


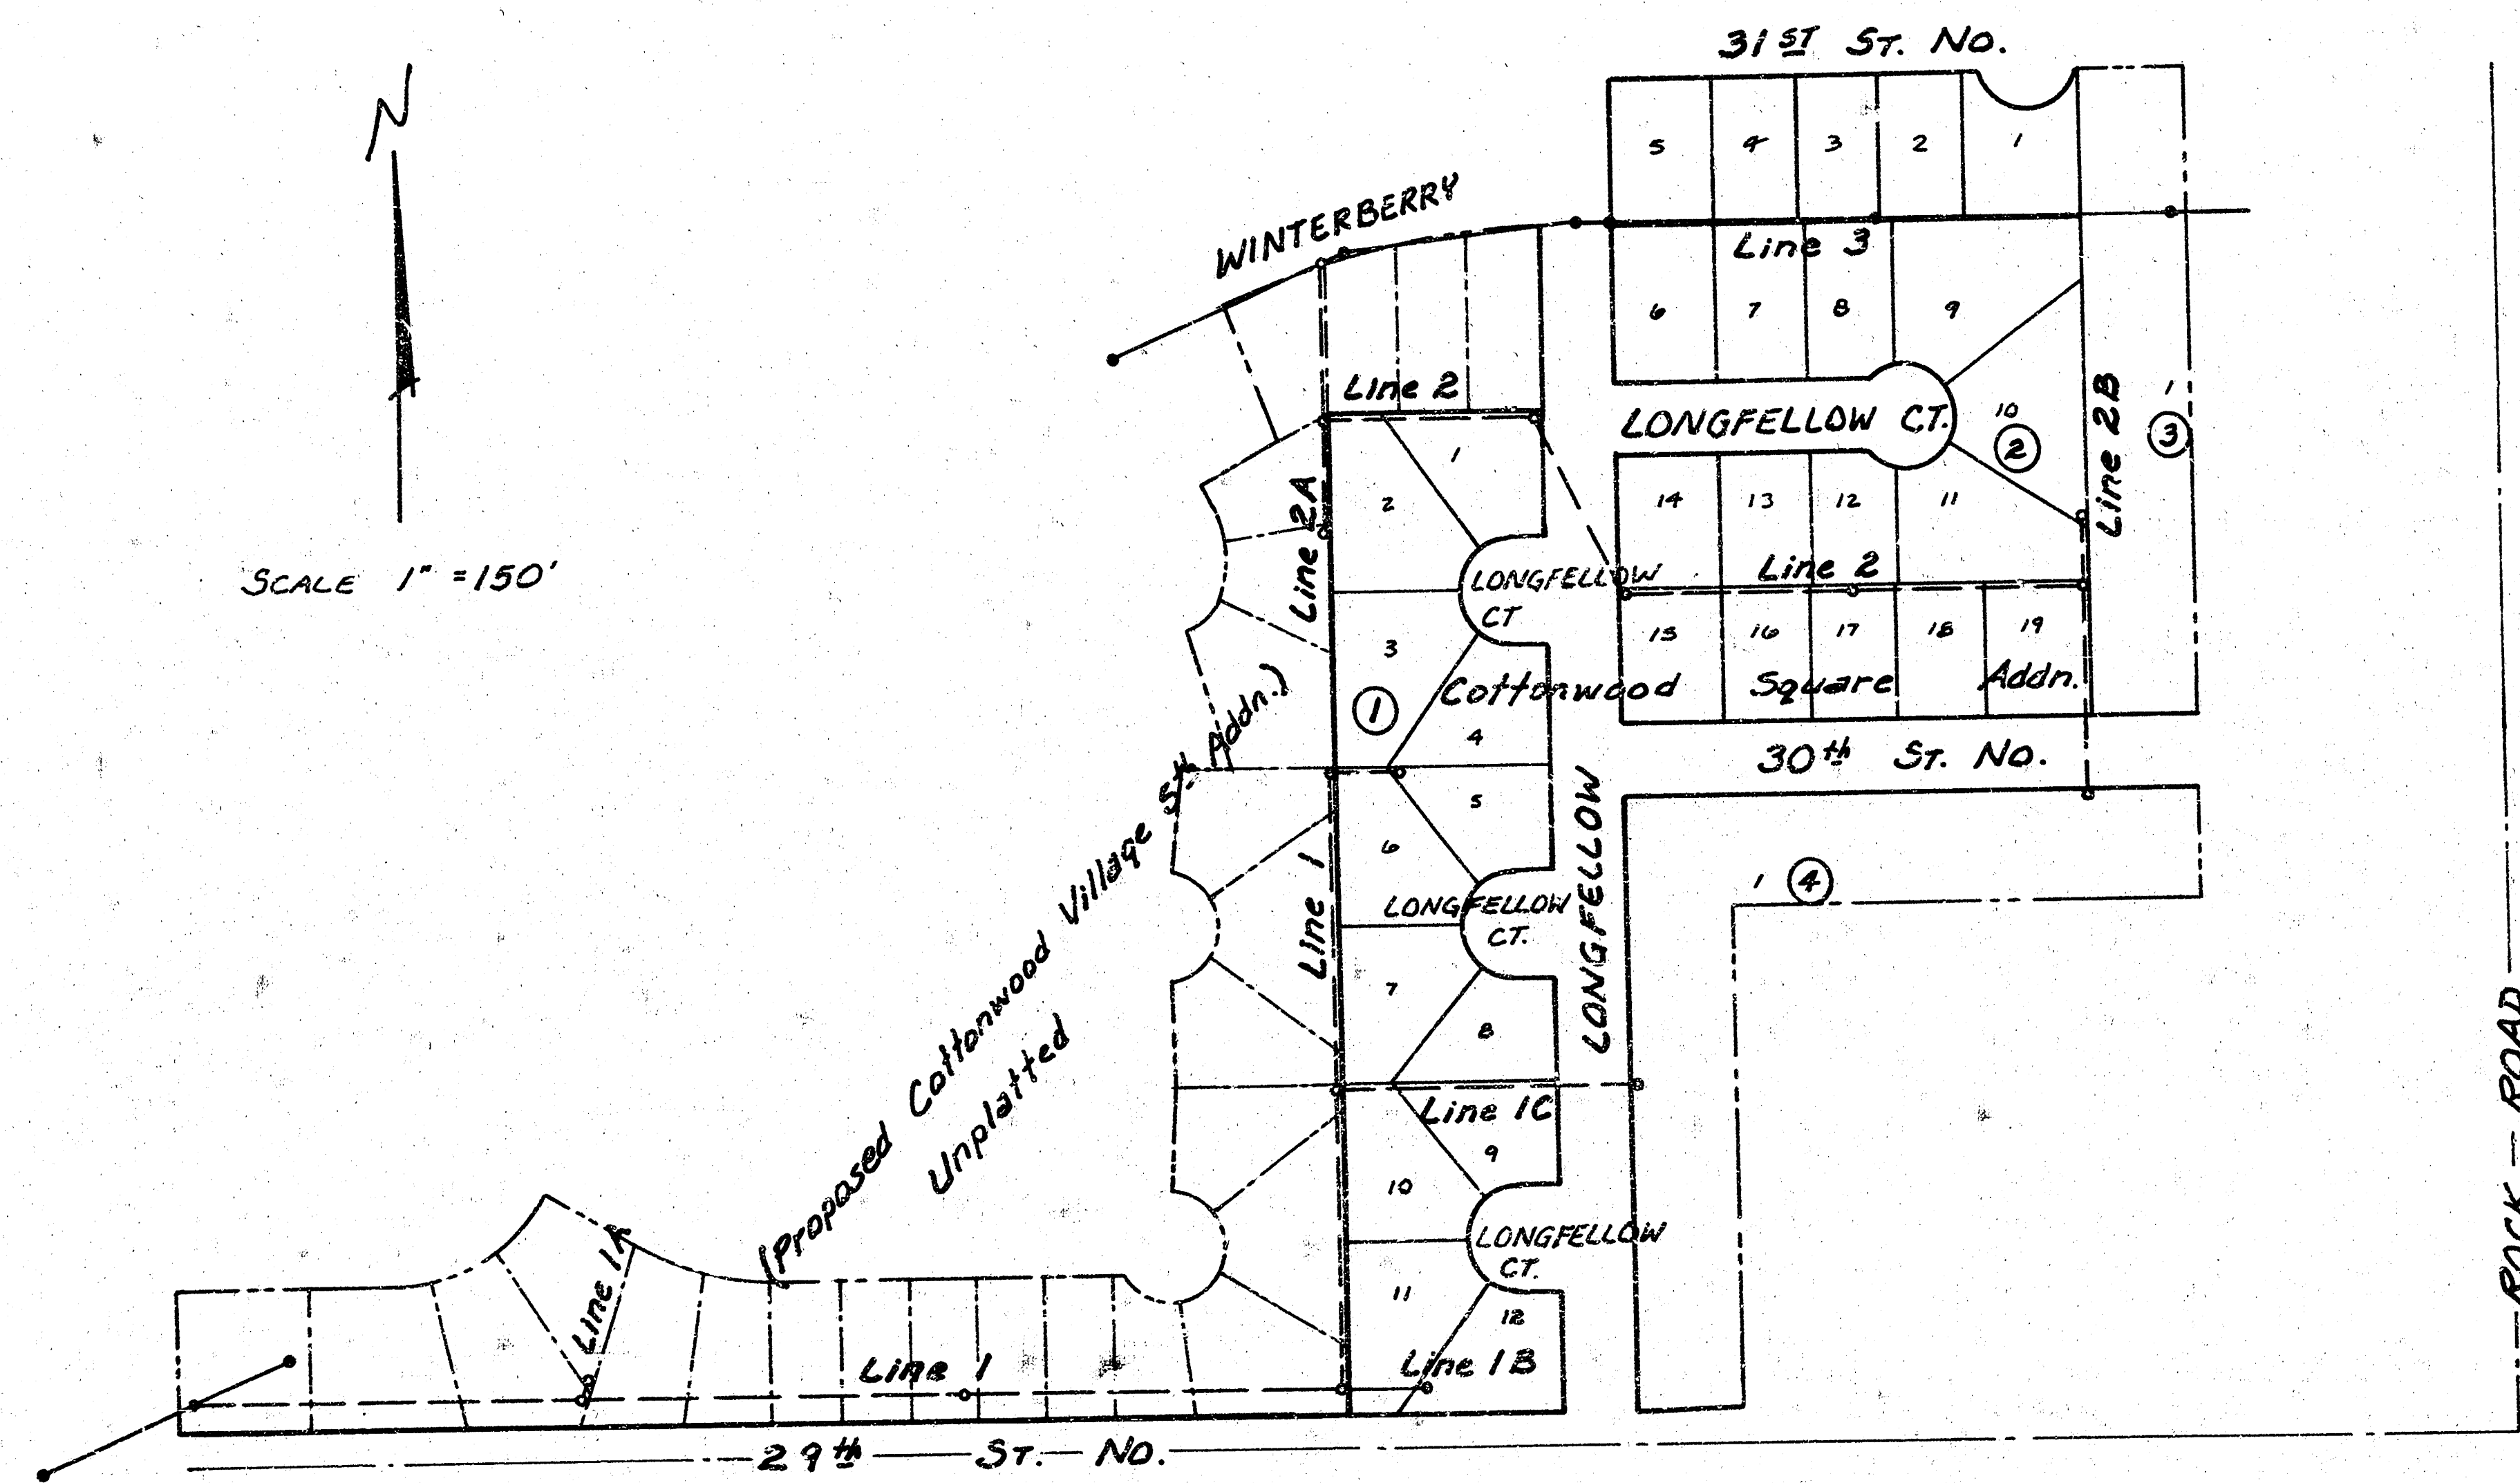

LAT 27, MAIN 7, SANITARY SEWER # 23


CITY OF WICHITA, KANSAS
R. W. BRUGGEMAN
DIRECTOR OF ENGINEERING / CITY ENGINEER


PROJ. NO. 468-76-245-81195-000-000-001


As Built
J.L.L.
4-83

INDEX

Line 1	Sheets	2-3
Line 1A	Sheet	2
Line 1B	Sheet	3
Line 1C	Sheet	3
Line 2	Sheets	4-5
Line 2A	Sheet	4
Line 2B	Sheet	5
Line 3	Sheet	5

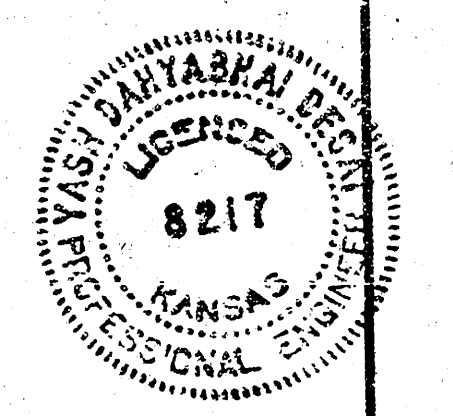

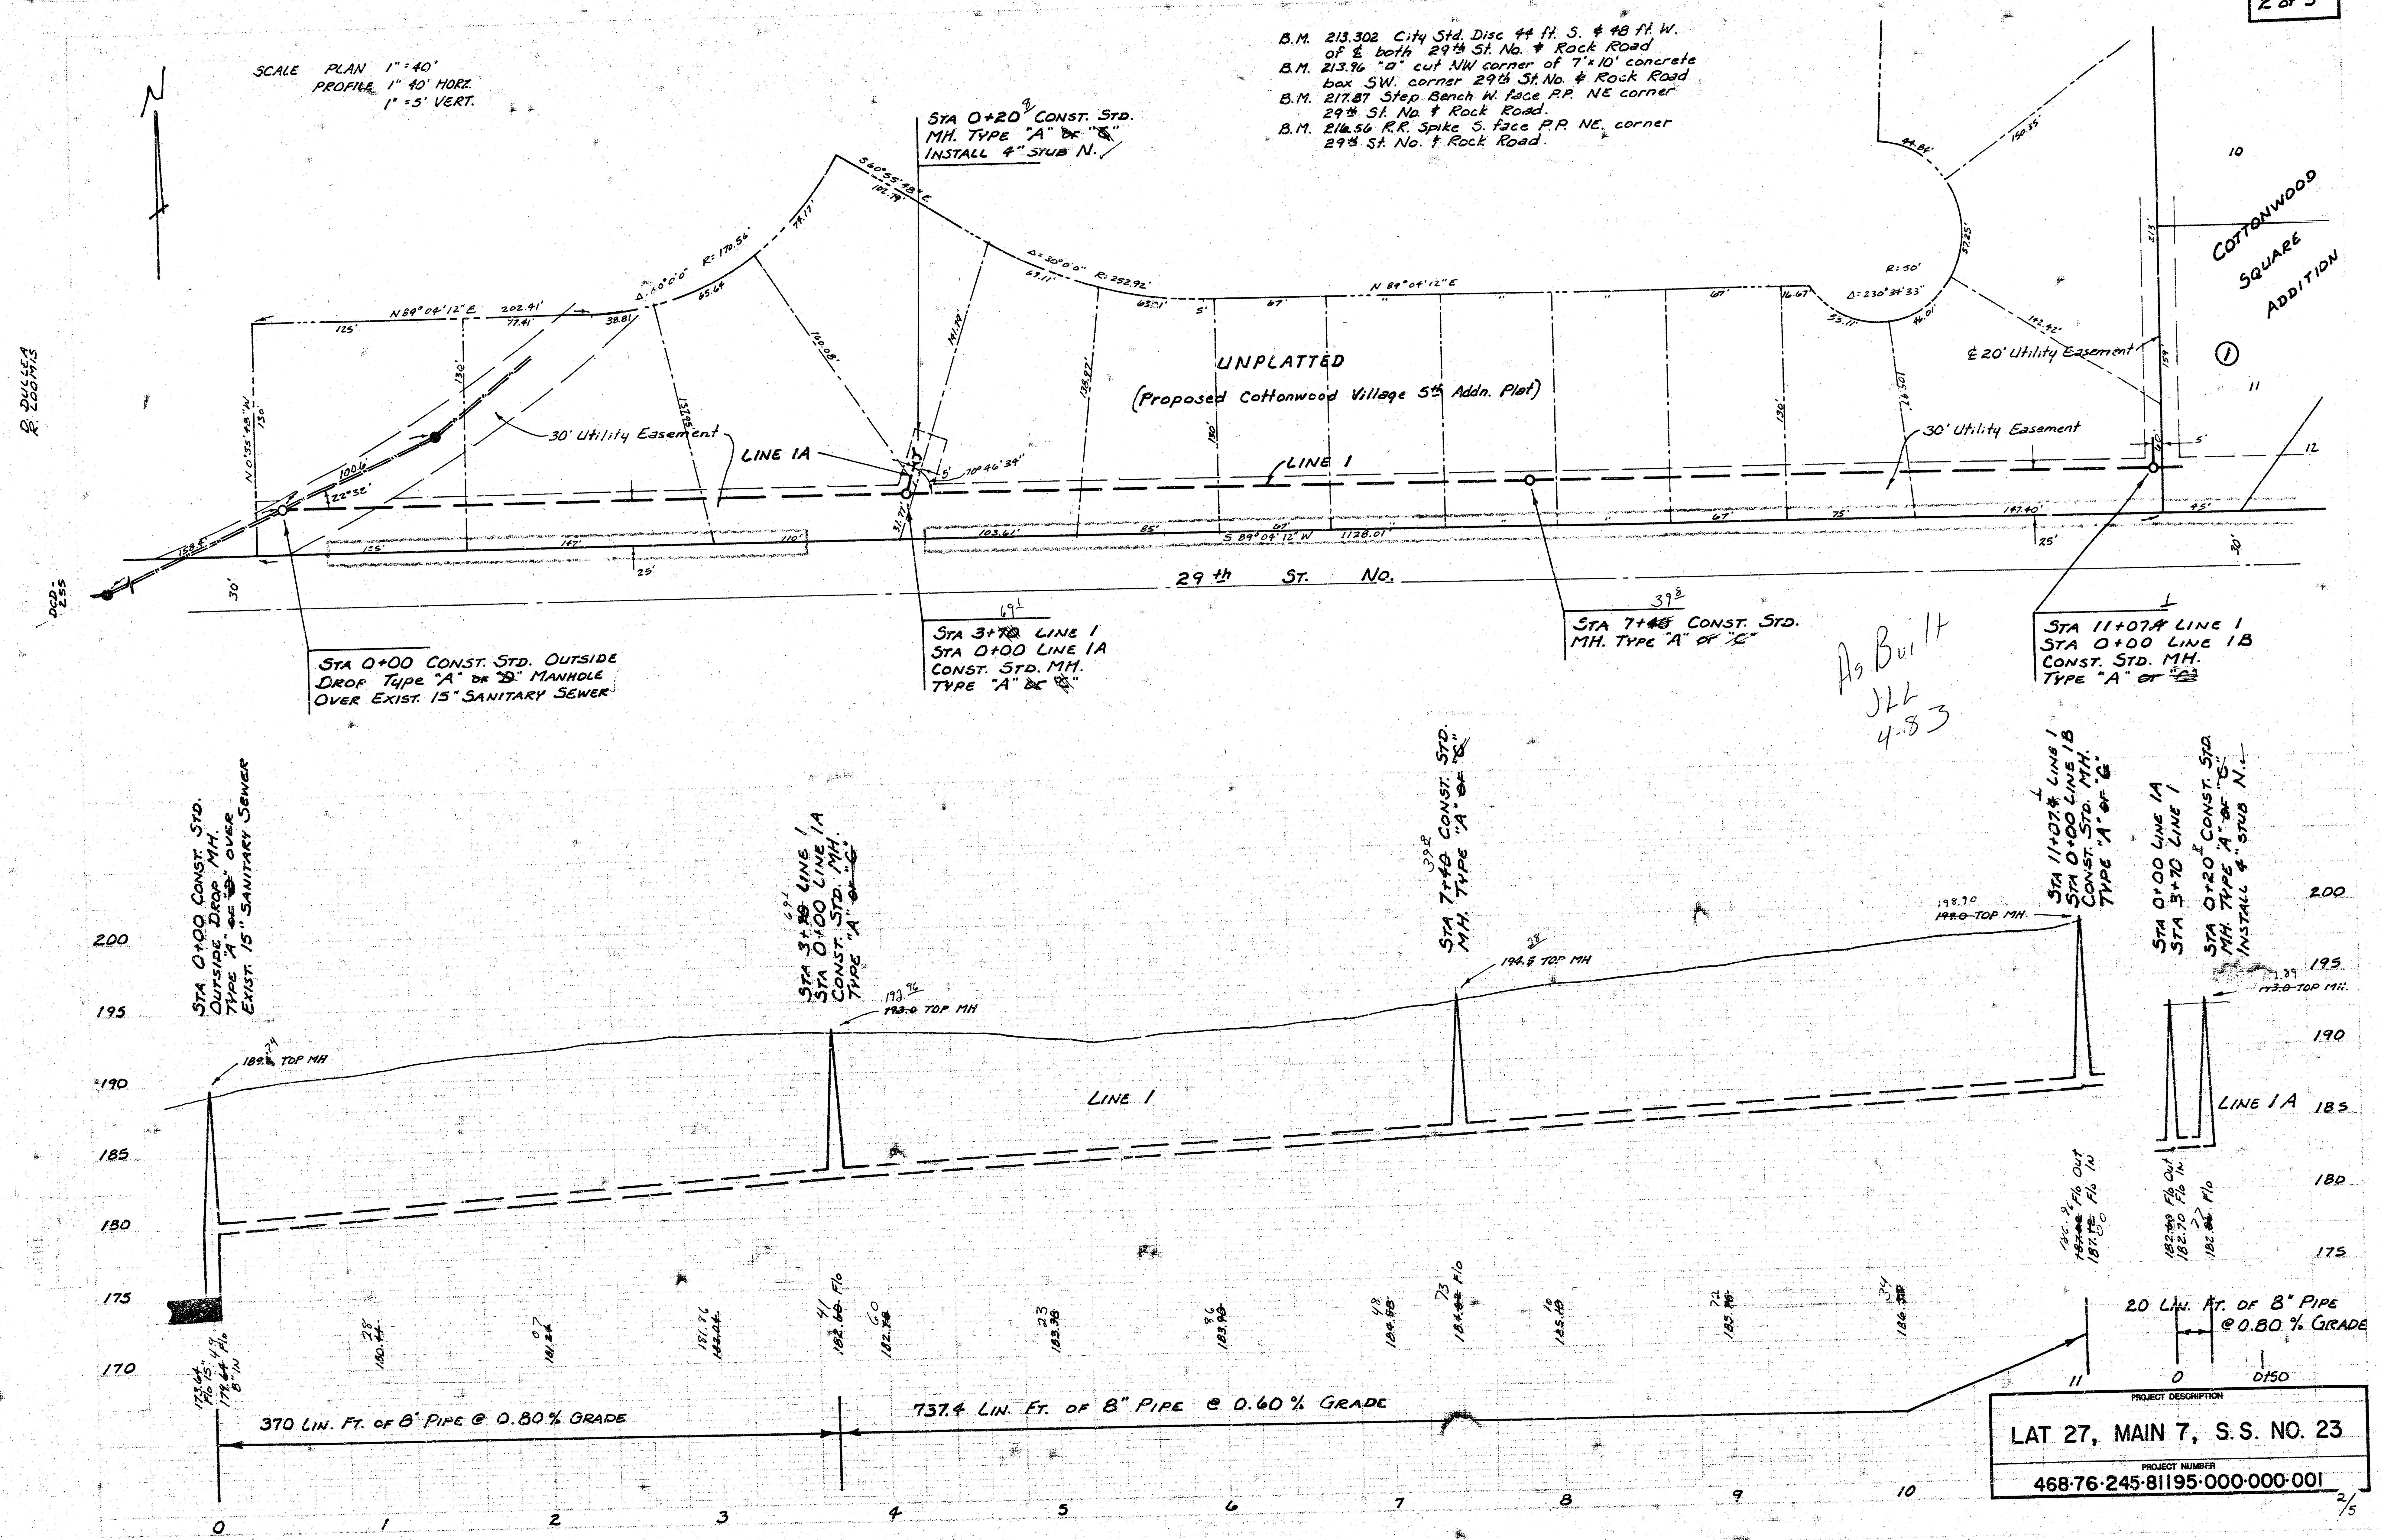

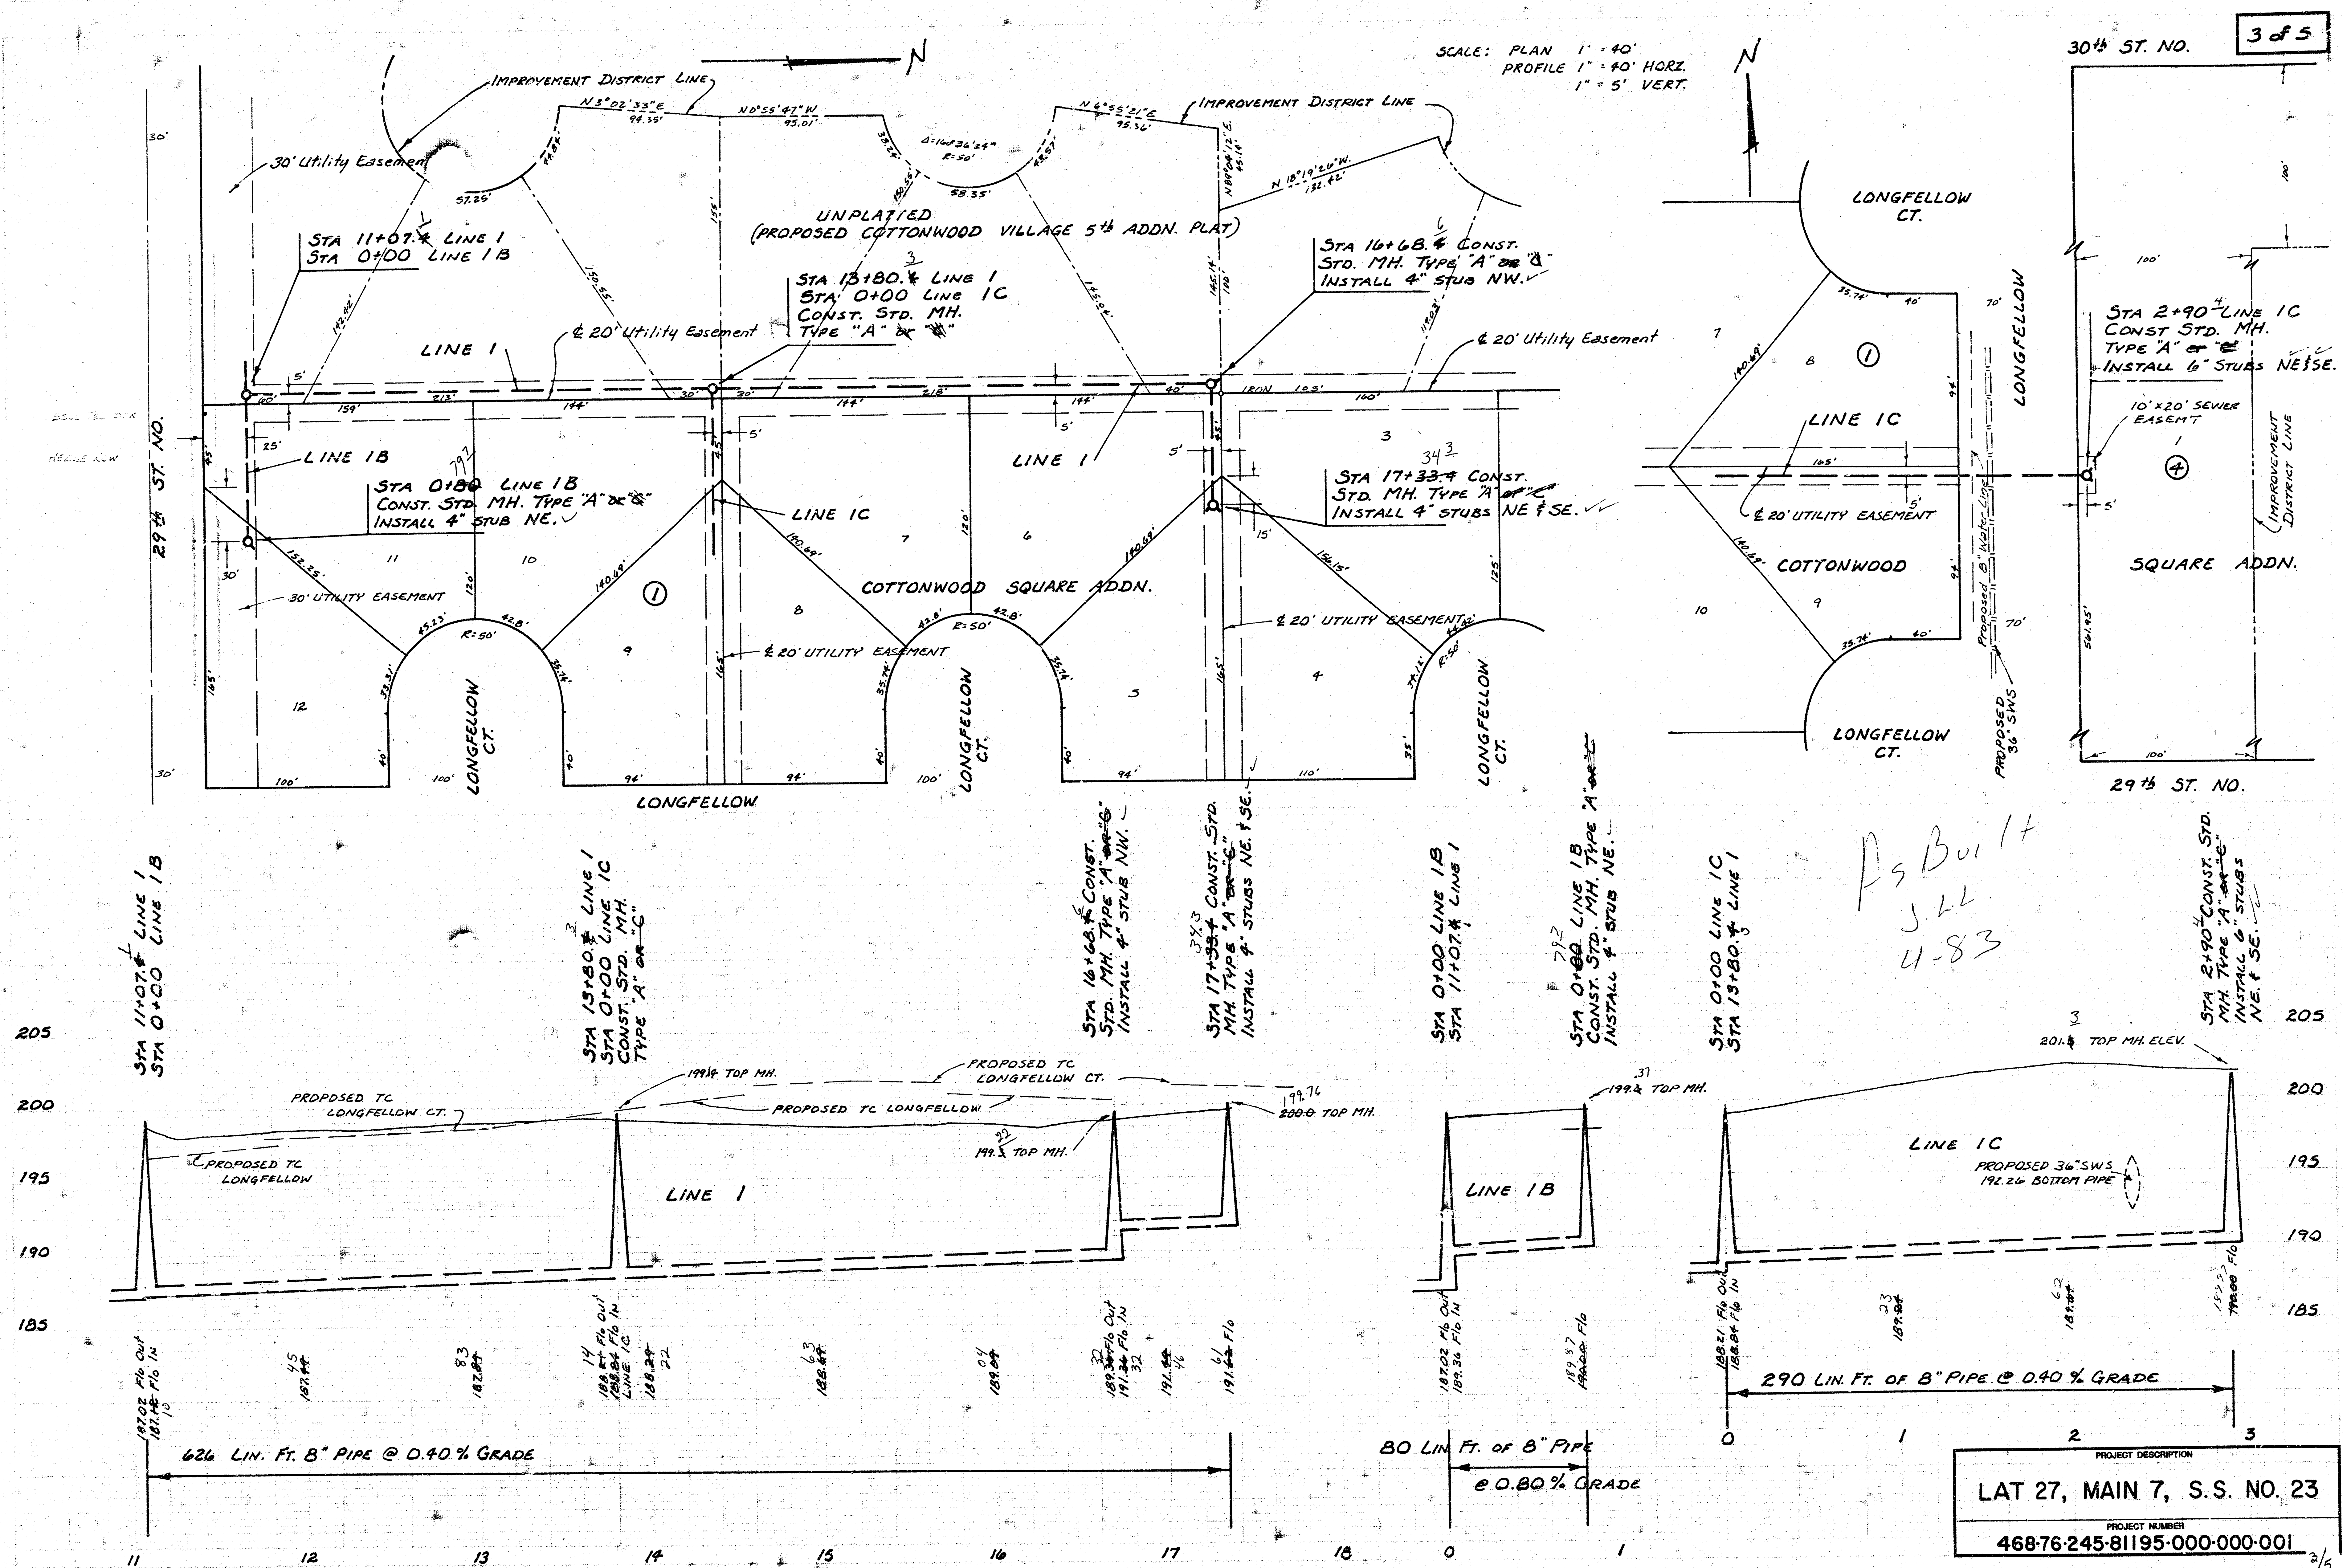

N

