

LATERAL 28, MAIN 7, SANITARY SEWER NO. 23

PROJECT NO.

468-76-245-81216-000-000-001

CITY OF WICHITA, KANSAS
R W BRUGGEMAN, CITY ENGINEER
MAY, 1982

NOTE: CONTRACTOR'S CONSTRUCTION OPERATIONS SHALL BE SUCH THAT WILL CREATE THE LEAST POSSIBLE AMOUNT OF INCONVENIENCE TO VEHICULAR TRAFFIC ON ROCK ROAD.

INDEX TO DRAWINGS	
<u>SHEET NO.</u>	<u>DESCRIPTION</u>
1	COVER SHEET
2	LINE 1

LEGEND

_____ PROPOSED LINE
 _____ EXISTING LINE
 _____ BENEFIT DISTRICT

 BENCH MARK "UPS" on east side of top rim on
Fire Hydrant Elev. = 213.88

NOTE TO CONTRACTOR


The contractor shall be responsible for preserving property irons. The contractor shall be required to re-establish any property irons which are damaged or destroyed by his construction operations. Such irons shall be re-established by a licensed land surveyor or a licensed professional engineer in accordance with state laws.



Van Doren Hazard Stallings
Architects • Engineers • Planners
Topeka • Wichita • Minneapolis • Kansas City


Sheet 1
of 2

PROJECT NO.
468-76-245-81216-000-000-001

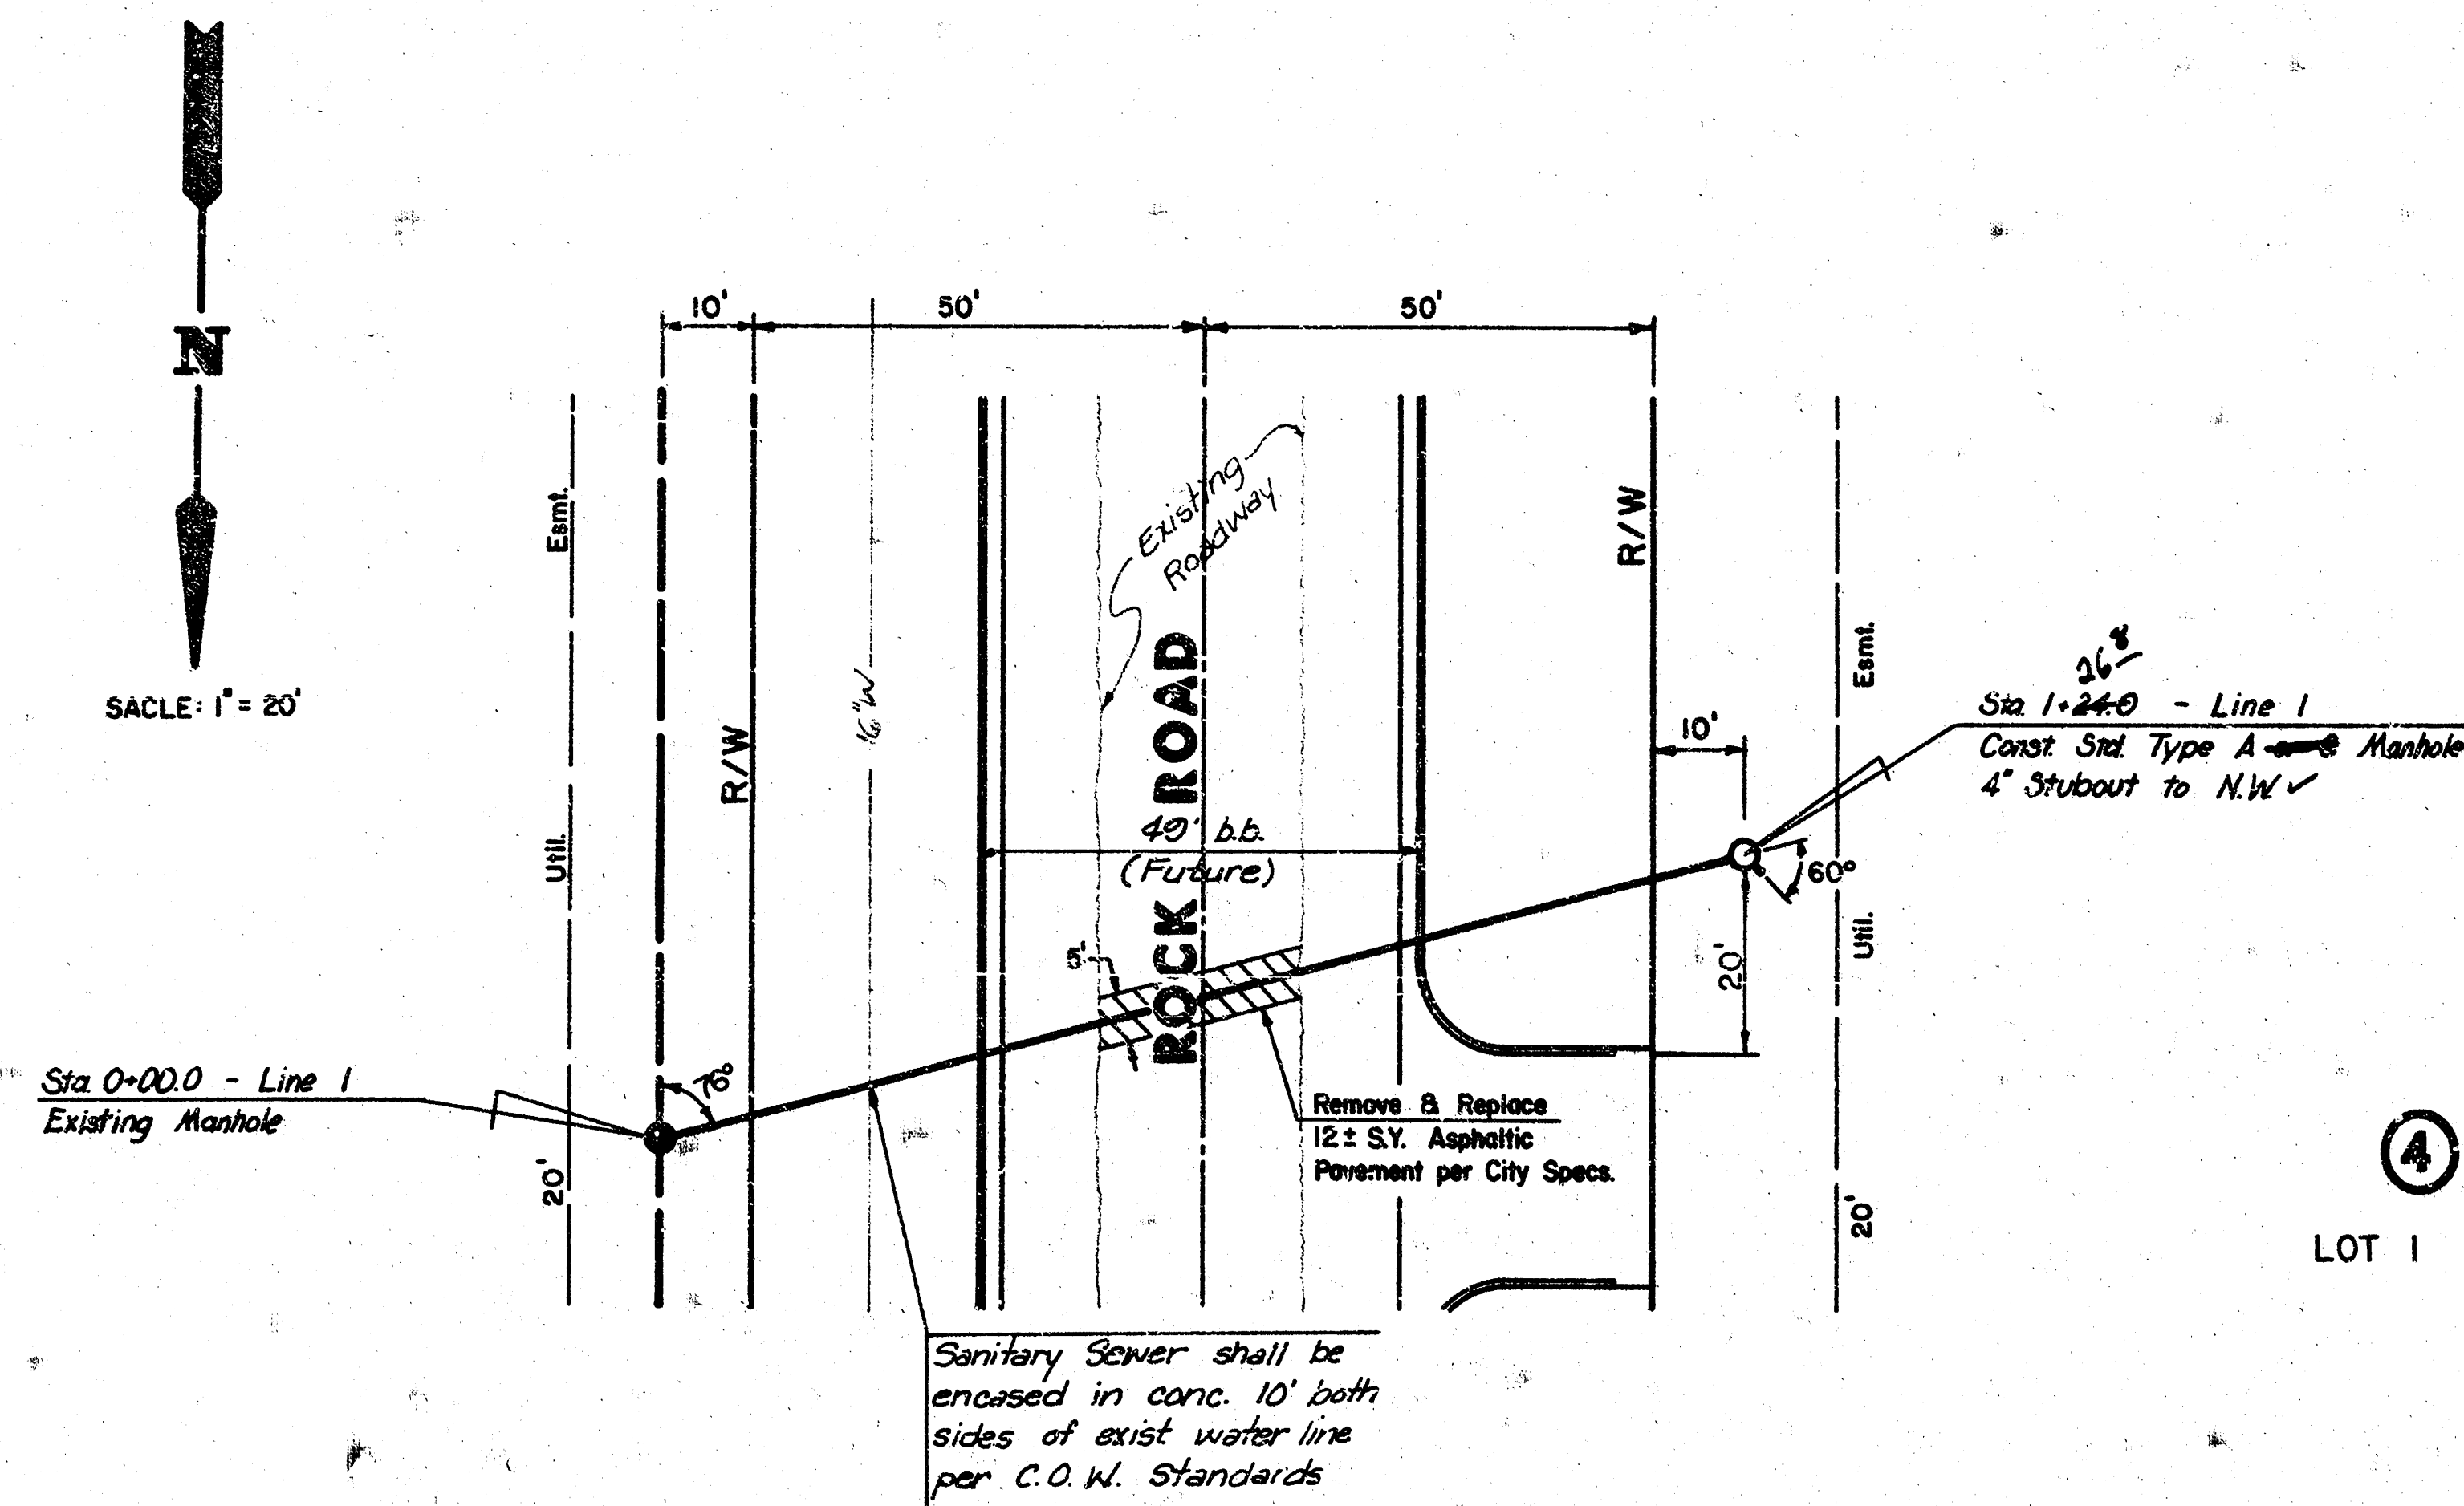

PLAN - LINE 1

As Built
J.L.L.
9-82

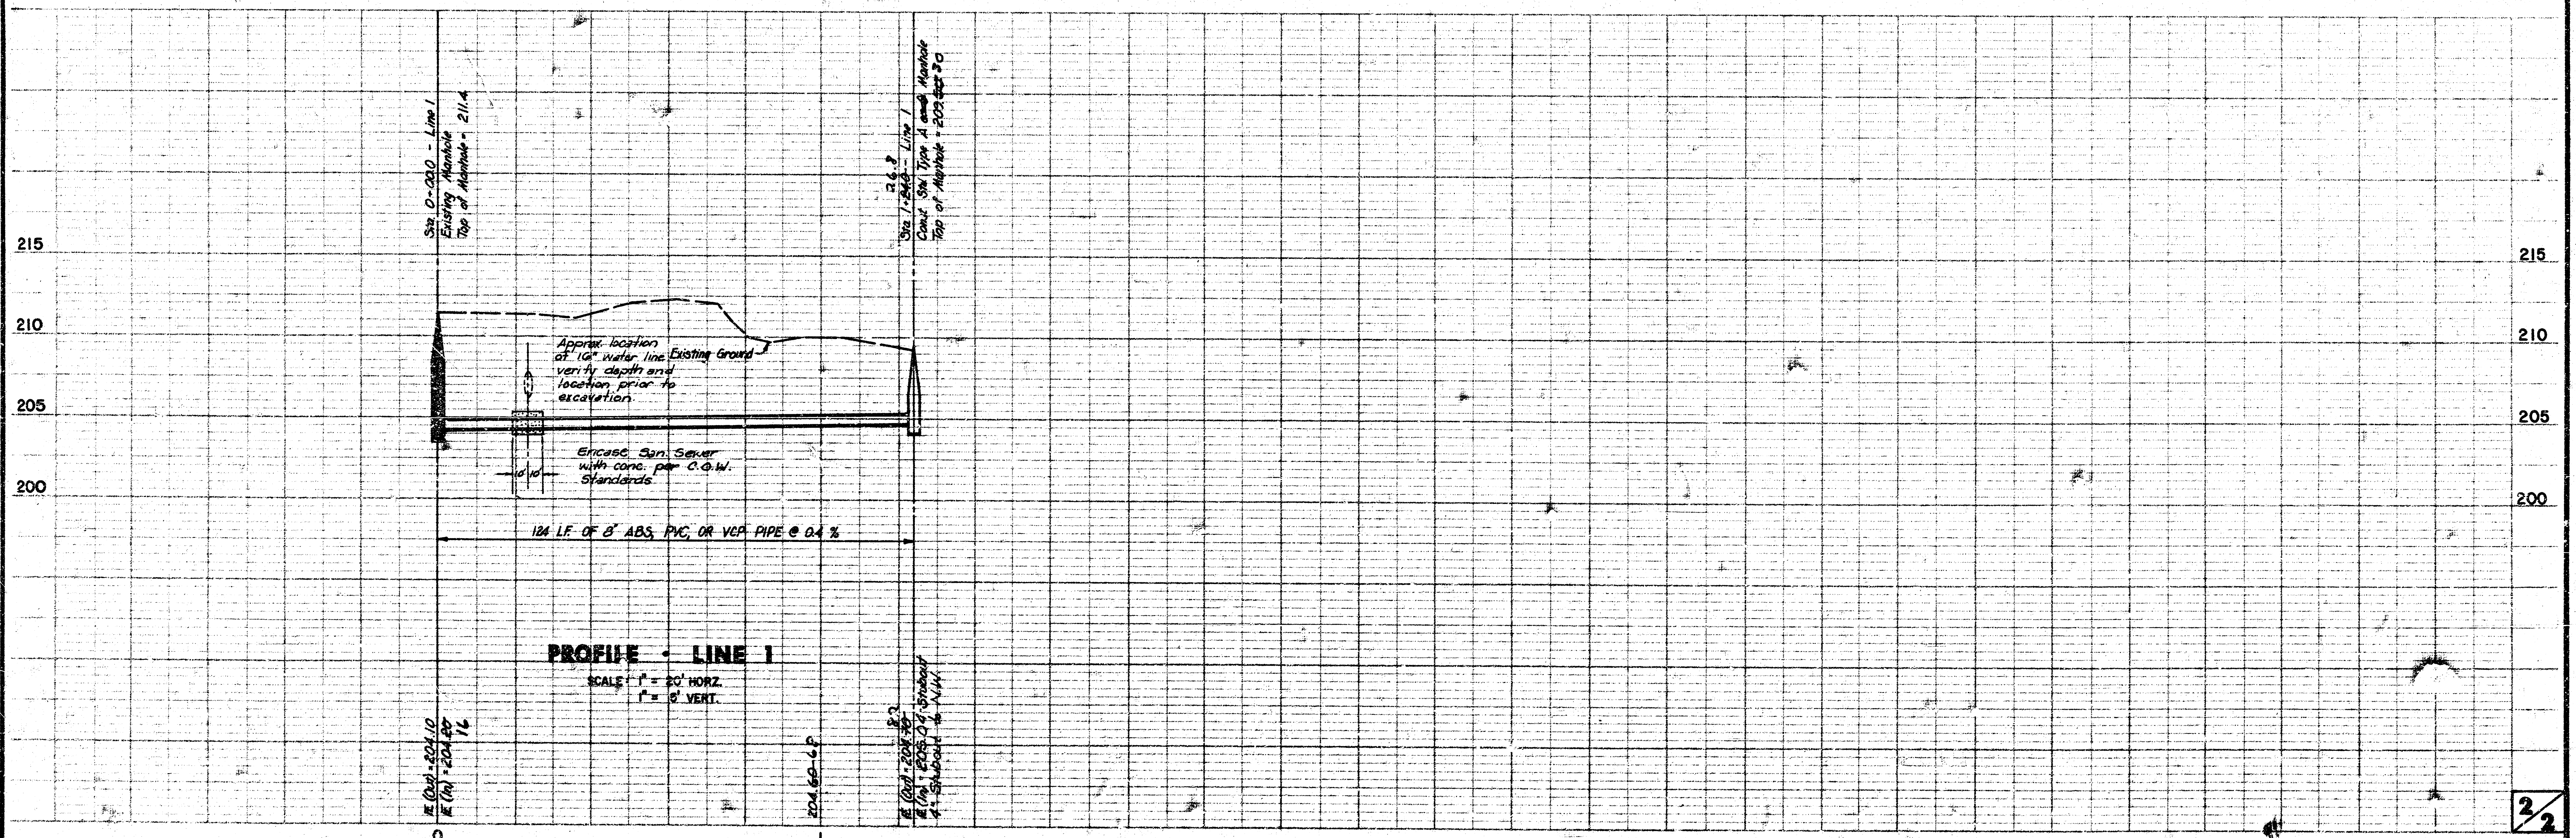

PROFILE - LINE 1

SCALE: 1" = 20' HORIZ.
1" = 5' VERT.