


LATERAL 4, MAIN 9 S.S. NO. 23

Project no. 468-76-245-81322-000-000-001

CITY OF WICHITA, KANSAS
MIKE LINDEBAK CITY ENGINEER


As Built
S.L.
8.84

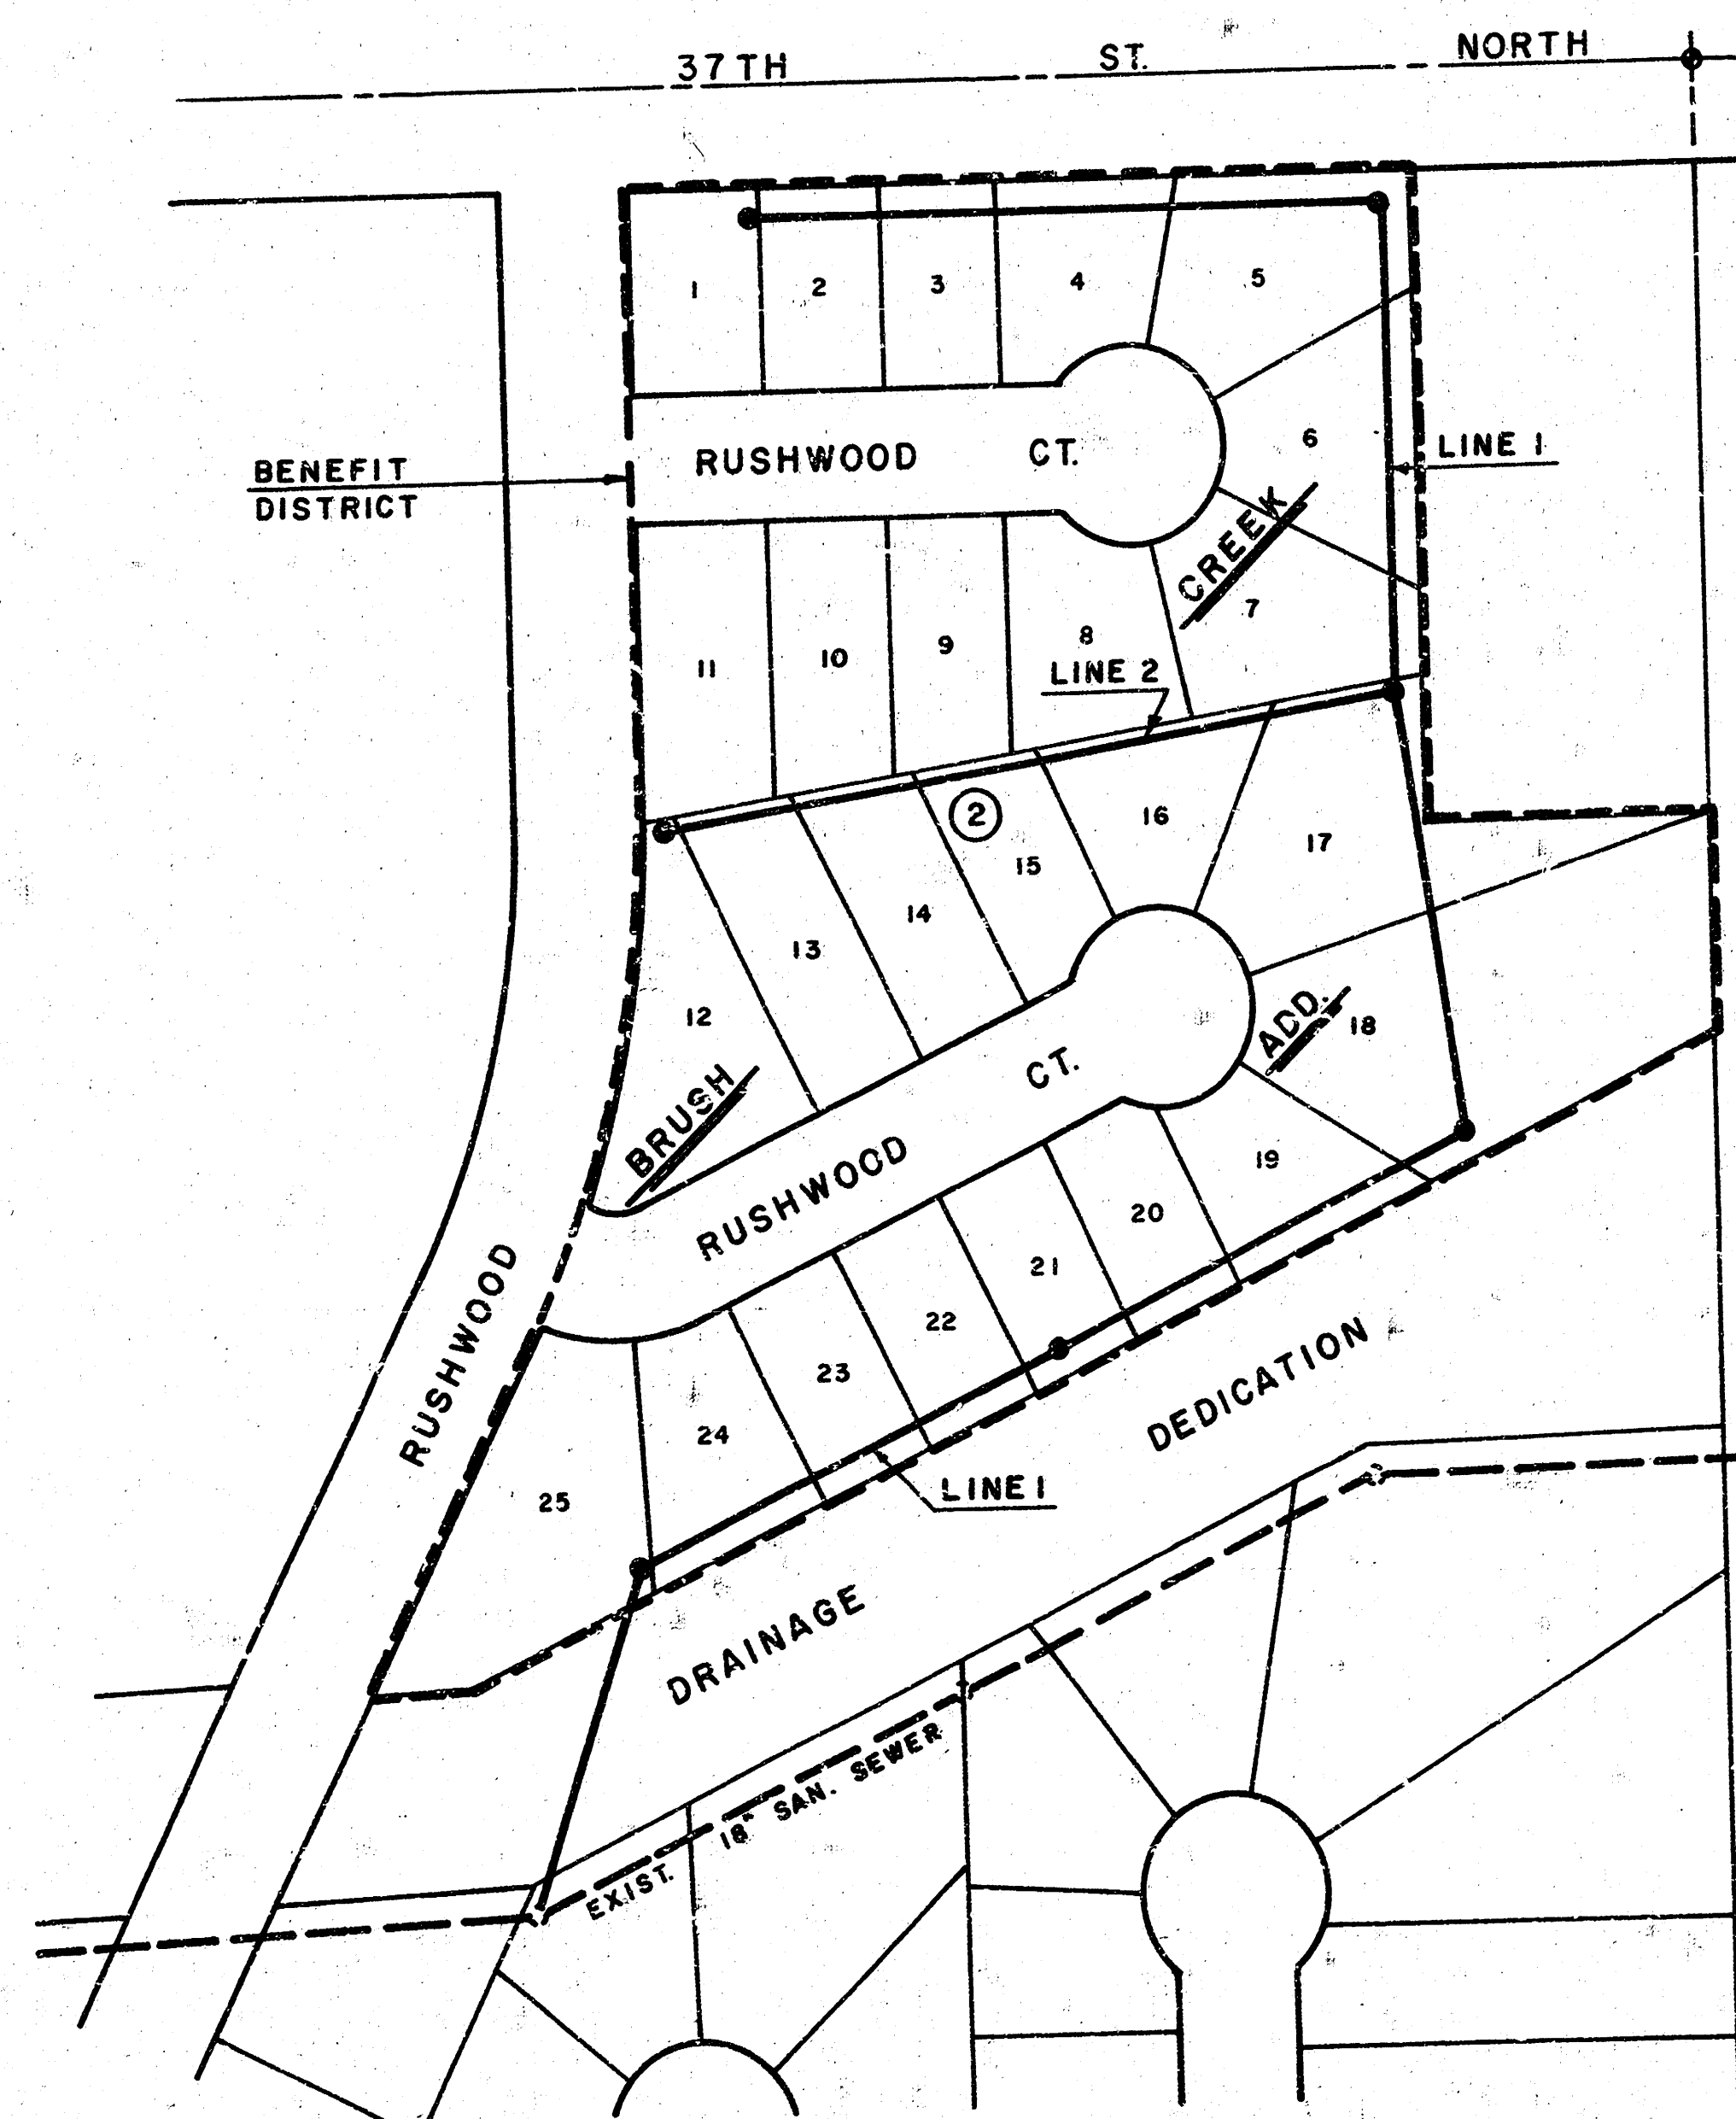


LOCATION MAP

The contractor shall be responsible for preserving property irons. The contractor shall be required to re-establish any property irons which are damaged or destroyed by his construction operations. Such irons shall be re-established by a licensed land surveyor or a professional engineer in accordance with state laws.


The contractor shall contact the Telephone Company for the verification of their line location along 37th St. No.

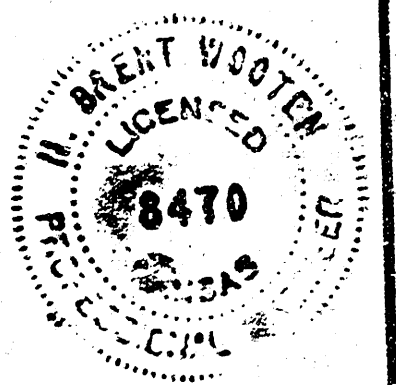

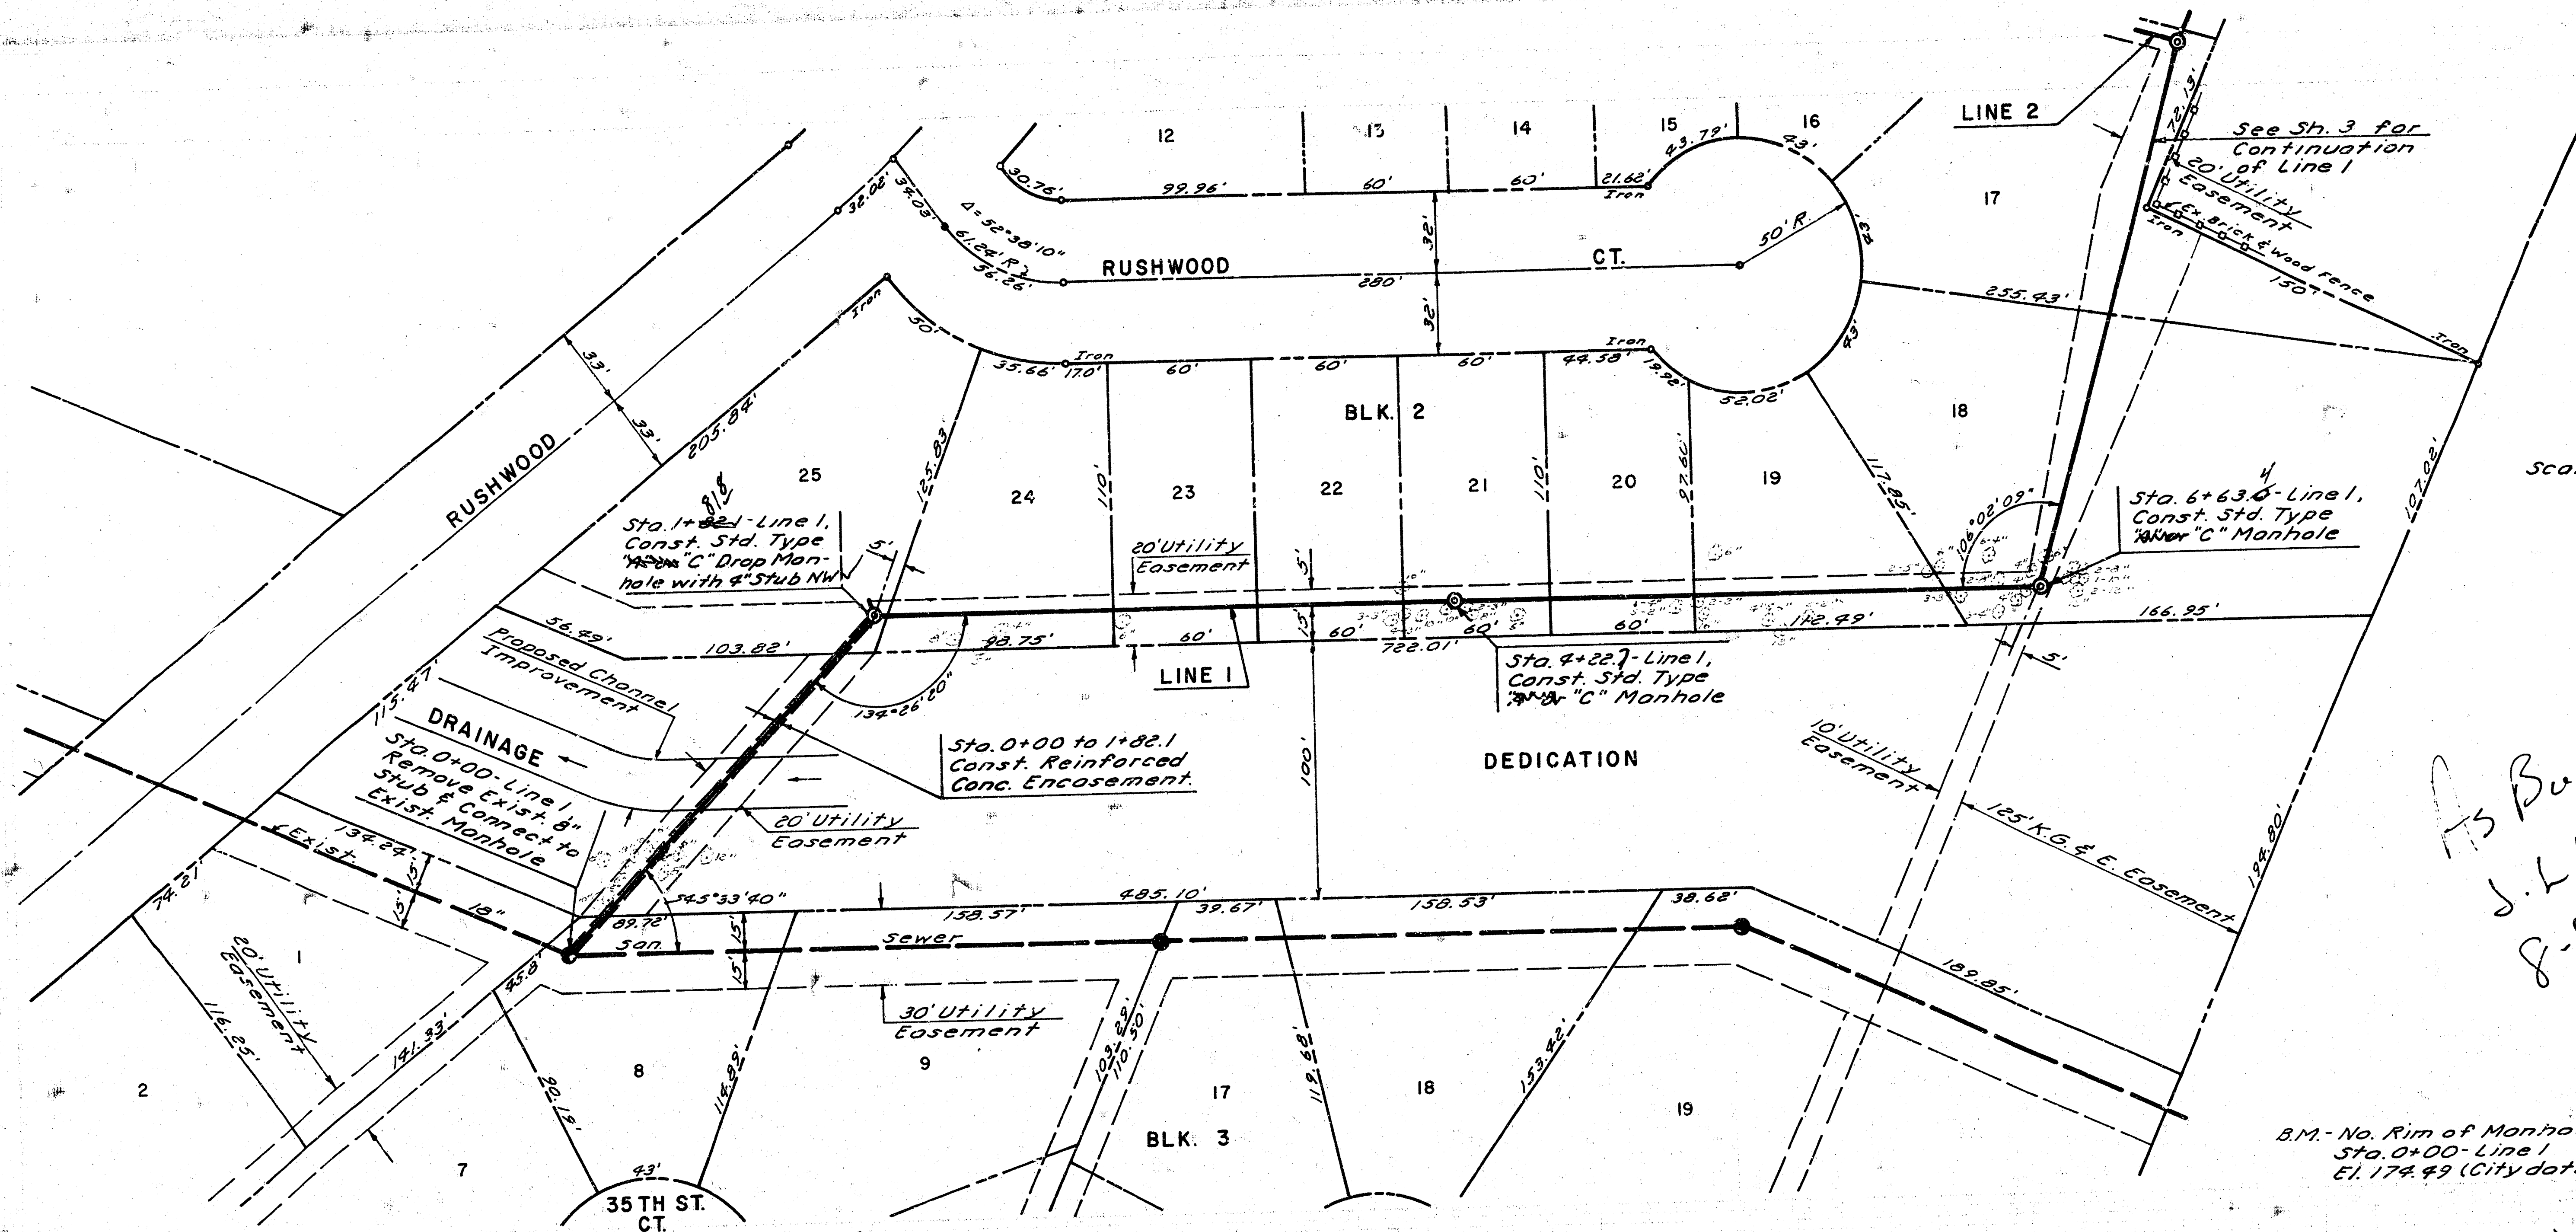


Scale: Hor. 1" = 40'
Ver. 1" = 5'

As Built
J.L.
8-84

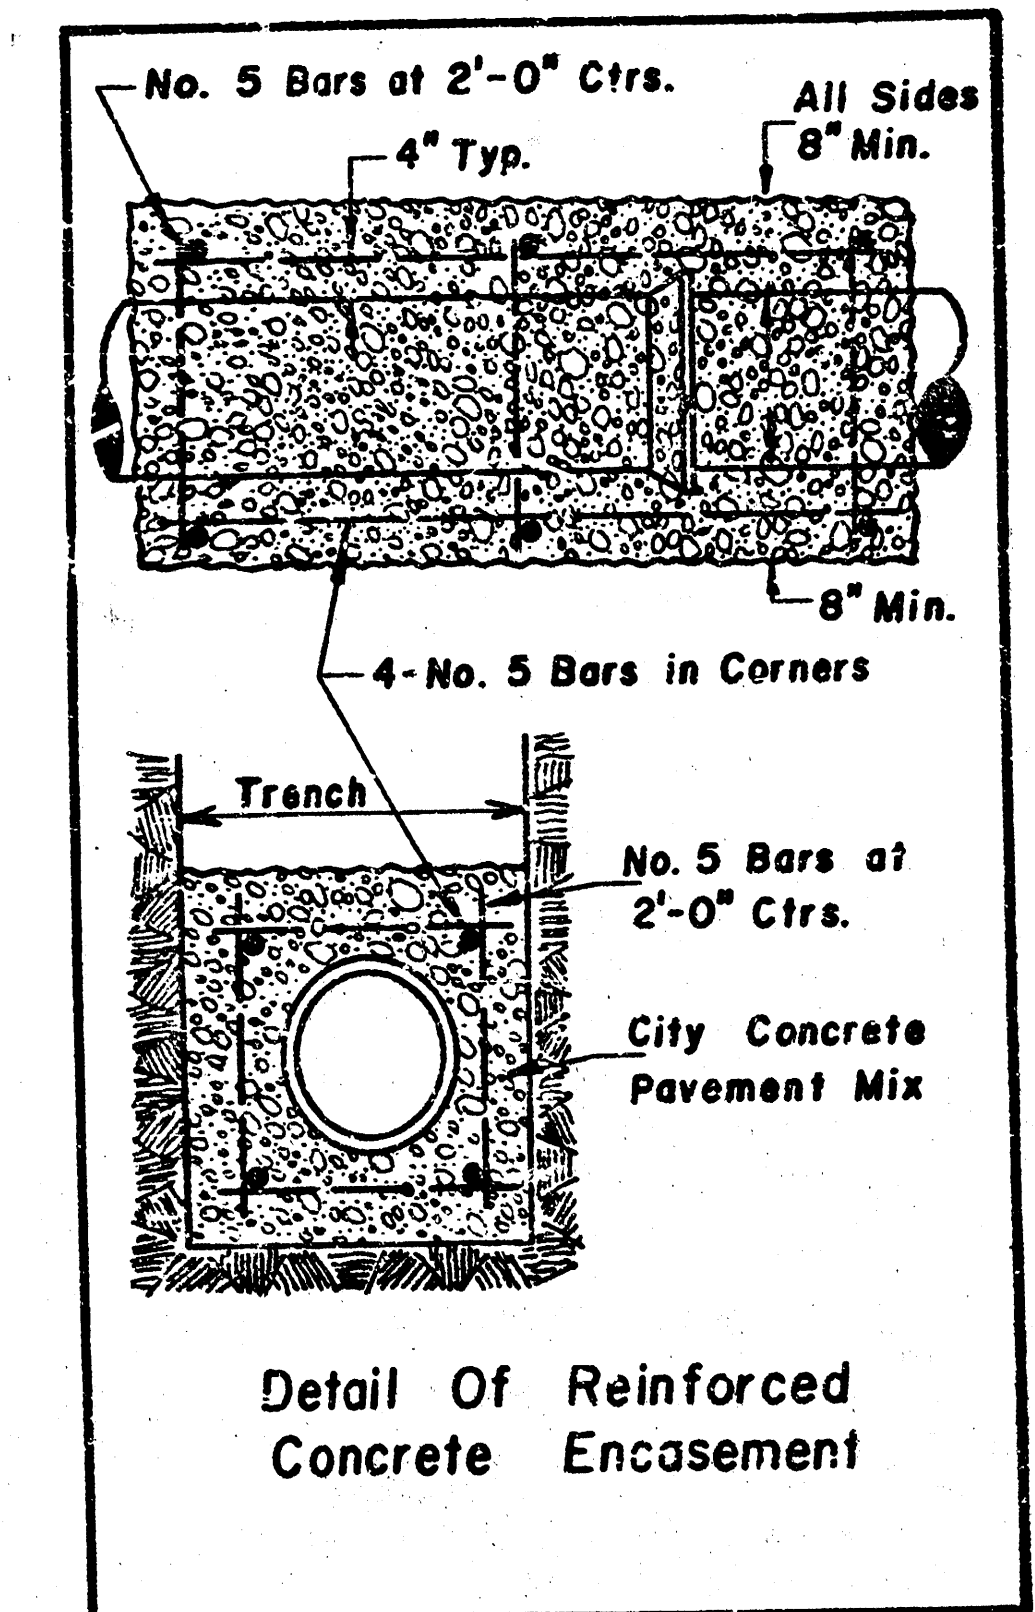


B.M. - No. Rim of Manhole
Sta. 0+00 - Line 1
El. 174.49 (City datum)

B.M. - City disc 70' W. & 39' N.
& 37th No. & Woodlawn
Elev. 186.17

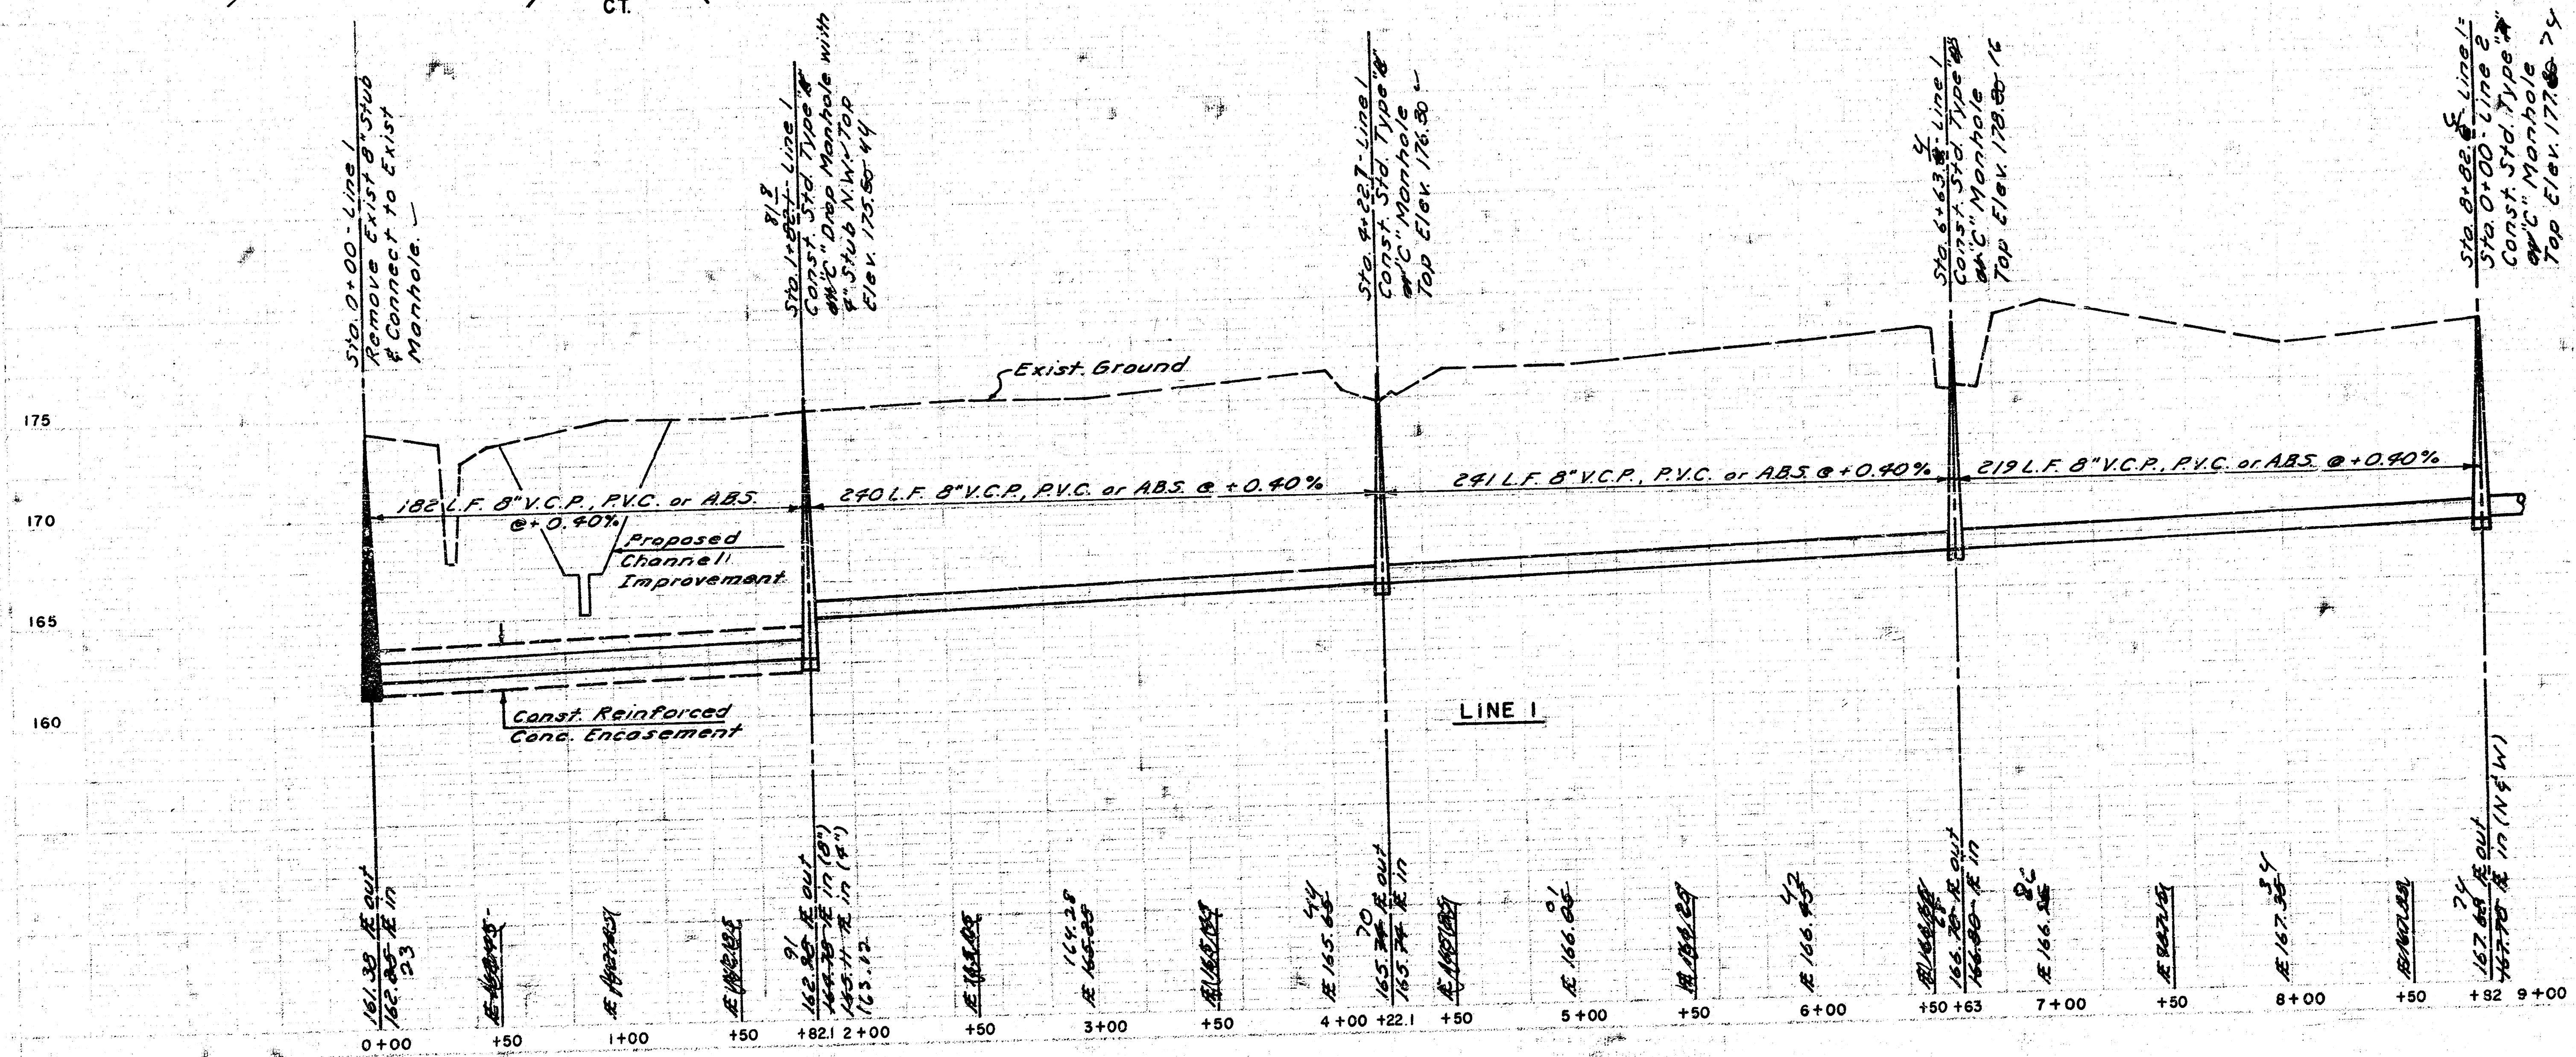


LATERAL 4, MAIN 9, S.S. NO. 23
SANITARY SEWER TO SERVE BLOCK 2,
BRUSH CREEK ADDITION
PROJ. NO. 468-76-245-81322-000-000-001
CITY OF WICHITA, KANSAS
MIKE LINDEBAK CITY ENGINEER

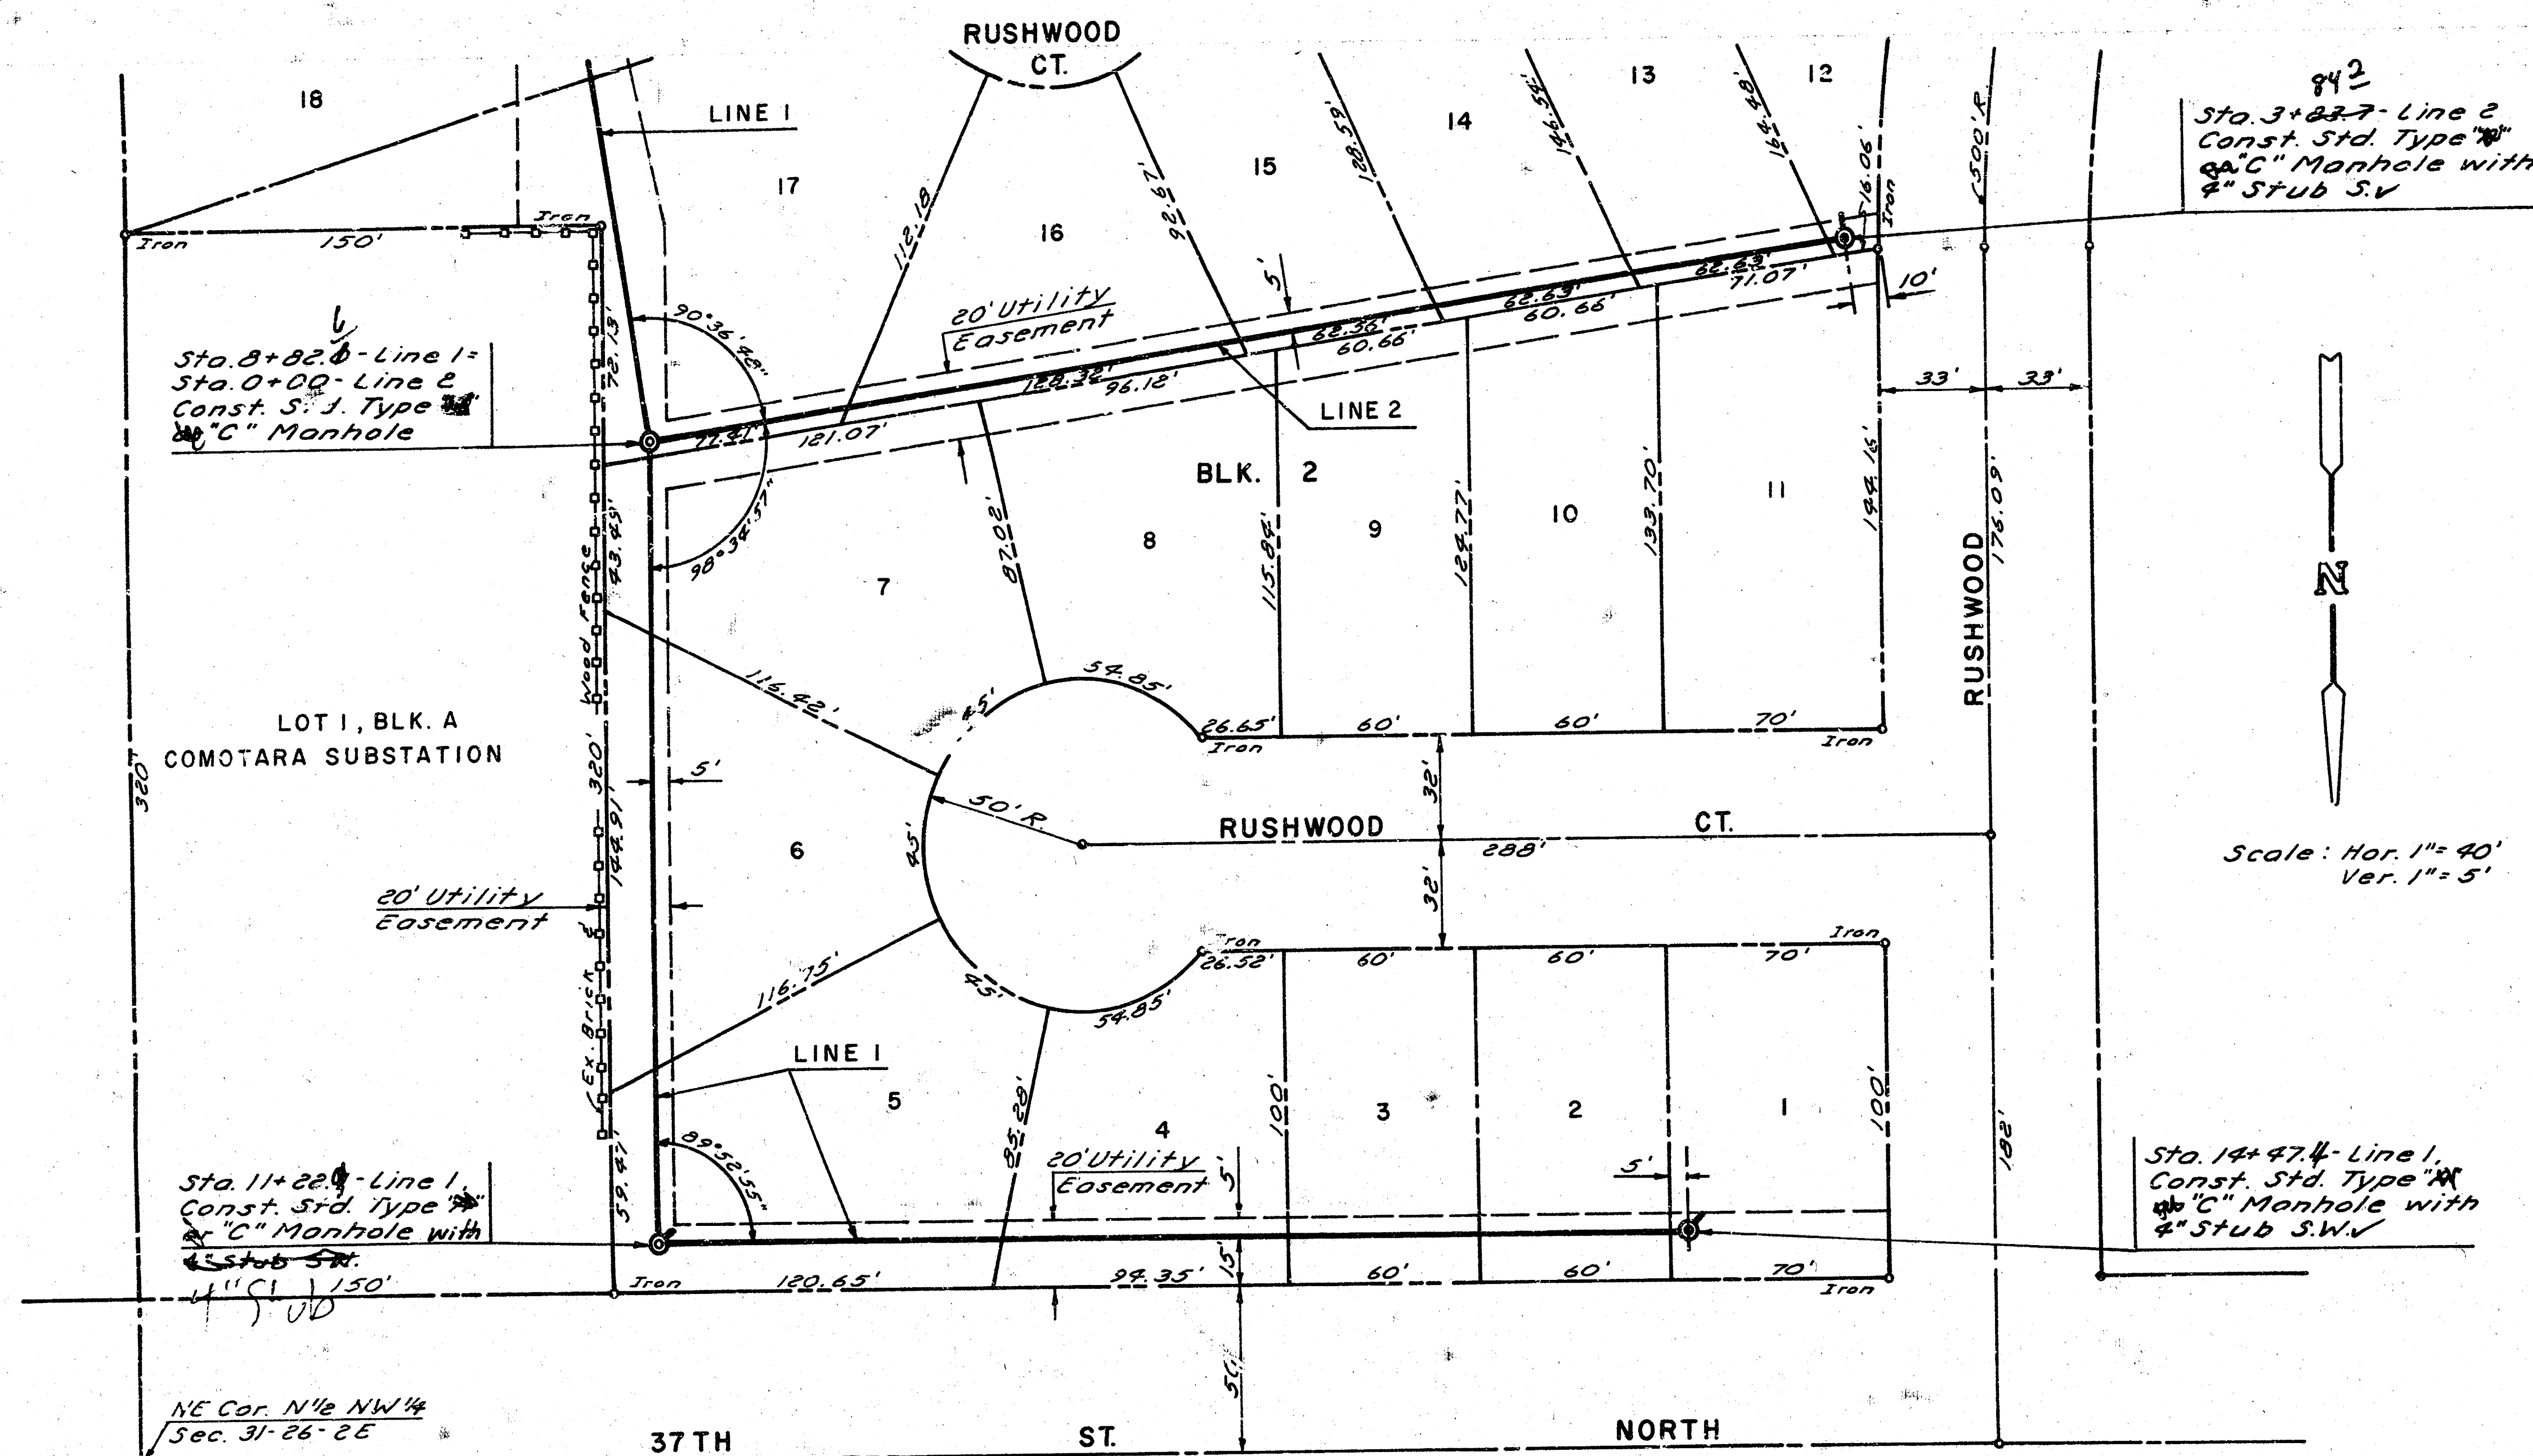

Scale: Hor. 1" = 40'
Ver. 1" = 5'

B.M. - RR Spk. in Power Pole
164.71' ± 29.3' E 37th
Rushwood - El. 181.28 (City datum)

As Built
J.L.L.
8-8-84

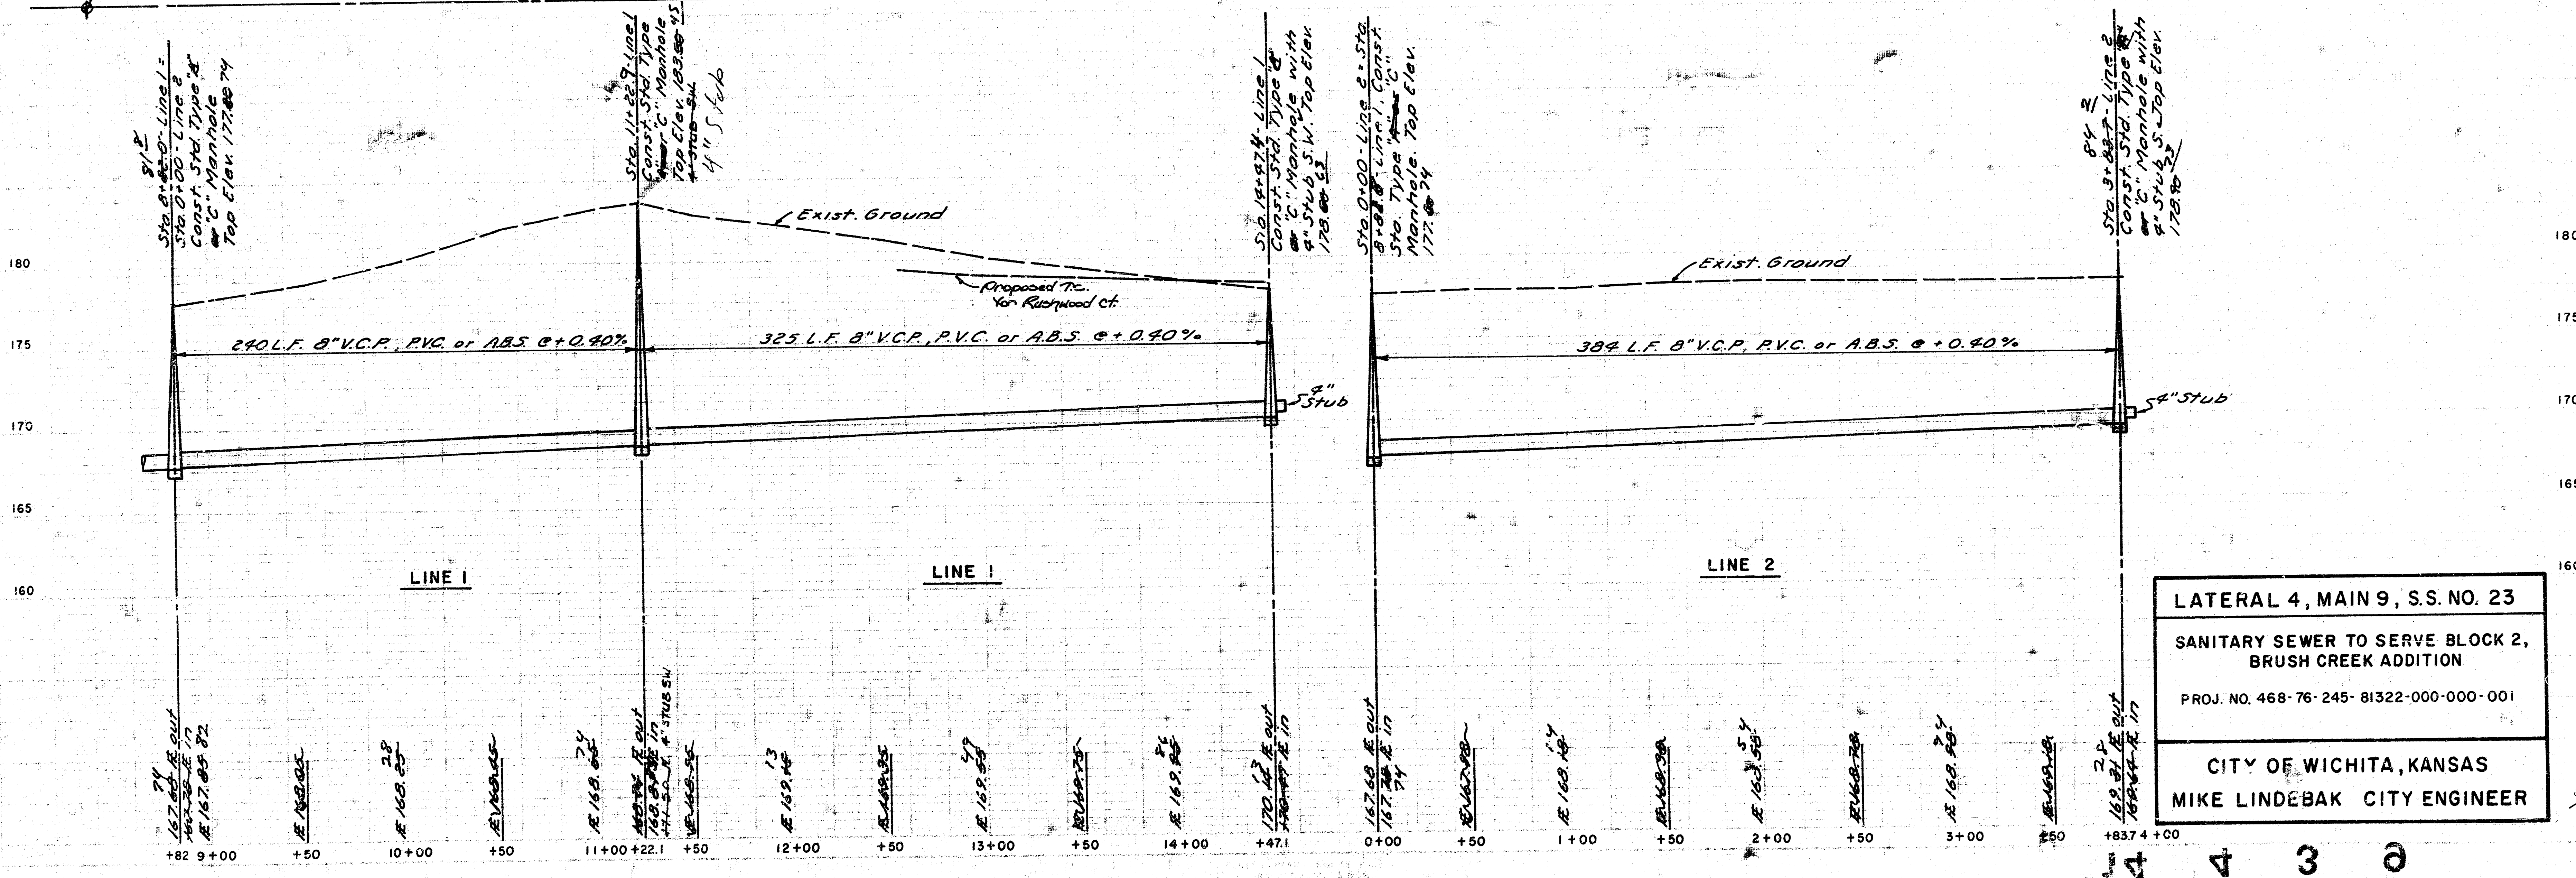

LATERAL 4, MAIN 9, S.S. NO. 23
SANITARY SEWER TO SERVE BLOCK 2,
BRUSH CREEK ADDITION
PROJ. NO. 468-76-245-81322-000-001
CITY OF WICHITA, KANSAS
MIKE LINDEBAK CITY ENGINEER

3/3