

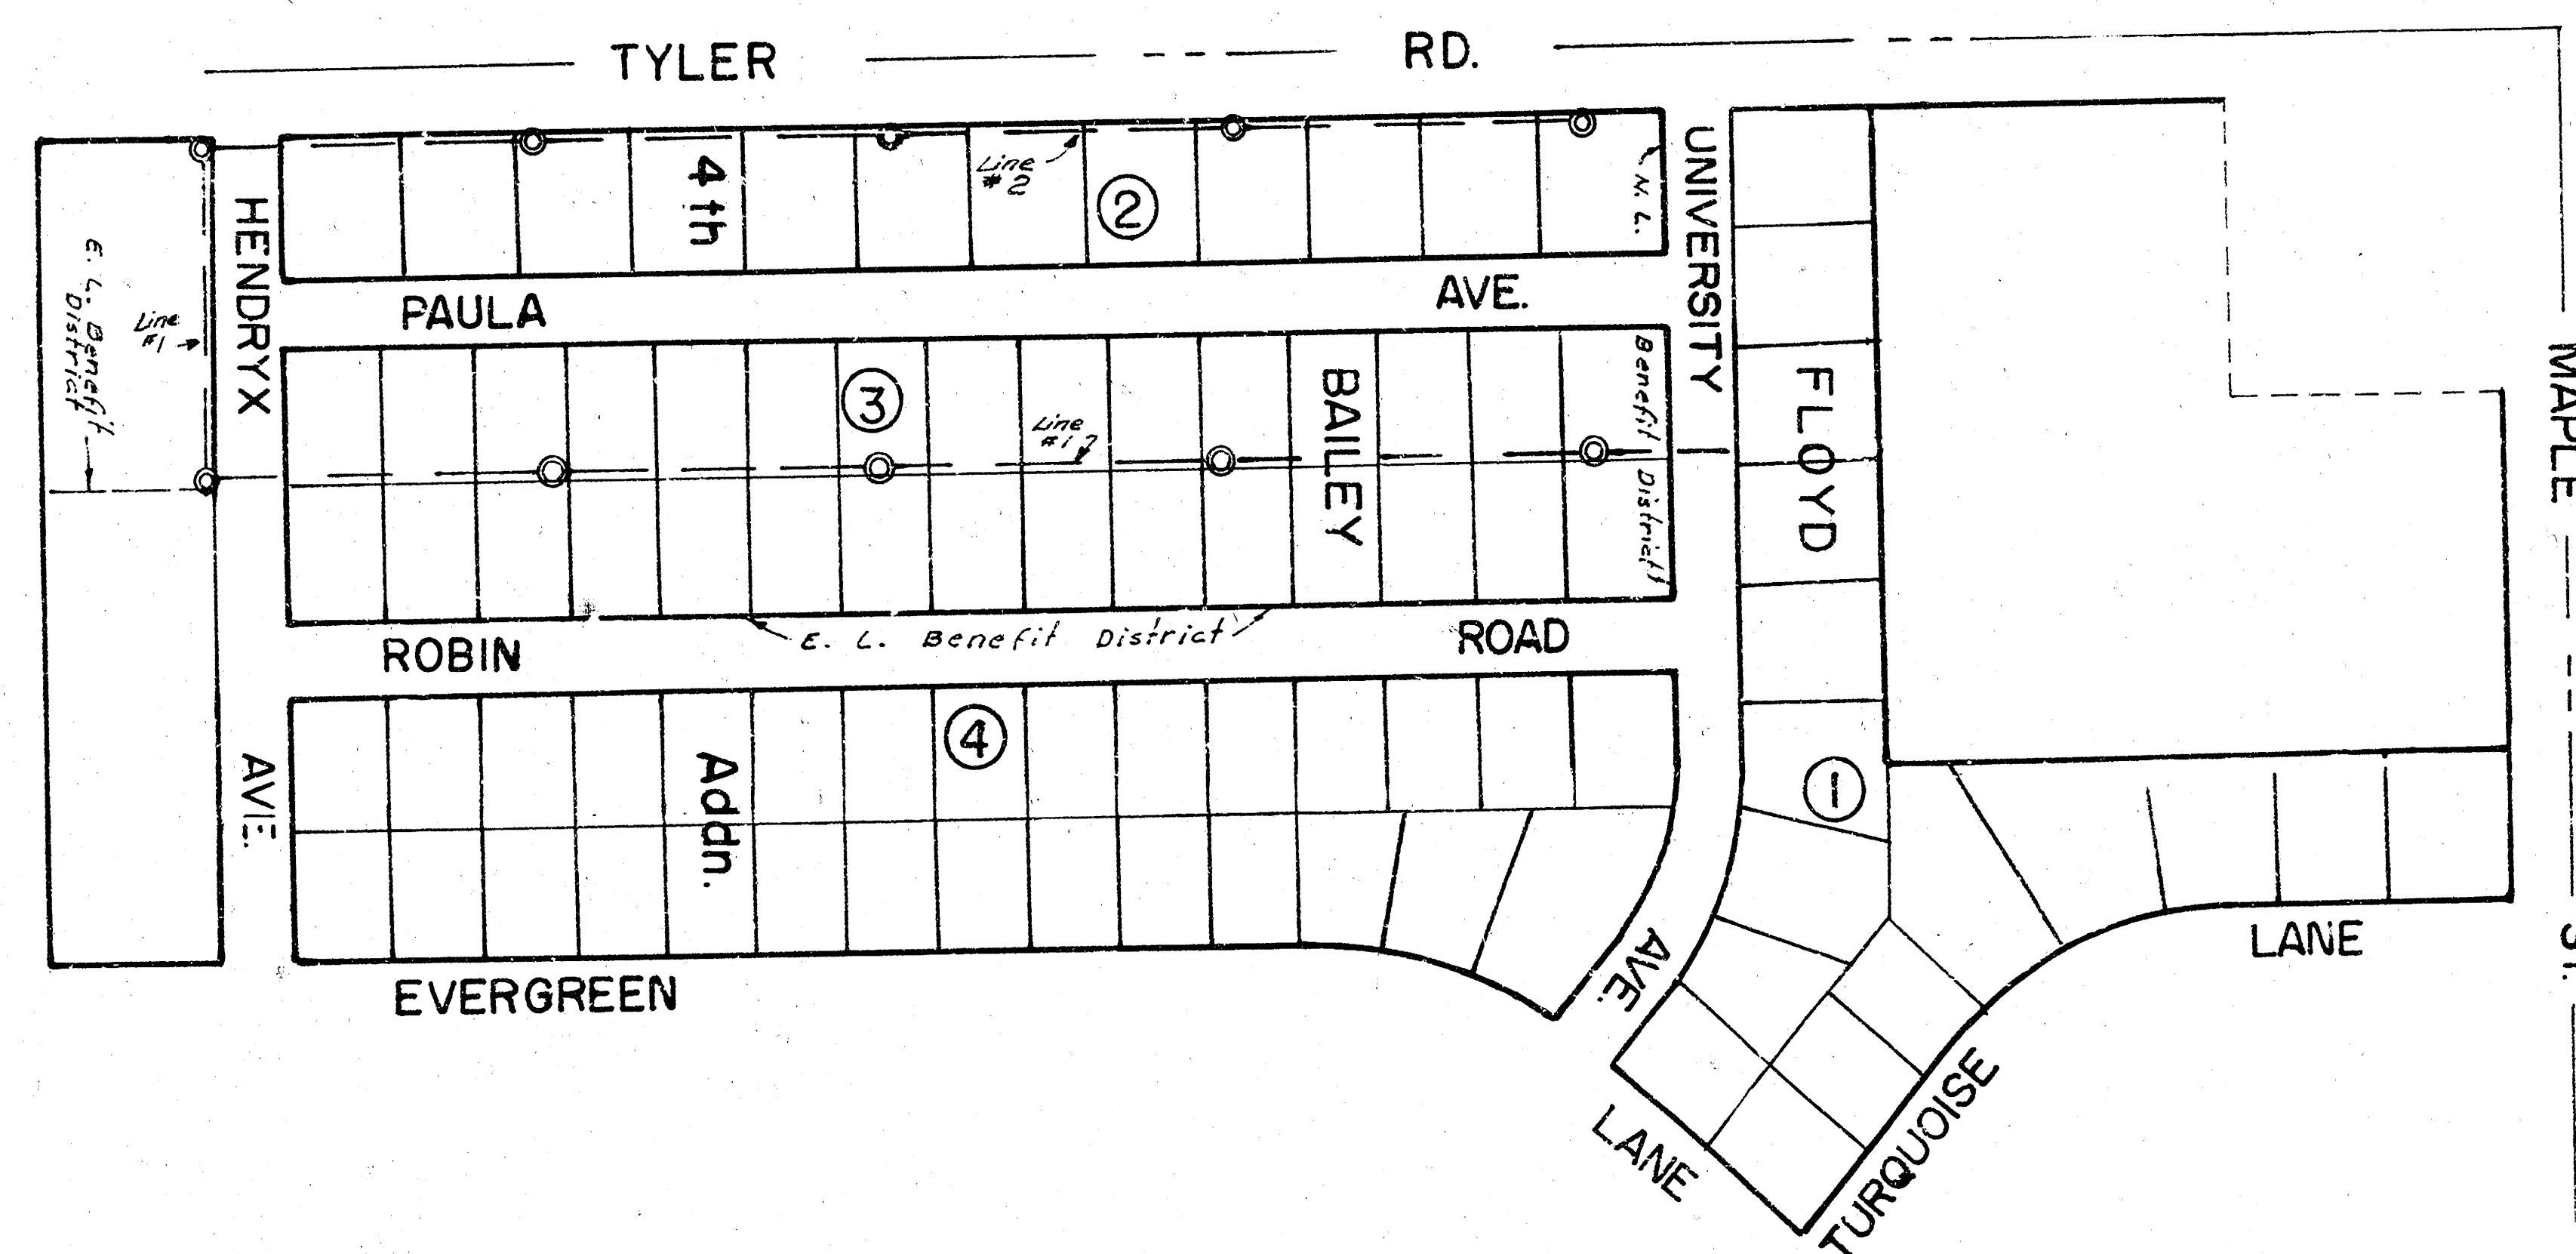
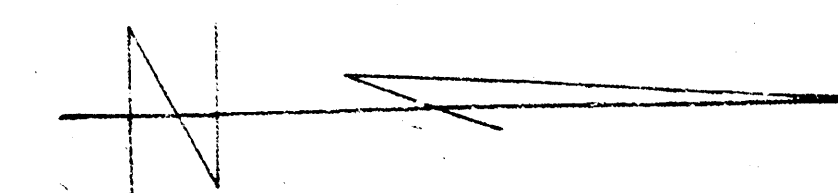



City of Wichita, Kansas

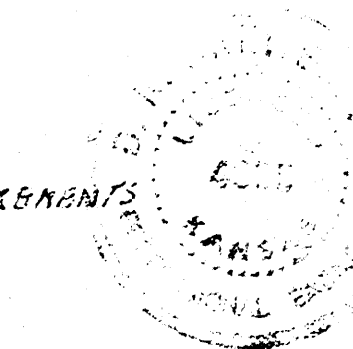

Line No.	Sheet No.
1	2 & 3
2	4



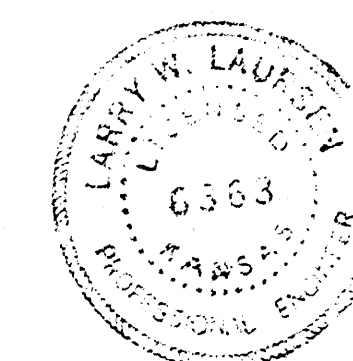




* AS BUILT * FINNL MORSURBANK
H-105

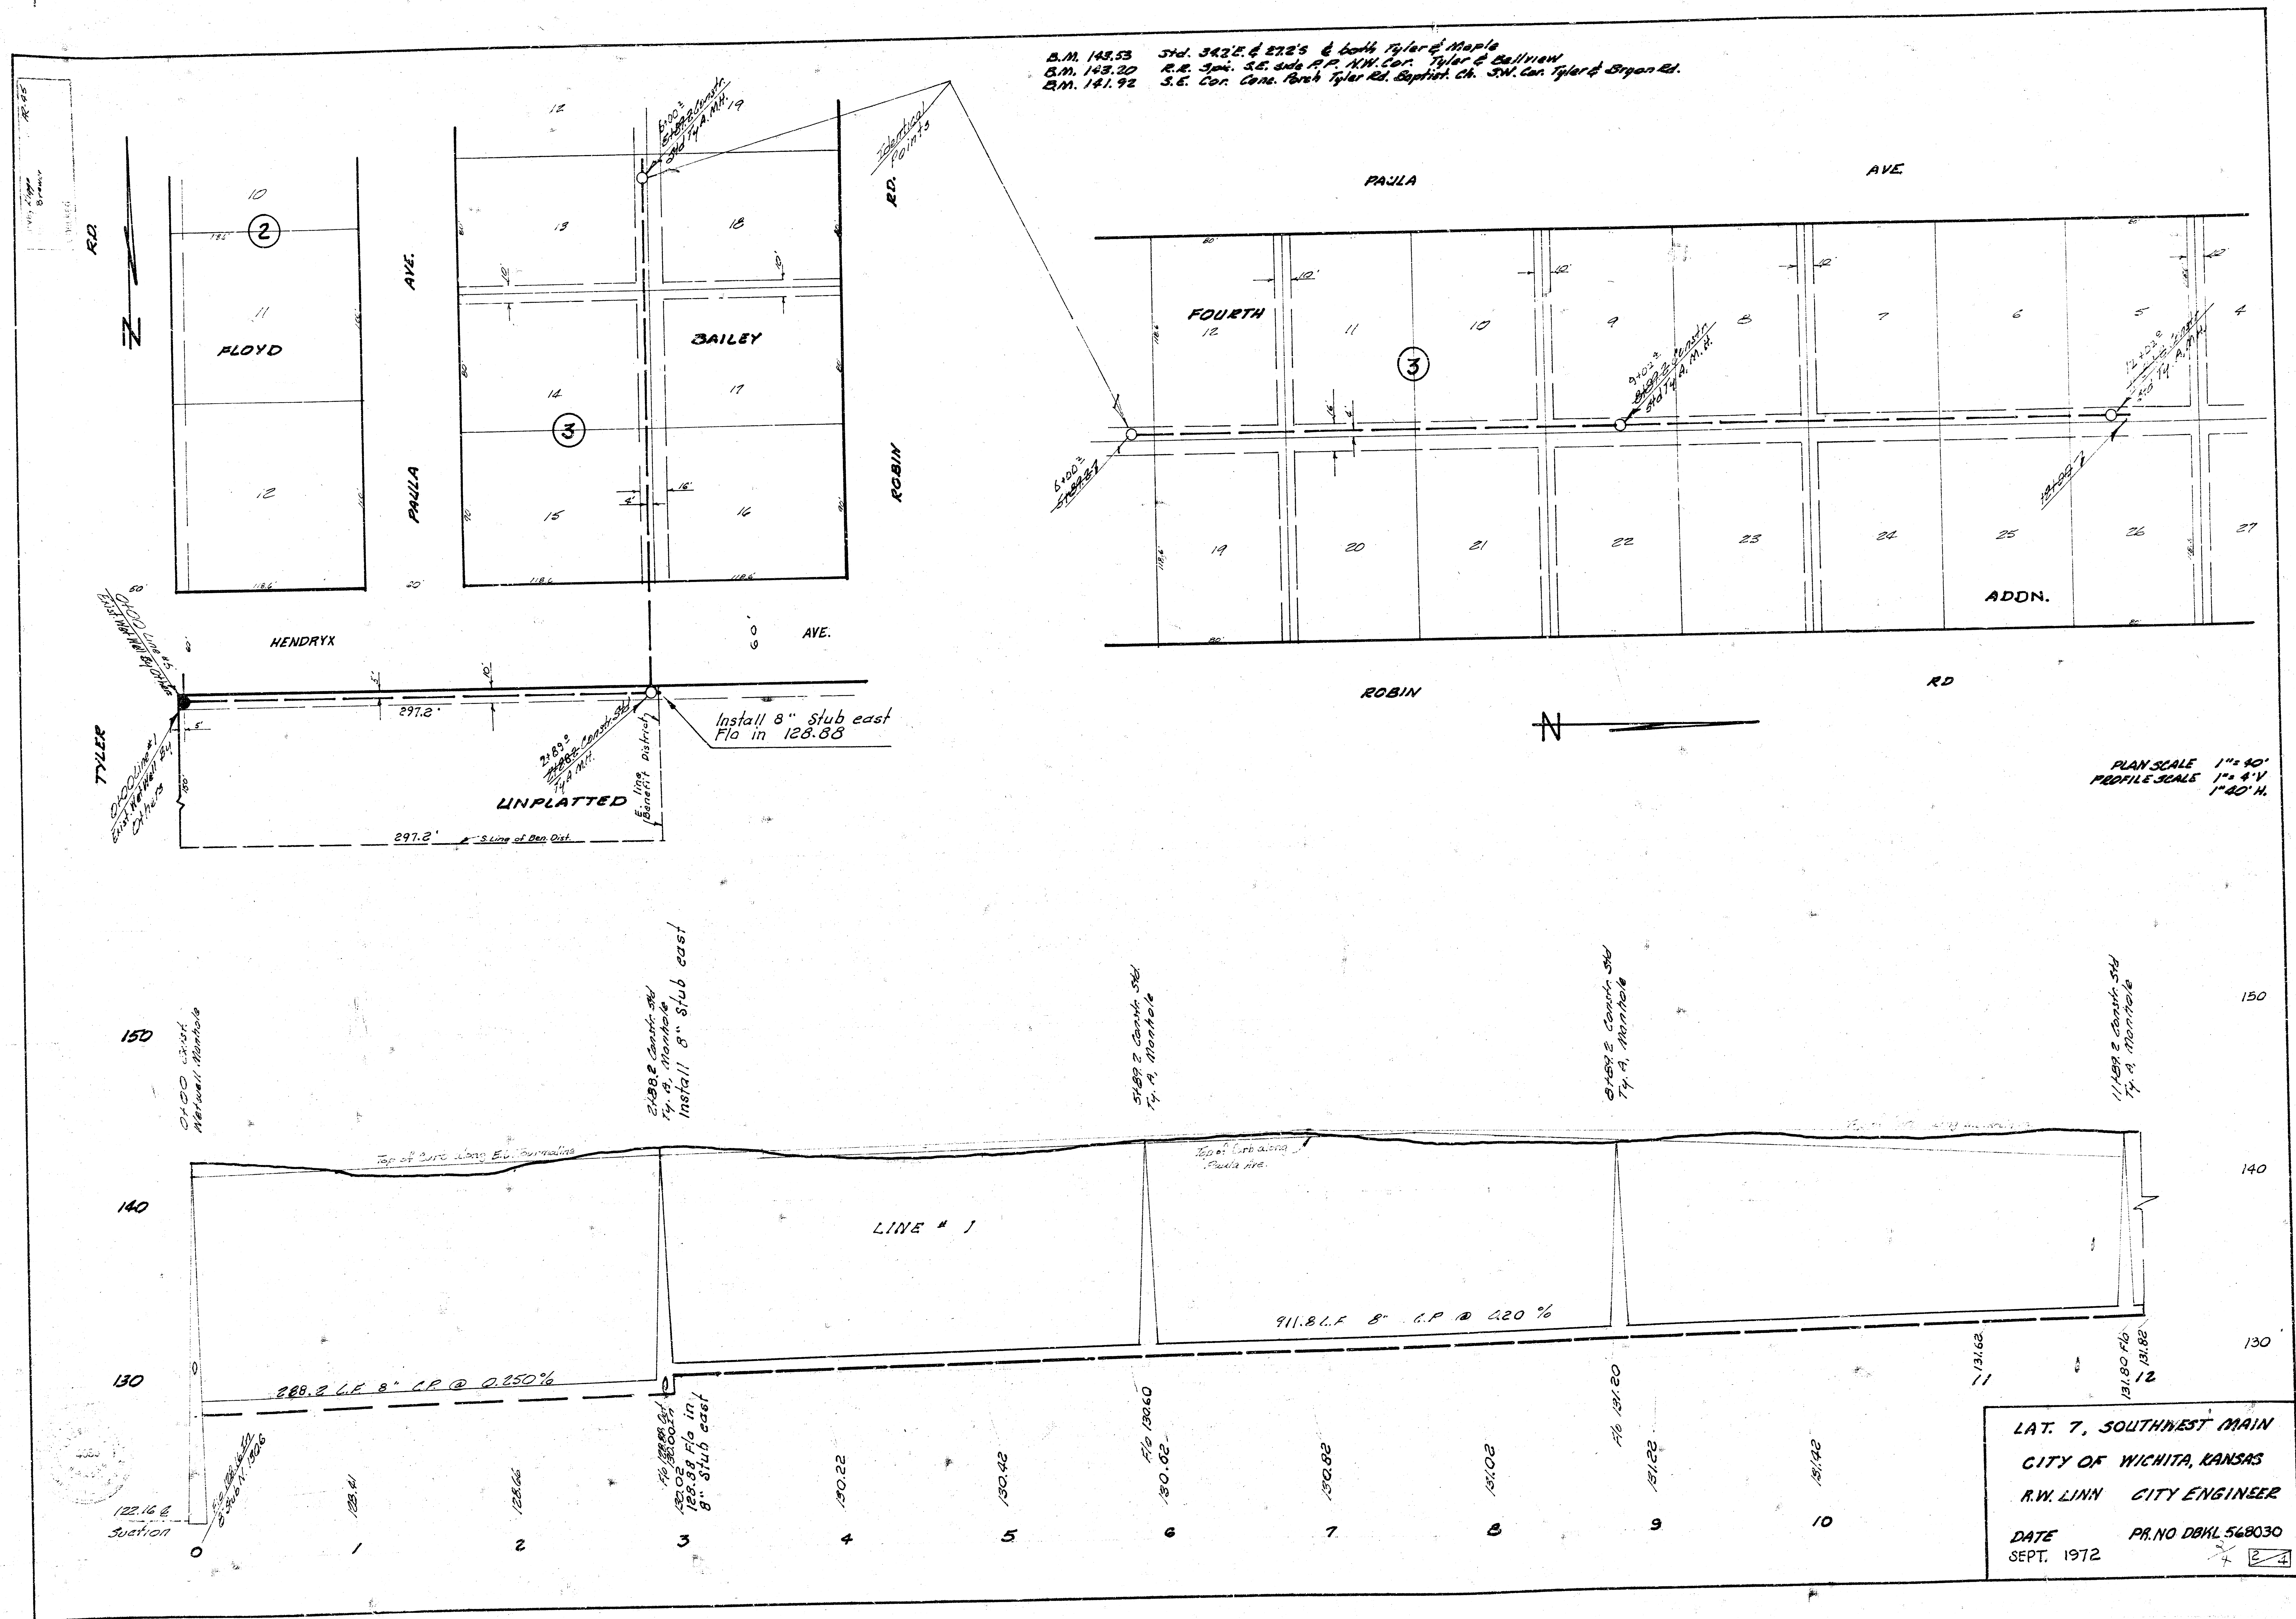

B.M. 143.53
 B.M. 143.20
 B.M. 141.92

Std. 342' E. of 272' S. & both Tyler & Maple
 R.R. 3rd. S.E. side R.P. NW. Cor. Tyler & Ballview
 S.E. Cor. Conc. Patch Tyler Rd. Baptist Ch. SW. Cor. Tyler & Bryan Rd.

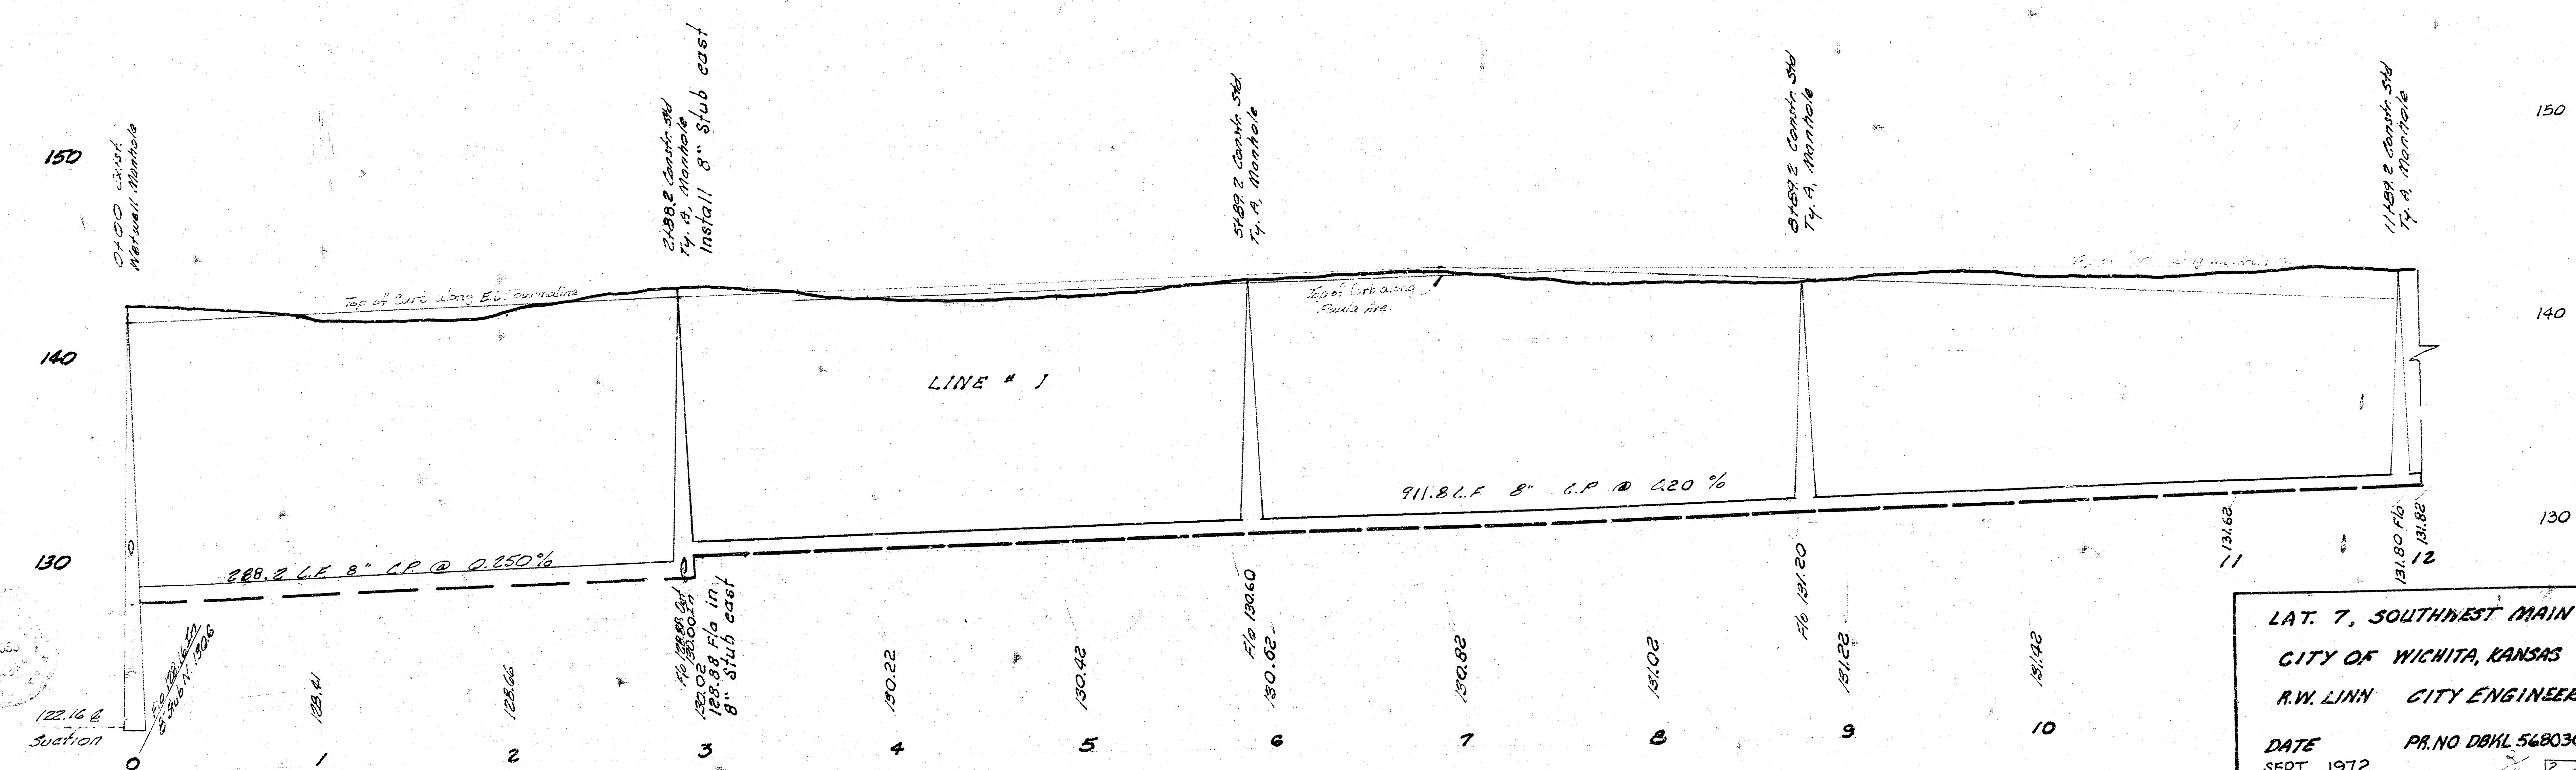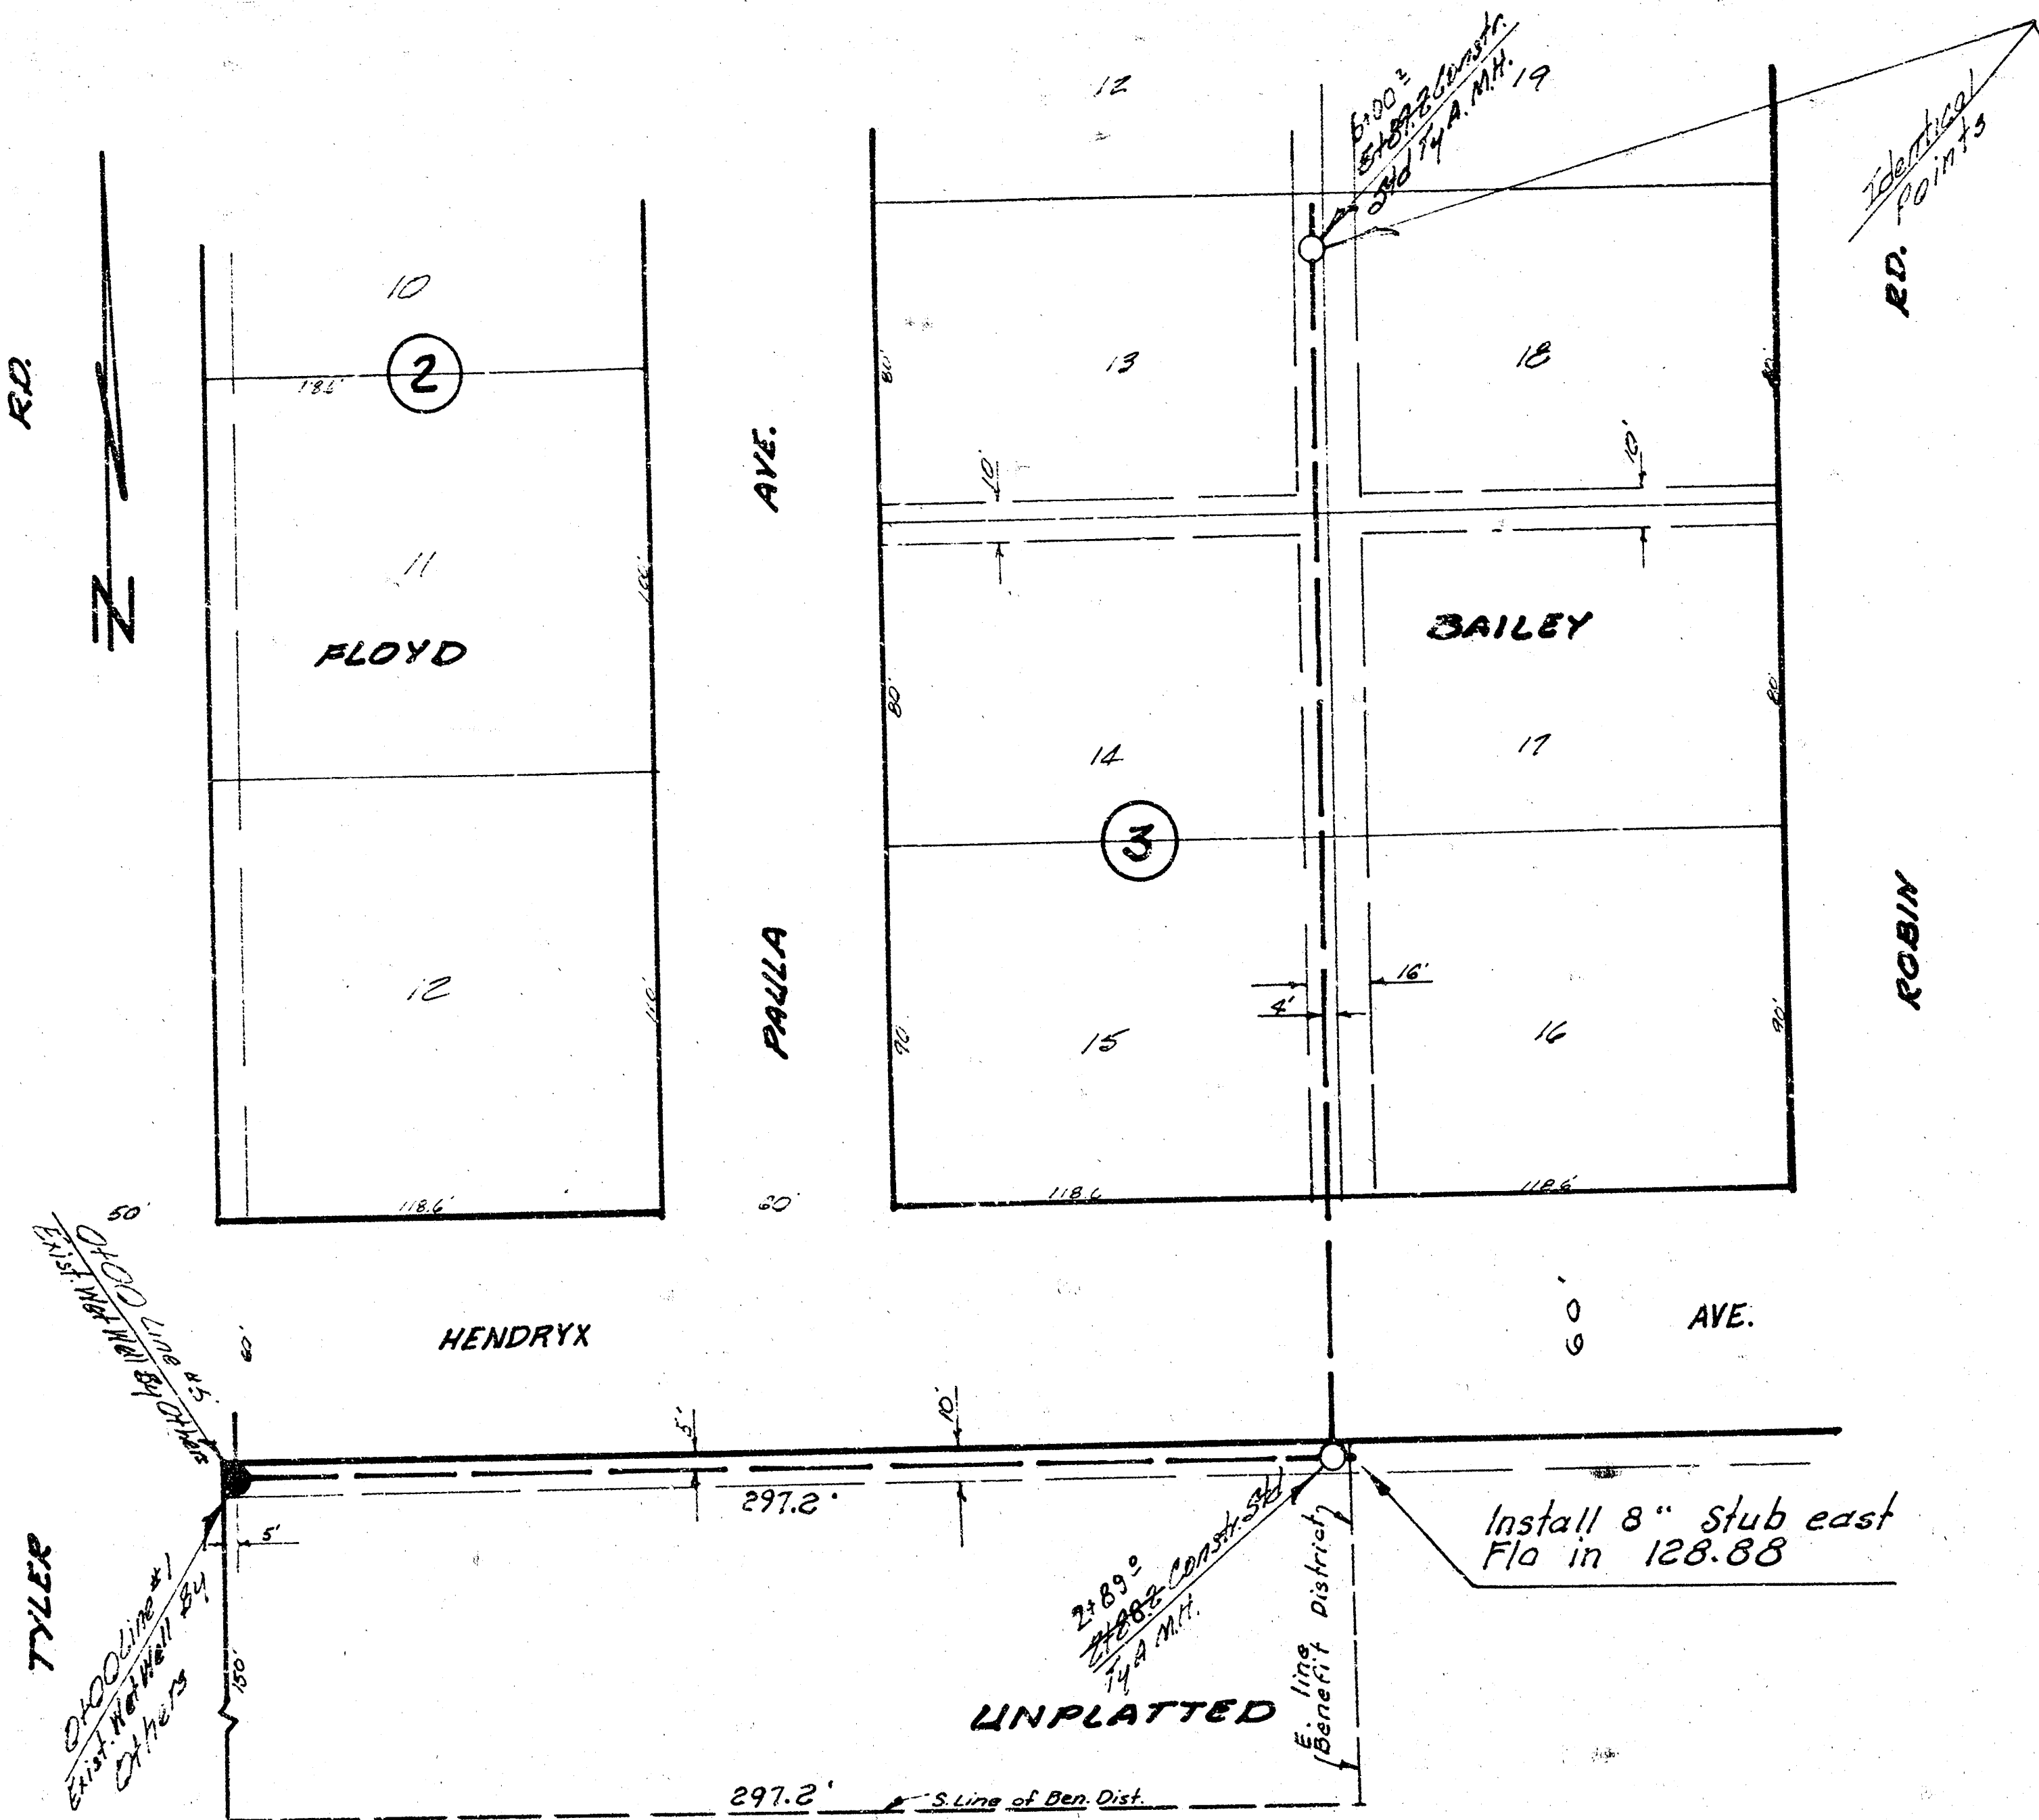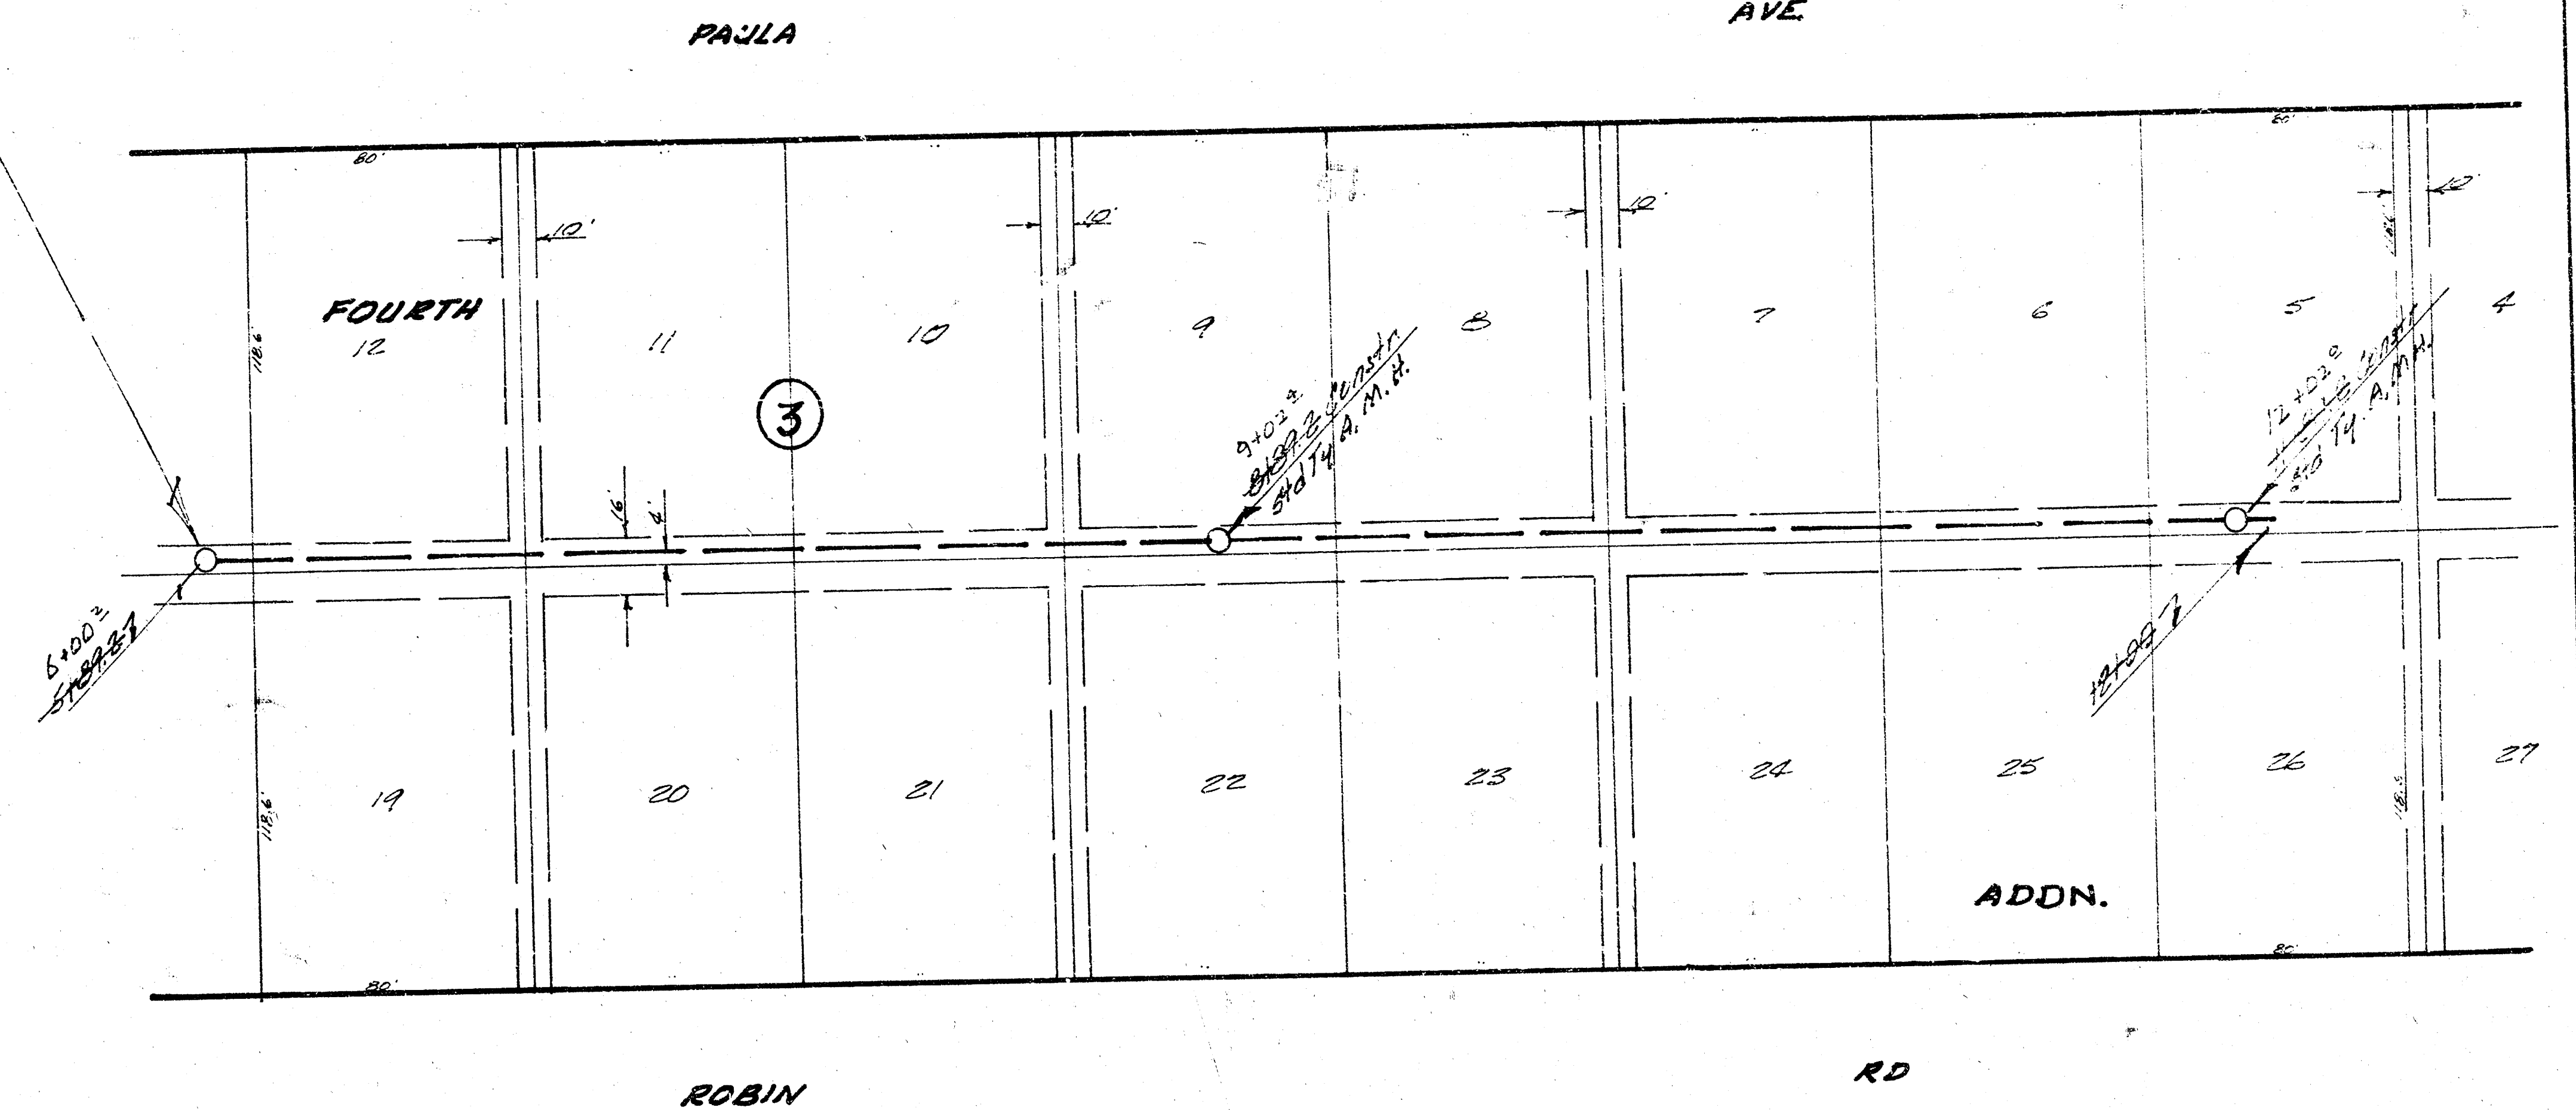

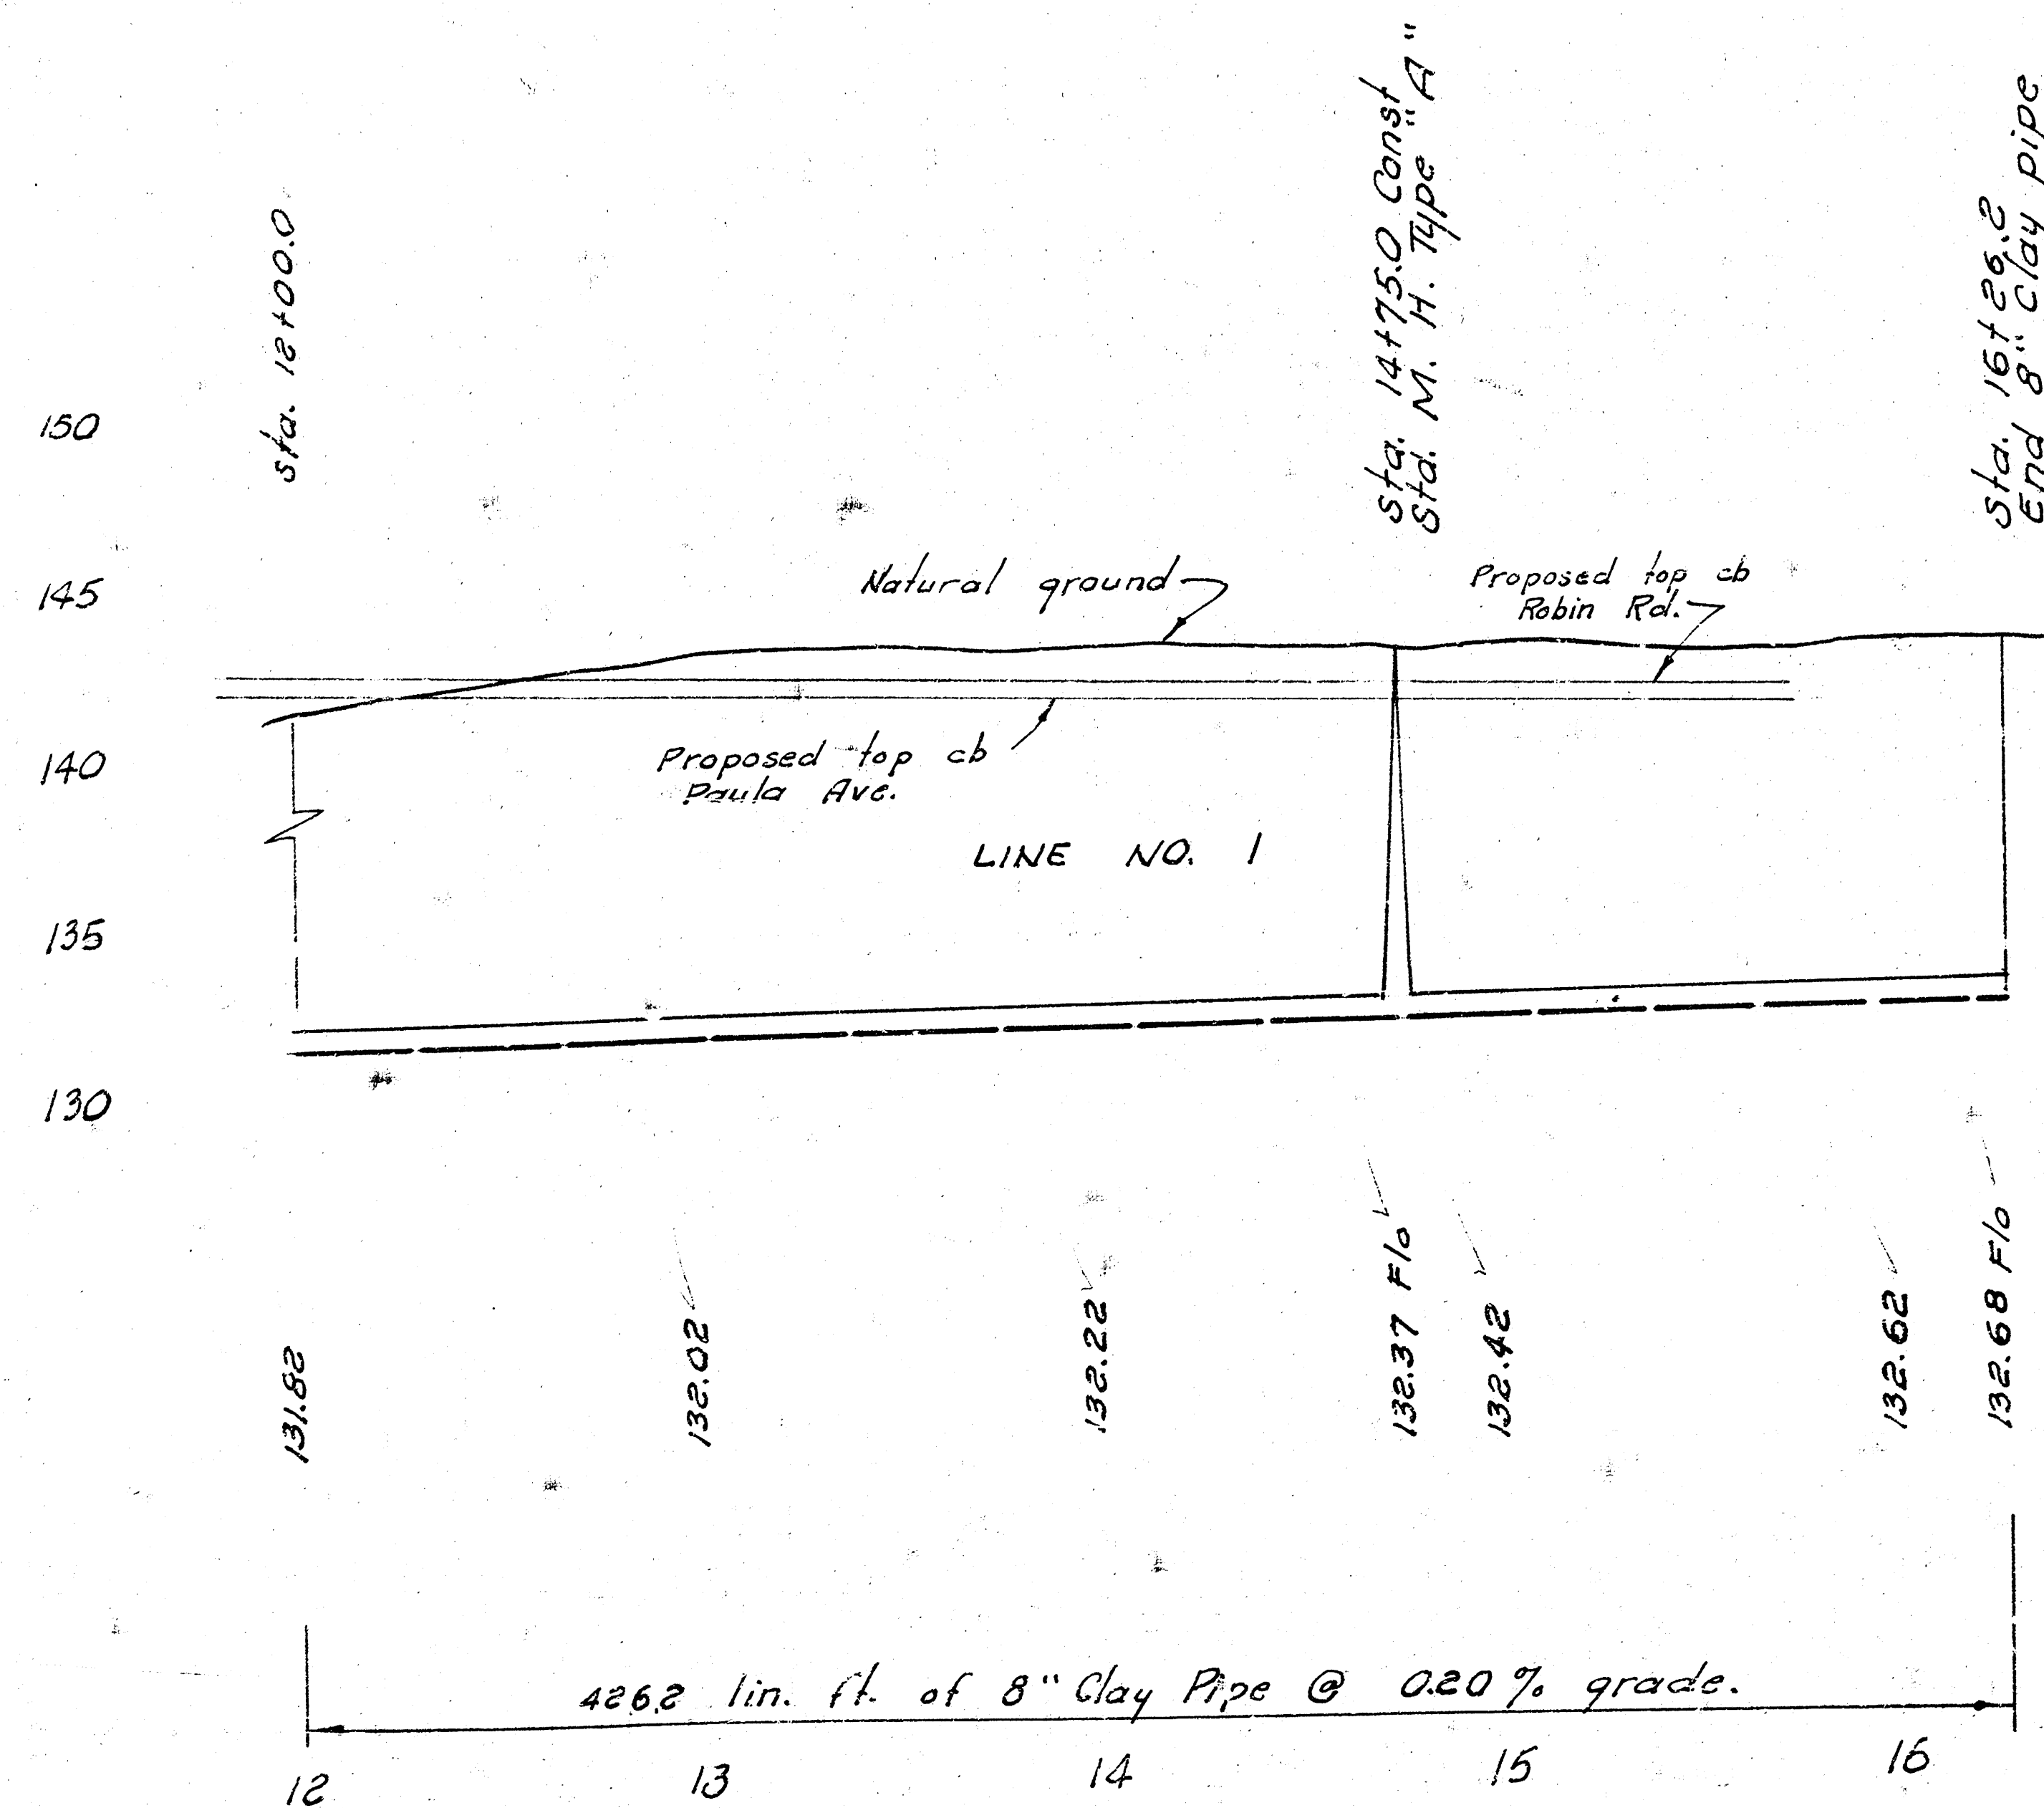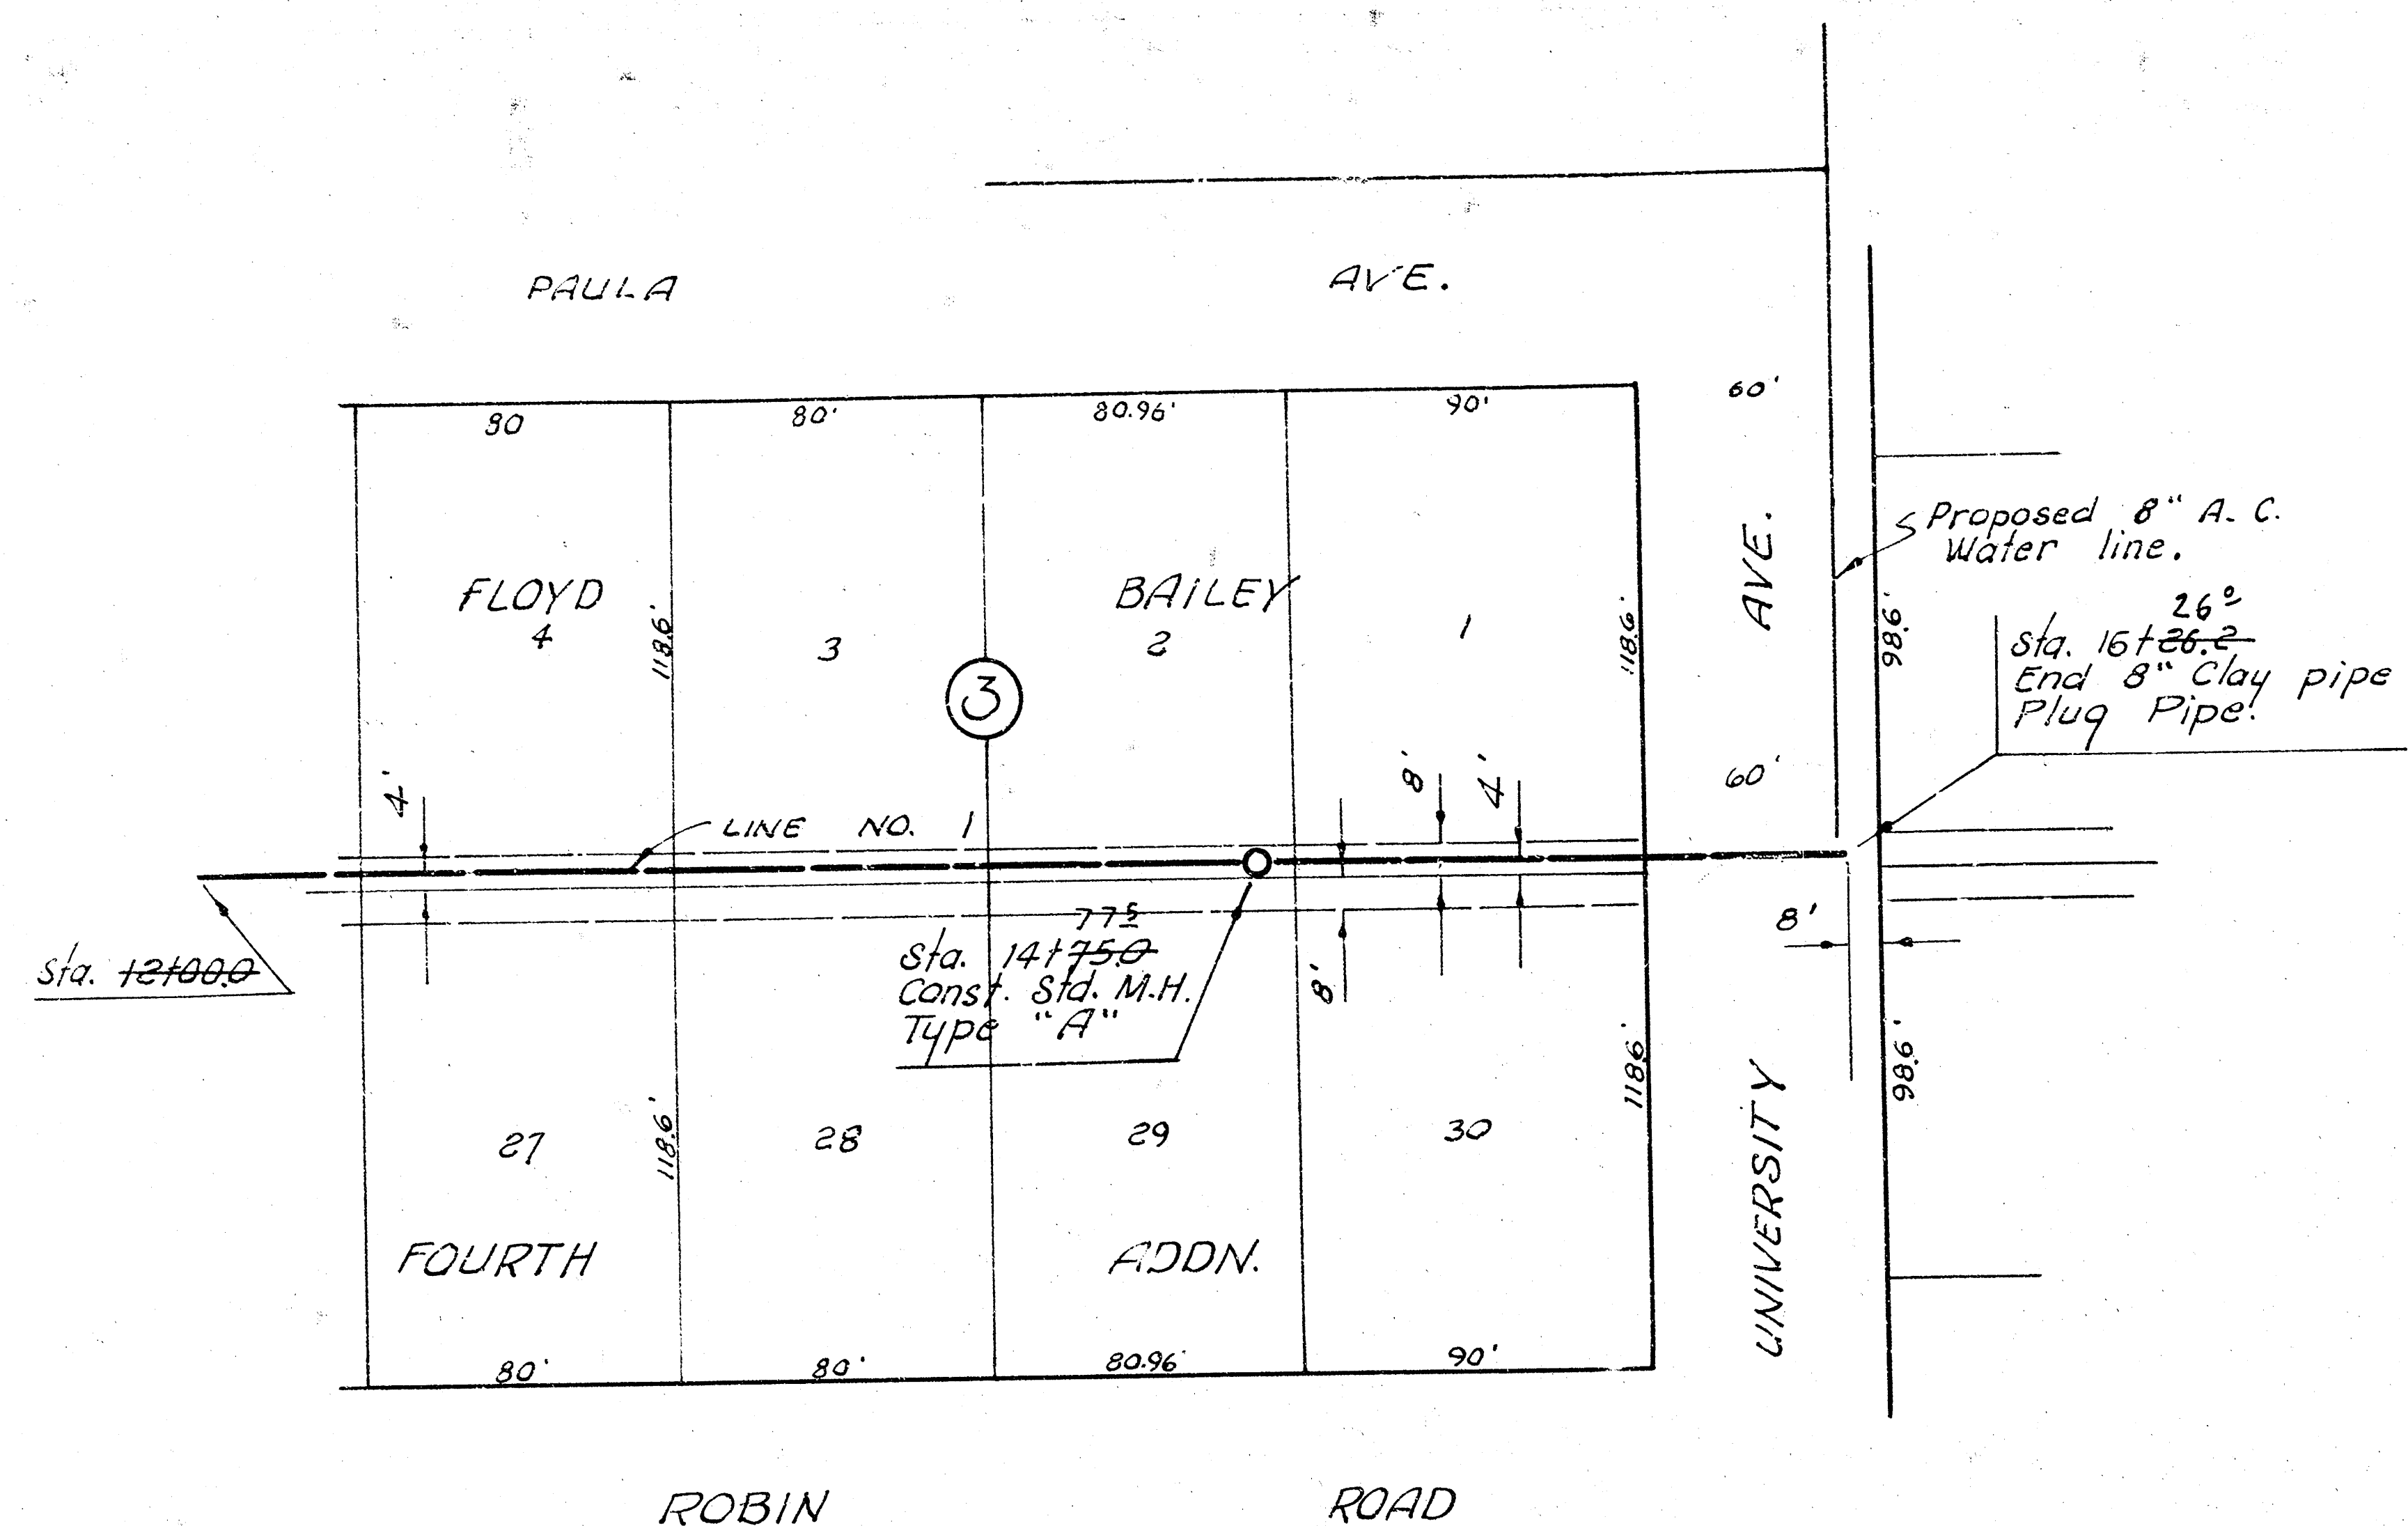

LAT. 7, S. W. MAIN
PROJECT NO. DBK L568030 3/4

