

Warehouse Bldg.

(A.M. Castle Co.)


Notes

1. All Elevations City of Wichita Datum
2. All construction to comply with City of Wichita specifications and standards.
3. Sewer lines to be inspected by the Dept. of Public Works Inspection.
4. Sand backfill and flush all sewer excavations.

NOTE TO CONTRACTOR
This project will be constructed under the supervision of the CITY ENGINEER and conforming to the SPECIFICATIONS of the CITY OF WICHITA. The CONTRACTOR will reimburse the City of Wichita for all cost of Engineering, Survey and Inspection.

APPROVED AS NOTED
By CITY ENGINEER OF WICHITA
Sanitary Sewers P.E.S.
Storm Sewers _____
Drainage Approaches _____

B.M. City Standard Disc, NW corner
Hydraulic and 31st Street South El. = 90.871

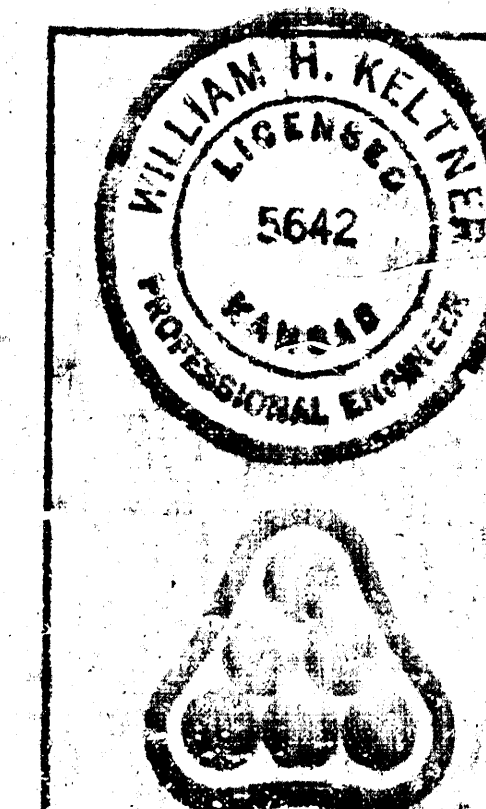

Revised Service Line	
1	Revised Easements
No.	Revision
50	1
Sanitary Sewer Extension A.M. Castle Company City Proj. No. DBKW 706002	
PROFESSIONAL ENGINEERING CONSULTANTS, P.C.	
ENGINEERS WICHITA, KANSAS	
Designed by <u>C.S.B.</u>	Job No. <u>76069</u>
Drawn by <u>C.L.</u>	Date <u>3/3/76</u>

Scale:
Plan: 1"=40'
Profile: Horiz: 1"=40'
Vert: 1"=5'

Install Cleanout

36" Tulsa Street

35'

Vacate Exist. San. Sewer Easement (Proposed)

Install 352 L.F., 8" VCP Service Line $s = .0\%$

Exist. 36" San. Sewer

35' 35' 5'

Exist. 50' M.H. 540.5' E. of @ Hydraulic

Install 33 L.F., 8" VCP

Sta. 0+40, Const. M.H. Type A or Type C, D=40'

Exist. 35' San. Sewer Easement to Remain

36" VCP SAN. SEWER
1913 ELEV. = 83.01
36" DRAINAGE MANHOLE
105' ELEV. = 85.12

Exist. Gnd

83.5
8" VCP SERV. LINE

33 L.F.
8" VCP
 $s = .0\%$