

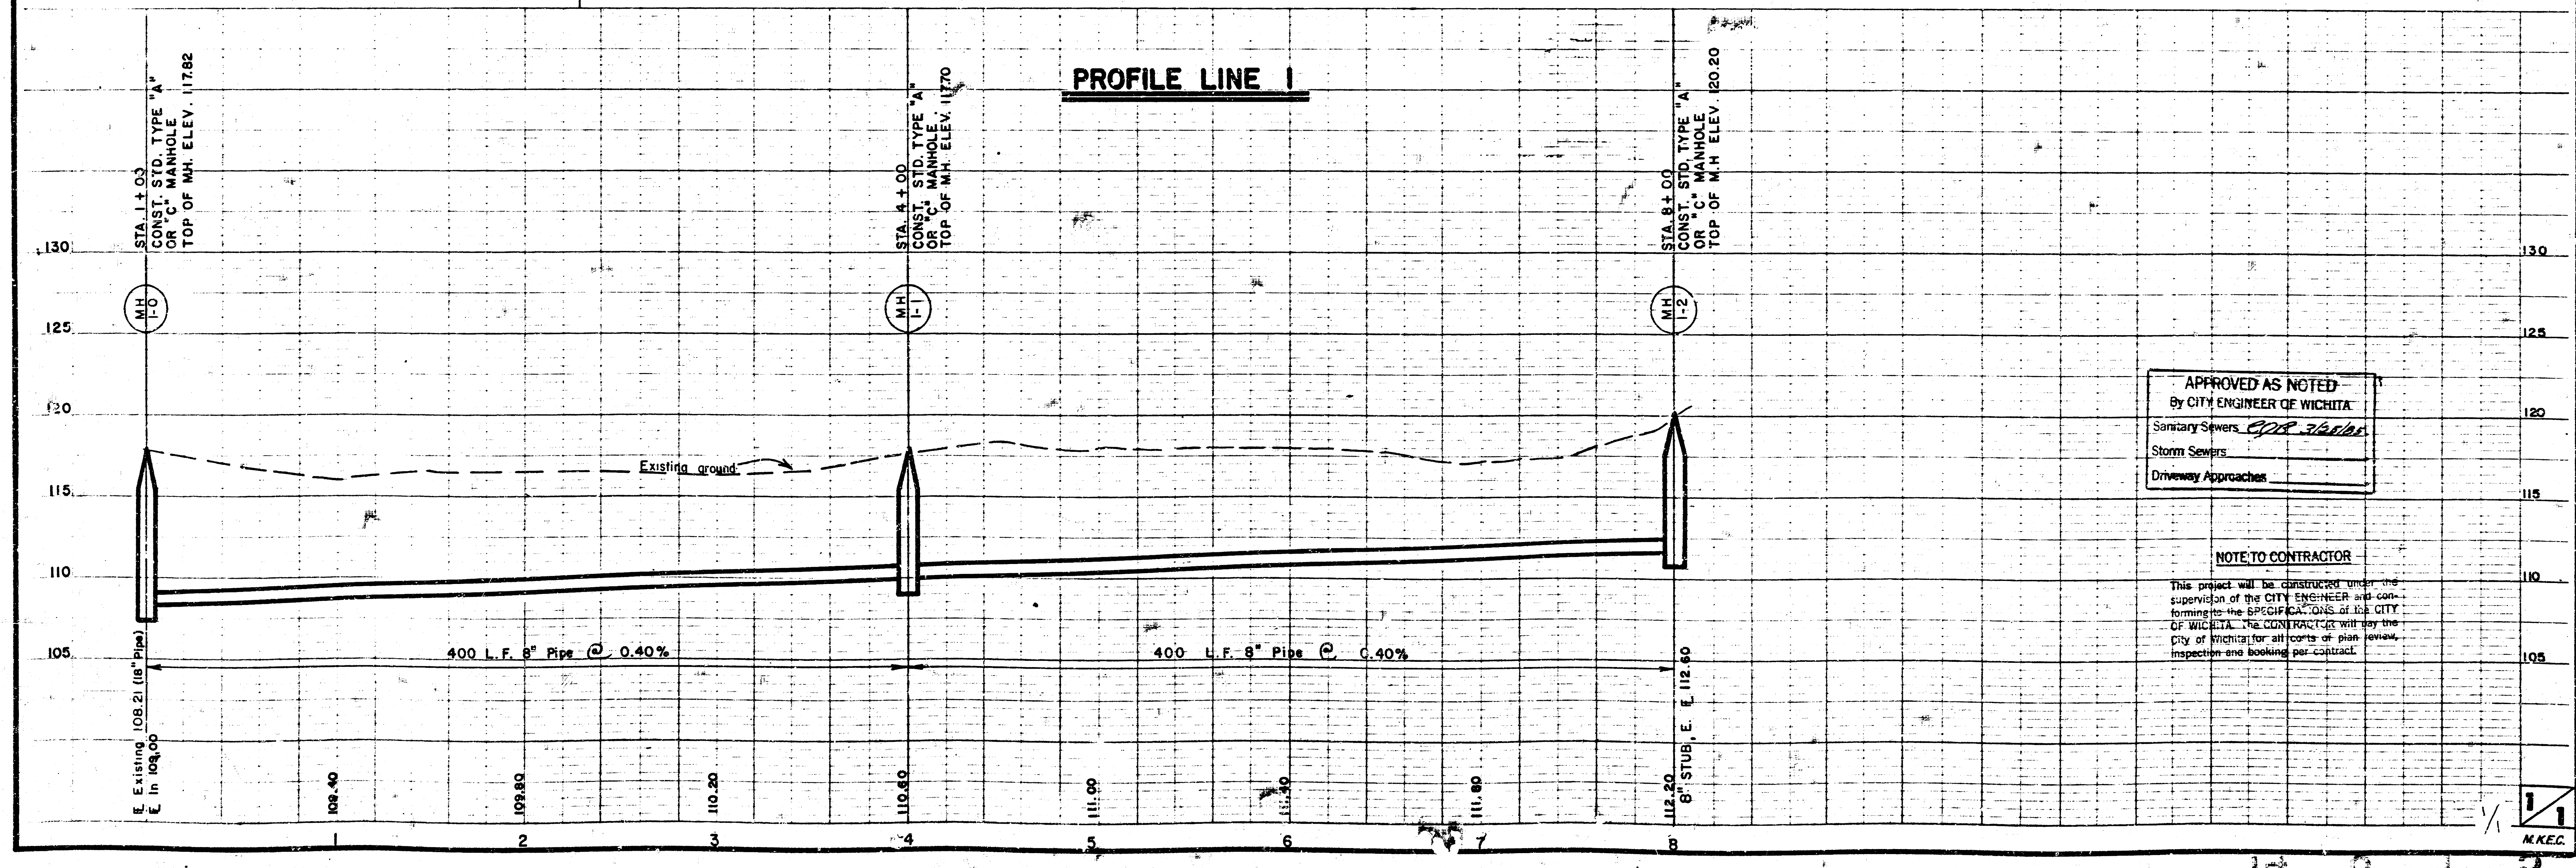
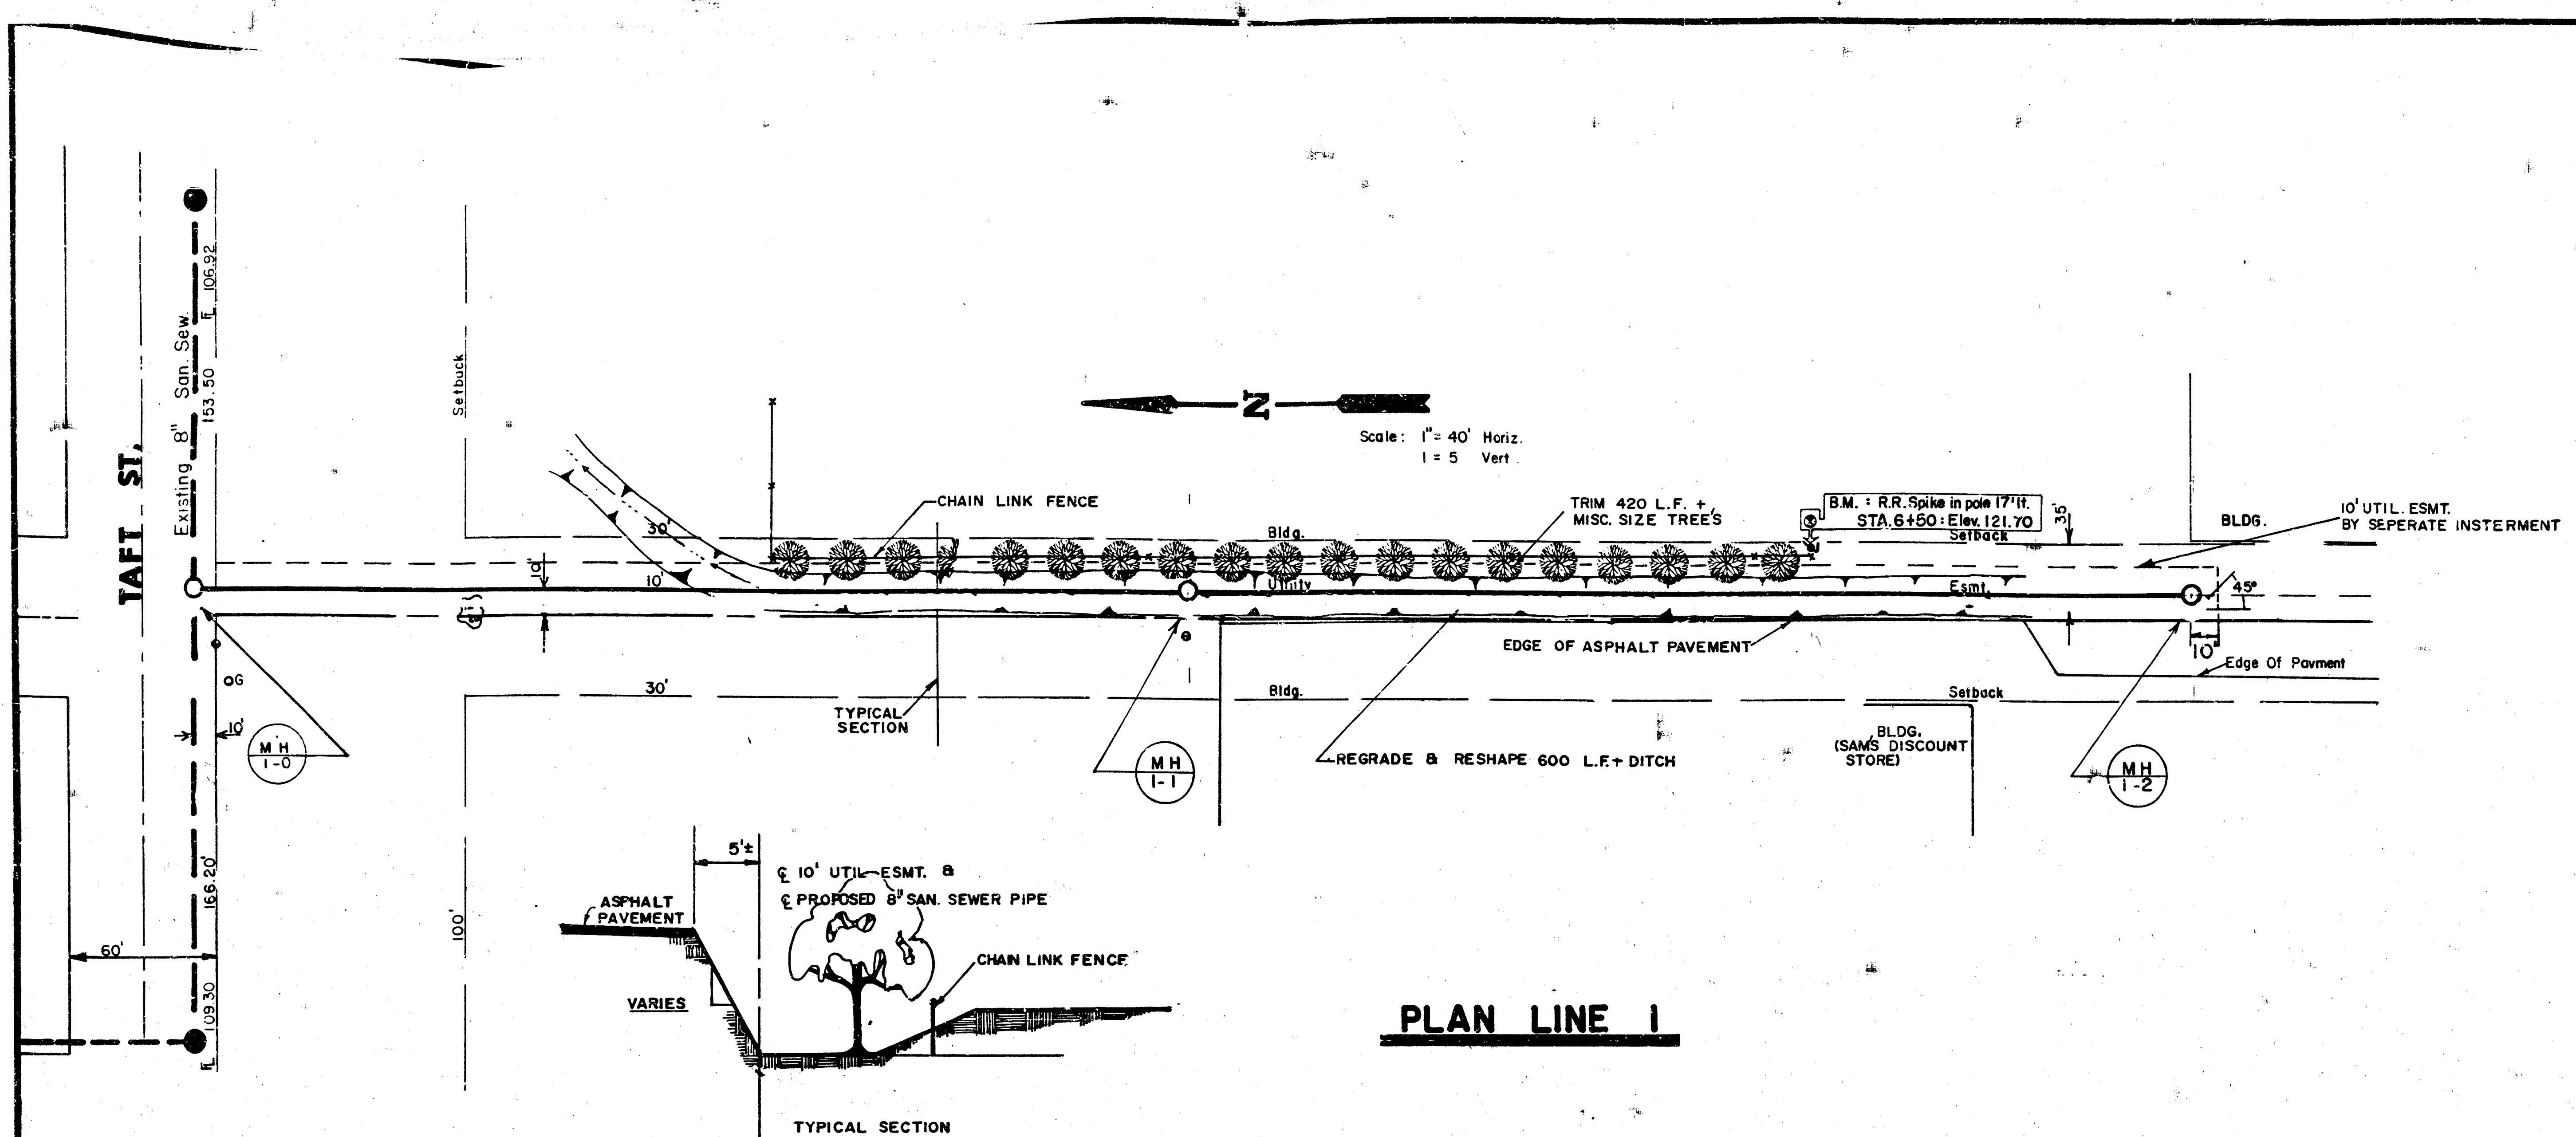
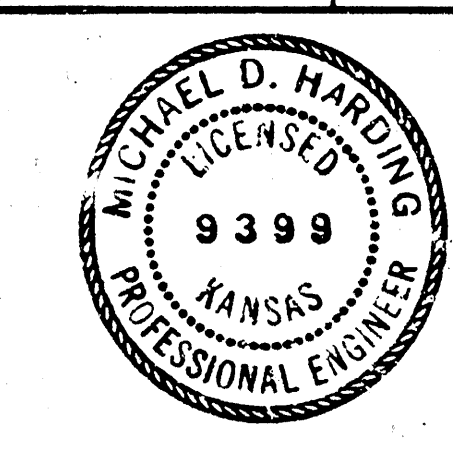


SERVING PART OF LOT 1
 AIR PARK THIRD ADDITION
 PROJ. NO. 46876-24580001-000-000-011

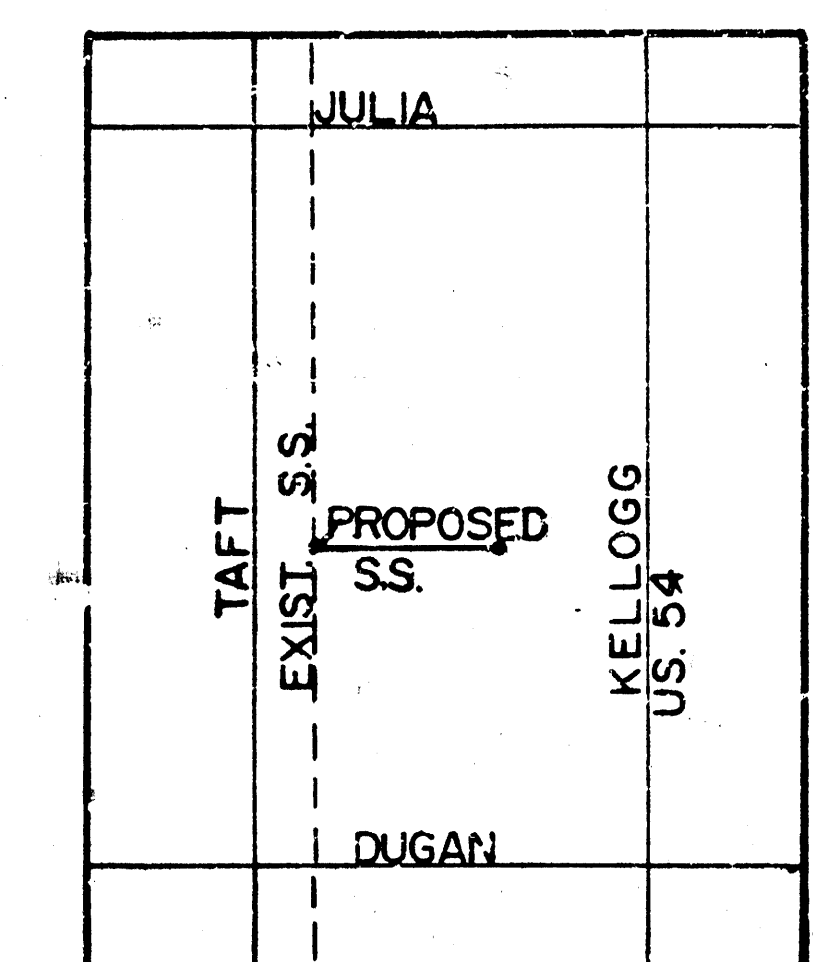

APPROVED AS NOTED
 By CITY ENGINEER OF WICHITA
 Sanitary Sewers *CPD 7/26/08*
 Storm Sewers
 Driveway Approaches

NOTE TO CONTRACTOR
 This project will be constructed under the supervision of the CITY ENGINEER and conforming to the SPECIFICATIONS of the CITY OF WICHITA. The CONTRACTOR will pay the City of Wichita for all costs of plan review, inspection and booking per contract.

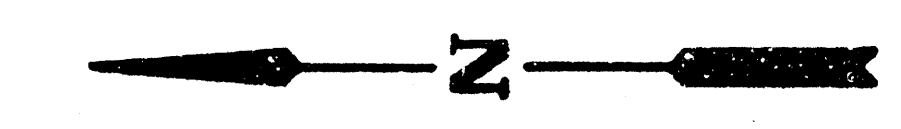