
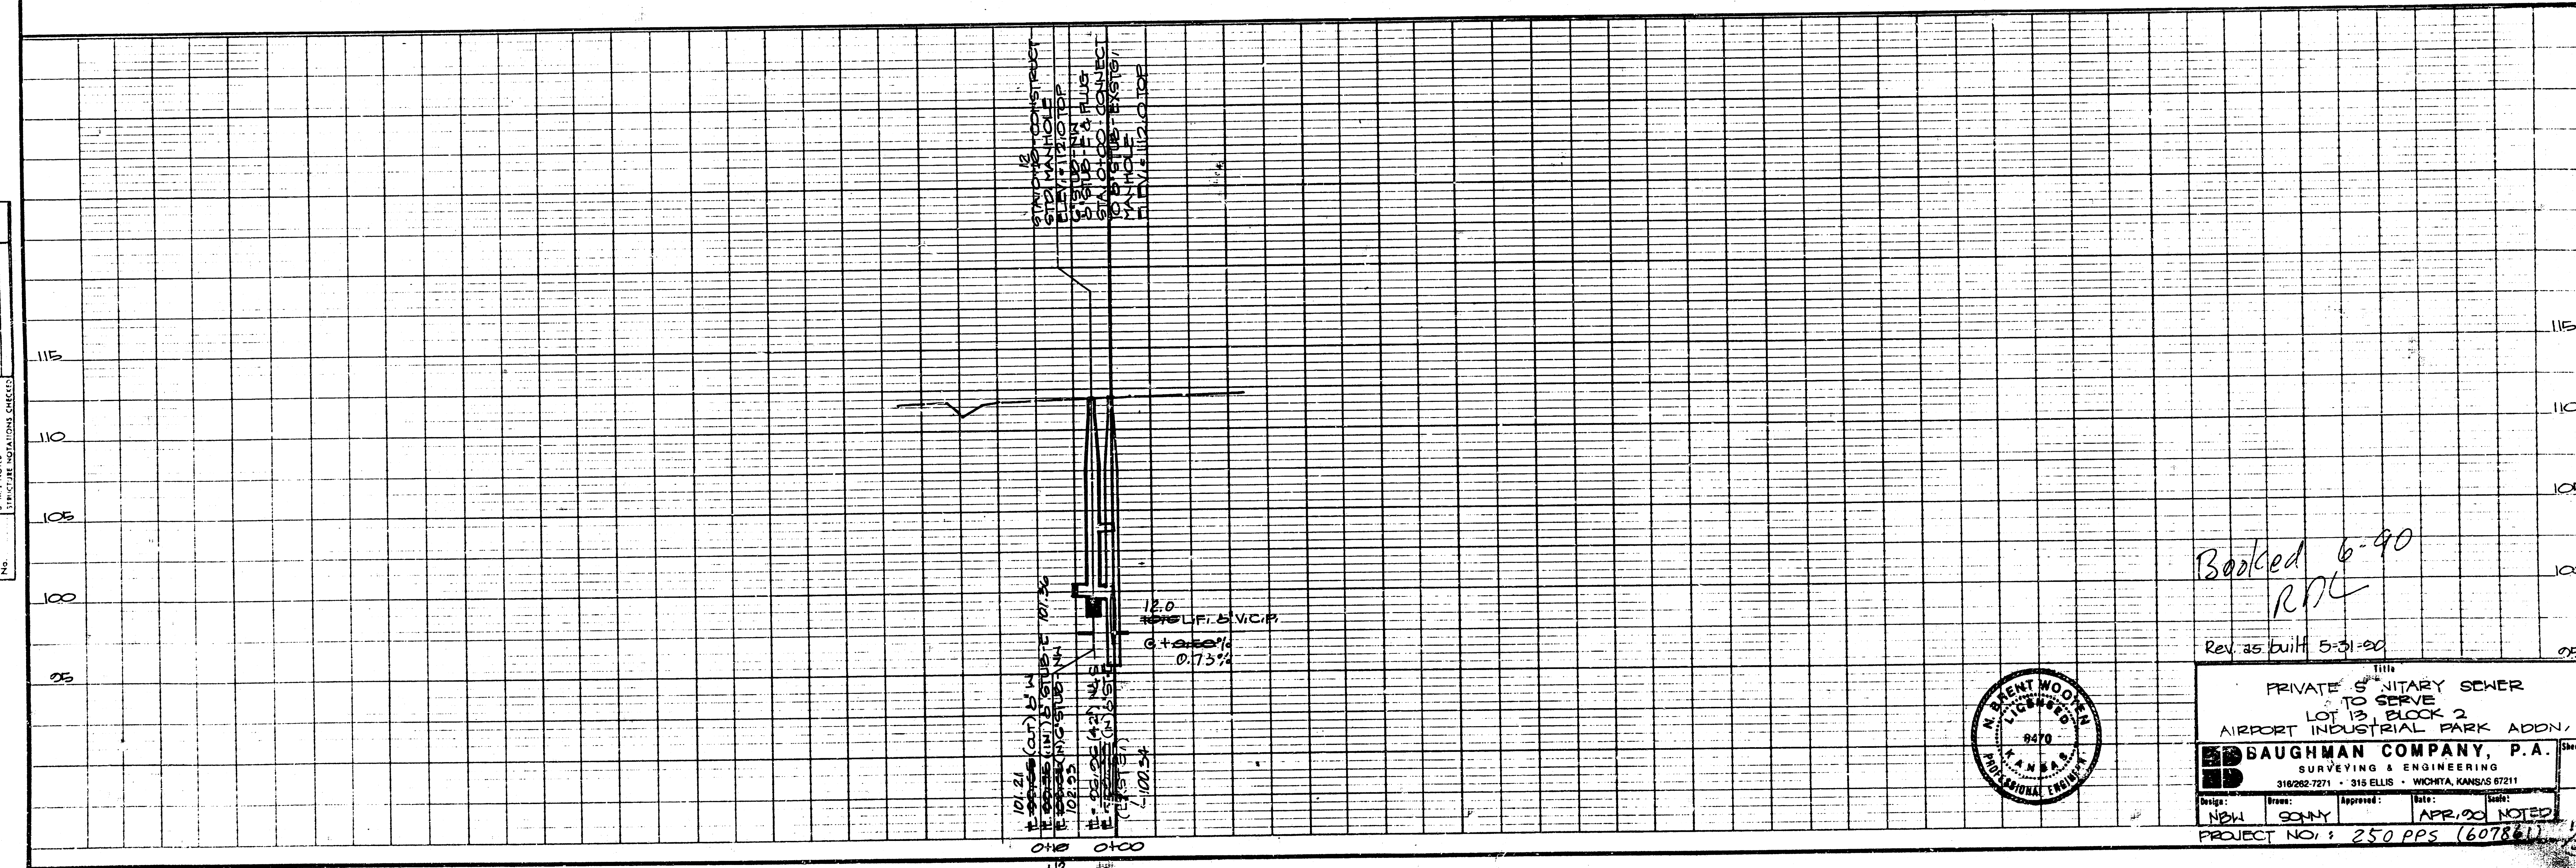


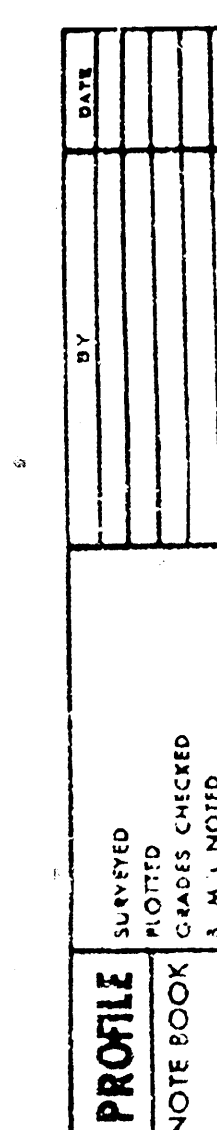

• BENCHMARKS •

1. CITY DISC - 44'S, & 45' W E
INTERSECTION HARRY ST, @
HOOVER RD,
ELEV. = 111, 24 C.D,
2. CITY DISC - 46' E & 5' S SEC,
1/4 COR., (E MAY AVE @ HOOVER RD,
ELEV. = 110, 57 C.D)

Booked 6-90
RNL
Rev. 35 built 5-31-90

11111



PRIVATE SECURITY SENSITIVE
 TO SERVE
 LOUISIANA BLOCK 2
 AIRPORT INDUSTRIAL PARK ADDN.

ED BAUGHMAN COMPANY, P.A. Sheet
 SURVEYING & ENGINEERING
 316262-7271 - 315 ELLIS - WICHITA, KANSAS 67211 of

Design: **NSM** Drawn: **SUNNY** Approved: **APR 20, 1982** Scale: **NOTED**

PROJECT NO.: **250 PPS (60786)**

AIRPORT INDUSTRIAL PARK ADDITION
(BLOCK 2)

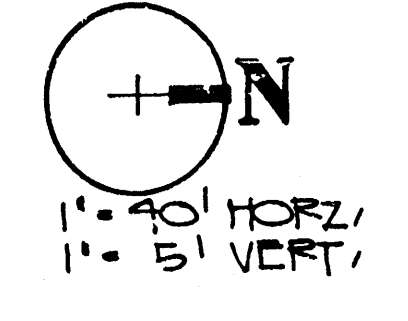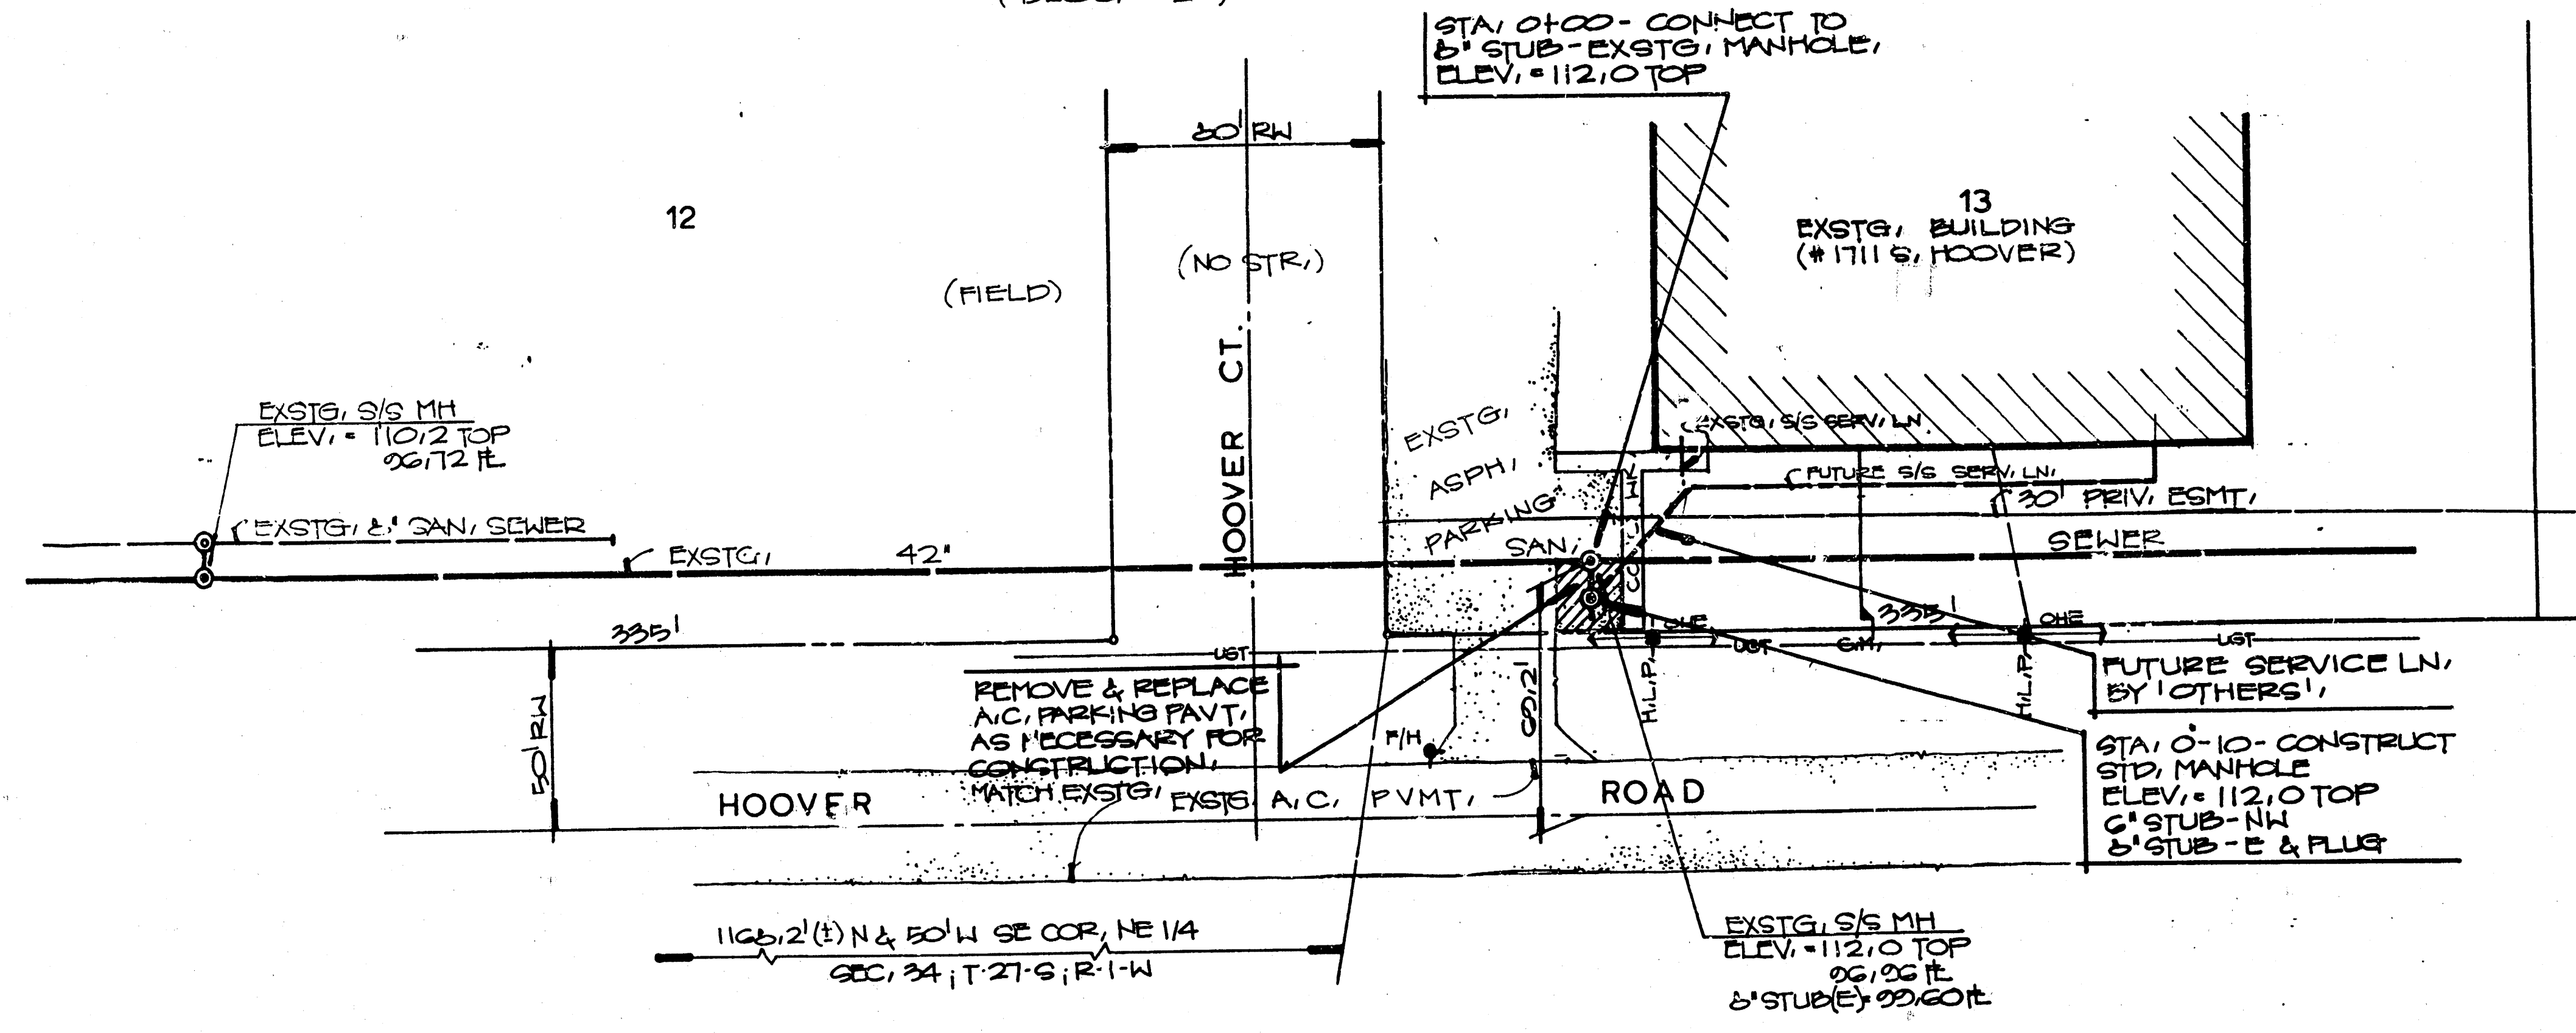



NOTE TO CONTRACTOR
INSPECTION AND TESTING FOR THIS PROJECT IS TO BE PROVIDED BY A LICENSED CONSULTING ENGINEERING FIRM UNDER CONTRACT WITH THE OWNER/DEVELOPER. SAID INSPECTION TO BE IN ACCORDANCE WITH THE CITY OF WICHITA STANDARDS. CONSTRUCTION ENGINEERING PRACTICES AND CERTIFIED BY A LICENSED PROFESSIONAL ENGINEER. NO WORK SHALL BE PERFORMED IN DEDICATED EASEMENTS OR THE PUBLIC RIGHT-OF-WAY BY THE CONTRACTOR WITHOUT SUCH INSPECTION AND SHALL ANY WORK BE COMMENCED IN DEDICATED EASEMENTS OR PUBLIC RIGHT-OF-WAY WITHOUT WRITTEN AUTHORIZATION BY THE CITY ENGINEER.

APPROVED AS NOTED
By CITY ENGINEER OF WICHITA
Sanitary Sewers VRH 5/7/90
Storm Sewers _____
Driveway Approaches _____
Water Mains _____

- BENCHMARKS**
- 1. CITY DISC - 44'S. & 46'W. E. INTERSECTION HARRY ST. @ HOOVER RD.
ELEV. = 111.24 C.D.
 - 2. CITY DISC - 46'E & 5'S SEC. 14 COR. (E MAY AVE @ HOOVER RD.)
ELEV. = 110.57 C.D.

PLAN	DATE	BY
NOTED		
REVIEWED		
APPROVED		

PROFILE	DATE	BY
NOTED		
REVIEWED		
APPROVED		

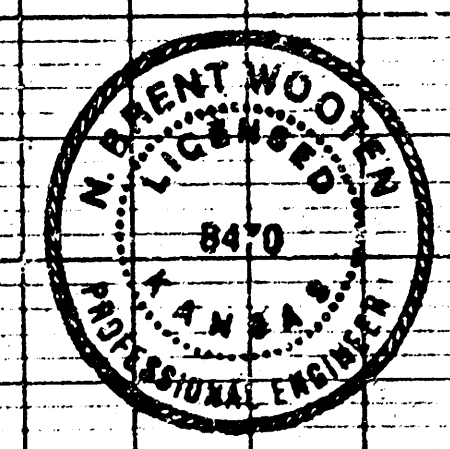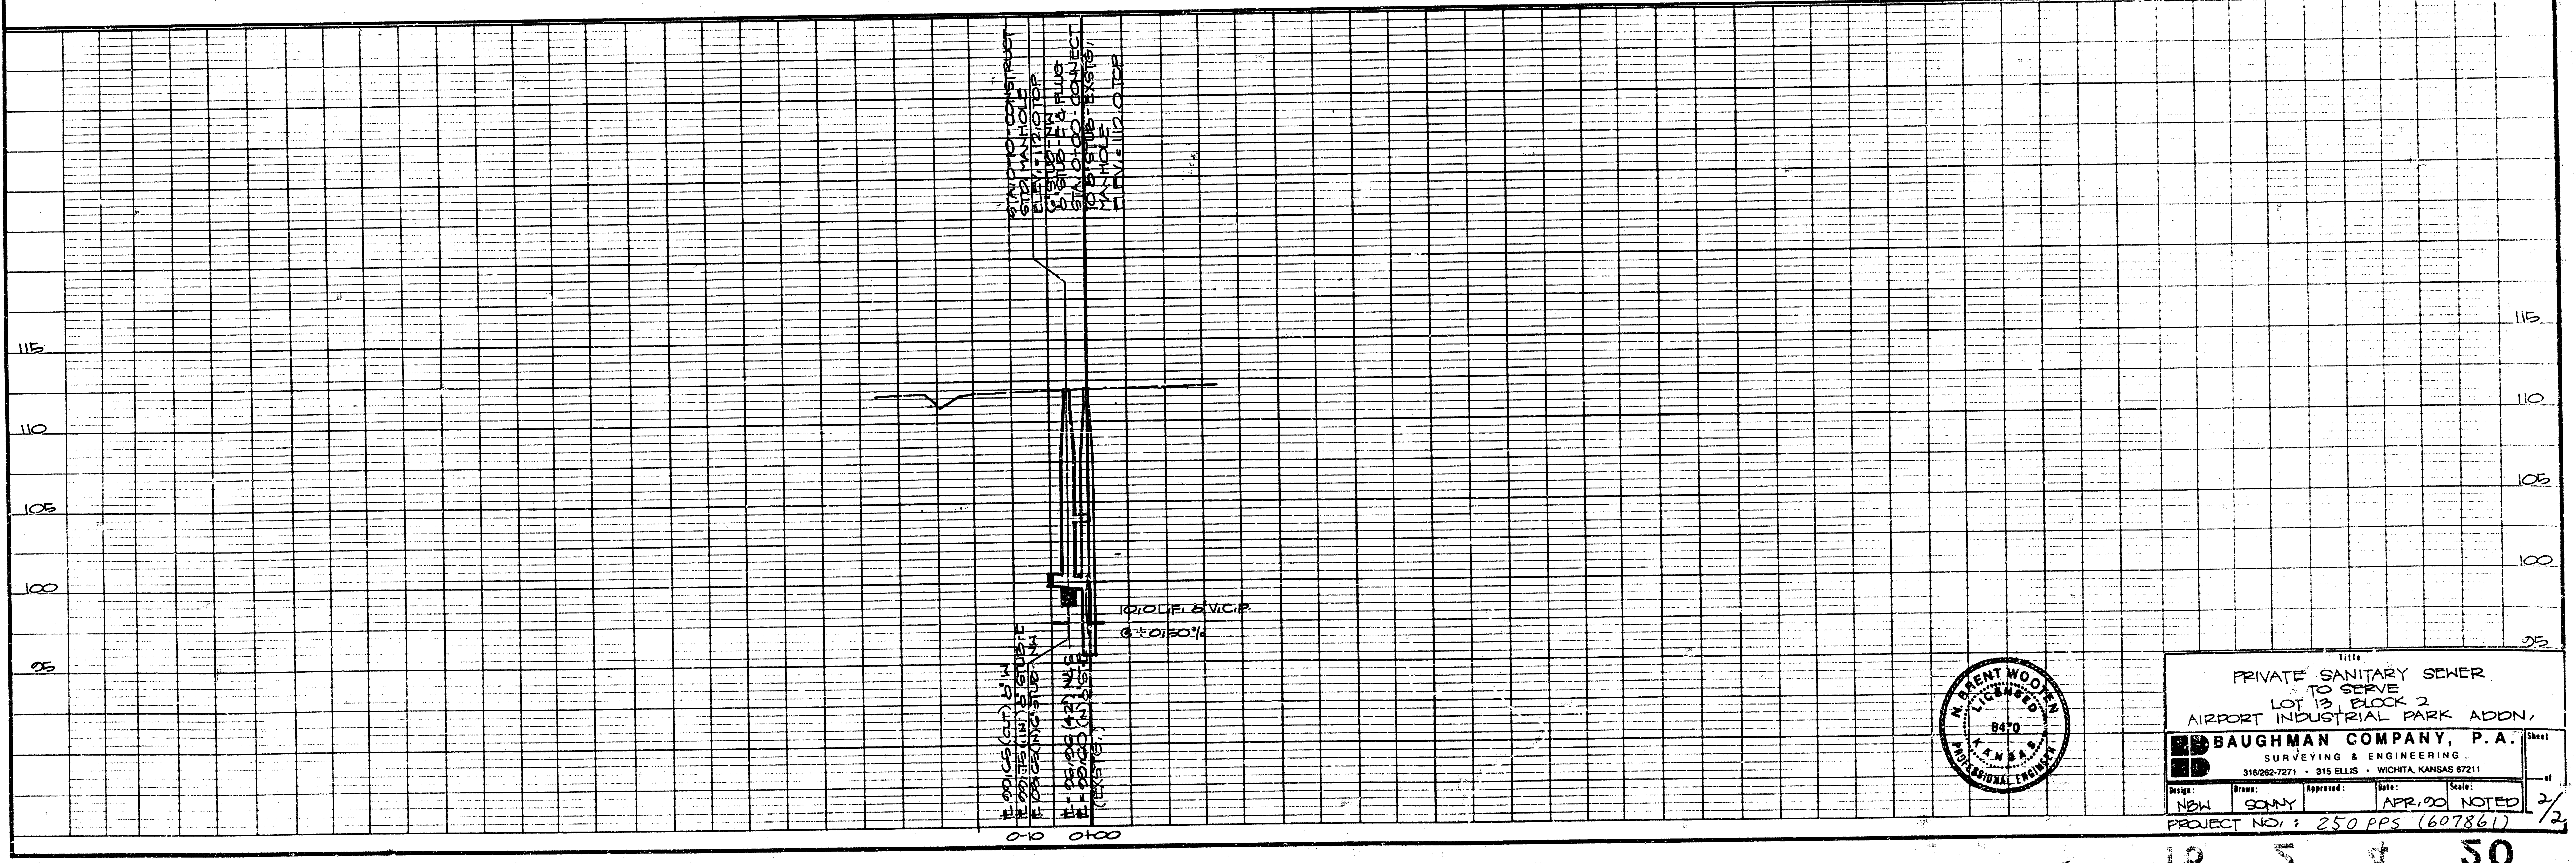

PRIVATE SANITARY SEWER
TO SERVE
LOT 13, BLOCK 2
AIRPORT INDUSTRIAL PARK ADDN.

BAUGHMAN COMPANY, P.A.
SURVEYING & ENGINEERING
318/262-7271 • 315 ELLIS • WICHITA, KANSAS 67211

Design: NDH Drawn: SONNY Approved: APR 90 Scale: NOTED
PROJECT NO.: 250 PPS (607861)