


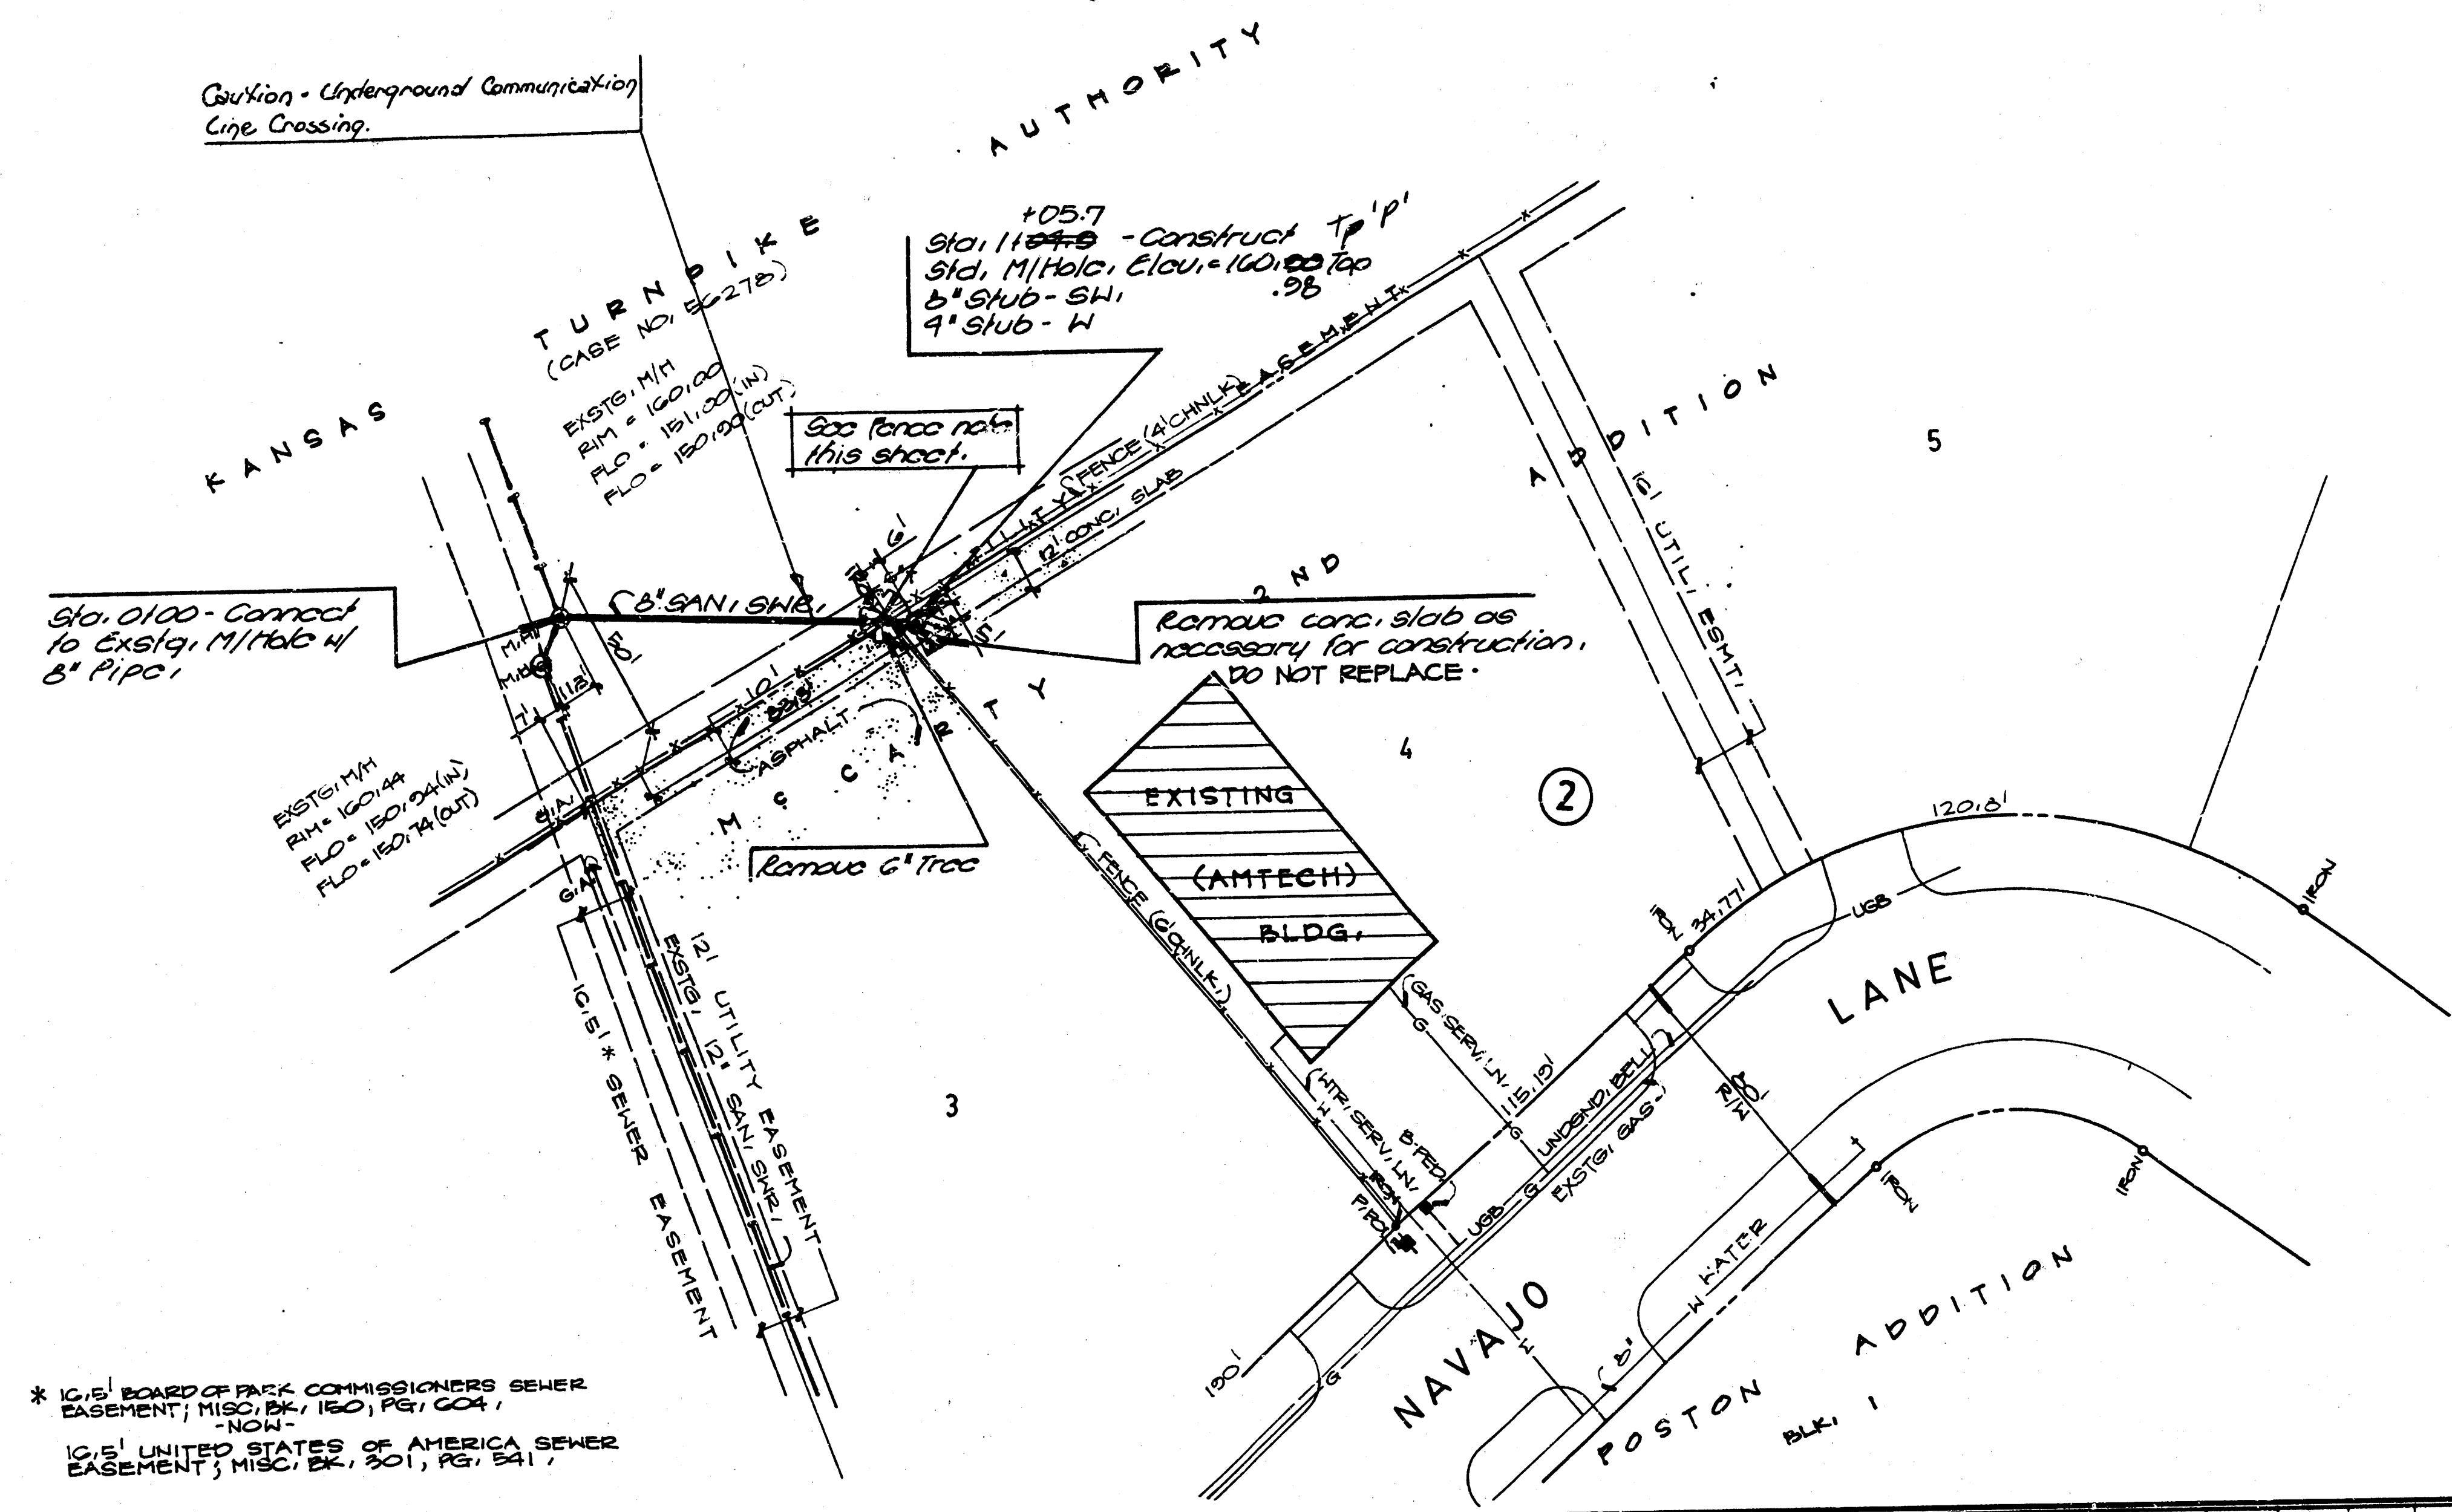

* FENCE NOTE *

Contractor to remove & replace K.T.A. wire fence as/when necessary. At no time during construction shall the K.T.A. fence be left unattended or open for any time without temporarily closing the fence opening.

Contractor to contact K.T.A. officials and make arrangements for construction within K.T.A. property. This shall include any bonds, deposits, permits, and fees thereof which may be required by the Kansas Turnpike Authority.

NOTE TO CONTRACTOR

INSPECTION AND TESTING FOR THIS PROJECT IS TO BE PROVIDED BY A LICENSED CONSULTING ENGINEERING FIRM UNDER CONTRACT WITH THE OWNER/DEVELOPER. SAID INSPECTION IS IN ACCORDANCE WITH THE CITY OF WICHITA CONSULTING ENGINEERING PRACTICES AND CONDITIONS OF PROFESSIONAL ENGINEERING CONTRACTS. THE CITY OF WICHITA DOES NOT GUARANTEE THE ACCURACY OF THE INFORMATION PROVIDED BY THE CONTRACTOR. WITHOUT LIMITING THE FOREGOING, THE CONTRACTOR IS TO BE RESPONSIBLE FOR ALL WORK BEING COMPLETED IN ACCORDANCE WITH THE CITY OF WICHITA WITHOUT WRITTEN APPROVAL BY THE CITY ENGINEER.

• BENCHMARK •
"D" TC, EAST OF SO. P.C. IRON
AT NE COR. POSTON ADDN.
ELEV. = 158.71 CITY DATUM


By CITY ENGINEER OF WICHITA

Sanitary Sewers: VRH 513 190

Storm Sewer: _____

Driveway Approaches: _____

Water Mains: _____


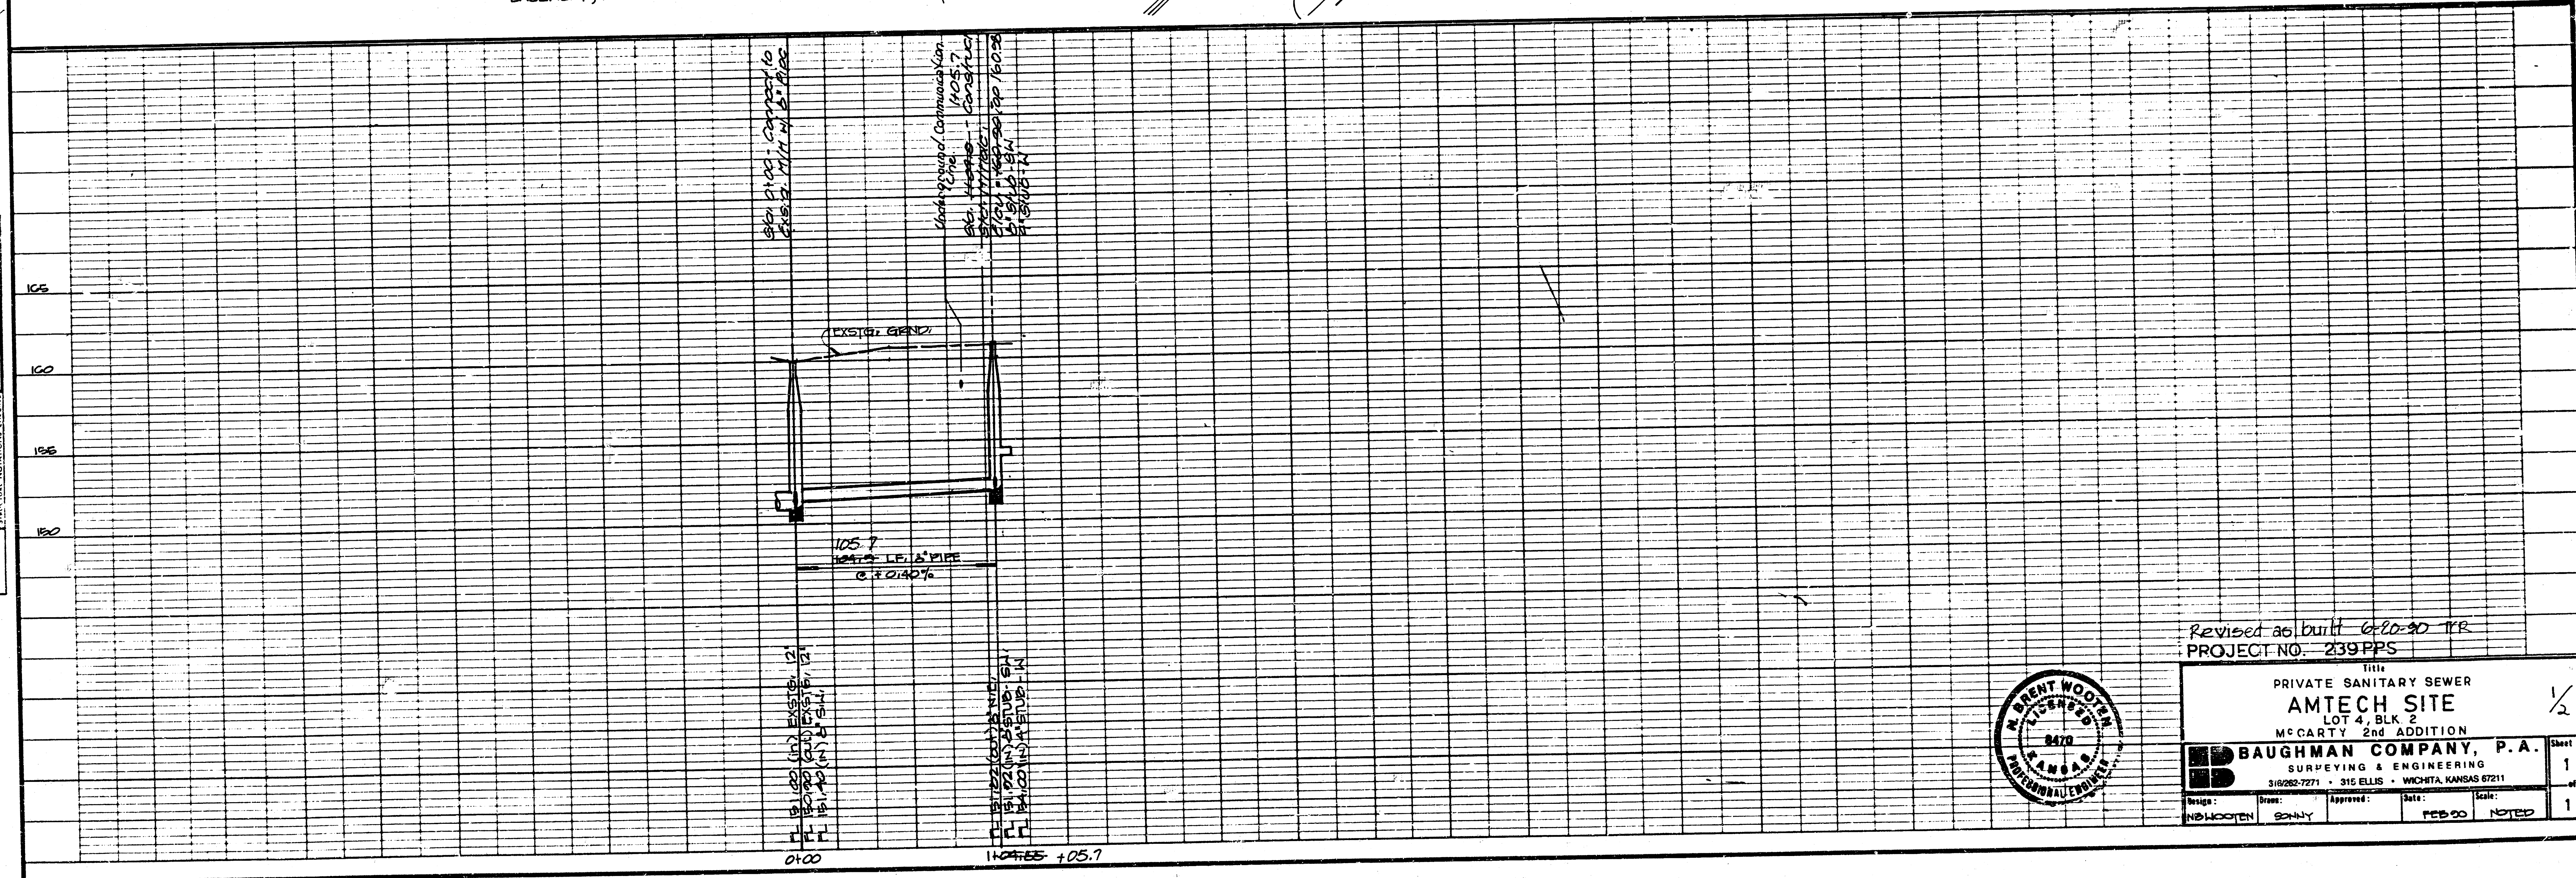


Revised as built 6-10-90 TR				
PROJECT NO. 239PPS				
Title				1/2
PRIVATE SANITARY SEWER				
AMTECH SITE				
LOT 4, BLK 2				
MC CARTY 2nd ADDITION				
BAUGHMAN COMPANY, P.A.				Sheet
SURVEYING & ENGINEERING				of
3/10/92-7271 315 ELLIS WICHITA, KANSAS 67211				
Drawn:	By:	Checked:	Date:	Scale:
WIDHOOTEN	SONNY		FEB 90	NOTED
				1



PLAN	DATE
BY	
CHECKED	
DATE	
NO.	

PROFILE	DATE
BY	
CHECKED	
DATE	
NO.	

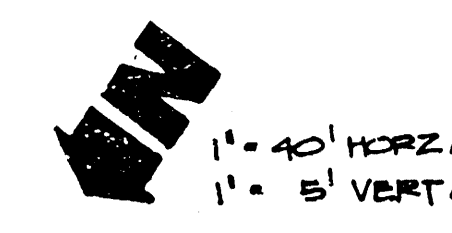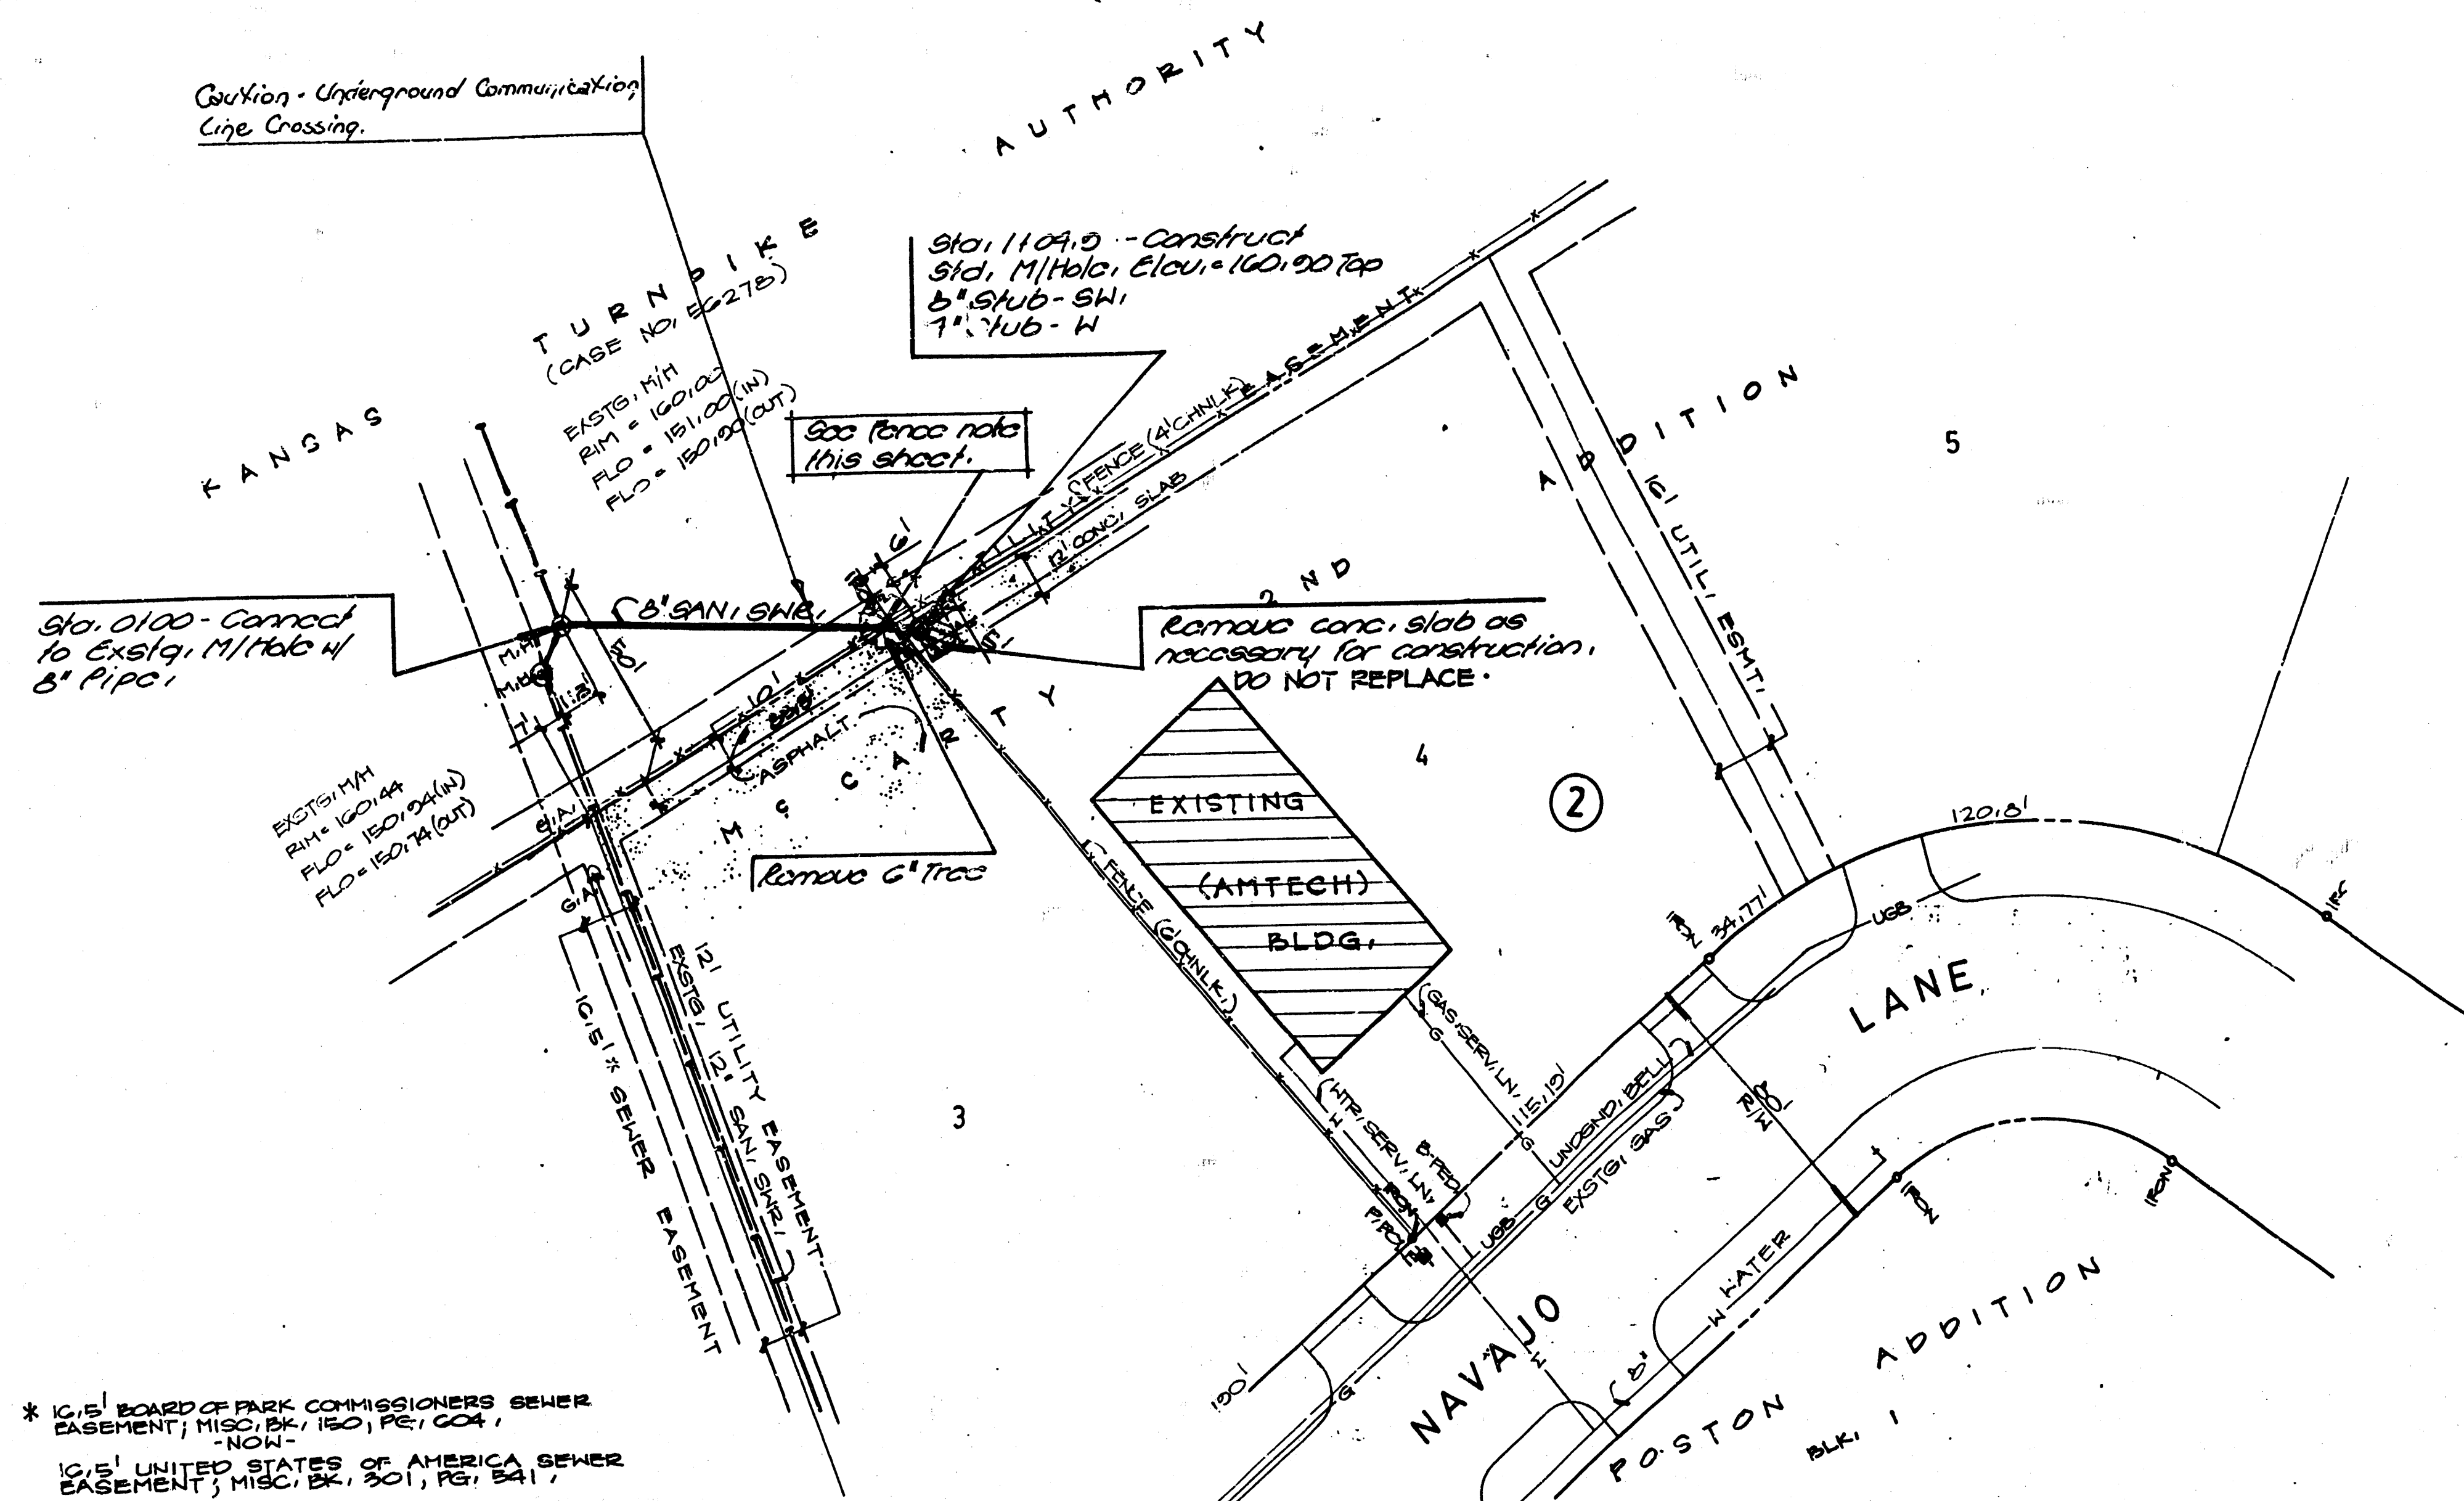

FENCE NOTE

Contractor to remove & replace K.T.A. fence ONLY as necessary. At no time during construction shall the K.T.A. fence be left unattended or open for any time without temporarily closing the fence opening.

Contractor to contact K.T.A. officials and make arrangements for construction within K.T.A. property. This shall include any bonds, deposits, permits, and fees thereof which may be required by the Kansas Turnpike Authority.

NOTE TO CONTRACTOR

INSPECTION AND TESTING FOR THIS PROJECT IS TO BE PROVIDED BY A LICENSED CONSULTING ENGINEERING FIRM UNDER CONTRACT WITH THE OWNER/DEVELOPER SAID INSPECTION TO BE IN ACCORDANCE WITH THE CITY OF WICHITA CODES, INSTRUCTIONS, ENGINEERING PRACTICES AND ORDINANCES. THE ENGINEER'S RESPONSIBILITY IS TO REVIEW THE INSPECTION REPORTS AND TO SIGN THE SAME IF THEY COMPLY WITH THE CITY OF WICHITA CODES, INSTRUCTIONS, ENGINEERING PRACTICES AND ORDINANCES. THE ENGINEER'S SIGNATURE SHALL BE A REQUIREMENT FOR THE CITY OF WICHITA TO ACCEPT THE PROJECT. THE ENGINEER'S SIGNATURE SHALL BE A REQUIREMENT FOR THE CITY OF WICHITA TO ACCEPT THE PROJECT.

APPROVED AS NOTED
By CITY ENGINEER OF WICHITA

Sanitary Sewers VRH 5/3/90

Storm Sewers _____


Driveway Approaches _____

Water Mains _____

Post _____

BENCHMARK

10' TO EAST OF S.D. P.O. 180N
AT NE COR. POSTON ADDN
ELEV. = 152.71 CITY DATUM

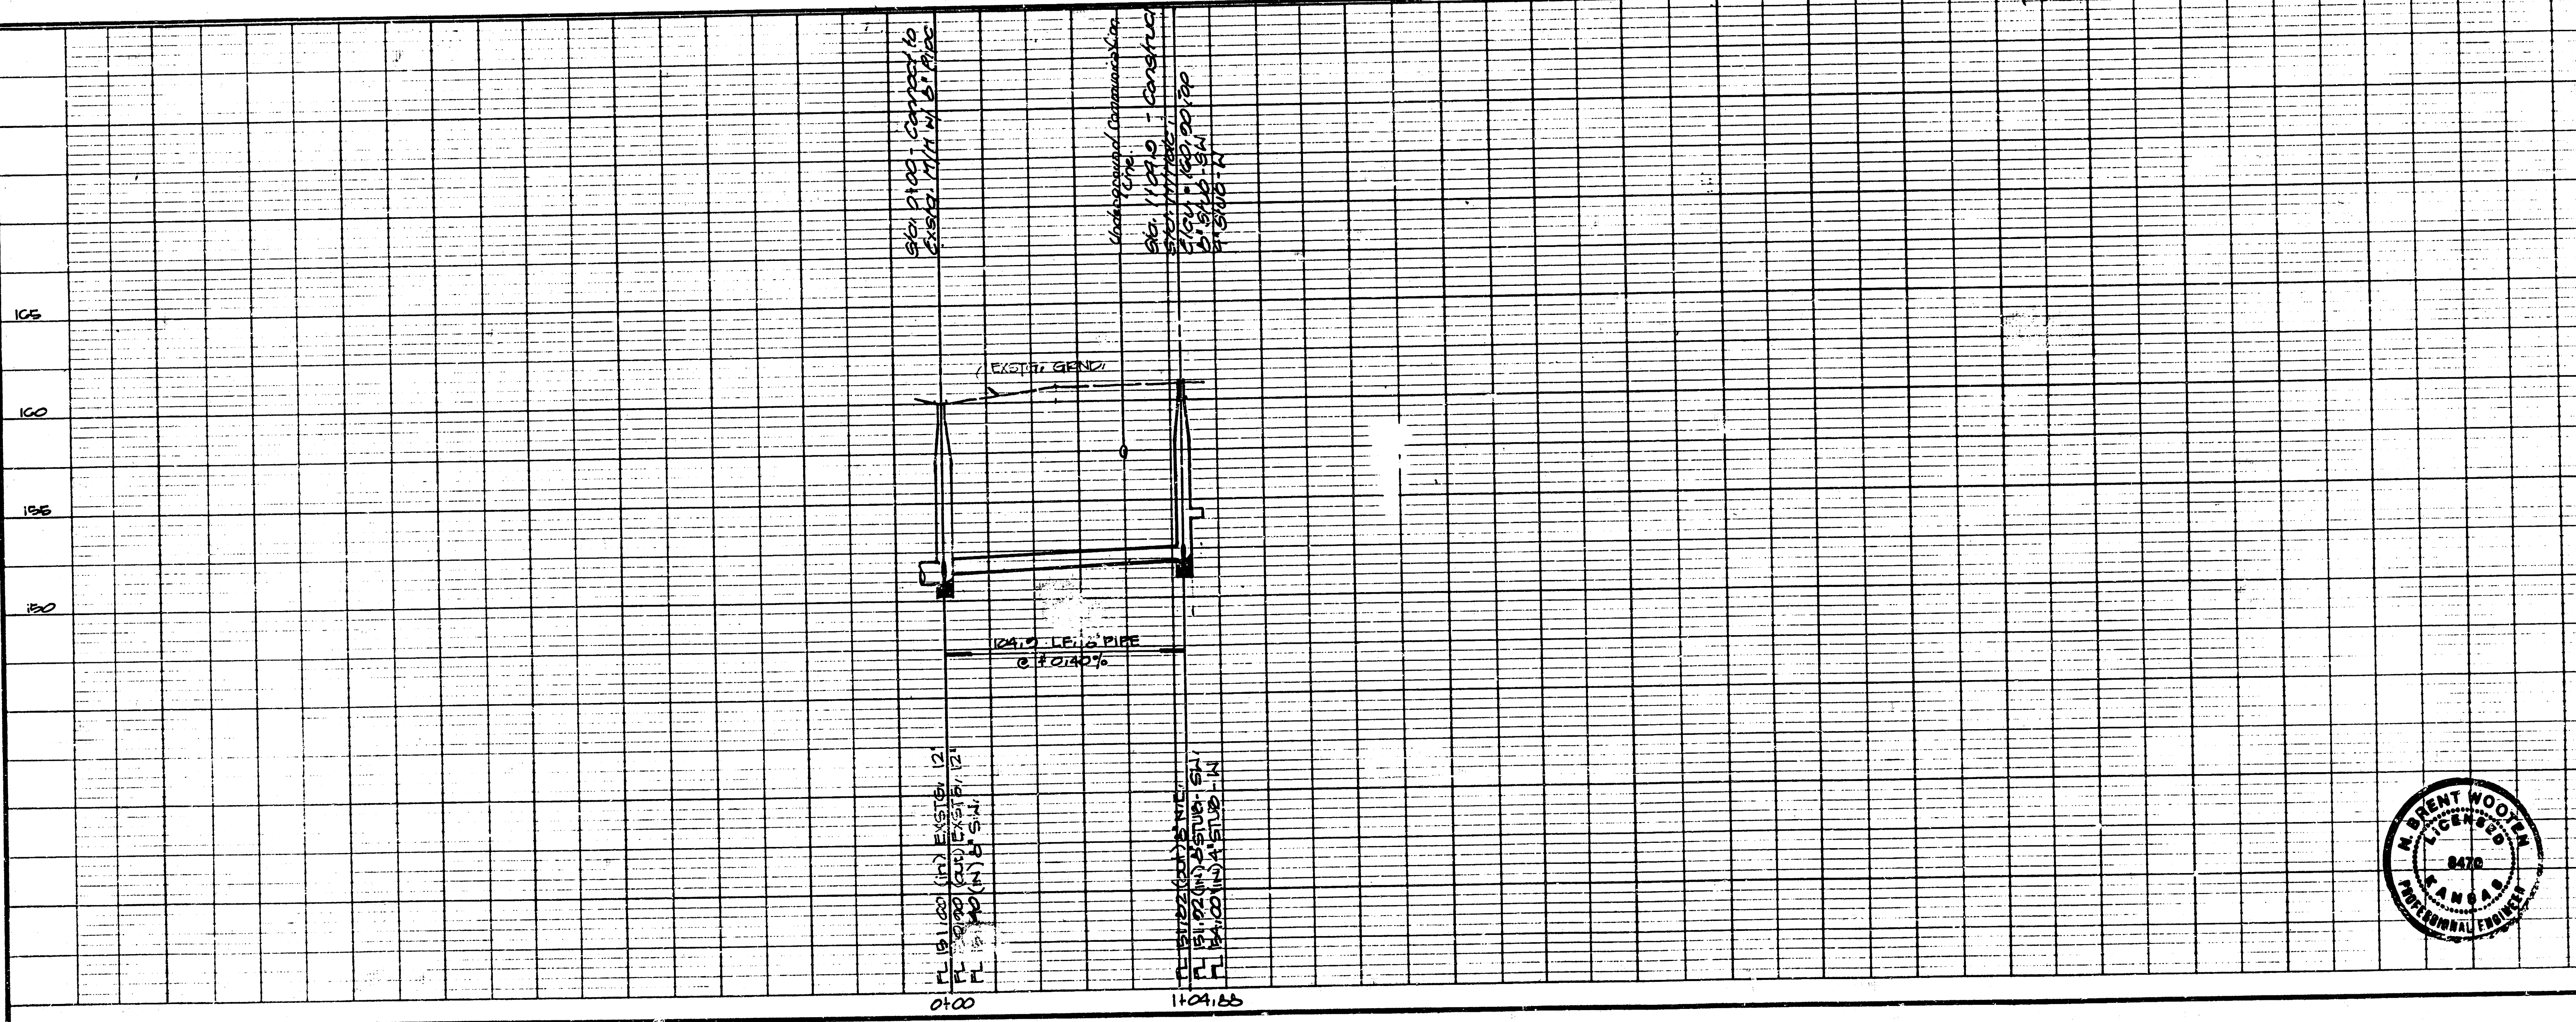

PROJECT NO. 239 PPS

PRIVATE SANITARY SEWER

AMTECH SITE

LOT 4, BLK. 2
MCCARTY 2ND ADDITION

BAUGHMAN COMPANY, P.A.

SURVEYING & ENGINEERING

318/262-7271 • 315 ELLIS • WICHITA, KANSAS 67211

Design: NOH/DOH Drawn: SONNY Approved: VRH Date: FEB 90 Scale: NOTED

Sheet 1 of 2