


Scale: 1" = 200'

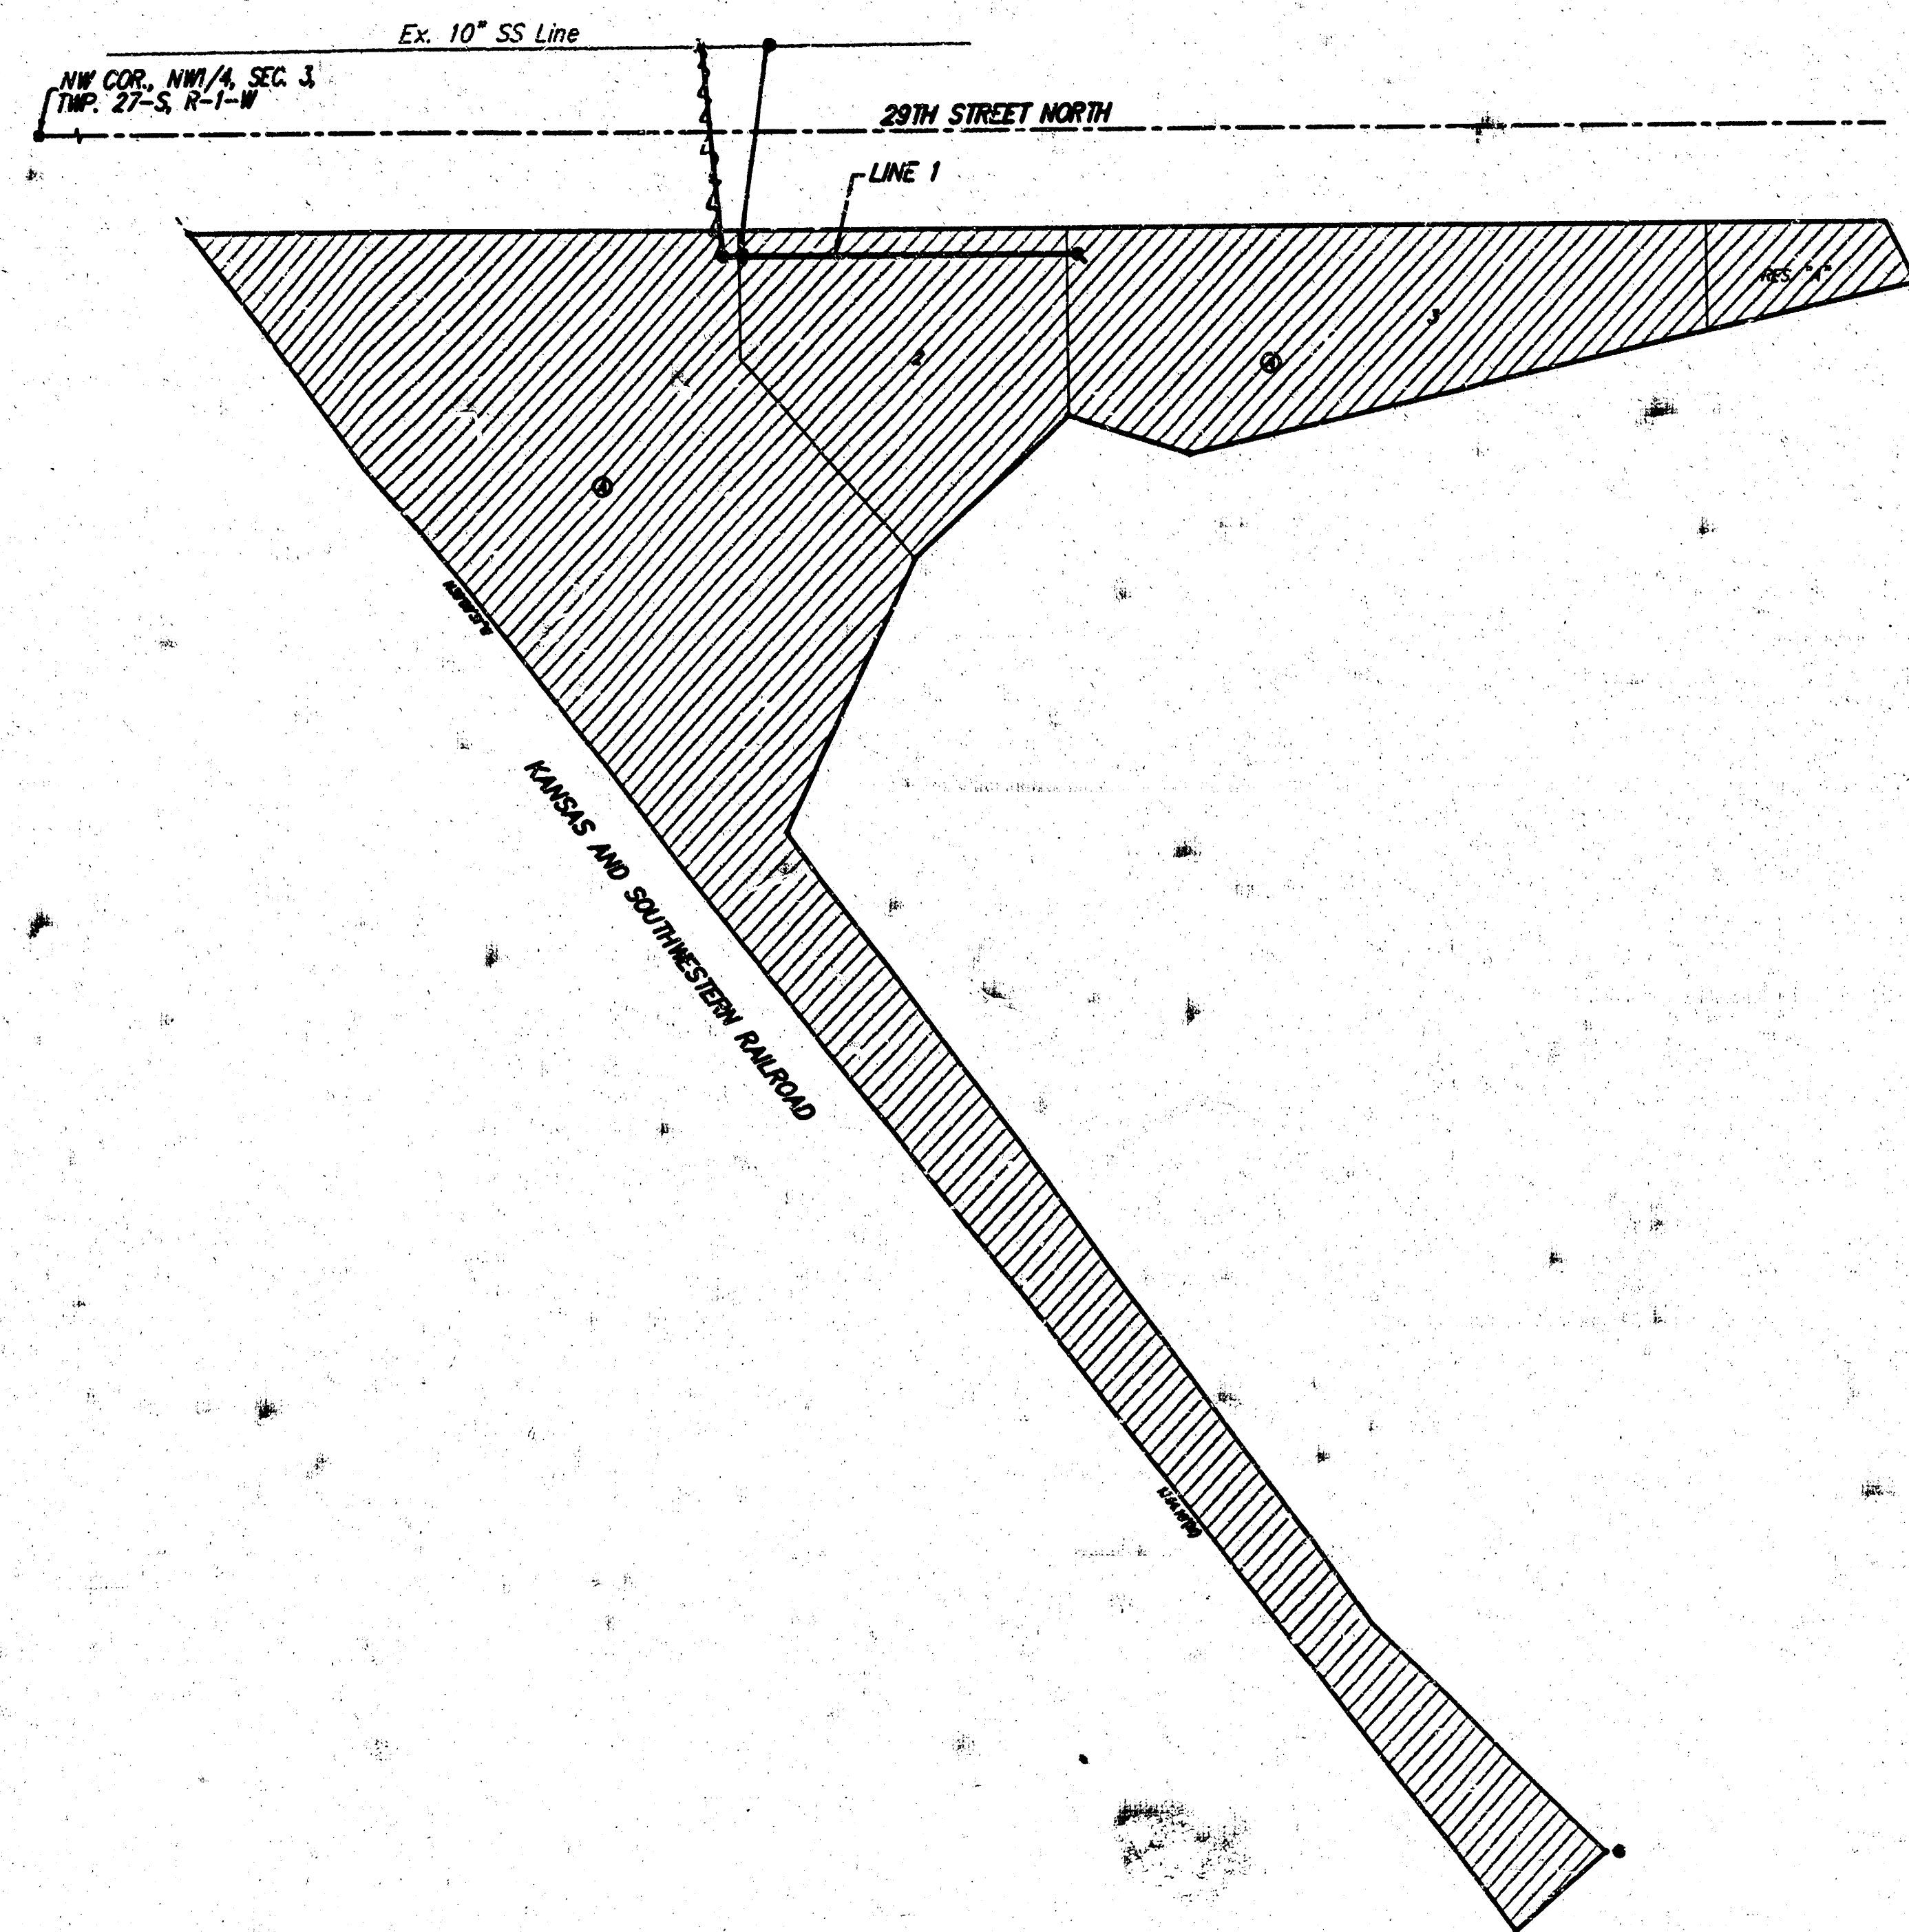

Benefit District

SANITARY SEWER IMPROVEMENTS

to serve

BAREFOOT BAY ESTATES

CITY OF WICHITA, KANSAS

Neil Cable, P.E. City Engineer

Private Project Number

1402 PPS (607861)

Benchmarks

0.4 MI. EAST OF RIDGE RD. ON 29TH ST. N. -
CITY OF WICHITA BENCHMARK DISC AT
NE CORNER OF CONCRETE BRIDGE ON
TOP OF HUBGUARD.
ELEV. = 142.51 CITY DATUM

Sheet Index

Title Sheet	1
Line 1	2
Standard Manhole Detail	3
Manhole Ring Detail	4
Copy of Plat	5


GENERAL NOTES:

- Contractor will be required to provide notice to utility companies a minimum of twenty-four (24) hours prior to any excavation, as follows:

Kansas One-Call	687-2470
-----------------	----------

The Contractor must notify the following in case of an emergency:

Cox Communications	262-4270
Kansas Gas Service	1-888-482-4950
Westar Energy	383-8650
Aquila Energy	1-800-303-0357
Southwestern Bell	268-2245
City of Wichita Water Dept.	268-4563
City of Wichita Sewer Maint.	268-4024
City of Wichita Storm Sewer Maint.	268-4090
City of Wichita Traffic Maint.	268-4034
Conoco Pipeline Co.	1-800-231-2551
Williams Pipeline Co.	529-6600
Phillips Pipeline Co.	1-800-756-8230
- Underground utility service lines and overhead utility pole lines are to be adjusted as necessary by others prior to construction unless the plans specifically call for their adjustment by the Contractor or unless the plans specifically identify a utility to be adjusted by its owner during construction. Existing utilities and their location, as shown on the plans, represent the best information obtainable for design. The Contractor will be required to work around existing utilities within the right-of-way which do not conflict with proposed construction.
- Trees and shrubs in public right-of-way which are in direct conflict with proposed new construction shall be removed by the Contractor with the Engineer's approval. Trees and shrubs which are not in direct conflict with proposed new construction shall be saved and protected from damage.
- The Contractor shall give all property owners and/or tenants of developed property abutting the construction of this project a minimum of ten (10) days advance notice prior to start of construction.
- The Contractor shall be responsible for preserving property irons. The Contractor will be required to re-establish any property iron which is damaged or destroyed by his construction operations. Such irons shall be reestablished by a licensed land surveyor in accordance with state laws.
- All existing and proposed erosion control measures including silt fencing, erosion control mat, straw bales, inlet barriers, and cost entrance shall be maintained throughout construction by the contractor and until project is accepted by the City of Wichita. The on-site engineer shall complete weekly reports on the status of erosion control measures. The contractor shall be required to comply with maintenance and/or replacement of erosion control measures as determined by the on-site engineer until project is accepted by City of Wichita. Maintenance and/or replacement of erosion control measures to be paid by L.S. bid item "Erosion Control Baffle".
- Easements will be graded by others with the mass grading plan, as part of the storm drain improvements. Easements shall be returned to original grade upon completion of construction.
- When connecting to existing manhole or stub, the contractor shall reshape manhole bottom or adjust the existing stub's alignment or elevation as necessary. Cost shall be subsidiary to project.
- The Contractor shall be responsible for maintaining continuous flow of sewage through construction. Contractor's proposed method for maintaining sewage flow shall be approved by the Engineer. Cost of maintaining flow of sewage through construction will not be paid for directly and this cost shall be considered as subsidiary to the other pay items of work.
- All areas disturbed during construction shall be seeded at 300 lbs./acre with Rye Grass immediately following construction in that area. Contractor shall prepare ground per City Specifications.
- Work shall begin on this project on the issued "Notice to Proceed" date. Mass Grading may or may not be complete prior to this. Sanitary Sewer Construction shall be in accordance with the construction sequence with that of the Mass Grading Contractor.
- Contractor shall keep one lane open to through traffic at all times. Contractor to use flagman, proper traffic control devices, etc. at all times. Cost of keeping through lane open is incidental to cost of new sewer pipe.

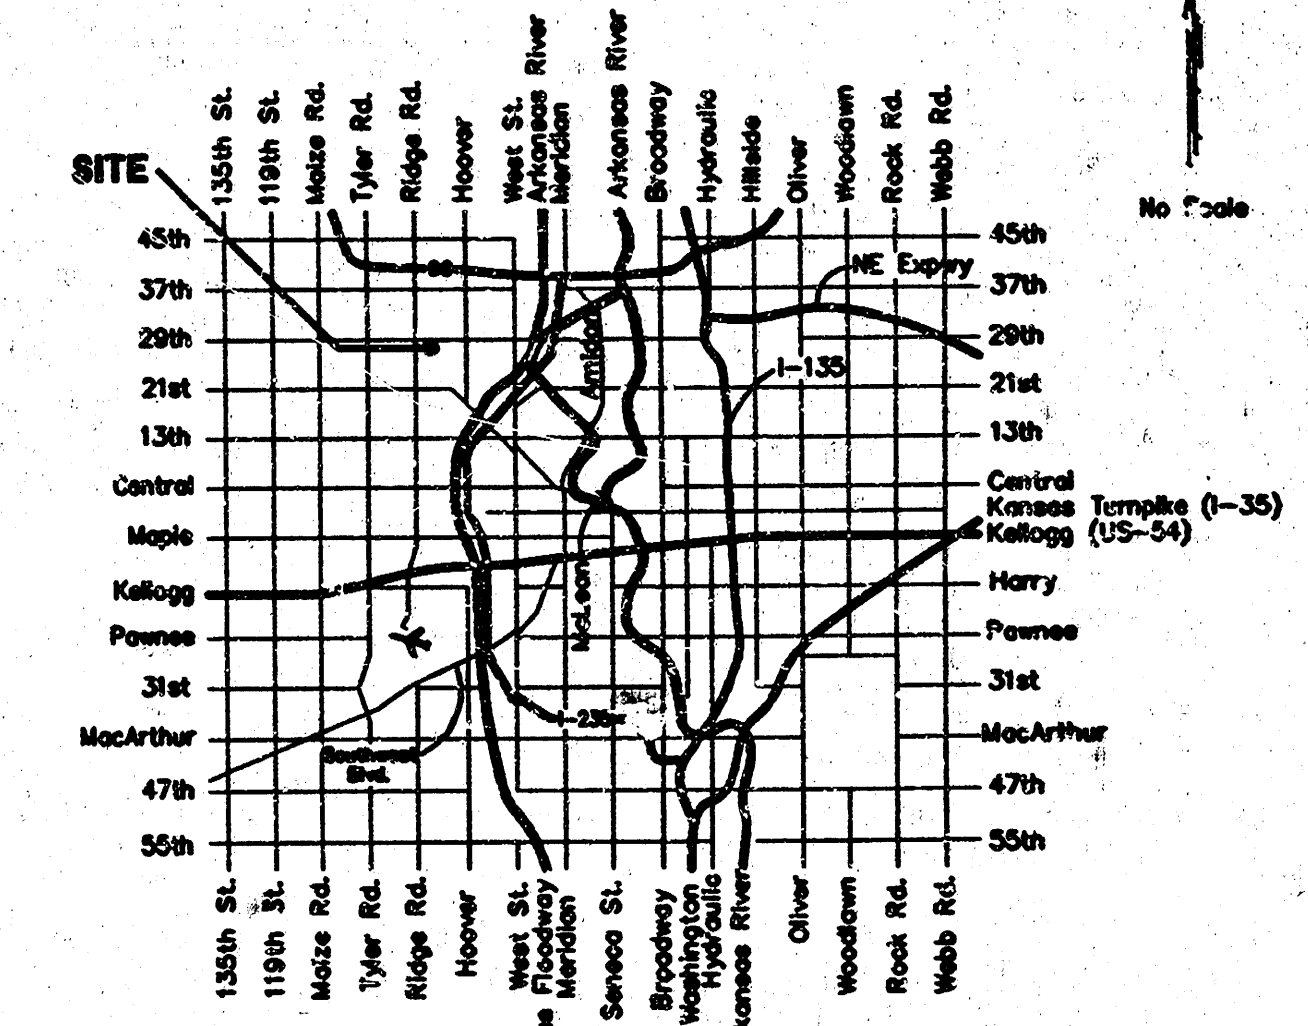

Vicinity Map

APPROVED AS NOTED
BY CITY ENGINEER OF WICHITA


Public Works
City of Wichita
VRH 1/7/04

NOTE TO CONTRACTORS

Inspection, inspection and testing for this project is to be provided by a Licensed Consulting Engineering Firm under contract with the City of Wichita. Said inspection is to be in accordance with the City of Wichita standard construction engineering practices and certified by a Licensed Professional Engineer. No work shall be performed in dedicated easements or public right-of-way by the Contractor without such inspection and approval by the City Engineer. All Construction and Materials shall comply with the City of Wichita Specifications and Standards (on file and available in the City Engineer's Office).


As Built - 2/18/04 KK
Jan 2004

BAUGHMAN COMPANY P.A.
ENGINEERING, SURVEYING, & PLANNING
318-262-7271 • 315 ELLIS • WICHITA, KANSAS 67211


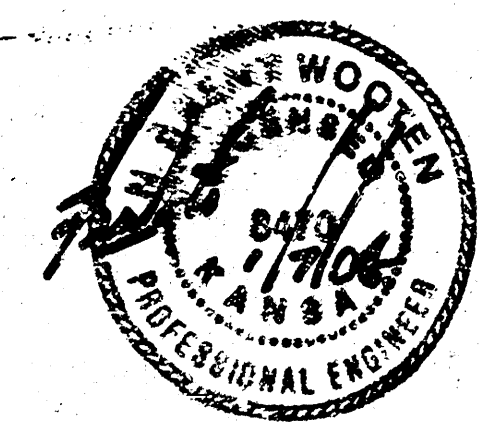


As Built - San. Sewer to Serve Barefoot Bay Est.
1402 PPS

BENCHMARK:
0.4 MI. EAST OF RIDGE RD. ON 29TH ST. N.
CITY OF WICHITA BENCHMARK DISC AT
NE CORNER OF CONCRETE BRIDGE ON
TOP OF HUGUARD
ELEV. = 142.51 CITY DATUM


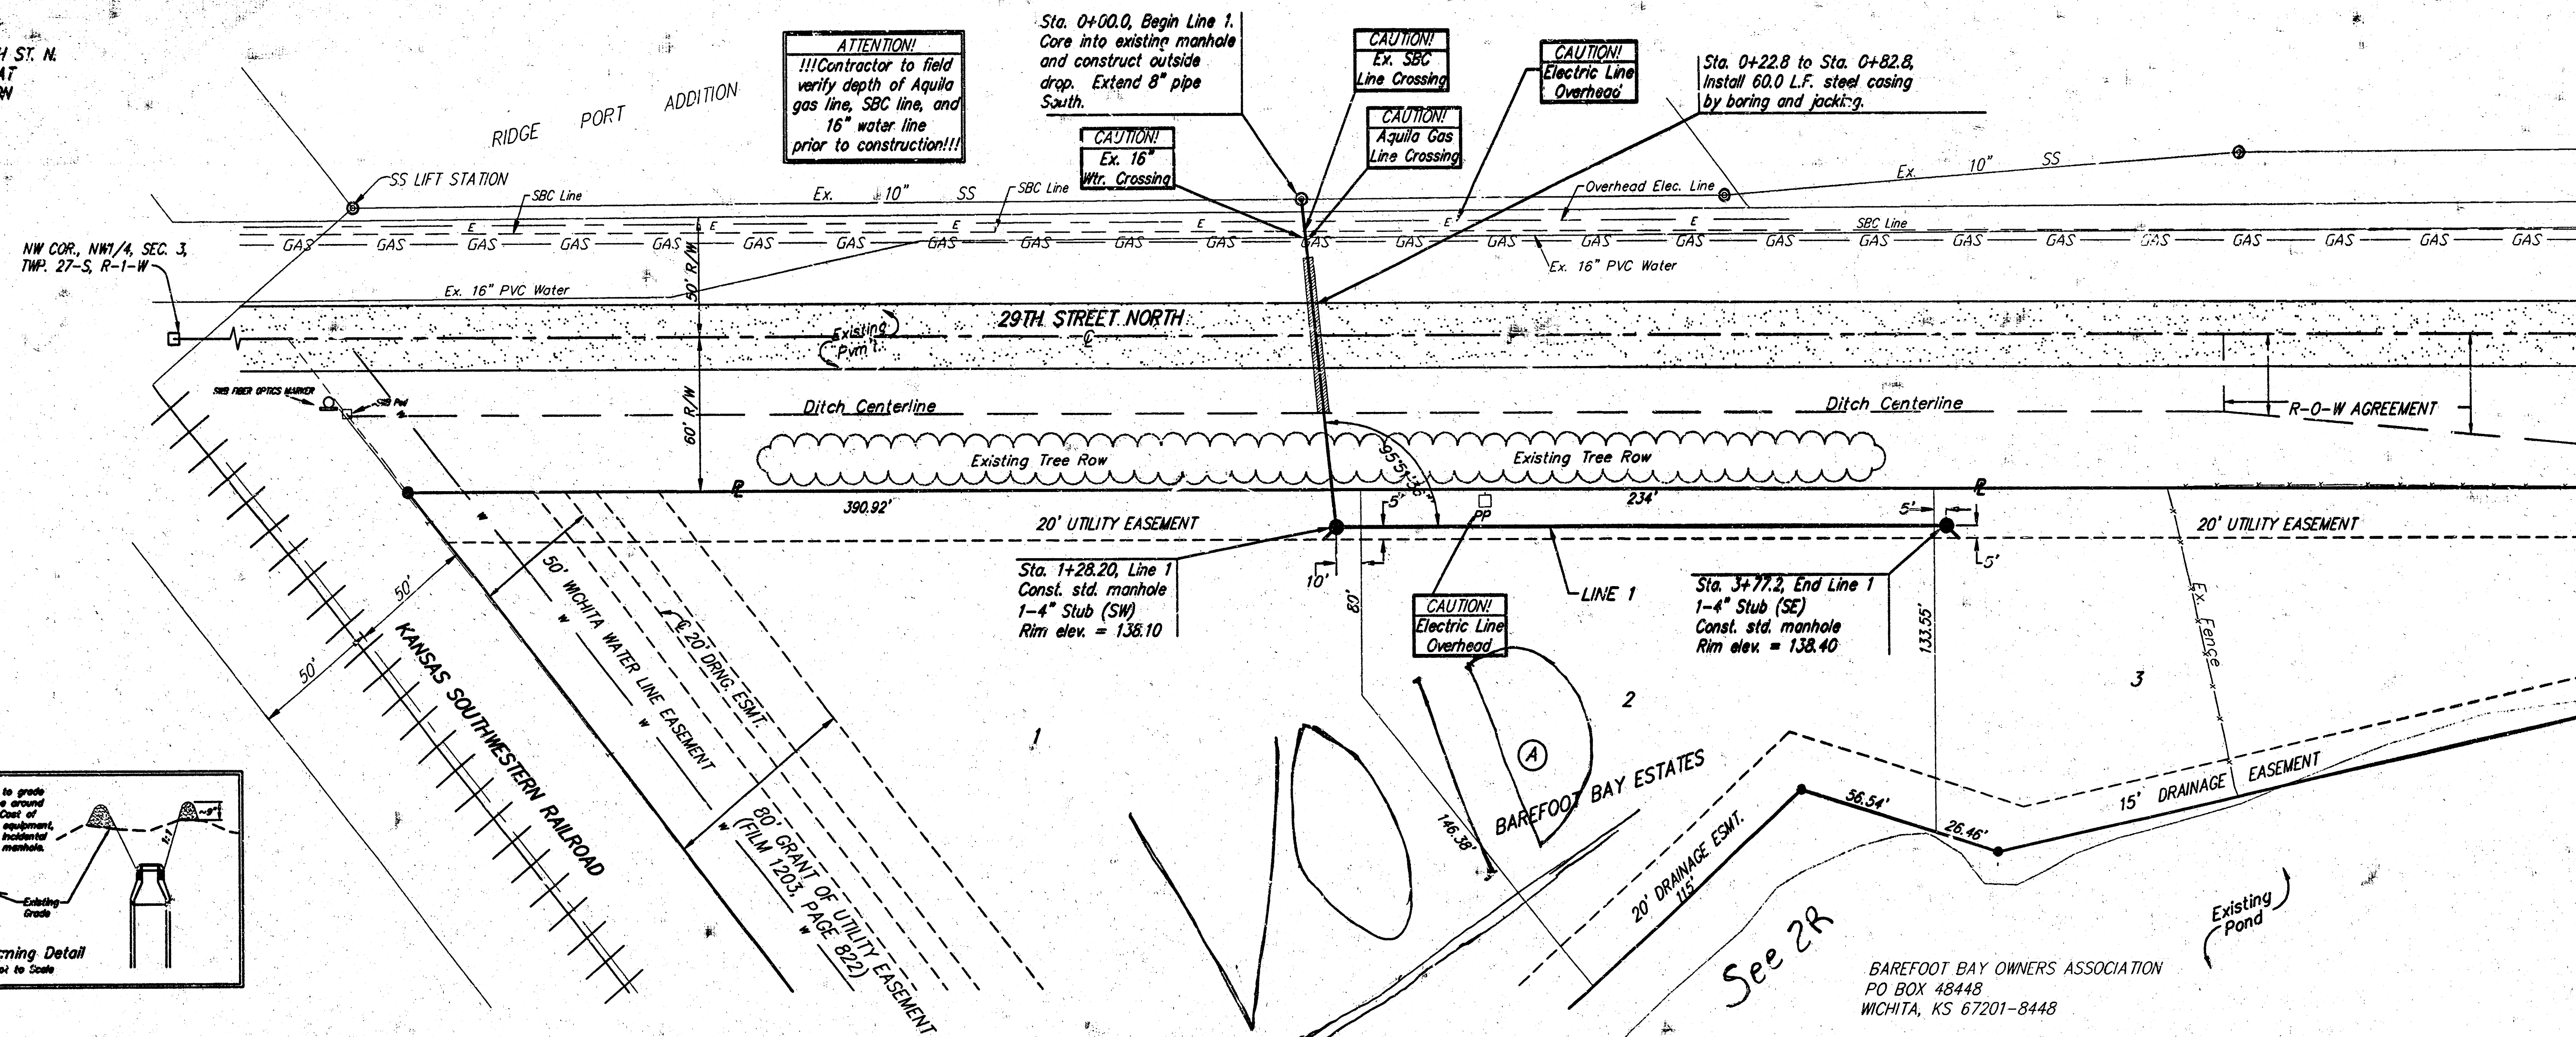


Scale: 1" = 40' Horizontal
1" = 5' Vertical
● = Iron

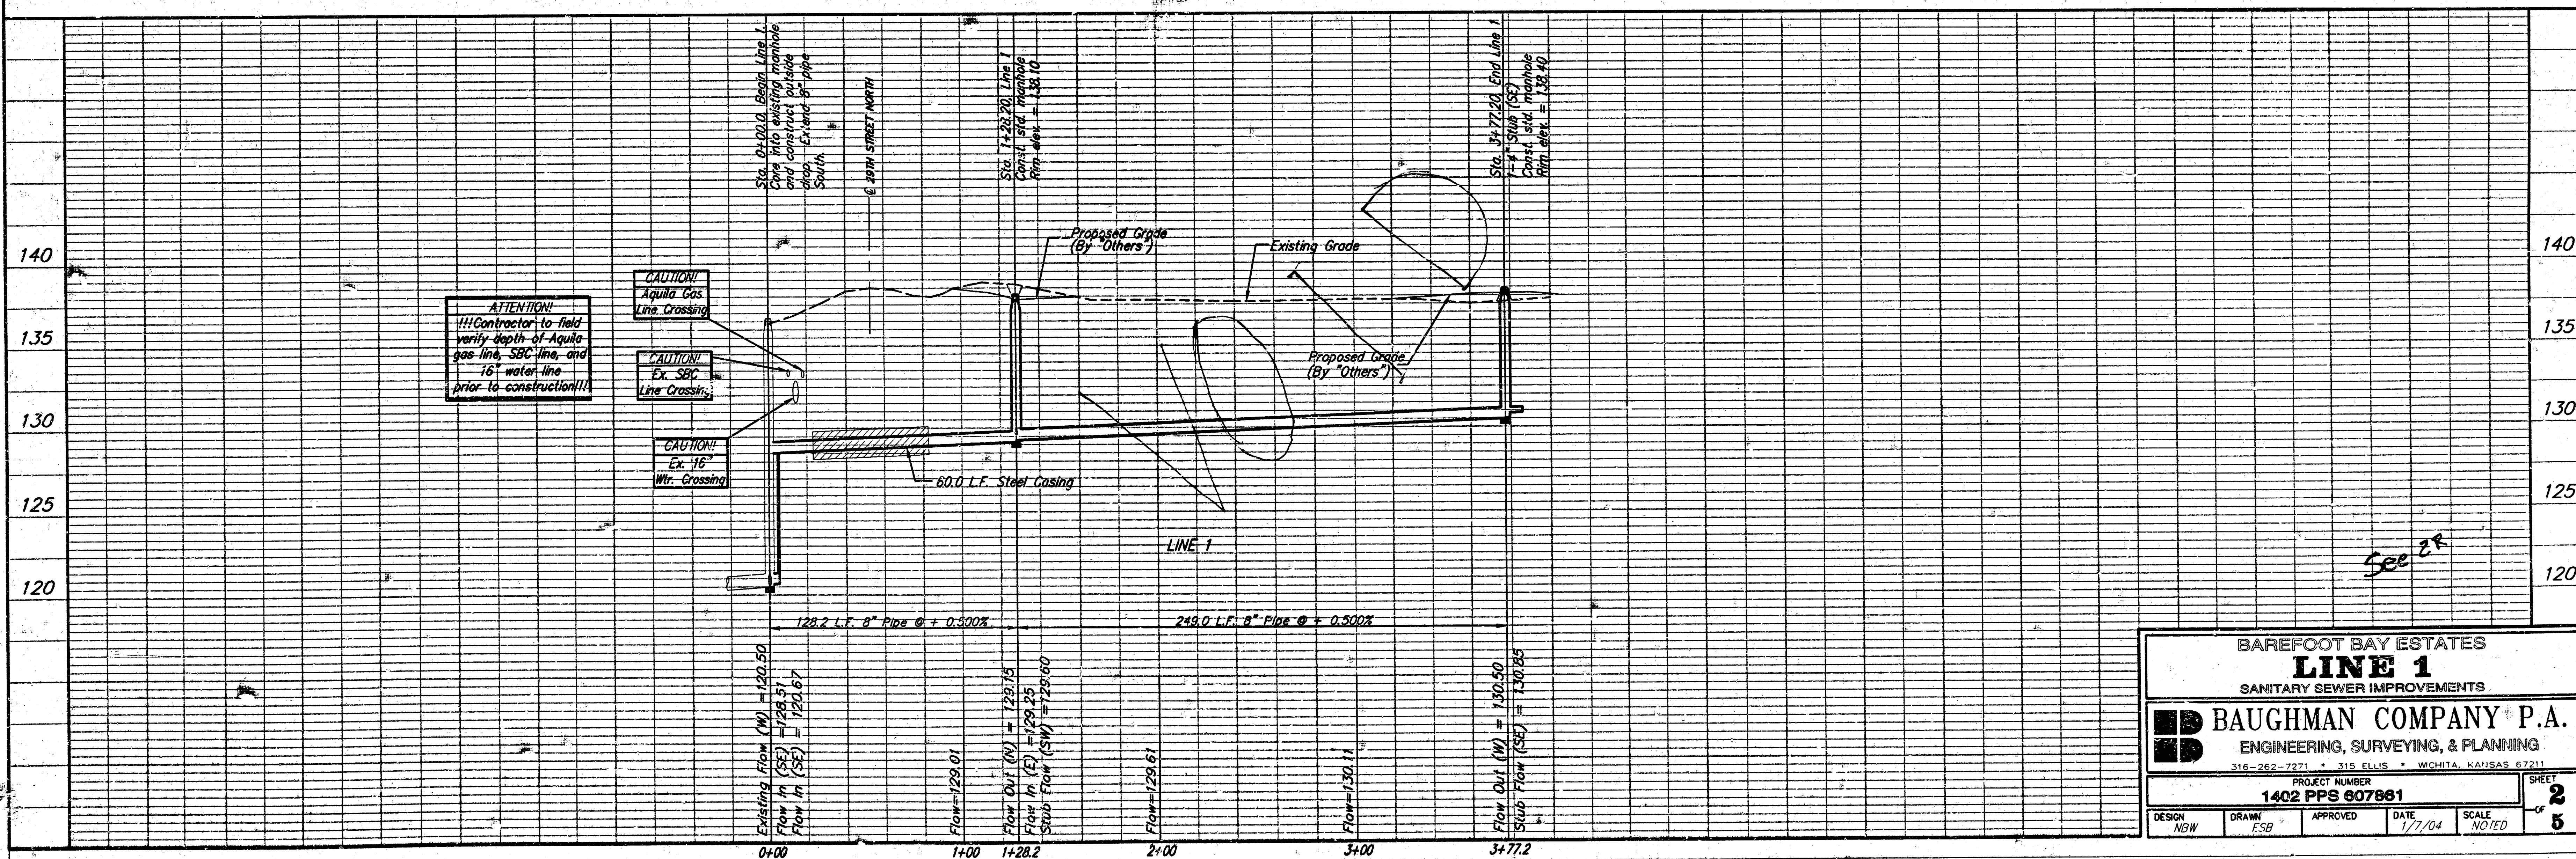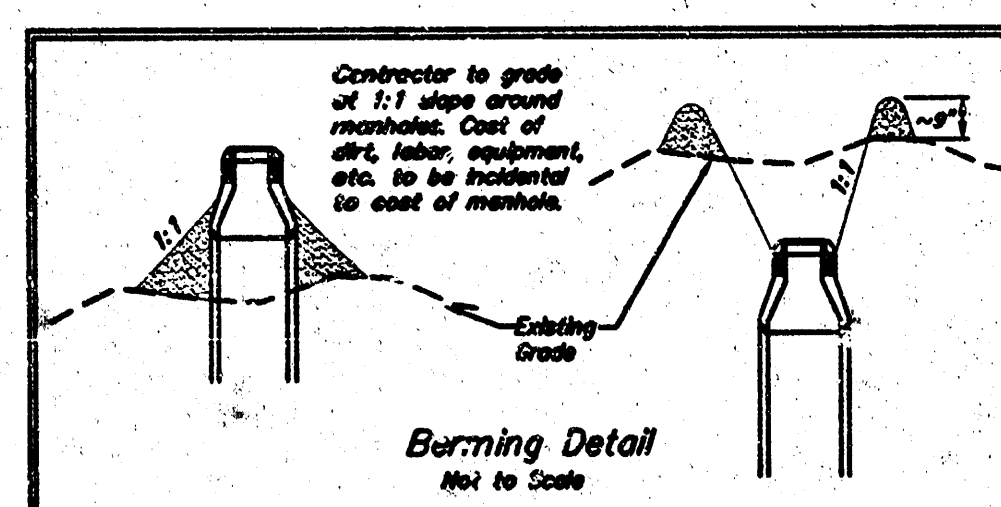


BAREFOOT BAY ESTATES LINE 1 SANITARY SEWER IMPROVEMENTS				
BAUGHMAN COMPANY P.A. ENGINEERING, SURVEYING, & PLANNING 316-262-7271 316-262-7272 WICHITA, KANSAS 67211				
PROJECT NUMBER 1402 PPS 607861				
DESIGN NSW	DRAWN ESB	APPROVED	DATE 1/7/04	SCALE NOTED
				SHEET 2 OF 5

BENCHMARK:
0.4 MI. EAST OF RIDGE RD. ON 29TH ST. N.
CITY OF WICHITA BENCHMARK DISC AT
NE CORNER OF CONCRETE BRIDGE ON
TOP OF HUBBARD
ELEV. = 142.51 CITY DATUM

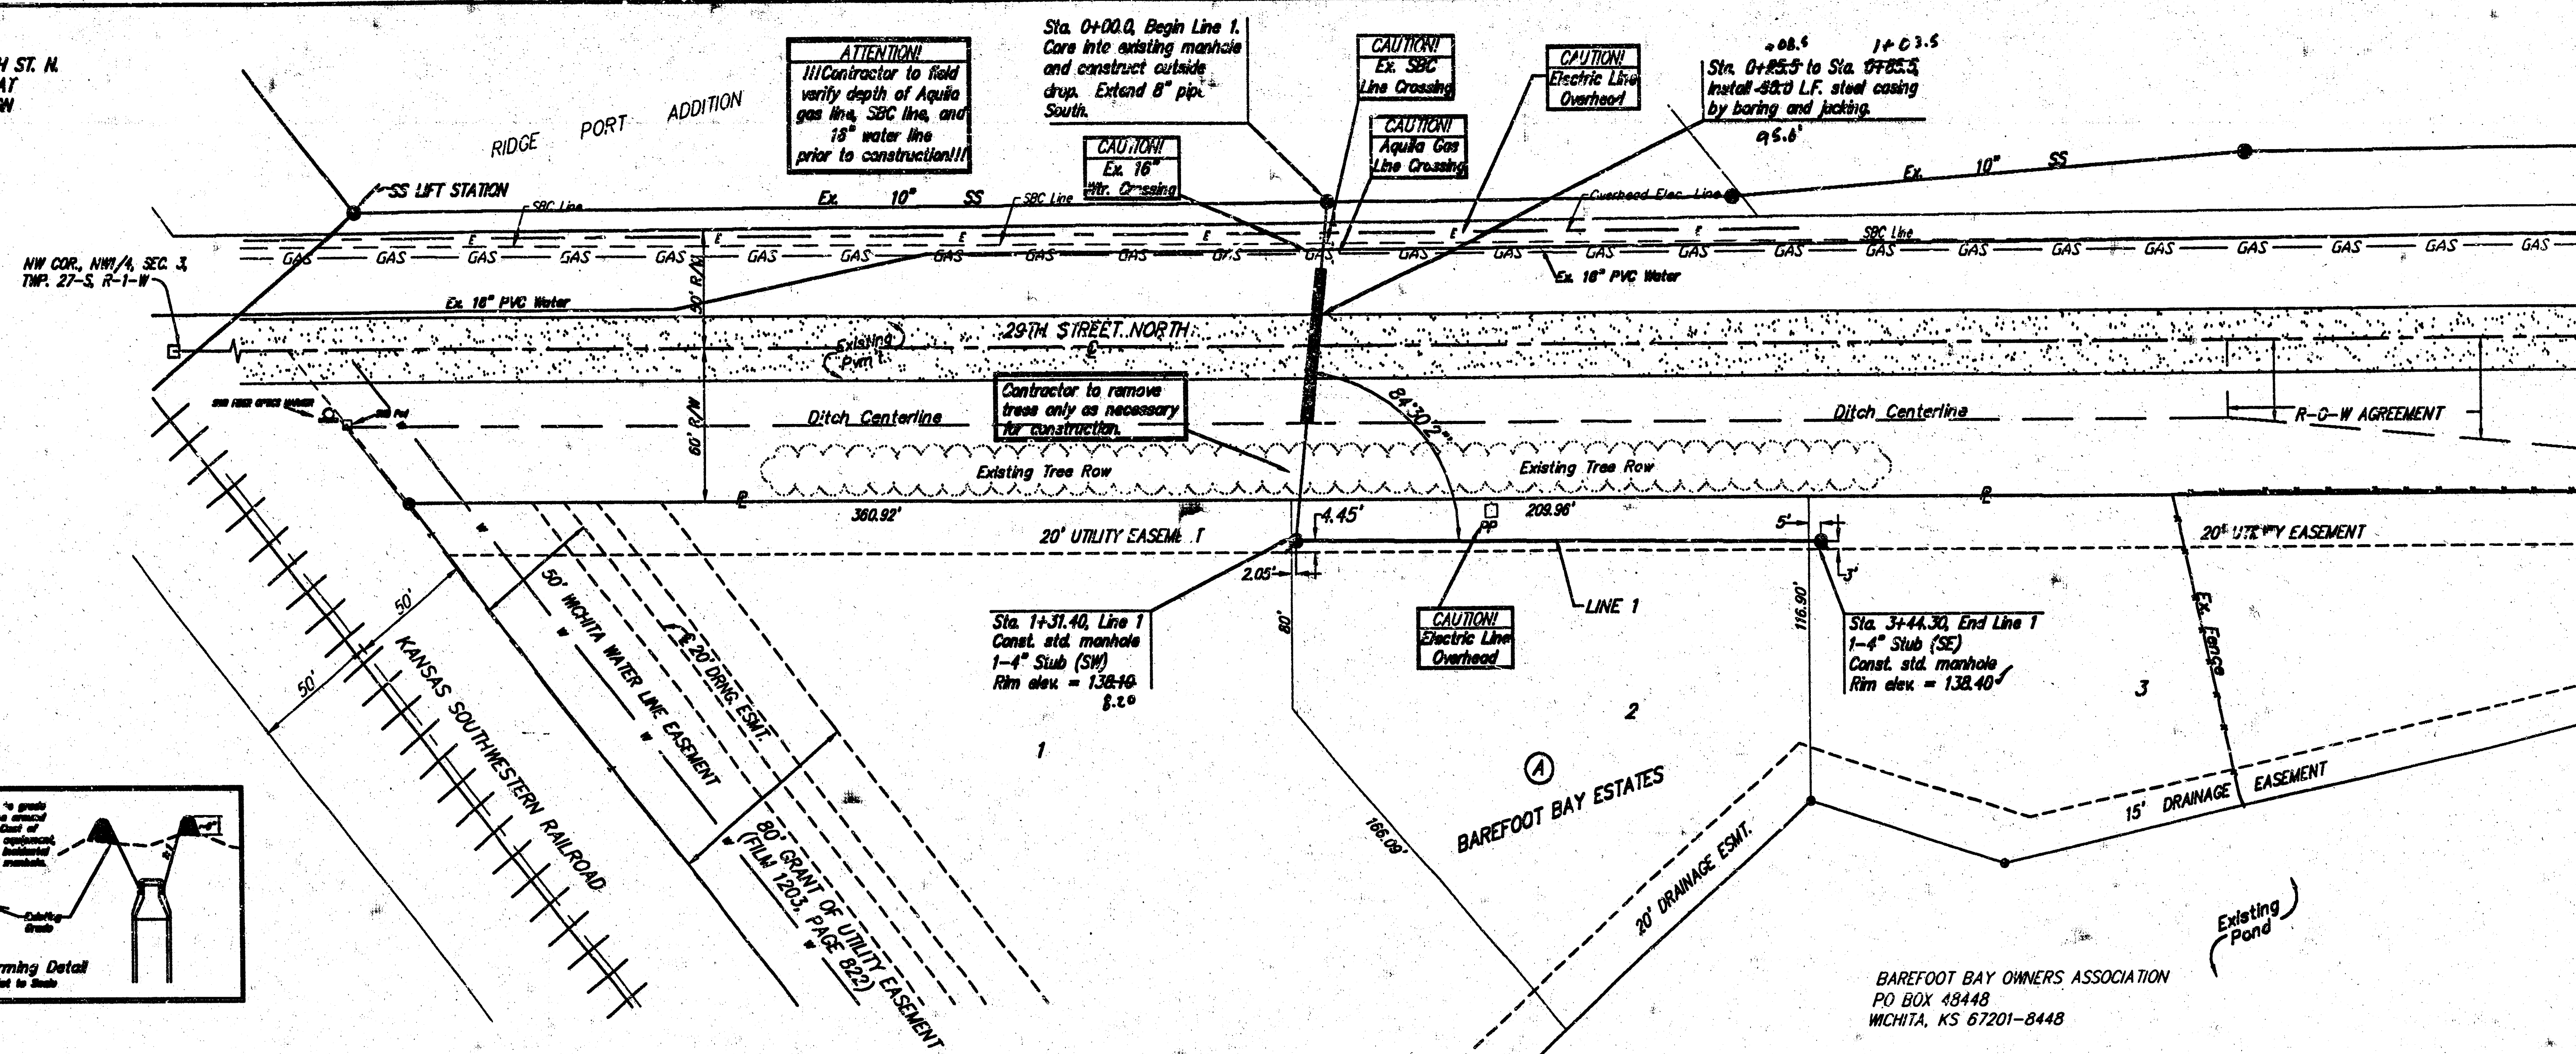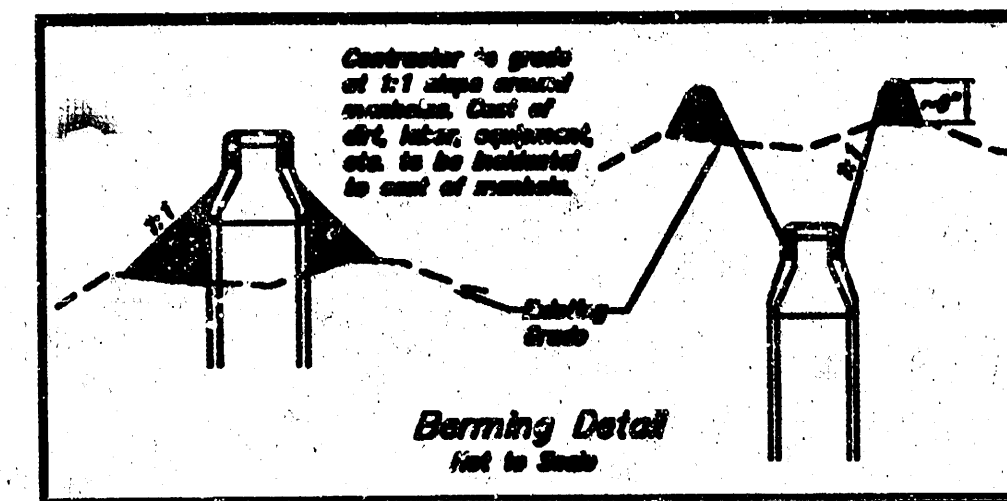

Scale: 1" = 40' Horizontal
1" = 5' Vertical
● = Iron

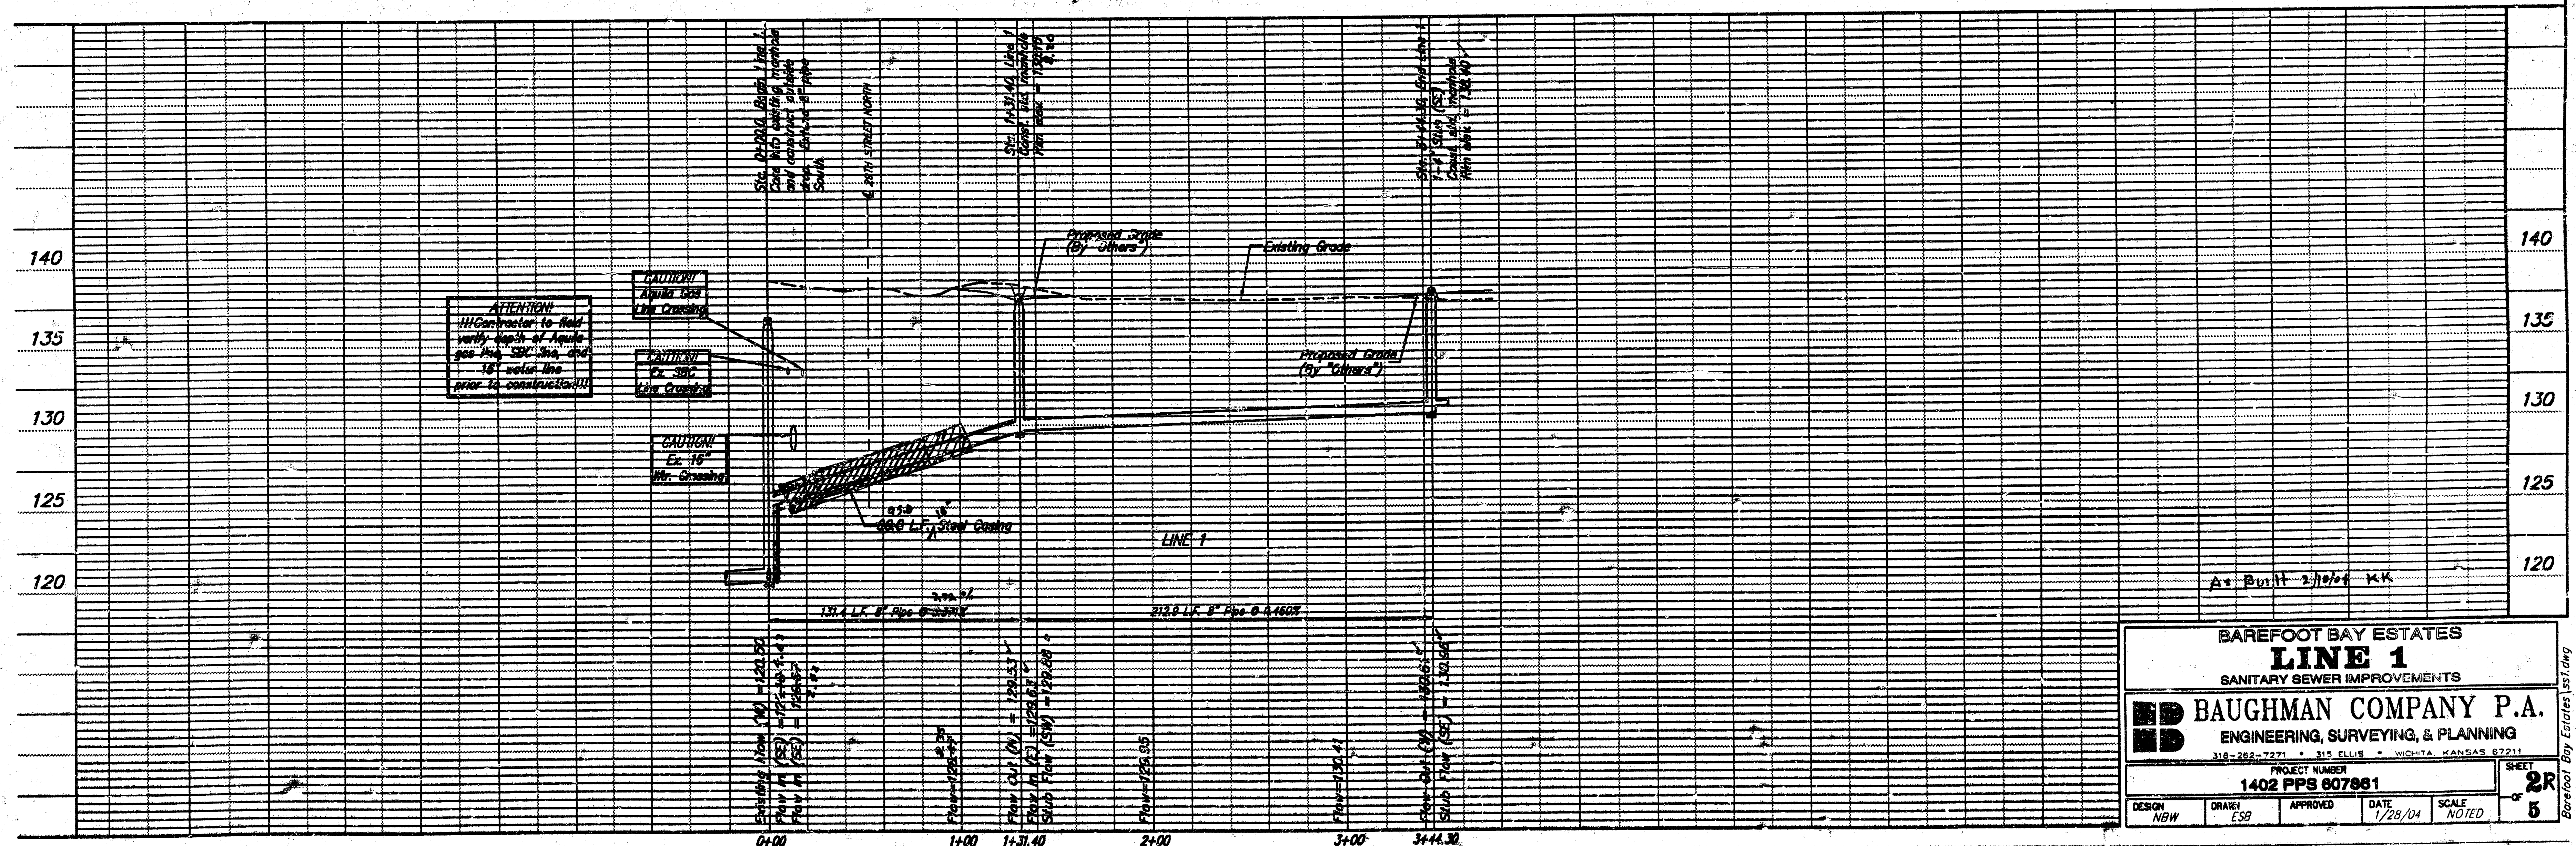

BAREFOOT BAY ESTATES
LINE 1
SANITARY SEWER IMPROVEMENTS





BAUGHMAN COMPANY P.A.
ENGINEERING, SURVEYING, & PLANNING
310-282-7271 • 315 ELLIS • WICHITA, KANSAS 67202

PROJECT NUMBER
1402 PPS 607861

DESIGN: NGW
DRAWN: ESB
APPROVED: [Signature]
DATE: 1/28/04
SCALE: NOTED

SHEET
2R
OF
5


SEWER APPURTENANCES DETAILS

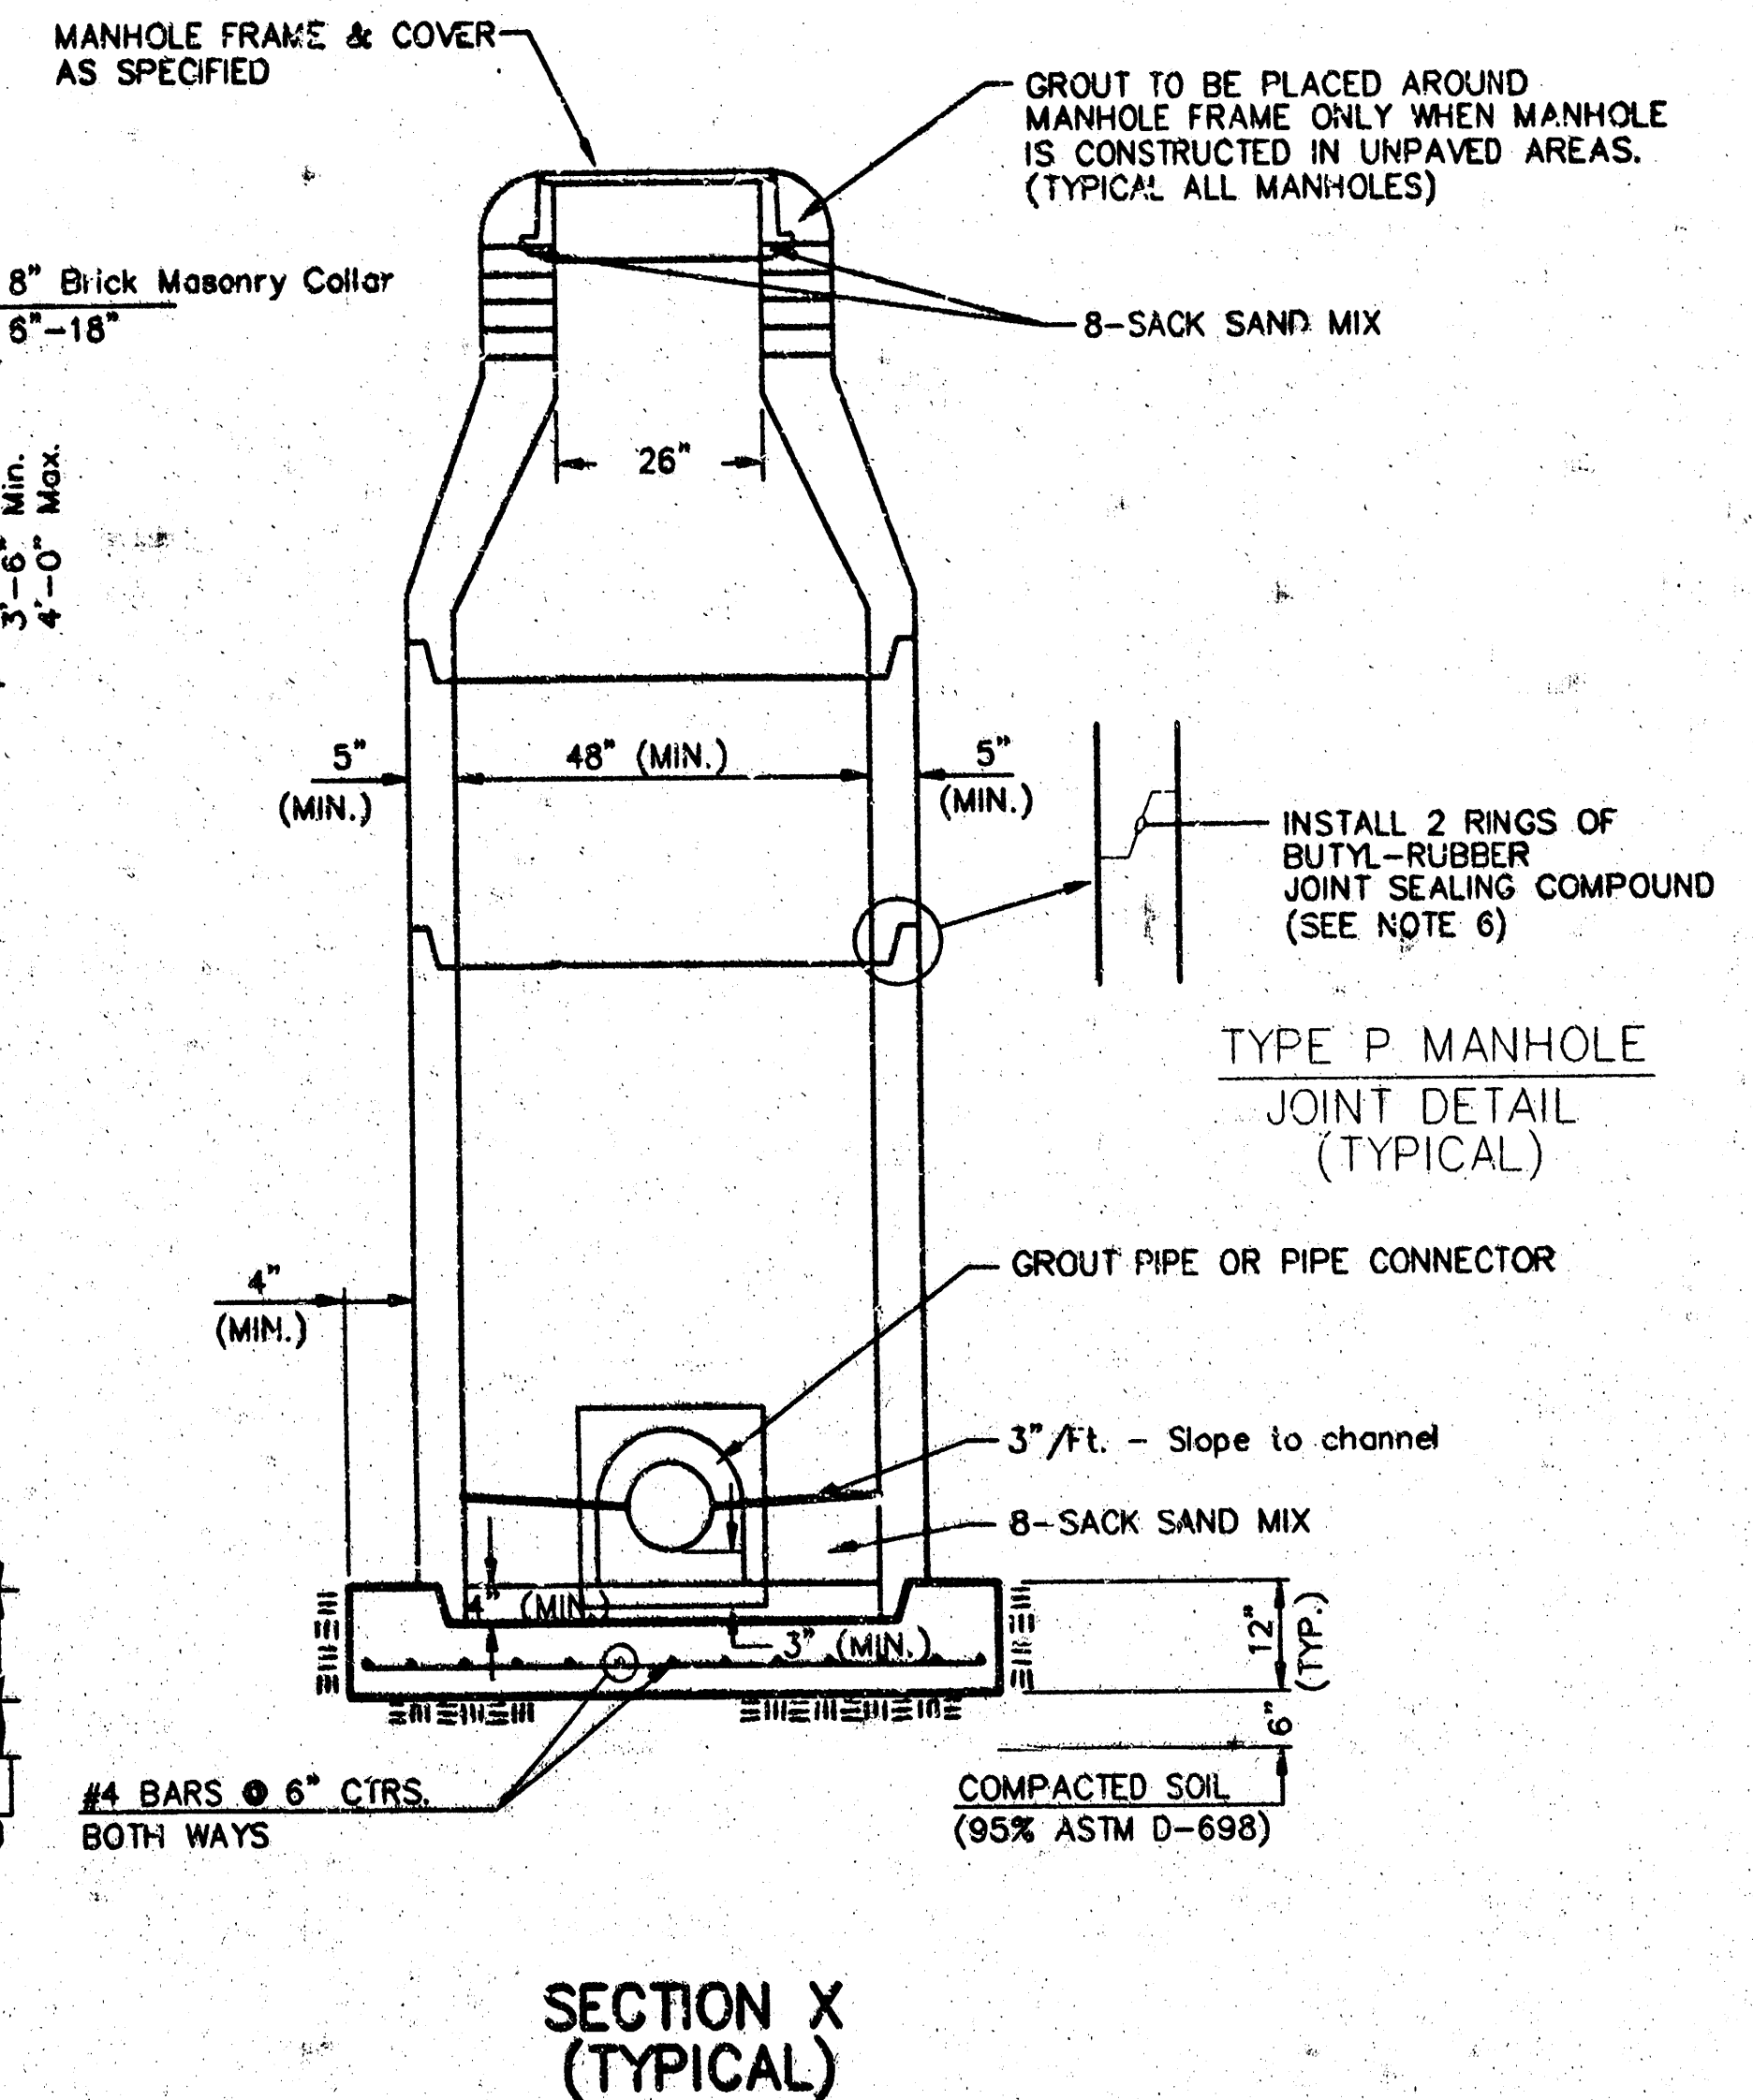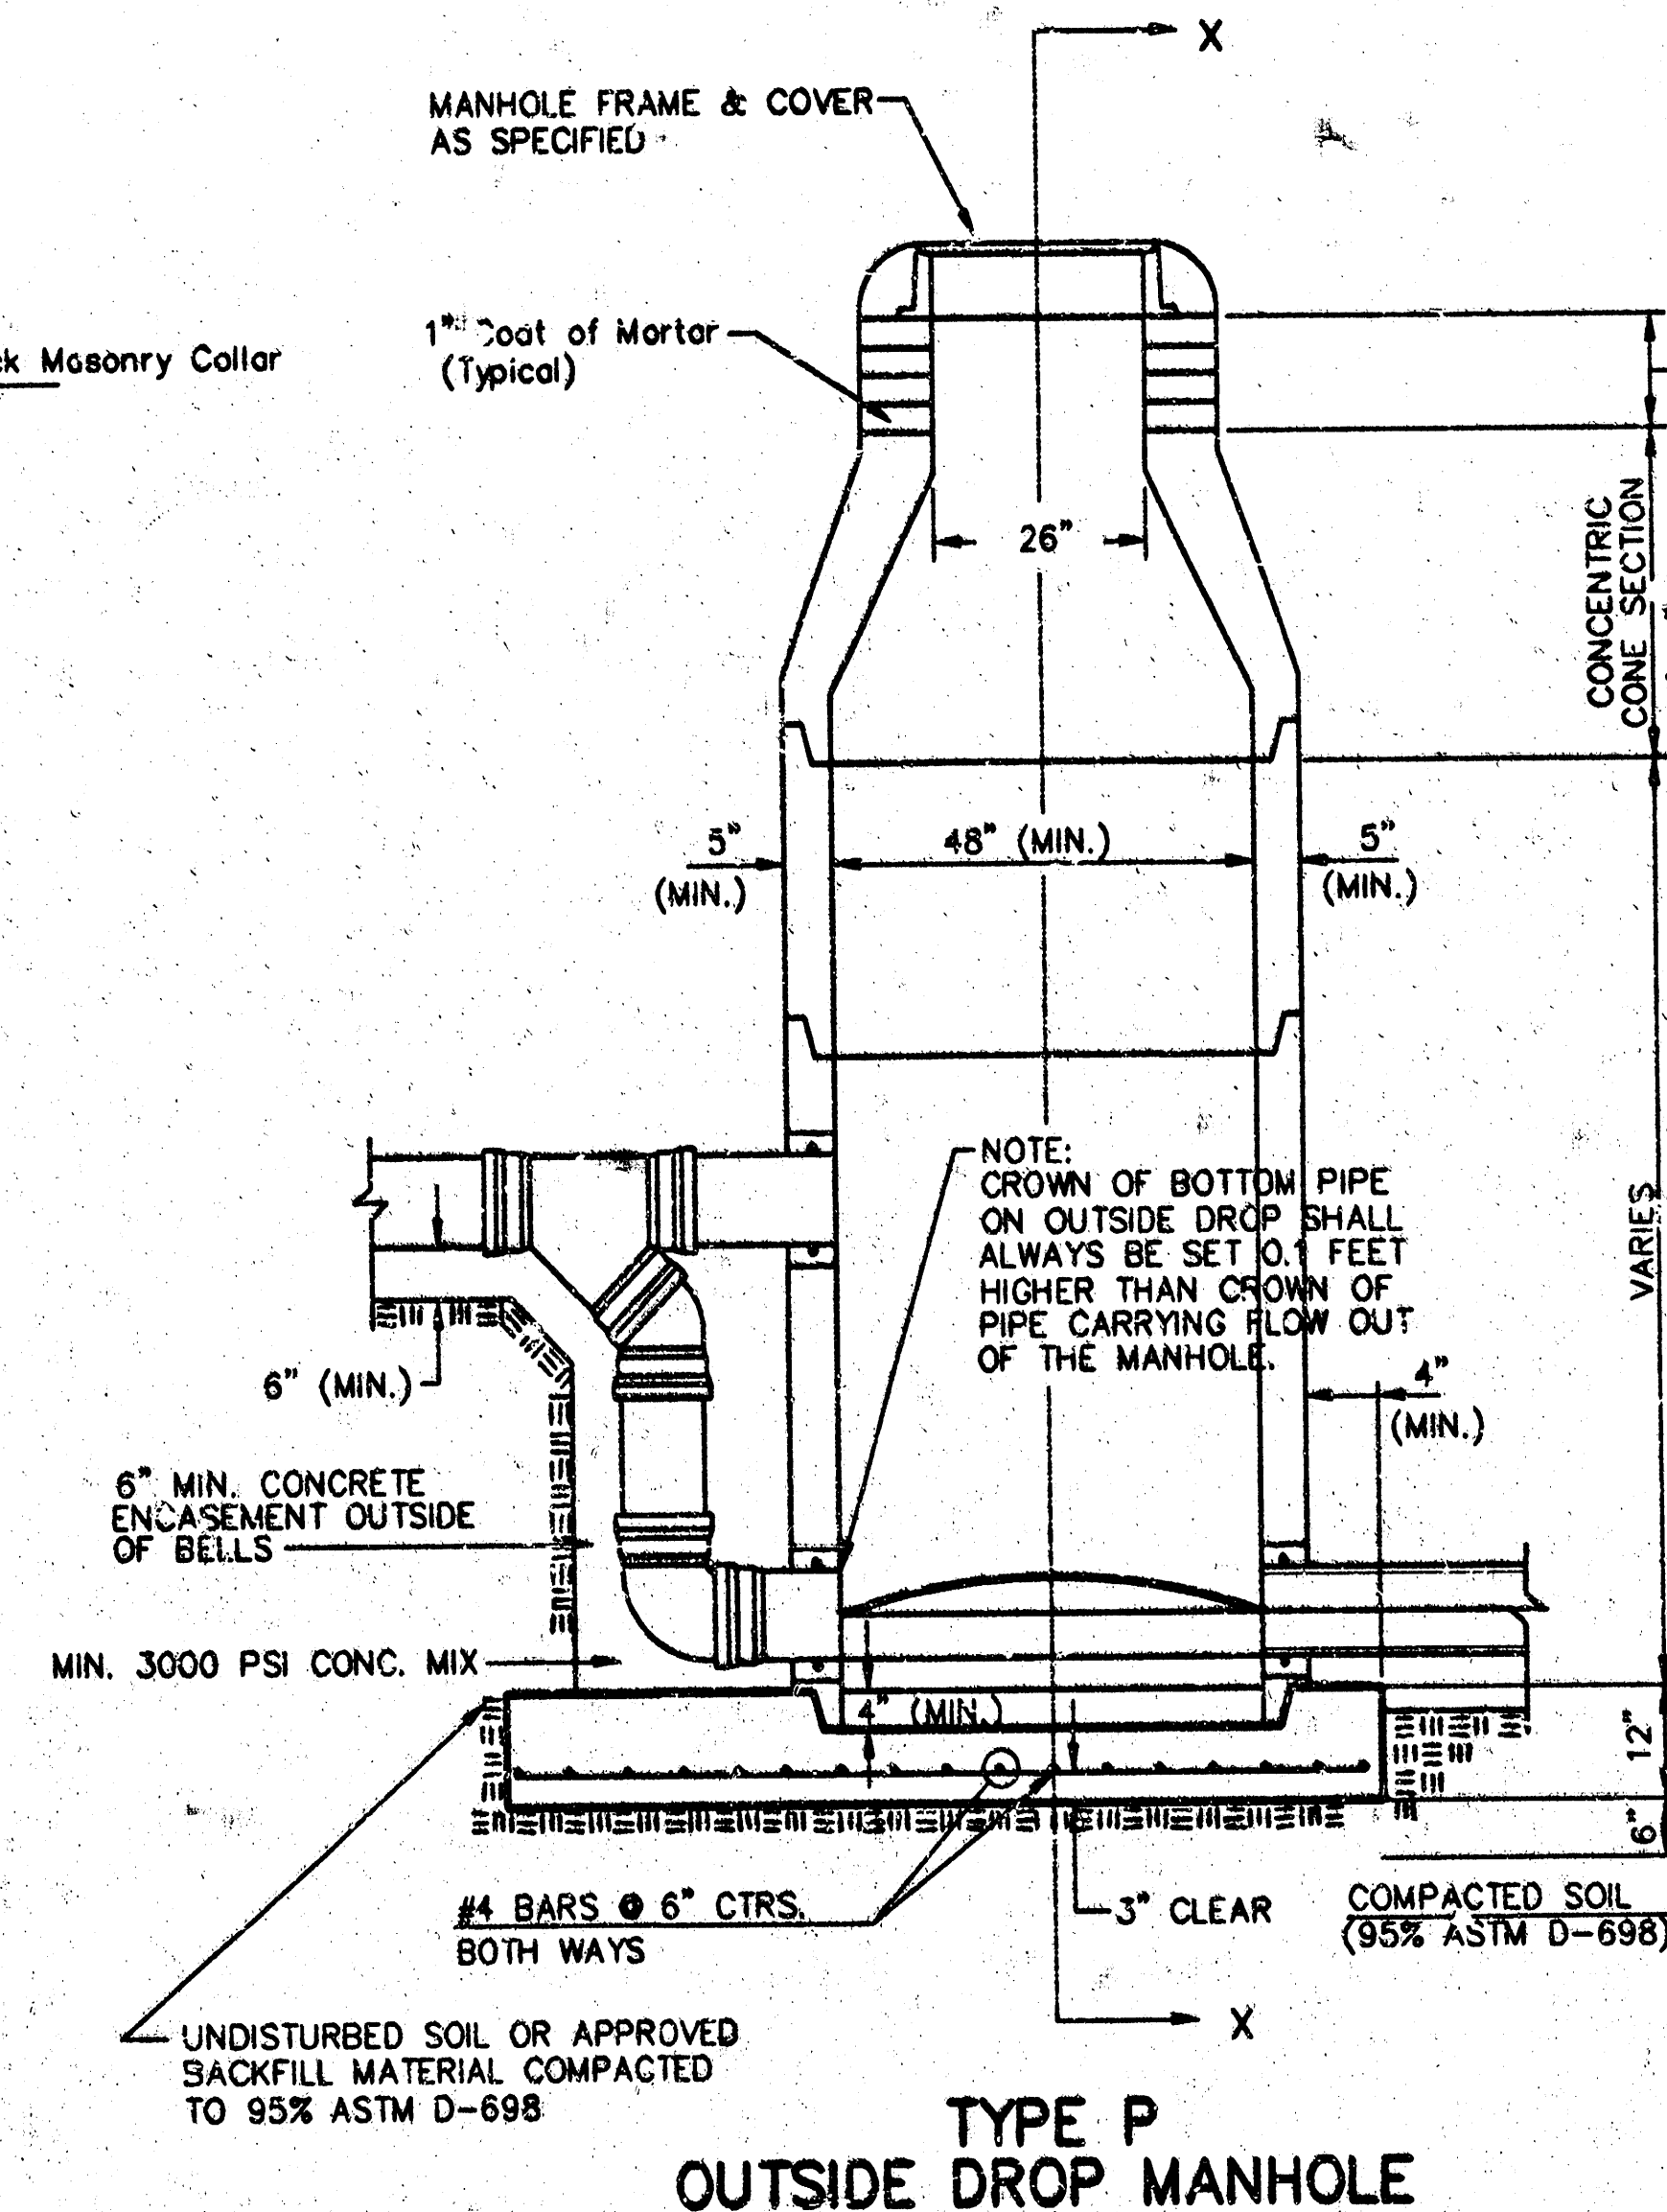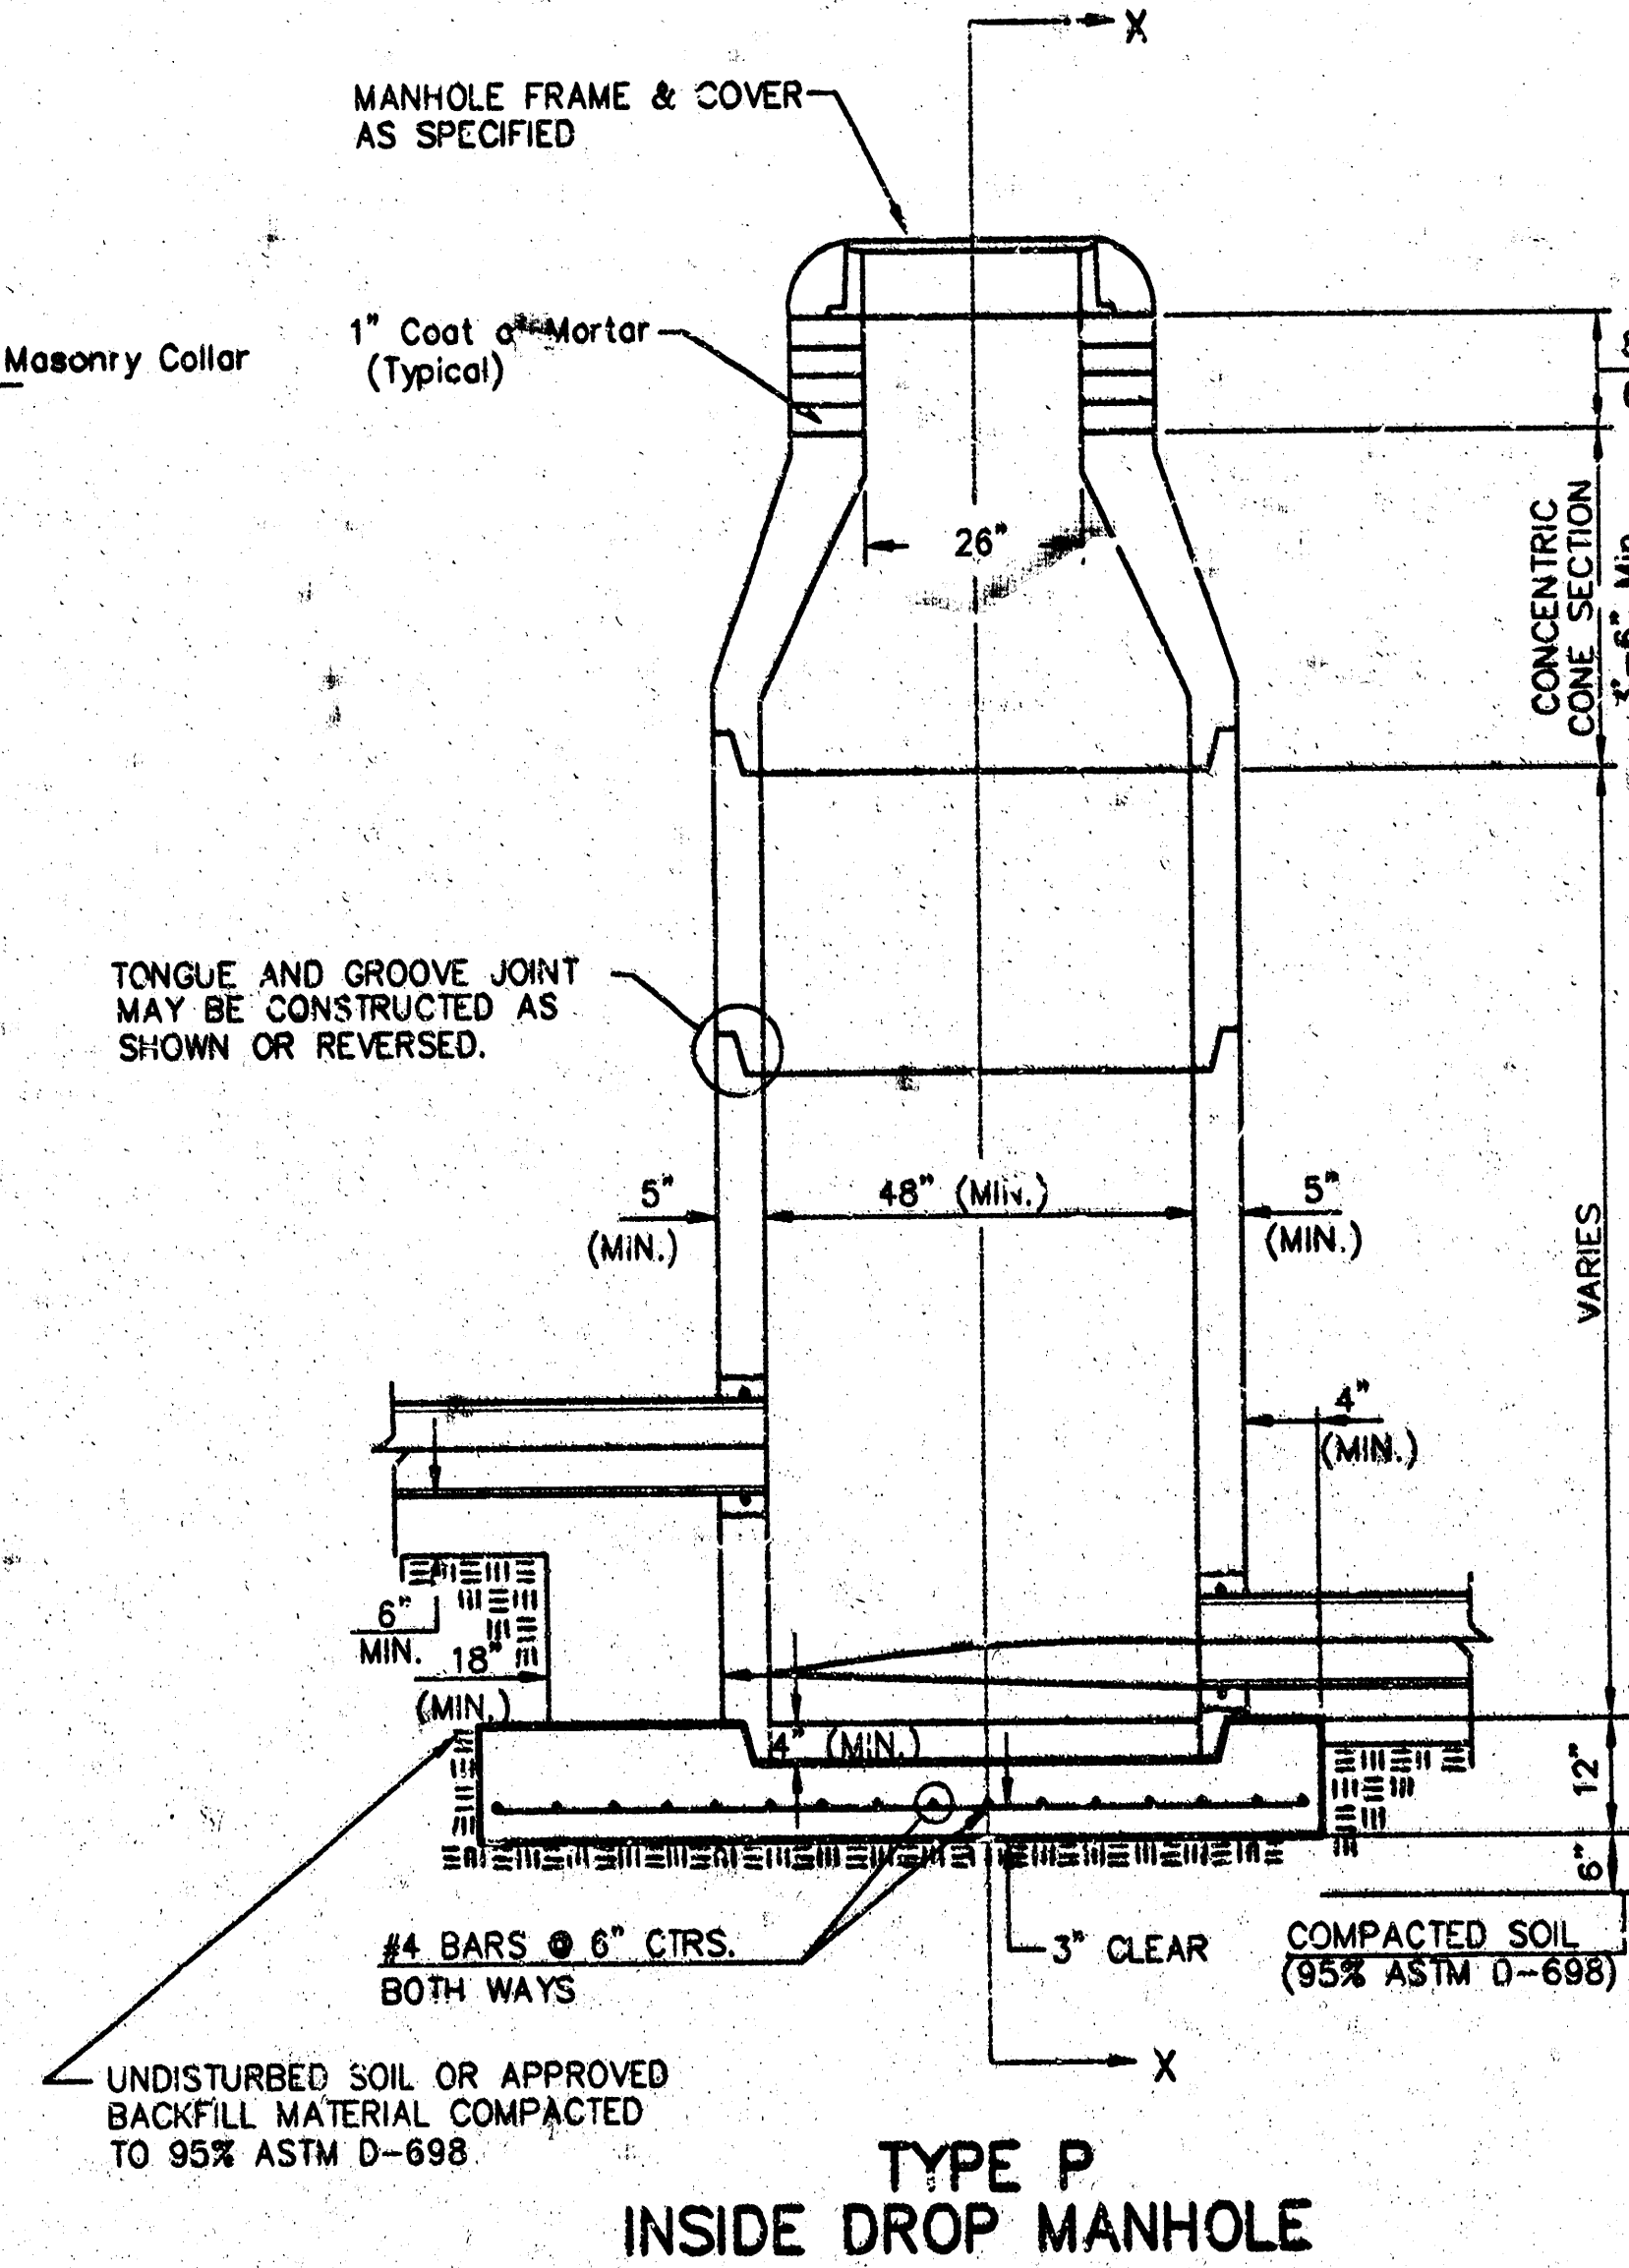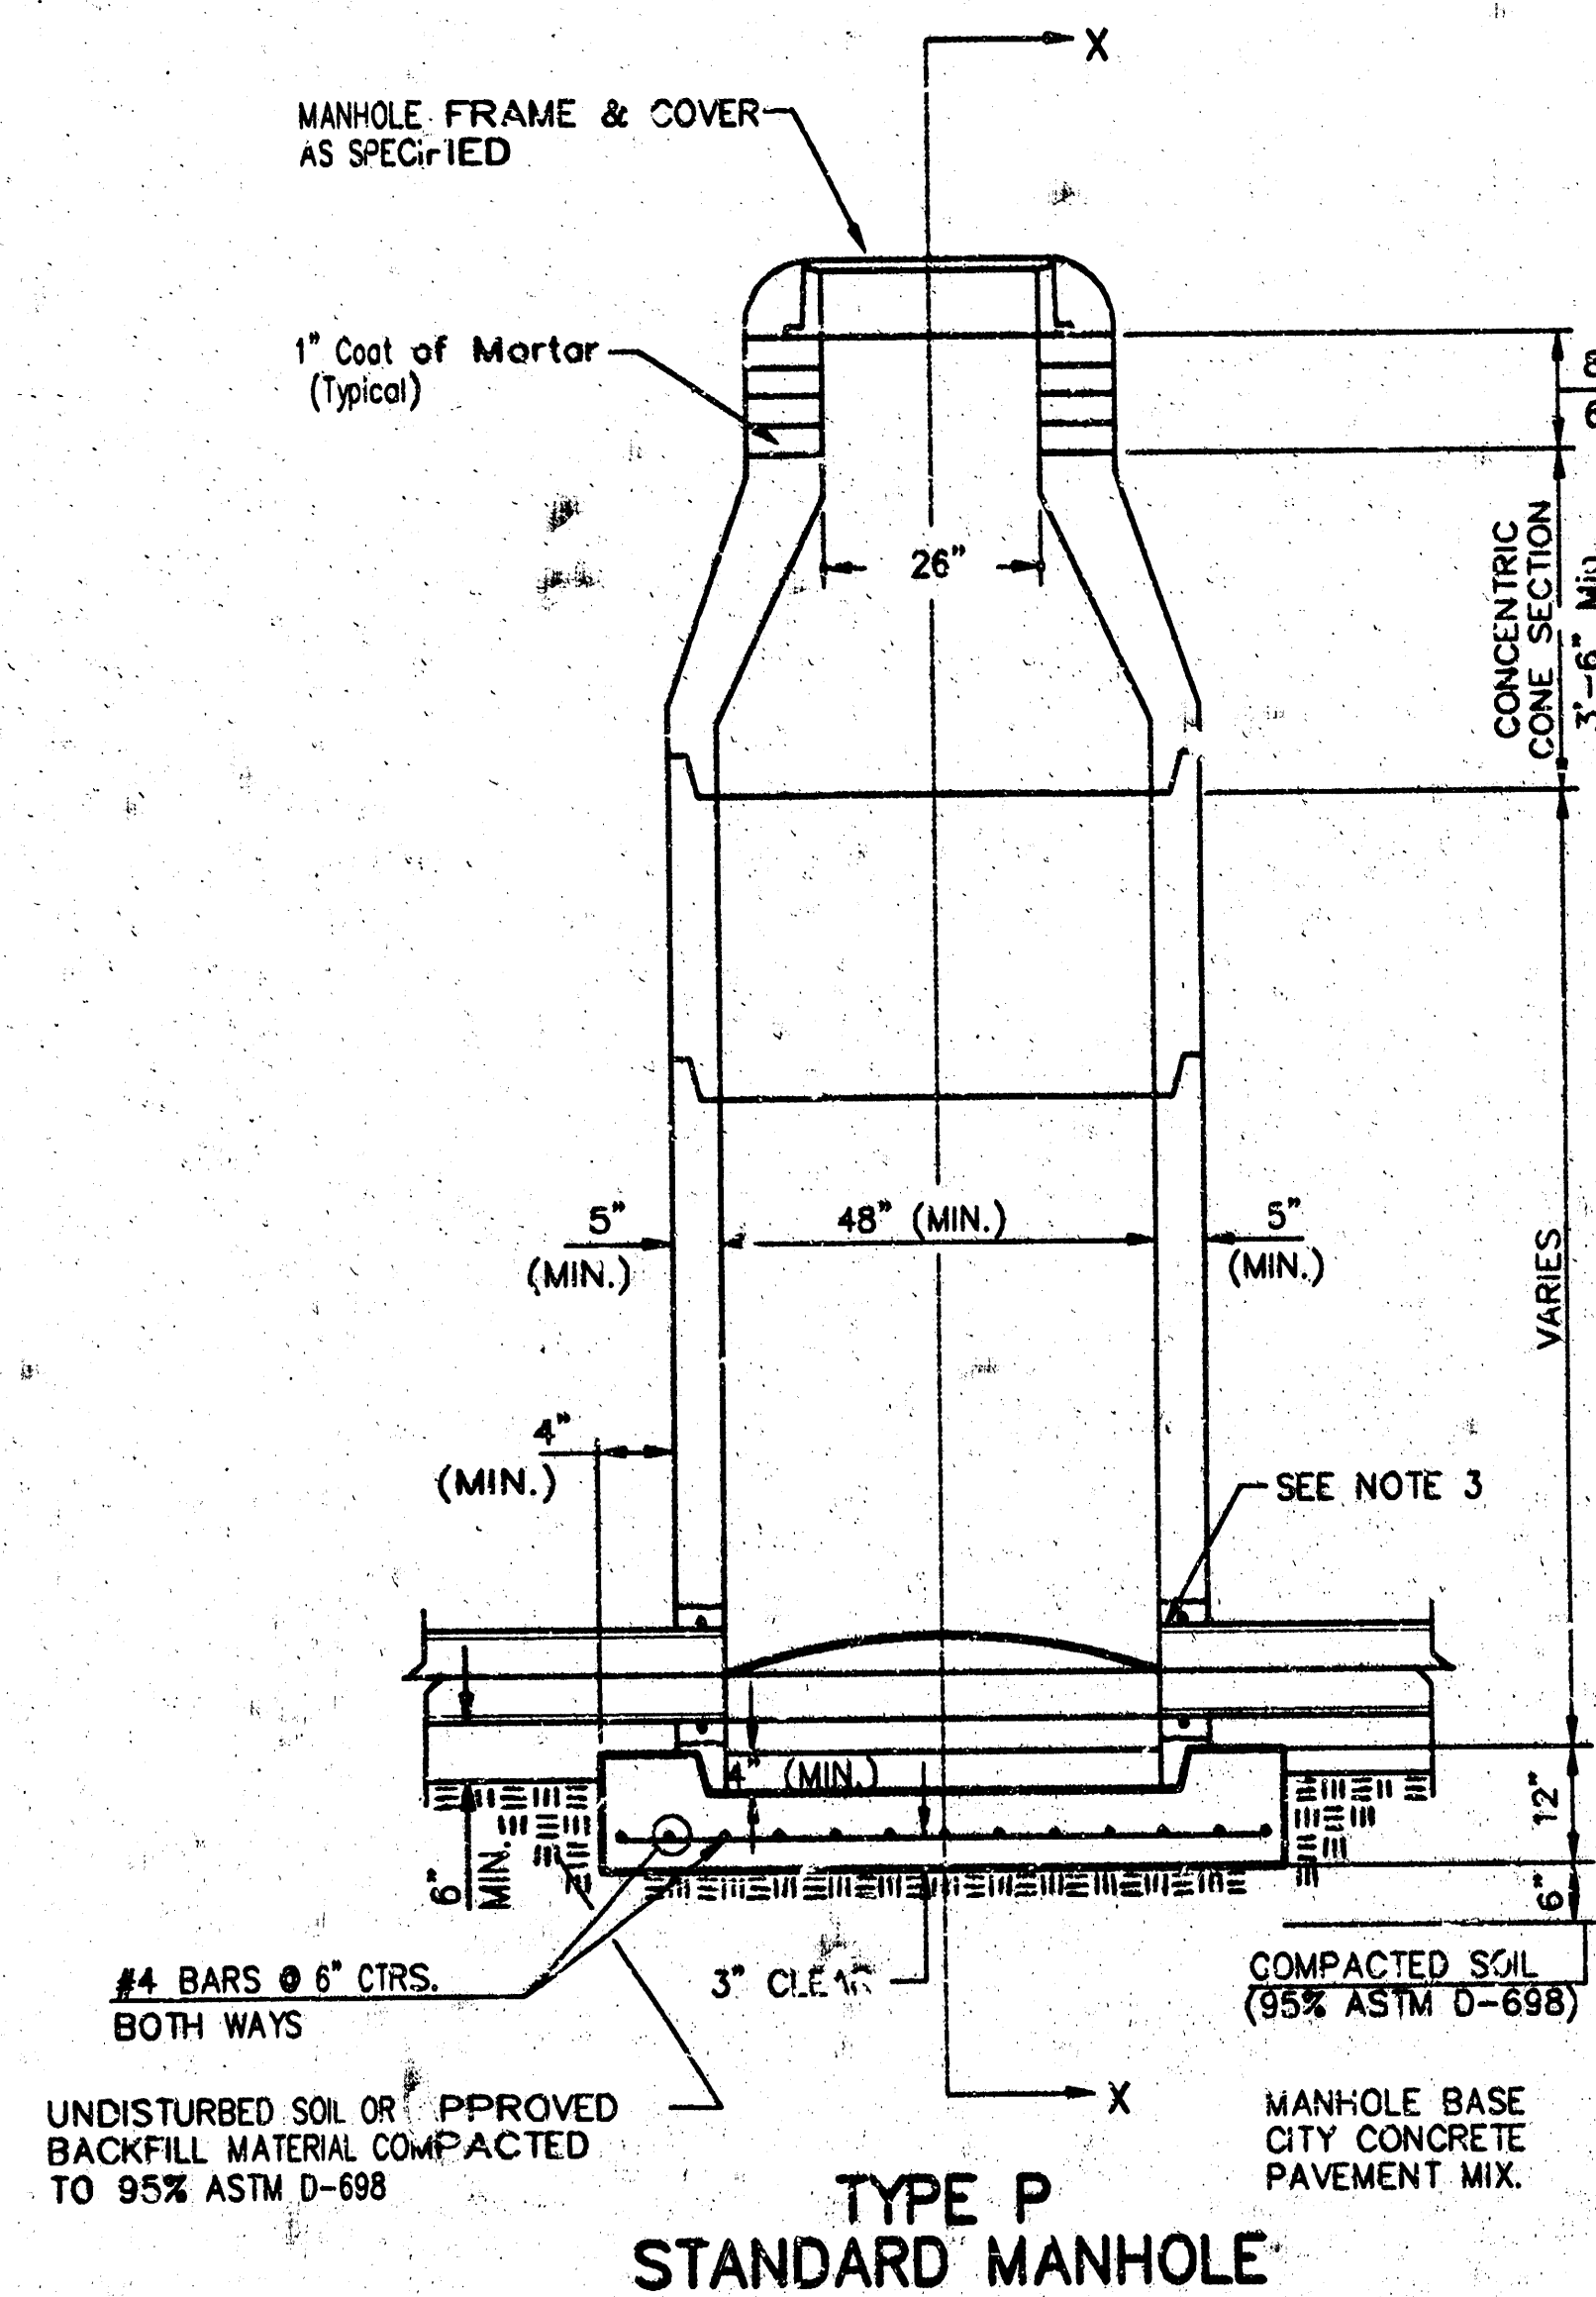

- GENERAL NOTES**
PRECAST MANHOLE NOTES
- ALL PRECAST CONCRETE MANHOLE SECTIONS SHALL CONFORM TO THE LATEST REVISIONS OF A.S.T.M. C478 AS MODIFIED BY THE SPECIFICATIONS.
 - NON-SHRINK GROUT SHALL BE NON-METALLIC TYPE.
 - APPROVED FLEXIBLE WATERSTOP GASKETS SHALL BE INSTALLED TO JOIN THE SEWER TO THE MANHOLE WALL WHEN A.B.S. COMPOSITE PIPE OR P.V.C. PIPE IS USED. FOR OTHER TYPES OF PIPE THE SEWER SHALL BE GROUTED IN PLACE WITH NON-SHRINK GROUT. THE SEWER PIPE SHALL BE SUPPORTED WITH CONCRETE ENCASEMENT A MINIMUM OF 3 FEET FROM THE MANHOLE WALL AND TO THE FIRST JOINT FOR V.C.P. SUCH THAT THE JOINT REMAINS FLEXIBLE.
 - ALL INSIDE SURFACES OF THE CONCRETE MANHOLE WHICH WOULD BE EXPOSED TO SEWER GAS SHALL BE COATED WITH 2 COATS OF MECC SERIES 60 H-BUILD EPOXY/URENE, DRY THICKNESS OF 8 MILS (MIN.).
 - EXTERIOR MANHOLE WALLS SHALL BE COATED WITH 1 COAT MOBILARMA 633 BITUMINOUS COATING.
 - JOINT SEALING COMPOUND SHALL BE KENT SEAL NO. 2 OR APPROVED EQUAL.
 - PRECAST MANHOLES SHALL BE SET AT LEAST 4 INCHES INTO THE MANHOLE BASE.
 - TOP OF MANHOLE FLOOR SLAB SHALL BE AT LEAST 3 INCHES BELOW THE FLOW LINE OF THE OUTLET PIPE TO INSURE SUFFICIENT MINIMUM THICKNESS OF SHAPED INVERT.
 - LIFTING HOLES SHALL BE FILLED WITH NON-SHRINK GROUT AND THE INTERIOR SURFACE COATED AS SPECIFIED.
 - MORTAR USED IN MASONRY CONSTRUCTION SHALL CONTAIN 8 BAGS OF CEMENT PER CUBIC YARD. CONCRETE USED IN MANHOLE BASES SHALL CONFORM TO THE REQUIREMENTS OF CONCRETE FOR CONCRETE PAVEMENT SPECIFICATIONS USING CITY STANDARD PAVING MIX WITHOUT AIR ENTRAINING ADMIXTURE. MORTAR SHALL BE PLACED AROUND THE MANHOLE RING AS SHOWN ON THE DRAWINGS WHEN MANHOLES ARE CONSTRUCTED IN UNPAVED AREAS. MANHOLES CONSTRUCTED WHERE PIPE SIZES ARE SMALLER THAN 24" SHALL HAVE AN INSIDE DIAMETER OF 4". MANHOLES CONSTRUCTED WHERE PIPE SIZES ARE 24" OR LARGER SHALL HAVE AN INSIDE DIAMETER OF 5". COMPLETED MANHOLE SHALL BE WITHOUT LEAKS AND WATER TIGHT.

- REINFORCING STEEL SHALL BE INSTALLED IN THE MANHOLE BASES AND SHALL CONSIST OF NO. 4 BARS PLACED ON 6" CENTERS IN BOTH DIRECTIONS. THE MANHOLE BASE REINFORCEMENT SHALL BE PLACED AT LEAST 3" ABOVE THE BOTTOM OF THE MANHOLE BASE. ALL COSTS FOR FURNISHING AND INSTALLING REINFORCING STEEL SHALL BE INCLUDED IN THE UNIT PRICE BID FOR THE MANHOLE.
- OPENINGS SHALL BE CUT INTO THE MANHOLE WALL WHEN OUTSIDE DROPS ARE CONSTRUCTED ON EXISTING MANHOLES. SUCH OPENINGS OUT INTO EXISTING MANHOLES SHALL BE AS SMALL AS PRACTICAL TO FACILITATE INSTALLING AND GROUTING THE NEW PIPE IN PLACE. WATERSTOP GASKETS SHALL BE USED WITH P.V.C. AND A.B.S. COMPOSITE PIPE. THE NEW PIPE SHALL BE GROUTED INTO THE OPENING USING AN APPROVED NON-SHRINK GROUT FOR THE FULL MANHOLE WALL THICKNESS. THE EXTERIOR OF THE COMPLETED CONNECTION SHALL BE SEALED WITH AN APPROVED BITUMINOUS COATING SUCH THAT THE CONNECTION WILL BE WATER TIGHT. FLOOR OF MANHOLE SHALL BE MODIFIED TO FORM NEW FLOW CHANNEL FOR THE NEW CONNECTION AS INDICATED BY THE DRAWING. THIS WORK, INCLUDING MODIFICATION OF MANHOLE FLOOR, SHALL BE PAID FOR AT THE UNIT PRICE BID FOR OUTSIDE DROP STACK CONSTRUCTED ON EXISTING MANHOLE.
- THE FLOORS OF ALL MANHOLES SHALL BE SHAPED WITH FLOW CHANNELS SUCH THAT THE MANHOLES WILL BE SELF-CLEANING AND FREE OF AREAS WHERE SOLIDS COULD BE DEPOSITED AS SEWAGE FLOWS THROUGH THE MANHOLE FROM ALL INLET PIPES TO THE OUTLET PIPE. FLOW CHANNELS SHALL BE FORMED TO MATCH THE BOTTOM HALVES OF THE INFLOWING PIPES AND THE OUTFLOWING PIPE AS SHOWN BY THE DRAWINGS EXCEPT FOR INSIDE DROP MANHOLES. FLOW CHANNELS FOR INSIDE DROP MANHOLES SHALL BE CONSTRUCTED AS INDICATED BY THE DRAWING. MANHOLE FLOORS SHALL HAVE SLOPES OF 3 INCHES PER FOOT IN THE AREAS OUTSIDE OF THE FLOW CHANNELS SLOPED TOWARD THE FLOW CHANNELS. PIPES LAID THROUGH MANHOLES SHALL HAVE THE TOP HALF REMOVED TO NEAR LINES FOR THE FULL INSIDE DIAMETER OF THE MANHOLE. MANHOLE FLOORS SHALL THEN BE SHAPED AROUND THE BOTTOM HALF OF THE PIPE WHICH FORMS THE FLOW CHANNEL.
- PIPES INSTALLED WITHIN THE EXCAVATION MADE FOR THE MANHOLE SHALL BE CRADLED WITH CONCRETE TO THE LIMITS OF THE MANHOLE EXCAVATION. WHEN CLAY PIPE IS USED, THE CRADLE SHALL EXTEND TO THE FIRST JOINT OUTSIDE THE MANHOLE. THE CRADLE SHALL BE TERMINATED AT THE CLAY PIPE JOINT IN A MANNER WHICH WILL MAINTAIN THE FLEXIBILITY OF THE JOINT. COST OF CRADLE WITHIN MANHOLE EXCAVATION OR TO CLAY PIPE JOINTS ADJACENT TO MANHOLE SHALL BE INCLUDED IN THE UNIT PRICE BID FOR THE MANHOLE.


- MANHOLE COVER CASTINGS AND MANHOLE FRAME CASTINGS SHALL CONFORM TO THE REQUIREMENTS AS INDICATED IN THE STANDARD SPECIFICATIONS AND AS SHOWN IN THE STANDARD DETAIL DRAWING.
- THE VERTICAL DROP IN INSIDE DROP MANHOLES SHALL NOT EXCEED 2' FOR INFLOWING PIPES SIZED 12" OR SMALLER AND 2' FOR INFLOWING PIPES LARGER THAN 12". THE CROWNS OF INFLOWING PIPES SHALL NEVER BE SET LOWER THAN THE CROWN OF THE OUTFLOWING PIPE.
- STANDARD MANHOLES AND STANDARD INSIDE DROP MANHOLES SHALL BE BID AS STANDARD MANHOLES FOR THE TYPE AND DIAMETER INDICATED. OUTSIDE DROP MANHOLES SHALL BE BID AS STANDARD OUTSIDE DROP MANHOLES FOR THE TYPE AND DIAMETER INDICATED. ALL MANHOLE DIMENSIONS WILL BE 4" UNLESS INDICATED OTHERWISE.
- A BRICK MASONRY COLLAR SHALL BE INSTALLED BETWEEN THE CAST IRON FRAME AND THE CONCENTRIC CONE. THE COLLAR WILL HAVE 8" WALLS AND A VERTICAL HEIGHT OF 6" MINIMUM AND 18" MAXIMUM. A 1" COAT OF MORTAR WILL BE PLASTERED ON THE OUTSIDE OF THE COLLAR. THE USE OF PRE-CAST CONCRETE SPACERS FOR MANHOLE TOP ADJUSTMENT IS ALSO ALLOWED.

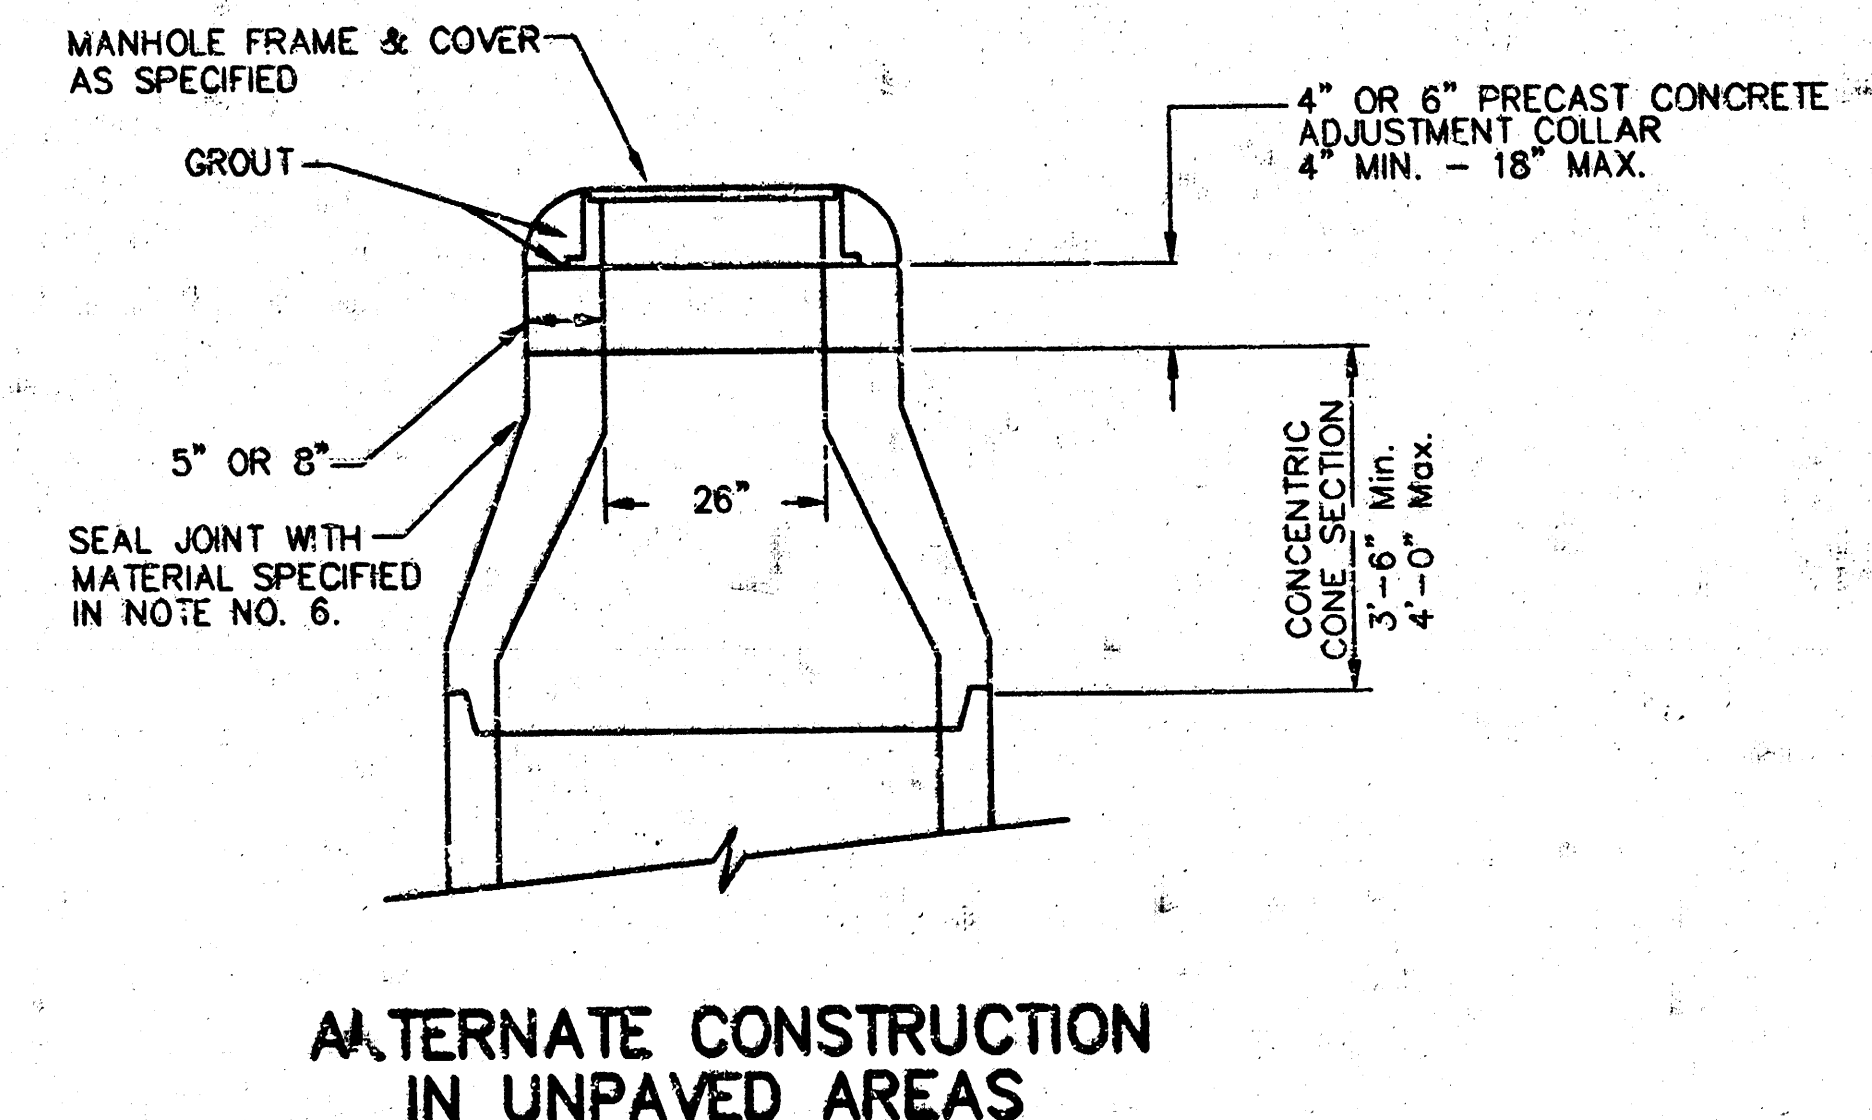

STD. MANHOLE DETAILS			
SEWER APPURTENANCES			
ED BAUGHMAN COMPANY P.A.			
ENGINEERING, SURVEYING, & PLANNING			
316-262-7221 • 316-262-7222 • 316-262-7223 • 316-262-7224 • 316-262-7225 • 316-262-7226 • 316-262-7227 • 316-262-7228 • 316-262-7229 • 316-262-7230 • 316-262-7231 • 316-262-7232 • 316-262-7233 • 316-262-7234 • 316-262-7235 • 316-262-7236 • 316-262-7237 • 316-262-7238 • 316-262-7239 • 316-262-7240 • 316-262-7241 • 316-262-7242 • 316-262-7243 • 316-262-7244 • 316-262-7245 • 316-262-7246 • 316-262-7247 • 316-262-7248 • 316-262-7249 • 316-262-7250 • 316-262-7251 • 316-262-7252 • 316-262-7253 • 316-262-7254 • 316-262-7255 • 316-262-7256 • 316-262-7257 • 316-262-7258 • 316-262-7259 • 316-262-7260 • 316-262-7261 • 316-262-7262 • 316-262-7263 • 316-262-7264 • 316-262-7265 • 316-262-7266 • 316-262-7267 • 316-262-7268 • 316-262-7269 • 316-262-7270 • 316-262-7271 • 316-262-7272 • 316-262-7273 • 316-262-7274 • 316-262-7275 • 316-262-7276 • 316-262-7277 • 316-262-7278 • 316-262-7279 • 316-262-7280 • 316-262-7281 • 316-262-7282 • 316-262-7283 • 316-262-7284 • 316-262-7285 • 316-262-7286 • 316-262-7287 • 316-262-7288 • 316-262-7289 • 316-262-7290 • 316-262-7291 • 316-262-7292 • 316-262-7293 • 316-262-7294 • 316-262-7295 • 316-262-7296 • 316-262-7297 • 316-262-7298 • 316-262-7299 • 316-262-7300 • 316-262-7301 • 316-262-7302 • 316-262-7303 • 316-262-7304 MANHOLE FRAME
Weight = 145 Lbs.

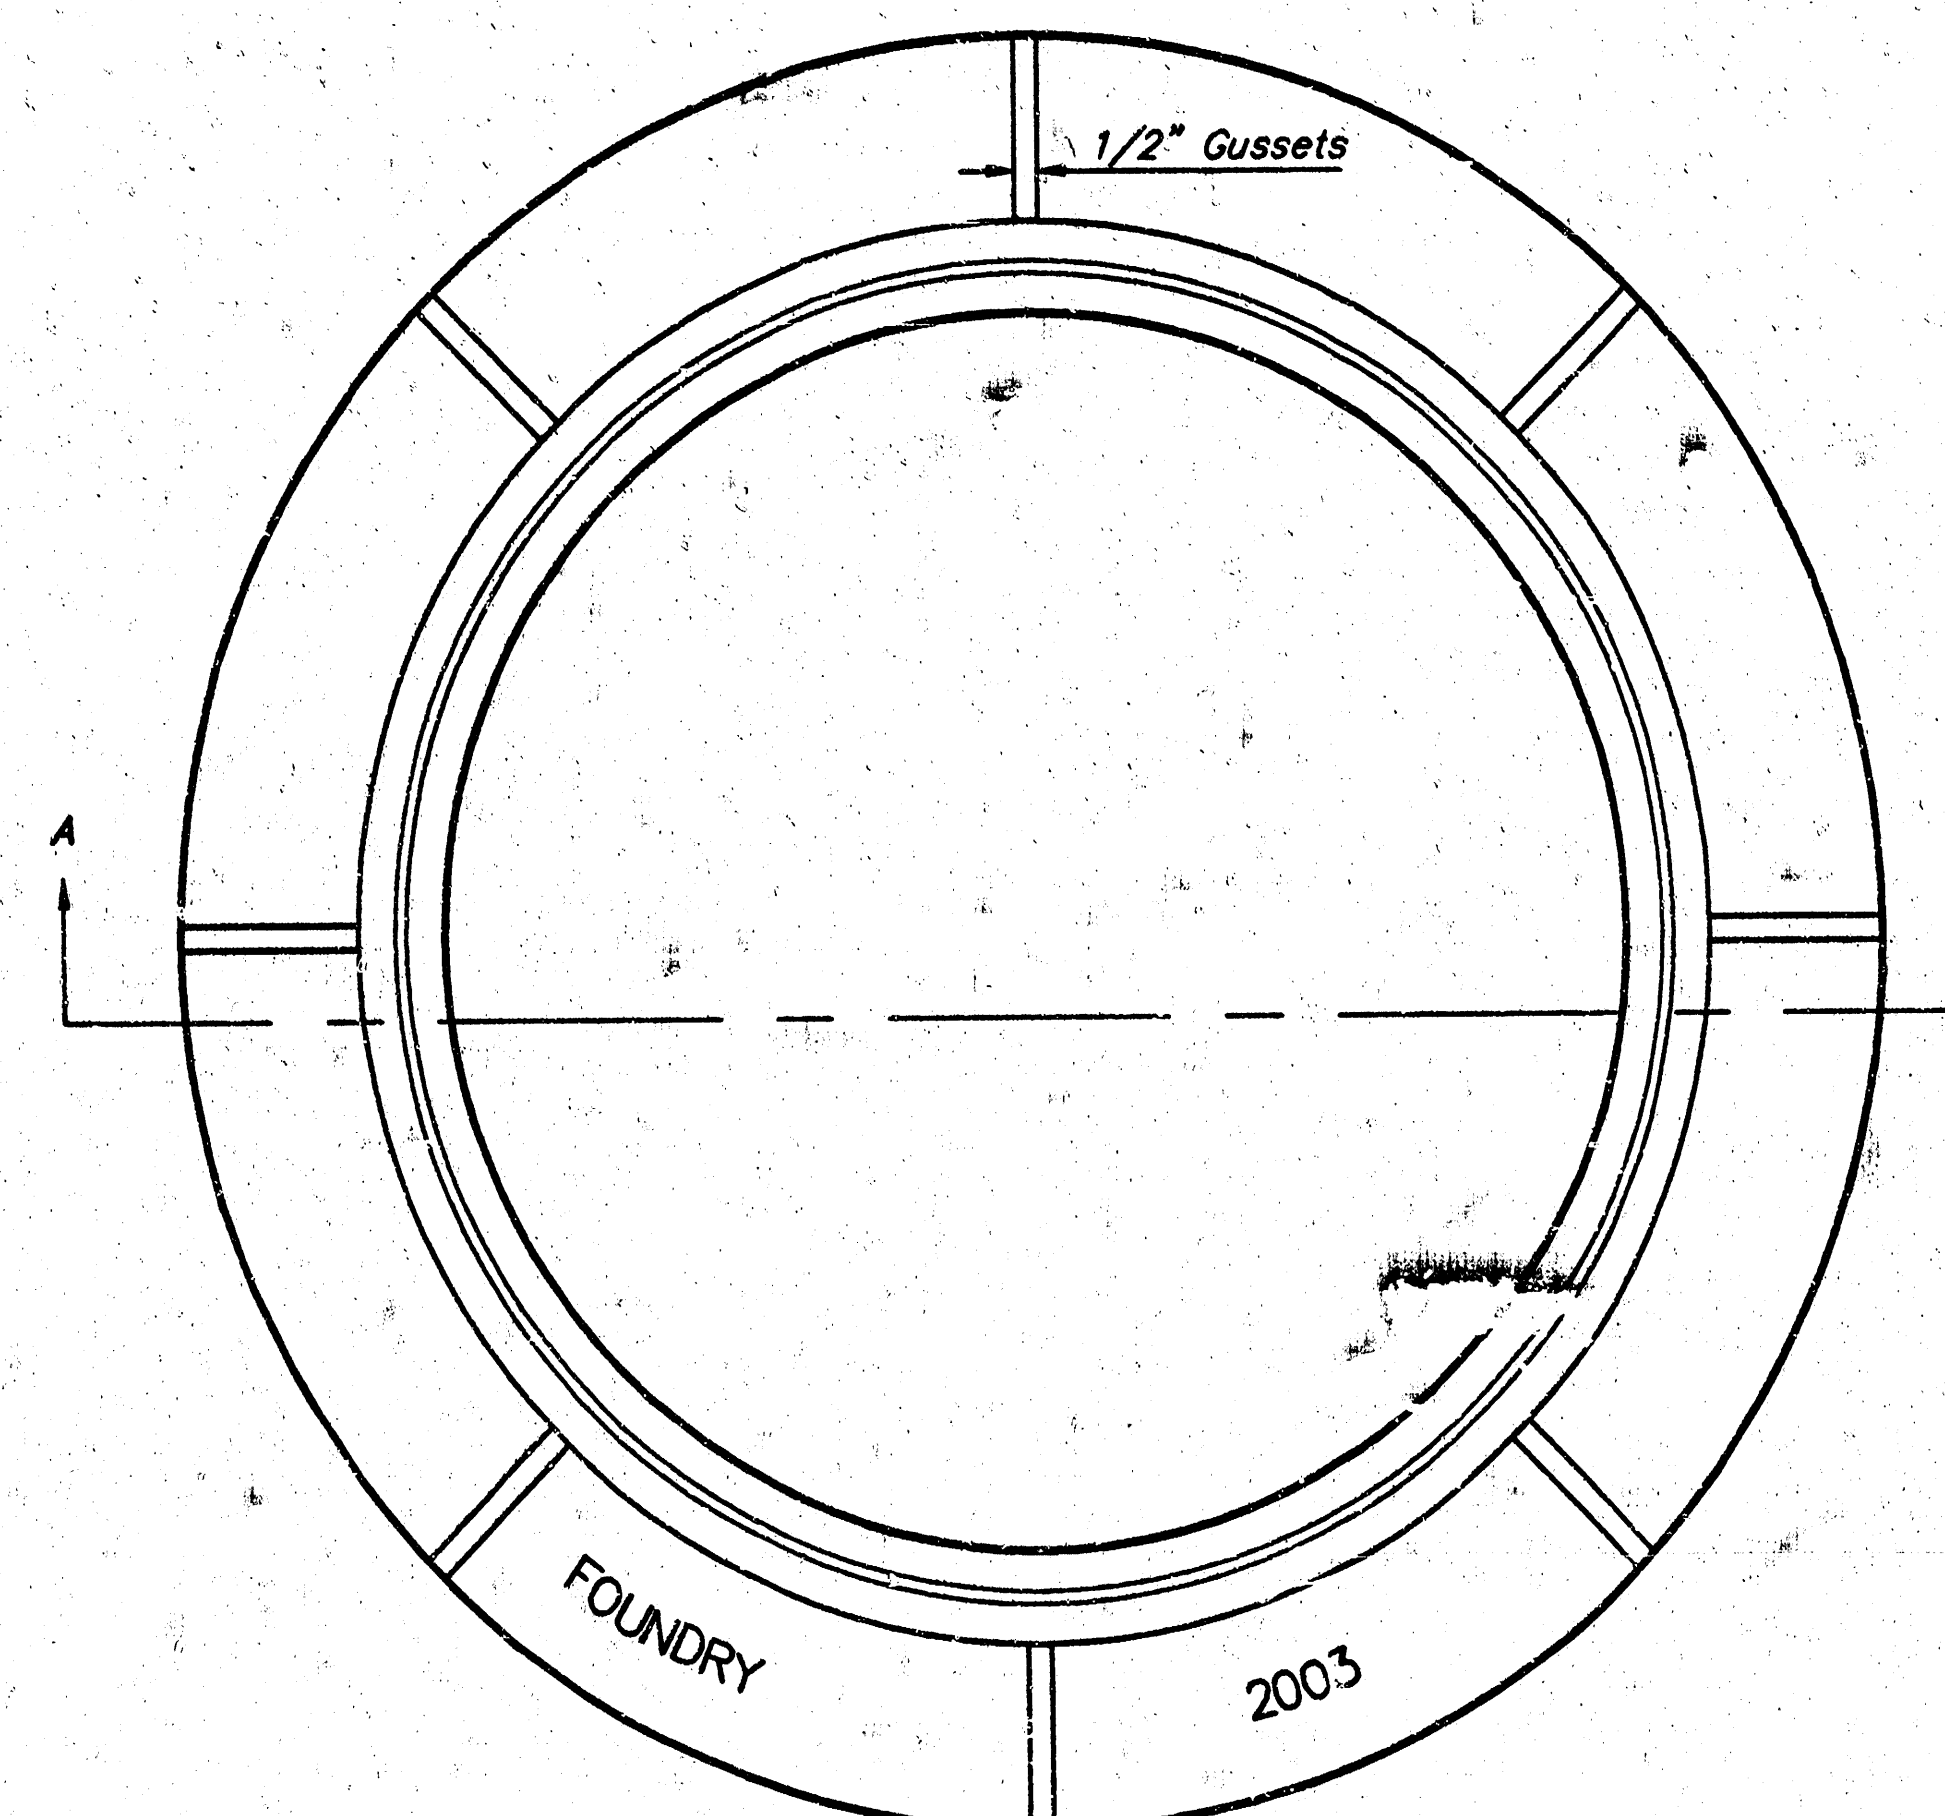[illegible]

MANHOLE CASTINGS SHALL BE MANUFACTURED USING GOOD QUALITY GRAY IRON CONFORMING TO CLASS 30 OF A.S.T.M. DESIGNATION A-19. DIMENSIONS SHALL FOLLOW OR THE DETAILED DRAWING SHALL BE CONSIDERED AS MINIMUM REQUIREMENTS AND ANY DEVIATIONS FROM THE DIMENSIONS SHOWN MUST BE SPECIFICALLY APPROVED. THE FINISHED CASTINGS SHALL BE OF UNIFORM QUALITY, FREE FROM BLOWHOLES, POROSITY, HARD SPOTS, SHRINKAGE DISTORTIONS OR OTHER DEFECTS.

MANHOLE CASTINGS SHALL BE COATED WITH AN ASPHALT PAINT RESULTING IN A SMOOTH, TOUGH AND TENACIOUS COATING WHICH IS NOT BRITTLE OR TACKY.


MANHOLE CASTINGS SHALL BE MANUFACTURED SUCH THAT A COVER MANUFACTURED BY ANY ONE
FOUNDRY WILL FIT INTERCHANGEABLY INTO A FRAME MANUFACTURED BY ANOTHER FOUNDRY AND
STILL MEET ALLOWABLE CLEARANCES AND NON-ROCKING REQUIREMENTS. THIS WILL REQUIRE
MANUFACTURING OF THE MATCHING FACES ON THE COVER AND THE FRAME TO CLOSE TOLERANCES.

THE OUTSIDE CIRCUMFERENCE OF THE VERTICAL FACE OF THE COVER AND THE INSIDE CIRCUMFERENCE OF THE VERTICAL FACE IN THE FRAME RECESS SHALL BE MANUFACTURED TO SUCH A TOLERANCE THAT THE CLEARANCE BETWEEN THE COVER AND FRAME SHALL NOT EXCEED 1/8" AT ANY POINT AROUND THE CIRCUMFERENCE OF THE COVER. THE SEATING SURFACES BETWEEN THE COVER AND FRAME SHALL BE MACHINED SUCH AS THESE SURFACES SHALL MAKE FULL CONTACT FOR THEIR FULL CIRCUMFERENCE TO PRECLUDE THE COVER FROM ROCKING IN THE FRAME.

THE MANHOLE FRAME AND COVER SHALL BE MARKED WITH LETTERING INDICATING THE NAME OF THE MANUFACTURER AND THE YEAR THE COVER AND FRAME WAS CAST. THE COVER SHALL BE FURTHER IDENTIFIED WITH REGARDS TO OWNERSHIP USING LETTERS AT LEAST 1 INCH IN HEIGHT. THIS IDENTIFICATION SHALL BE "CITY OF MOHITA SEWER DEPARTMENT". THE WORD DEPARTMENT MAY BE ABBREVIATED. THE TEXTURE OF THE TOP SURFACE OF THE COVER SHALL BE MANUFACTURED IN A CHECKERED PATTERN DESIGN AS INDICATED ON THE DRAWINGS. BOTH BLOCKS OF SMOOTH SHALL BE UTILIZED TO OBTAIN THE LETTERING SURFACE. THE TOTAL AREA OF SMOOTH SURFACE BLOCKOUT SHALL NOT EXCEED THE AREA AS INDICATED ON THE DRAWING. POSITIONING OF SMOOTH BLOCKOUTS AND LETTERING MAY VARY FROM THAT SHOWN ON THE DETAILED DRAWING.

MANHOLE FRAME AND COVER DETAIL				
ADOPTED AS STANDARD DESIGN BY CITY OF WICHITA, KANSAS				
 BAUGHMAN COMPANY P.A. ENGINEERING, SURVEYING, & PLANNING				
316-262-7271 • 315 ELLIS • WICHITA, KANSAS 67211				
PROJECT NUMBER 1402 PPS 807861				
DESIGN DATE	DRAWN DATE	APPROVED	DATE 104	SCALE NONE
SHEET 4 OF 5				

BAREFOOT BAY ESTATES WICHITA, SEDGWICK COUNTY, KANSAS

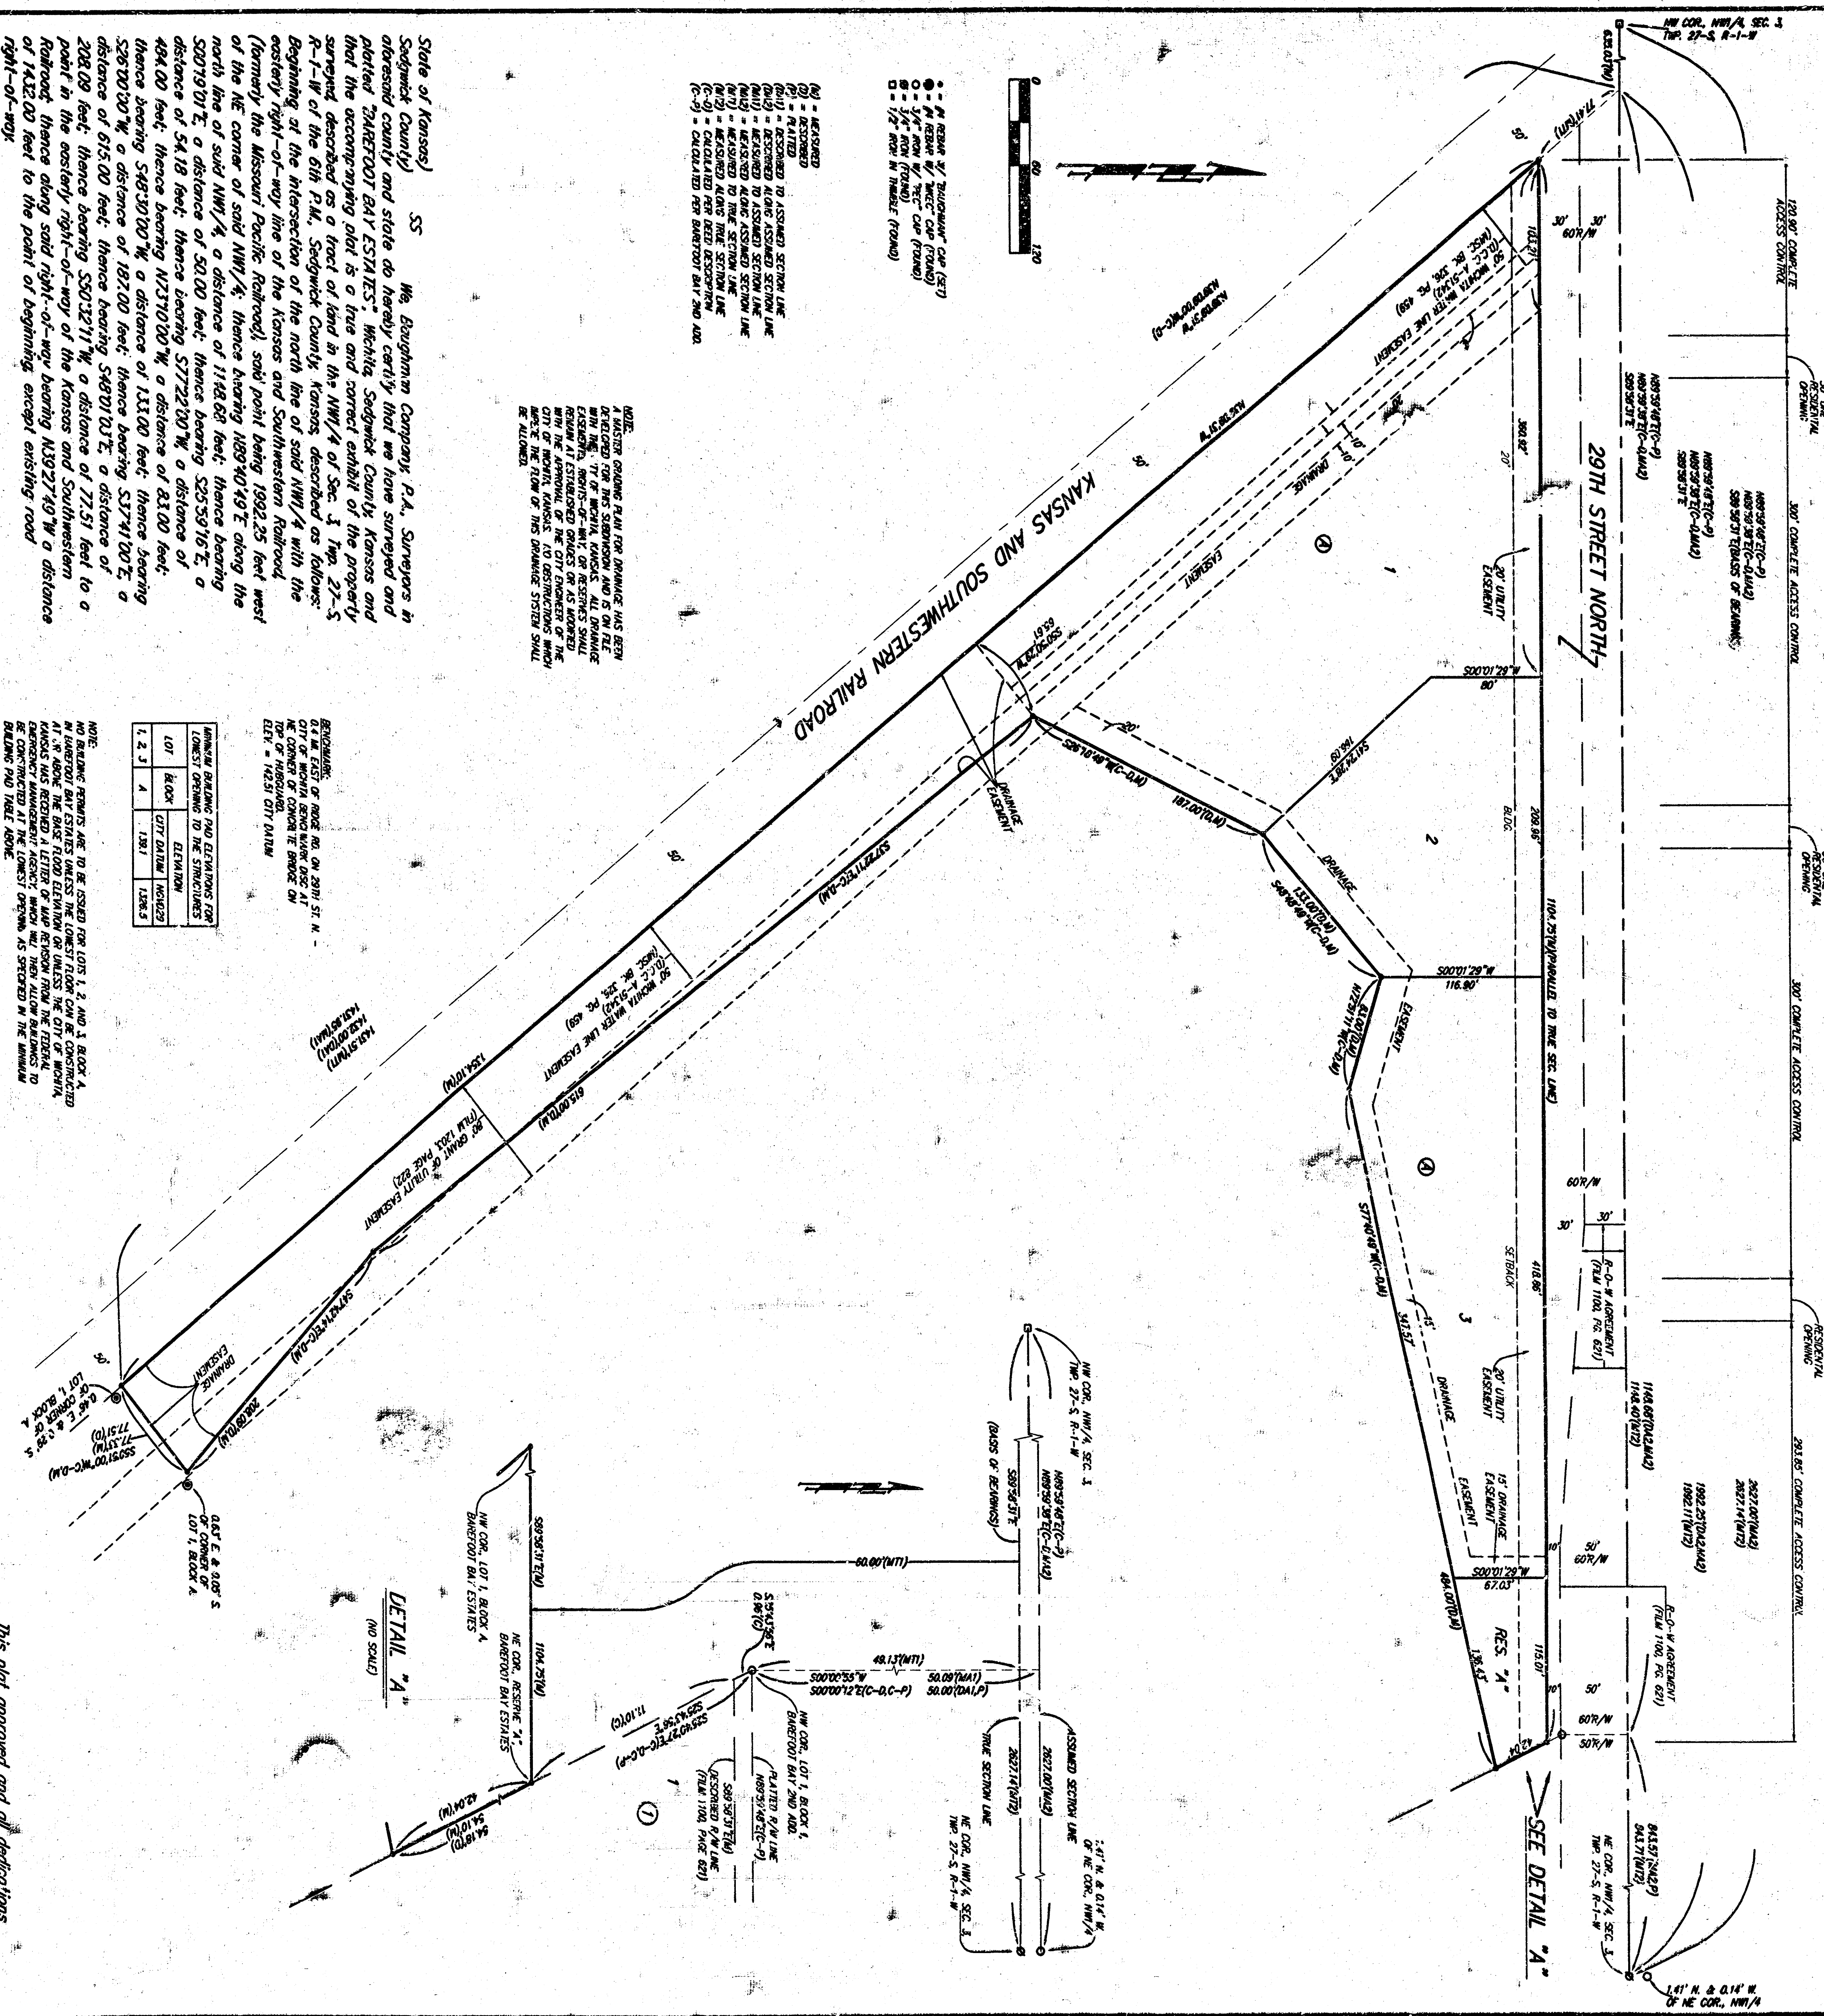

State of Kansas) SS We, Baughman Company, P.A., Surveyors in Sedgewick County and state do hereby certify that we have surveyed and plotted BAREFOOT BAY ESTATES, Wichita, Sedgewick County, Kansas, and that the accompanying plat is a true and correct copy of the plat as surveyed, described as a tract of land in the NW 1/4 of Sec. 1, T. 23 N., R. 12 E., of the 6th P.M., being of the north line of said NW 1/4 with the boundary line of the intersection of the Kansas and Southwestern Railroad (formerly the Missouri Pacific Railroad), said point being 1992.25 feet west of the NE corner, said NW 1/4, thence bearing 114°42'58" East, thence along the north line of said NW 1/4, a distance of 58.00 feet, thence bearing S72°22'10" W, a distance of 54.18 feet, thence bearing 173°10'00" N, a distance of 81.00 feet, thence bearing S46°30'00" N, a distance of 131.00 feet, thence bearing S28°00'00" N, a distance of 167.00 feet, thence bearing S17°10'00" E, a distance of 615.00 feet, thence bearing S50°12'11" N, a distance of 27.25 feet to a point in the eastern right-of-way of the Kansas and Southwestern Railroad, thence along said right-of-way bearing N33°27'00" W a distance of 142.00 feet to the point of beginning, except existing road right-of-way.

Existing public easements and dedications being recorded by virtue of K.S.A. 12-512(a).

Baughman Company, P.A.

Michael G. Conroy
Surveyor

Know all men by these presents that we, the undersigned, have caused this plat to be surveyed and plotted as aforesaid, to be BAREFOOT BAY ESTATES, Wichita, Sedgewick County, Kansas. The utility easement is hereby granted as indicated for the construction and maintenance of all public utilities. The drainage easements are hereby granted as indicated for drainage purposes. The street "A" is hereby dedicated to and for the use of the public. Reserve "1" is hereby reserved for drainage purposes, Reserve "1" shall be owned and maintained by the owner of Lot 3, Block 4. All duties rights of access shall be as depicted on the face of the plat and are hereby granted to the City of Wichita, Kansas. The Minimum Building Foot Elevation for the lot(s) opening to the structures on Lots 1, 2 and 3, Block 4, shall be 1381 City Datum, (1328.5 MVD029).

Michael D. Shell
Sanford D. Shell

State of)
County) SS The foregoing instrument acknowledged before me this _____ day of _____, by Michael D. Shell and Sanford D. Shell, husband and wife.

My Exp. _____, Notary Public

We, the undersigned holders of a mortgage on the above described property do hereby consent to this plat of BAREFOOT BAY ESTATES, Wichita, Sedgewick County, Kansas.

Convey Bank, P.A.
The First National Bank of Conway Springs

ANNUAL DRAINAGE AND ELEVATIONS FOR LOT(S) OPENING TO THE STRUCTURES	
LOT	Block
1, 2, 3, 4	101, 102, 103, 104

NOTE: READING PLANS ARE TO BE ISSUED FOR LOTS 1, 2 AND 3, BLOCK 4, AND LOTS 5, 6, 7, 8, 9, 10, BLOCK 4, AND LOTS 11, 12, 13, 14, 15, 16, 17, 18, 19, 20, BLOCK 4, AND LOTS 21, 22, 23, 24, 25, 26, 27, 28, 29, 30, BLOCK 4, AND LOTS 31, 32, 33, 34, 35, 36, 37, 38, 39, 40, BLOCK 4, AND LOTS 41, 42, 43, 44, 45, 46, 47, 48, 49, 50, BLOCK 4, AND LOTS 51, 52, 53, 54, 55, 56, 57, 58, 59, 60, BLOCK 4, AND LOTS 61, 62, 63, 64, 65, 66, 67, 68, 69, 70, BLOCK 4, AND LOTS 71, 72, 73, 74, 75, 76, 77, 78, 79, 80, BLOCK 4, AND LOTS 81, 82, 83, 84, 85, 86, 87, 88, 89, 90, BLOCK 4, AND LOTS 91, 92, 93, 94, 95, 96, 97, 98, 99, 100, BLOCK 4, AND LOTS 101, 102, 103, 104, 105, 106, 107, 108, 109, 110, BLOCK 4, AND LOTS 111, 112, 113, 114, 115, 116, 117, 118, 119, 120, BLOCK 4, AND LOTS 121, 122, 123, 124, 125, 126, 127, 128, 129, 130, BLOCK 4, AND LOTS 131, 132, 133, 134, 135, 136, 137, 138, 139, 140, BLOCK 4, AND LOTS 141, 142, 143, 144, 145, 146, 147, 148, 149, 150, BLOCK 4, AND LOTS 151, 152, 153, 154, 155, 156, 157, 158, 159, 160, BLOCK 4, AND LOTS 161, 162, 163, 164, 165, 166, 167, 168, 169, 170, BLOCK 4, AND LOTS 171, 172, 173, 174, 175, 176, 177, 178, 179, 180, BLOCK 4, AND LOTS 181, 182, 183, 184, 185, 186, 187, 188, 189, 190, BLOCK 4, AND LOTS 191, 192, 193, 194, 195, 196, 197, 198, 199, 200, BLOCK 4, AND LOTS 201, 202, 203, 204, 205, 206, 207, 208, 209, 210, BLOCK 4, AND LOTS 211, 212, 213, 214, 215, 216, 217, 218, 219, 220, BLOCK 4, AND LOTS 221, 222, 223, 224, 225, 226, 227, 228, 229, 230, BLOCK 4, AND LOTS 231, 232, 233, 234, 235, 236, 237, 238, 239, 240, BLOCK 4, AND LOTS 241, 242, 243, 244, 245, 246, 247, 248, 249, 250, BLOCK 4, AND LOTS 251, 252, 253, 254, 255, 256, 257, 258, 259, 260, BLOCK 4, AND LOTS 261, 262, 263, 264, 265, 266, 267, 268, 269, 270, BLOCK 4, AND LOTS 271, 272, 273, 274, 275, 276, 277, 278, 279, 280, BLOCK 4, AND LOTS 281, 282, 283, 284, 285, 286, 287, 288, 289, 290, BLOCK 4, AND LOTS 291, 292, 293, 294, 295, 296, 297, 298, 299, 300, BLOCK 4, AND LOTS 301, 302, 303, 304, 305, 306, 307, 308, 309, 310, BLOCK 4, AND LOTS 311, 312, 313, 314, 315, 316, 317, 318, 319, 320, BLOCK 4, AND LOTS 321, 322, 323, 324, 325, 326, 327, 328, 329, 330, BLOCK 4, AND LOTS 331, 332, 333, 334, 335, 336, 337, 338, 339, 340, BLOCK 4, AND LOTS 341, 342, 343, 344, 345, 346, 347, 348, 349, 350, BLOCK 4, AND LOTS 351, 352, 353, 354, 355, 356, 357, 358, 359, 360, BLOCK 4, AND LOTS 361, 362, 363, 364, 365, 366, 367, 368, 369, 370, BLOCK 4, AND LOTS 371, 372, 373, 374, 375, 376, 377, 378, 379, 380, BLOCK 4, AND LOTS 381, 382, 383, 384, 385, 386, 387, 388, 389, 390, BLOCK 4, AND LOTS 391, 392, 393, 394, 395, 396, 397, 398, 399, 400, BLOCK 4, AND LOTS 401, 402, 403, 404, 405, 406, 407, 408, 409, 410, BLOCK 4, AND LOTS 411, 412, 413, 414, 415, 416, 417, 418, 419, 420, BLOCK 4, AND LOTS 421, 422, 423, 424, 425, 426, 427, 428, 429, 430, BLOCK 4, AND LOTS 431, 432, 433, 434, 435, 436, 437, 438, 439, 440, BLOCK 4, AND LOTS 441, 442, 443, 444, 445, 446, 447, 448, 449, 450, BLOCK 4, AND LOTS 451, 452, 453, 454, 455, 456, 457, 458, 459, 460, BLOCK 4, AND LOTS 461, 462, 463, 464, 465, 466, 467, 468, 469, 470, BLOCK 4, AND LOTS 471, 472, 473, 474, 475, 476, 477, 478, 479, 480, BLOCK 4, AND LOTS 481, 482, 483, 484, 485, 486, 487, 488, 489, 490, BLOCK 4, AND LOTS 491, 492, 493, 494, 495, 496, 497, 498, 499, 500, BLOCK 4, AND LOTS 501, 502, 503, 504, 505, 506, 507, 508, 509, 510, BLOCK 4, AND LOTS 511, 512, 513, 514, 515, 516, 517, 518, 519, 520, BLOCK 4, AND LOTS 521, 522, 523, 524, 525, 526, 527, 528, 529, 530, BLOCK 4, AND LOTS 531, 532, 533, 534, 535, 536, 537, 538, 539, 540, BLOCK 4, AND LOTS 541, 542, 543, 544, 545, 546, 547, 548, 549, 550, BLOCK 4, AND LOTS 551, 552, 553, 554, 555, 556, 557, 558, 559, 560, BLOCK 4, AND LOTS 561, 562, 563, 564, 565, 566, 567, 568, 569, 570, BLOCK 4, AND LOTS 571, 572, 573, 574, 575, 576, 577, 578, 579, 580, BLOCK 4, AND LOTS 581, 582, 583, 584, 585, 586, 587, 588, 589, 590, BLOCK 4, AND LOTS 591, 592, 593, 594, 595, 596, 597, 598, 599, 600, BLOCK 4, AND LOTS 601, 602, 603, 604, 605, 606, 607, 608, 609, 610, BLOCK 4, AND LOTS 611, 612, 613, 614, 615, 616, 617, 618, 619, 620, BLOCK 4, AND LOTS 621, 622, 623, 624, 625, 626, 627, 628, 629, 630, BLOCK 4, AND LOTS 631, 632, 633, 634, 635, 636, 637, 638, 639, 640, BLOCK 4, AND LOTS 641, 642, 643, 644, 645, 646, 647, 648, 649, 650, BLOCK 4, AND LOTS 651, 652, 653, 654, 655, 656, 657, 658, 659, 660, BLOCK 4, AND LOTS 661, 662, 663, 664, 665, 666, 667, 668, 669, 670, BLOCK 4, AND LOTS 671, 672, 673, 674, 675, 676, 677, 678, 679, 680, BLOCK 4, AND LOTS 681, 682, 683, 684, 685, 686, 687, 688, 689, 690, BLOCK 4, AND LOTS 691, 692, 693, 694, 695, 696, 697, 698, 699, 700, BLOCK 4, AND LOTS 701, 702, 703, 704, 705, 706, 707, 708, 709, 710, BLOCK 4, AND LOTS 711, 712, 713, 714, 715, 716, 717, 718, 719, 720, BLOCK 4, AND LOTS 721, 722, 723, 724, 725, 726, 727, 728, 729, 730, BLOCK 4, AND LOTS 731, 732, 733, 734, 735, 736, 737, 738, 739, 740, BLOCK 4, AND LOTS 741, 742, 743, 744, 745, 746, 747, 748, 749, 750, BLOCK 4, AND LOTS 751, 752, 753, 754, 755, 756, 757, 758, 759, 760, BLOCK 4, AND LOTS 761, 762, 763, 764, 765, 766, 767, 768, 769, 770, BLOCK 4, AND LOTS 771, 772, 773, 774, 775, 776, 777, 778, 779, 780, BLOCK 4, AND LOTS 781, 782, 783, 784, 785, 786, 787, 788, 789, 790, BLOCK 4, AND LOTS 791, 792, 793, 794, 795, 796, 797, 798, 799, 800, BLOCK 4, AND LOTS 801, 802, 803, 804, 805, 806, 807, 808, 809, 810, BLOCK 4, AND LOTS 811, 812, 813, 814, 815, 816, 817, 818, 819, 820, BLOCK 4, AND LOTS 821, 822, 823, 824, 825, 826, 827, 828, 829, 830, BLOCK 4, AND LOTS 831, 832, 833, 834, 835, 836, 837, 838, 839, 840, BLOCK 4, AND LOTS 841, 842, 843, 844, 845, 846, 847, 848, 849, 850, BLOCK 4, AND LOTS 851, 852, 853, 854, 855, 856, 857, 858, 859, 860, BLOCK 4, AND LOTS 861, 862, 863, 864, 865, 866, 867, 868, 869, 870, BLOCK 4, AND LOTS 871, 872, 873, 874, 875, 876, 877, 878, 879, 880, BLOCK 4, AND LOTS 881, 882, 883, 884, 885, 886, 887, 888, 889, 890, BLOCK 4, AND LOTS 891, 892, 893, 894, 895, 896, 897, 898, 899, 900, BLOCK 4, AND LOTS 901, 902, 903, 904, 905, 906, 907, 908, 909, 910, BLOCK 4, AND LOTS 911, 912, 913, 914, 915, 916, 917, 918, 919, 920, BLOCK 4, AND LOTS 921, 922, 923, 924, 925, 926, 927, 928, 929, 930, BLOCK 4, AND LOTS 931, 932, 933, 934, 935, 936, 937, 938, 939, 940, BLOCK 4, AND LOTS 941, 942, 943, 944, 945, 946, 947, 948, 949, 950, BLOCK 4, AND LOTS 951, 952, 953, 954, 955, 956, 957, 958, 959, 960, BLOCK 4, AND LOTS 961, 962, 963, 964, 965, 966, 967, 968, 969, 970, BLOCK 4, AND LOTS 971, 972, 973, 974, 975, 976, 977, 978, 979, 980, BLOCK 4, AND LOTS 981, 982, 983, 984, 985, 986, 987, 988, 989, 990, BLOCK 4, AND LOTS 991, 992, 993, 994, 995, 996, 997, 998, 999, 1000, BLOCK 4, AND LOTS 1001, 1002, 1003, 1004, 1005, 1006, 1007, 1008, 1009, 1010, BLOCK 4, AND LOTS 1011, 1012, 1013, 1014, 1015, 1016, 1017, 1018, 1019, 1020, BLOCK 4, AND LOTS 1021, 1022, 1023, 1024, 1025, 1026, 1027, 1028, 1029, 1030, BLOCK 4, AND LOTS 1031, 1032, 1033, 1034, 1035, 1036, 1037, 1038, 1039, 1040, BLOCK 4, AND LOTS 1041, 1042, 1043, 1044, 1045, 1046, 1047, 1048, 1049, 1050, BLOCK 4, AND LOTS 1051, 1052, 1053, 1054, 1055, 1056, 1057, 1058, 1059, 1060, BLOCK 4, AND LOTS 1061, 1062, 1063, 1064, 1065, 1066, 1067, 1068, 1069, 1070, BLOCK 4, AND LOTS 1071, 1072, 1073, 1074, 1075, 1076, 1077, 1078, 1079, 1080, BLOCK 4, AND LOTS 1081, 1082, 1083, 1084, 1085, 1086, 1087, 1088, 1089, 1090, BLOCK 4, AND LOTS 1091, 1092, 1093, 1094, 1095, 1096, 1097, 1098, 1099, 1100, BLOCK 4, AND LOTS 1101, 1102, 1103, 1104, 1105, 1106, 1107, 1108, 1109, 1110, BLOCK 4, AND LOTS 1111, 1112, 1113, 1114, 1115, 1116, 1117, 1118, 1119, 1120, BLOCK 4, AND LOTS 1121, 1122, 1123, 1124, 1125, 1126, 1127, 1128, 1129, 1130, BLOCK 4, AND LOTS 1131, 1132, 1133, 1134, 1135, 1136, 1137, 1138, 1139, 1140, BLOCK 4, AND LOTS 1141, 1142, 1143, 1144, 1145, 1146, 1147, 1148, 1149, 1150, BLOCK 4, AND LOTS 1151, 1152, 1153, 1154, 1155, 1156, 1157, 1158, 1159, 1160, BLOCK 4, AND LOTS 1161, 1162, 1163, 1164, 1165, 1166, 1167, 1168, 1169, 1170, BLOCK 4, AND LOTS 1171, 1172, 1173, 1174, 1175, 1176, 1177, 1178, 1179, 1180, BLOCK 4, AND LOTS 1181, 1182, 1183, 1184, 1185, 1186, 1187, 1188, 1189, 1190, BLOCK 4, AND LOTS 1191, 1192, 1193, 1194, 1195, 1196, 1197, 1198, 1199, 1200, BLOCK 4, AND LOTS 1201, 1202, 1203, 1204, 1205, 1206, 1207, 1208, 1209, 1210, BLOCK 4, AND LOTS 1211, 1212, 1213, 1214, 1215, 1216, 1217, 1218, 1219, 1220, BLOCK 4, AND LOTS 1221, 1222, 1223, 1224, 1225, 1226, 1227, 1228, 1229, 1230, BLOCK 4, AND LOTS 1231, 1232, 1233, 1234, 1235, 1236, 1237, 1238, 1239, 1240, BLOCK 4, AND LOTS 1241, 1242, 1243, 1244, 1245, 1246, 1247, 1248, 1249, 1250, BLOCK 4, AND LOTS 1251, 1252, 1253, 1254, 1255, 1256, 1257, 1258, 1259, 1260, BLOCK 4, AND LOTS 1261, 1262, 1263, 1264, 1265, 1266, 1267, 1268, 1269, 1270, BLOCK 4, AND LOTS 1271, 1272, 1273, 1274, 1275, 1276, 1277, 1278, 1279, 1280, BLOCK 4, AND LOTS 1281, 1282, 1283, 1284, 1285, 1286, 1287, 1288, 1289, 1290, BLOCK 4, AND LOTS 1291, 1292, 1293, 1294, 1295, 1296, 1297, 1298, 1299, 1300, BLOCK 4, AND LOTS 1301, 1302, 1303, 1304, 1305, 1306, 1307, 1308, 1309, 1310, BLOCK 4, AND LOTS 1311, 1312, 1313, 1314, 1315, 1316, 1317, 1318, 1319, 1320, BLOCK 4, AND LOTS 1321, 1322, 1323, 1324, 1325, 1326, 1327, 1328, 1329, 1330, BLOCK 4, AND LOTS 1331, 1332, 1333, 1334, 1335, 1336, 1337, 1338, 1339, 1340, BLOCK 4, AND LOTS 1341, 1342, 1343, 1344, 1345, 1346, 1347, 1348, 1349, 1350, BLOCK 4, AND LOTS 1351, 1352, 1353, 1354, 1355, 1356, 1357, 1358, 1359, 1360, BLOCK 4, AND LOTS 1361, 1362, 1363, 1364, 1365, 1366, 1367, 1368, 1369, 1370, BLOCK 4, AND LOTS 1371, 1372, 1373, 1374, 1375, 1376, 1377, 1378, 1379, 1380, BLOCK 4, AND LOTS 1381, 1382, 1383, 1384, 1385, 1386, 1387, 1388, 1389, 1390, BLOCK 4, AND LOTS 1391, 1392, 1393, 1394, 1395, 1396, 1397, 1398, 1399, 1400, BLOCK 4, AND LOTS 1401, 1402, 1403, 1404, 1405, 1406, 1407, 1408, 1409, 1410, BLOCK 4, AND LOTS 1411, 1412, 1413, 1414, 1415, 1416, 1417, 1418, 1419, 1420, BLOCK 4, AND LOTS 1421, 1422, 1423, 1424, 1425, 1426, 1427, 1428, 1429, 1430, BLOCK 4, AND LOTS 1431, 1432, 1433, 1434, 1435, 1436, 1437, 1438, 1439, 1440, BLOCK 4, AND LOTS 1441, 1442, 1443, 1444, 1445, 1446, 1447, 1448, 1449, 1450, BLOCK 4, AND LOTS 1451, 1452, 1453, 1454, 1455, 1456, 1457, 1458, 1459, 1460, BLOCK 4, AND LOTS 1461, 1462, 1463, 1464, 1465, 1466, 1467, 1468, 1469, 1470, BLOCK 4, AND LOTS 1471, 1472, 1473, 1474, 1475, 1476, 1477, 1478, 1479, 1480, BLOCK 4, AND LOTS 1481, 1482, 1483, 1484, 1485, 1486, 1487, 1488, 1489, 1490, BLOCK 4, AND LOTS 1491, 1492, 1493, 1494, 1495, 1496, 1497, 1498, 1499, 1500, BLOCK 4, AND LOTS 1501, 1502, 1503, 1504, 1505, 1506, 1507, 1508, 1509, 1510, BLOCK 4, AND LOTS 1511, 1512, 1513, 1514, 1515, 1516, 1517, 1518, 1519, 1520, BLOCK 4, AND LOTS 1521, 1522, 1523, 1524, 1525, 1526, 1527, 1528, 1529, 1530, BLOCK 4, AND LOTS 1531, 1532, 1533, 1534, 1535, 1536, 1537, 1538, 1539, 1540, BLOCK 4, AND LOTS 1541, 1542, 1543, 1544, 1545, 1546, 1547, 1548, 1549, 1550, BLOCK 4, AND LOTS 1551, 1552, 1553, 1554, 1555, 1556, 1557, 1558, 1559, 1560, BLOCK 4, AND LOTS 1561, 1562, 1563, 1564, 1565, 1566, 1567, 1568, 1569, 1570, BLOCK 4, AND LOTS 1571, 1572, 1573, 1574, 1575, 1576, 1577, 1578, 1579, 1580, BLOCK 4, AND LOTS 1581, 1582, 1583, 1584, 1585, 1586, 1587, 1588, 1589, 1590, BLOCK 4, AND LOTS 1591, 1592, 1593, 1594, 1595, 1596, 1597, 1598, 1599, 1600, BLOCK 4, AND LOTS 1601, 1602, 1603, 1604, 1605, 1606, 1607, 1608, 1609, 1610, BLOCK 4, AND LOTS 1611, 1612, 1613, 1614, 1615, 1616, 1617, 1618, 1619, 1620, BLOCK 4, AND LOTS 1621, 1622, 1623, 1624, 1625, 1626, 1627, 1628, 1629, 1630, BLOCK 4, AND LOTS 1631, 1632, 1633, 1634, 1635, 1636, 1637, 1638, 1639, 1640, BLOCK 4, AND LOTS 1641, 1642, 1643, 1644, 1645, 1646, 1647, 1648, 1649, 1650, BLOCK 4, AND LOTS 1651, 1652, 1653, 1654, 1655, 1656, 1657, 1658, 1659, 1660, BLOCK 4, AND LOTS 1661, 1662, 1663, 1664, 1665, 1666, 1667, 1668, 1669, 1670, BLOCK 4, AND LOTS 1671, 1672, 1673, 1674, 1675, 1676, 1677, 1678, 1679, 1680, BLOCK 4, AND LOTS 1681, 1682, 1683, 1684, 1685, 1686, 1687, 1688, 1689, 1690, BLOCK 4, AND LOTS 1691, 1692, 1693, 1694, 1695, 1696, 1697, 1698, 1699, 1700, BLOCK 4, AND LOTS 1701, 1702, 1703, 1704, 1705, 1706, 1707, 1708, 1709, 1710, BLOCK 4, AND LOTS 1711, 1712, 1713, 1714, 1715, 1716, 1717, 1718, 1719, 1720, BLOCK 4, AND LOTS 1721, 1722, 1723, 1724, 1725, 1726, 1727, 1728, 1729, 1730, BLOCK 4, AND LOTS 1731, 1732, 1733, 1734, 1735, 1736, 1737, 1738, 1739, 1740, BLOCK 4, AND LOTS 1741, 1742, 1743, 1744, 1745, 1746, 1747, 1748, 1749, 1750, BLOCK 4, AND LOTS 1751, 1752, 1753, 1754, 1755, 1756, 1757, 1758, 1759, 1760, BLOCK 4, AND LOTS 1761, 1762, 1763, 1764,