


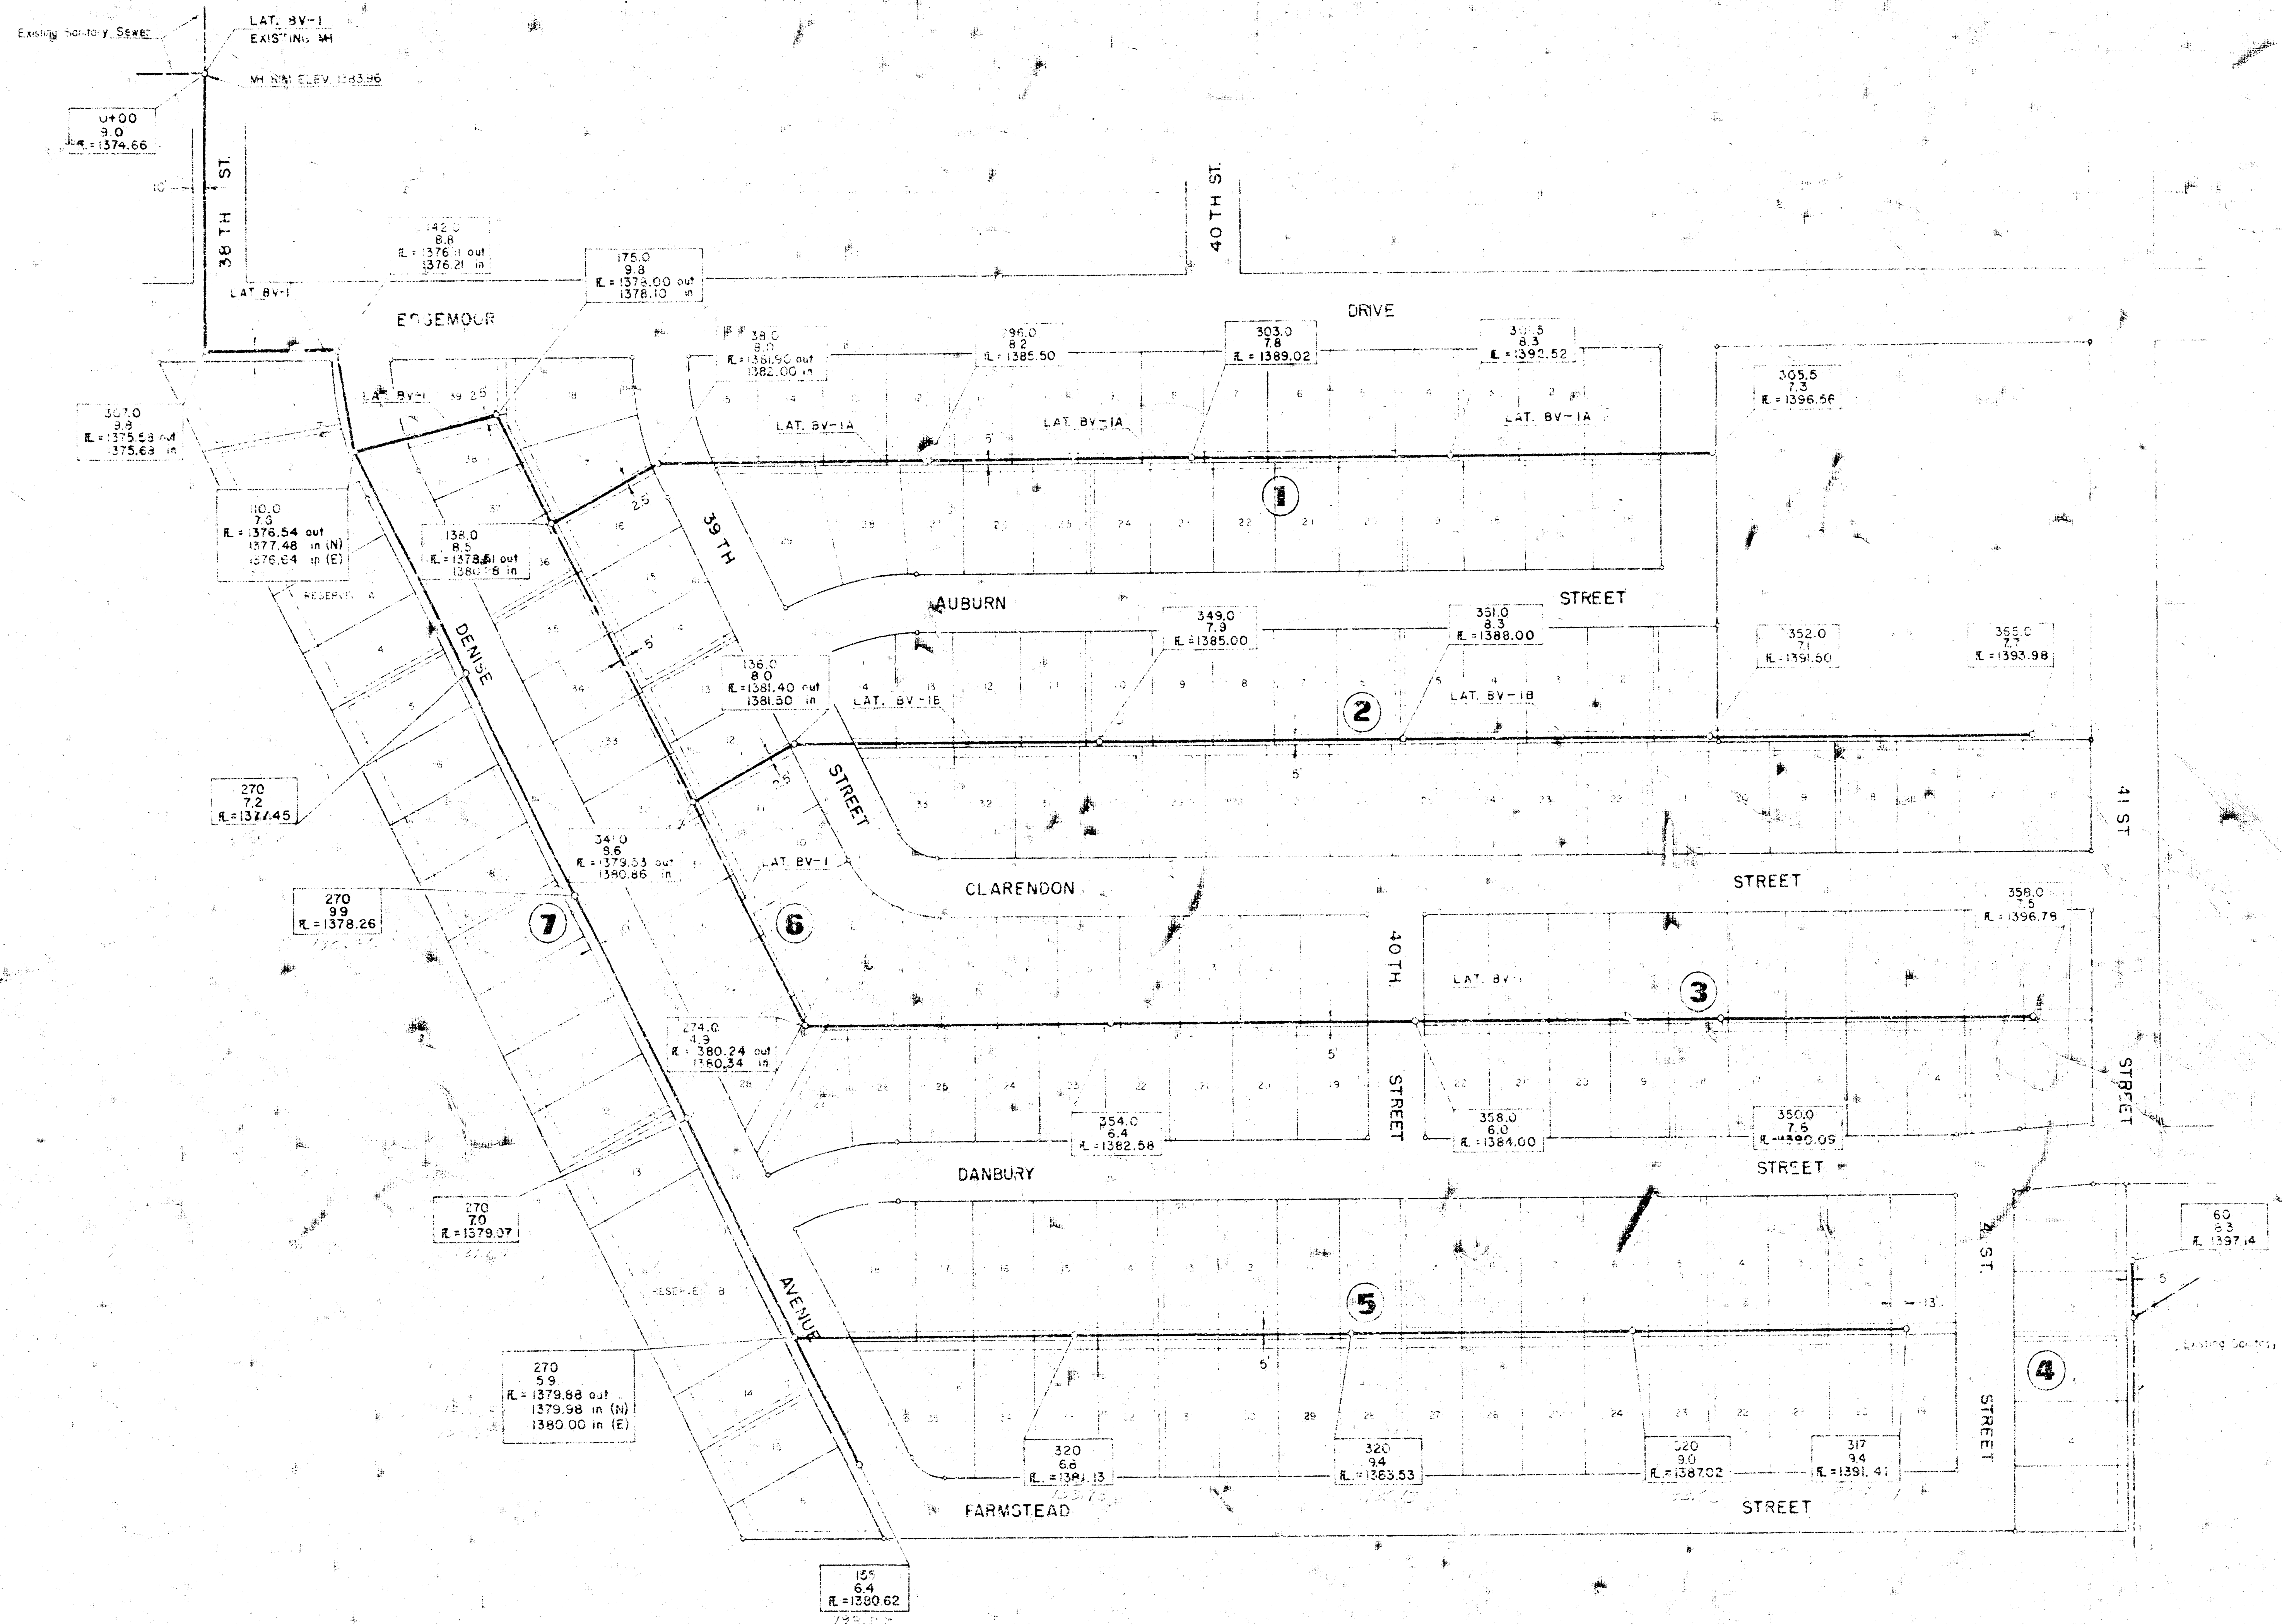

AS CONSTRUCTED
 SANITARY SEWER SYSTEM
Bel Aire Village
 C. of W. PROJECT NO. DBKW 707051
 SEDGWICK COUNTY, KANSAS
 1977

EDWARD & CO. ENGINEERS, INC.
 2160 WEST 21ST AVENUE
 WICHITA, KANSAS 67204
 (913) 263-0000