

PLANS
FOR
SANITARY SEWER EXTENSION
ARTHUR HEIGHTS ADDITION
BEL AIRE, KANSAS

1988

SE0688

CITY OF WICHITA PROJECT NO. 468-75-245-80001-000-000-181

APPROVED AS NOTED
By CITY ENGINEER OF WICHITA
Sanitary Sewers 9/22/88
Storm Sewers _____
Driveway Approaches _____
Water Mains _____
Paving _____

NOTE TO CONTRACTOR
INSPECTION AND TESTING FOR THIS PROJECT IS TO BE PROVIDED BY A LICENSED CONSULTING ENGINEERING FIRM UNDER CONTRACT WITH THE OWNER/DEVELOPER. SAID INSPECTION TO BE IN ACCORDANCE WITH THE CITY OF WICHITA STANDARD CONSTRUCTION ENGINEERING PRACTICES AND CERTIFIED BY A LICENSED PROFESSIONAL ENGINEER. NO WORK SHALL BE PERFORMED IN DEDICATED EASEMENTS OR THE PUBLIC RIGHT-OF-WAY BY THE CONTRACTOR WITHOUT SUCH INSPECTION NOR SHALL ANY WORK BE COMMENCED IN DEDICATED EASEMENTS OR PUBLIC RIGHT-OF-WAY WITHOUT WRITTEN AUTHORIZATION BY THE CITY ENGINEER.

NOTE TO CONTRACTOR
INSPECTION AND TESTING FOR THIS PROJECT IS TO BE PROVIDED BY A LICENSED CONSULTING ENGINEERING FIRM UNDER CONTRACT WITH THE OWNER/DEVELOPER. SAID INSPECTION TO BE IN ACCORDANCE WITH THE CITY OF WICHITA STANDARD CONSTRUCTION ENGINEERING PRACTICES AND CERTIFIED BY A LICENSED PROFESSIONAL ENGINEER. NO WORK SHALL BE PERFORMED IN DEDICATED EASEMENTS OR THE PUBLIC RIGHT-OF-WAY BY THE CONTRACTOR WITHOUT SUCH INSPECTION NOR SHALL ANY WORK BE COMMENCED IN DEDICATED EASEMENTS OR PUBLIC RIGHT-OF-WAY WITHOUT WRITTEN AUTHORIZATION BY THE CITY ENGINEER.

AS BUILT




DEISS & GOODNESS ENGINEERS
2100 WEST 21ST STREET
WICHITA, KANSAS 67203
(913) 632-0250

REV. 9-23-88


REVISION	DRAWN BY	CHECKED BY	DESIGNED BY

PROJECT NO. SE0688
DATE 8-18-88 SHEET 1 OF 7

FILMED FROM THE BEST
AVAILABLE COPY


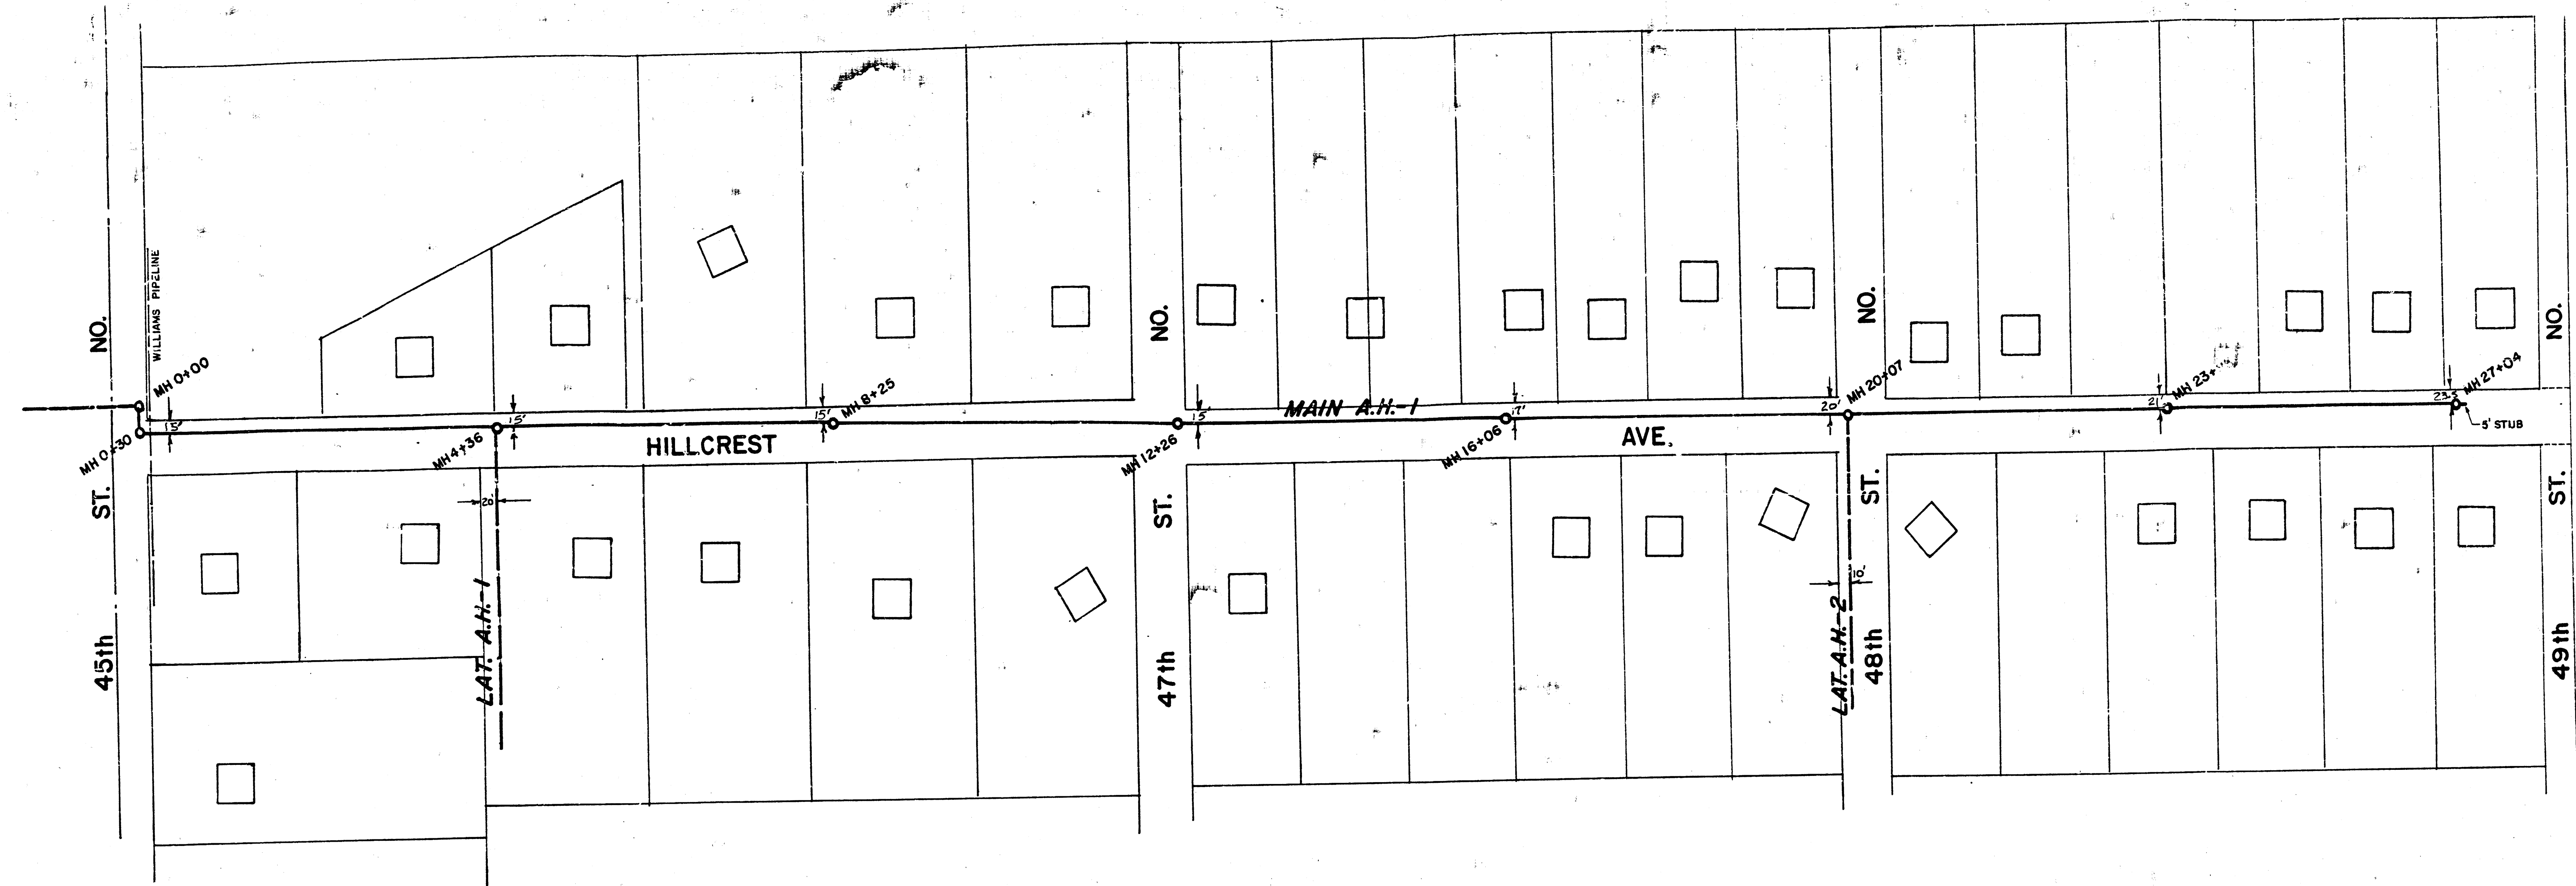


SCALE
PLAN: 1" = 100'
PROFILE: VERT. - 1" = 4'
HORZ. - 1" = 100'

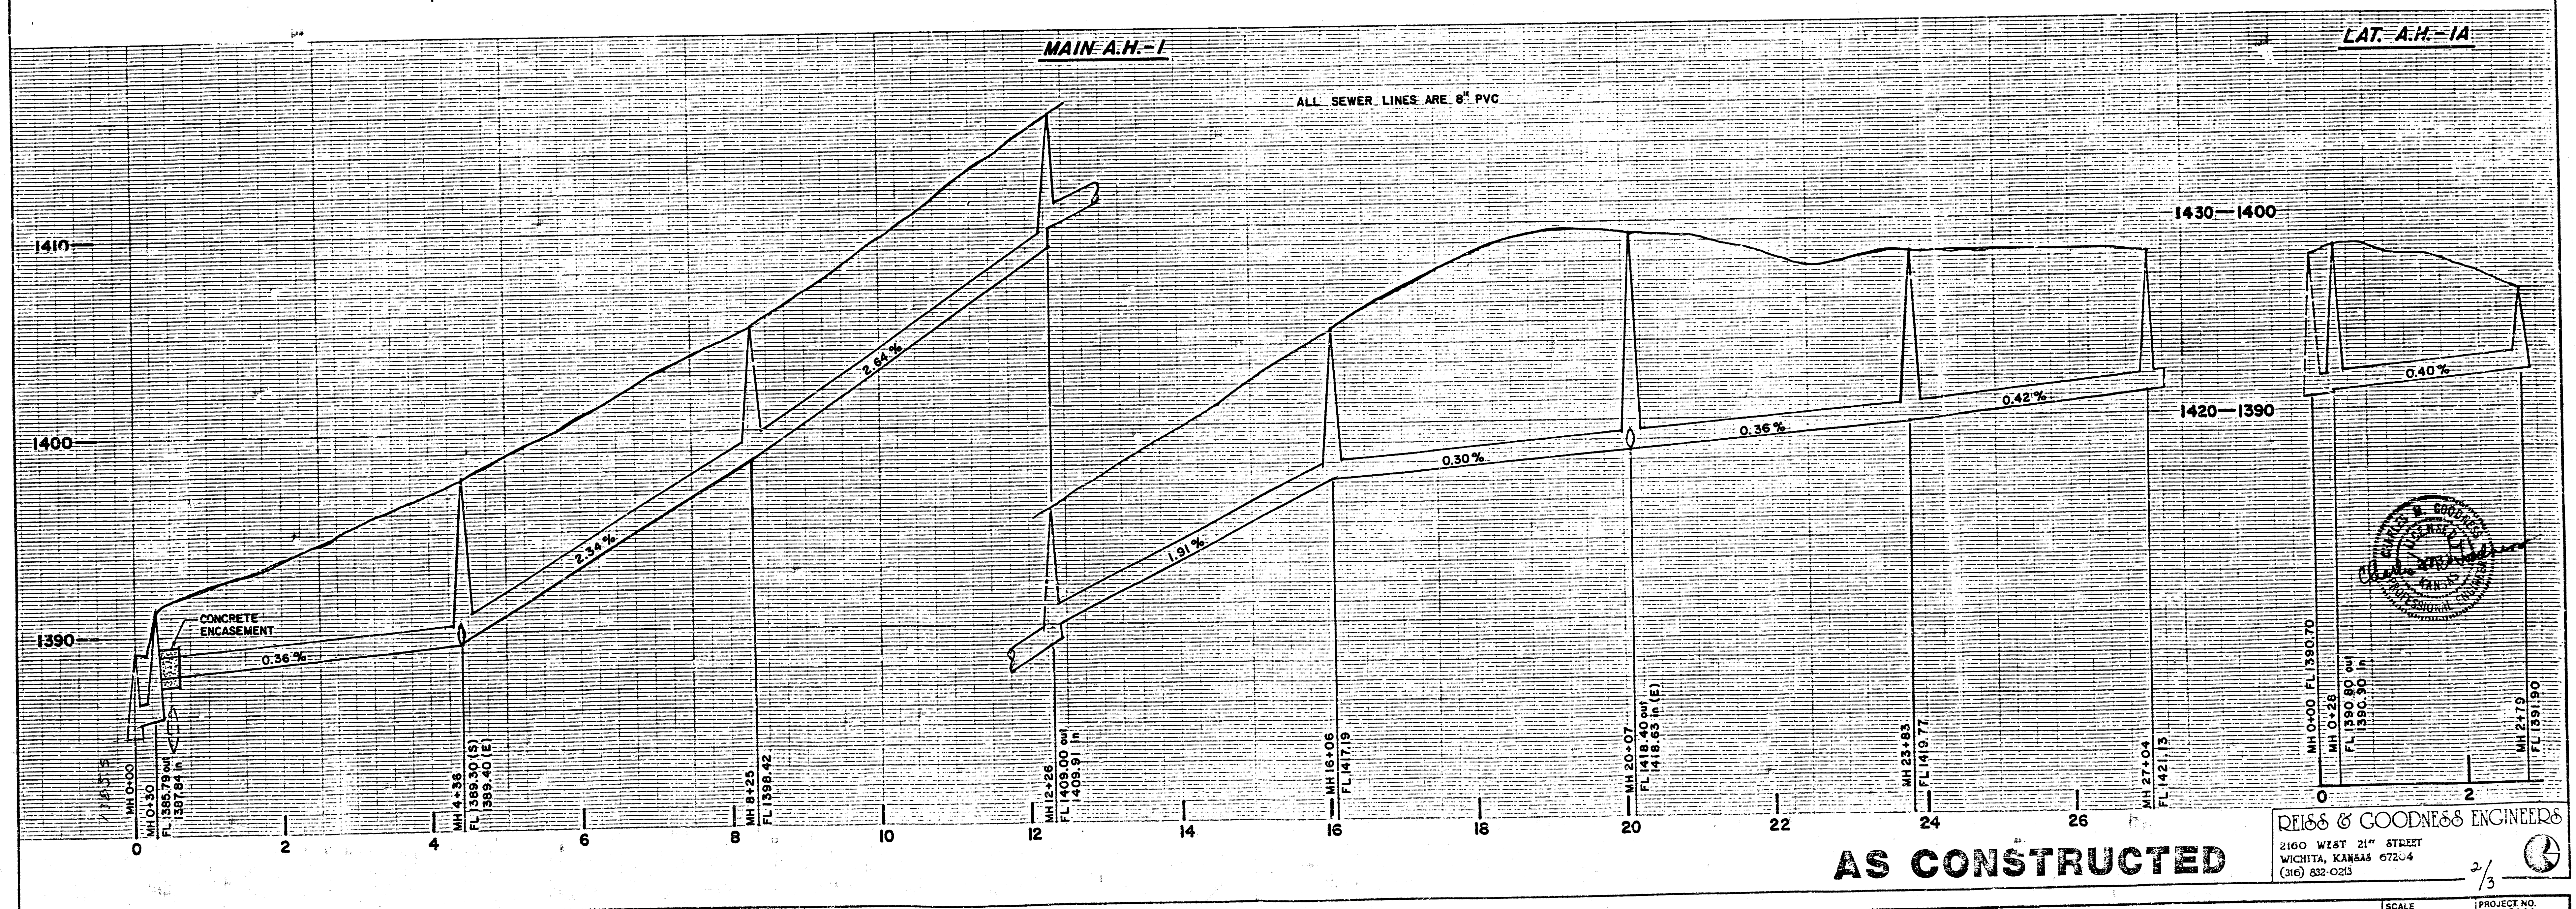

SANITARY SEWER EXTENSION					ARTHUR HEIGHTS ADD.-BEL AIRE, KANSAS	
REVISION	DRAWN BY	CHECKED BY	DESIGNED BY	PROJECT	CUSTOMER	DATE
	CG	CG	CG			1-3-89
	DEJ					

FILMED FROM THE BEST
AVAILABLE COPY.....

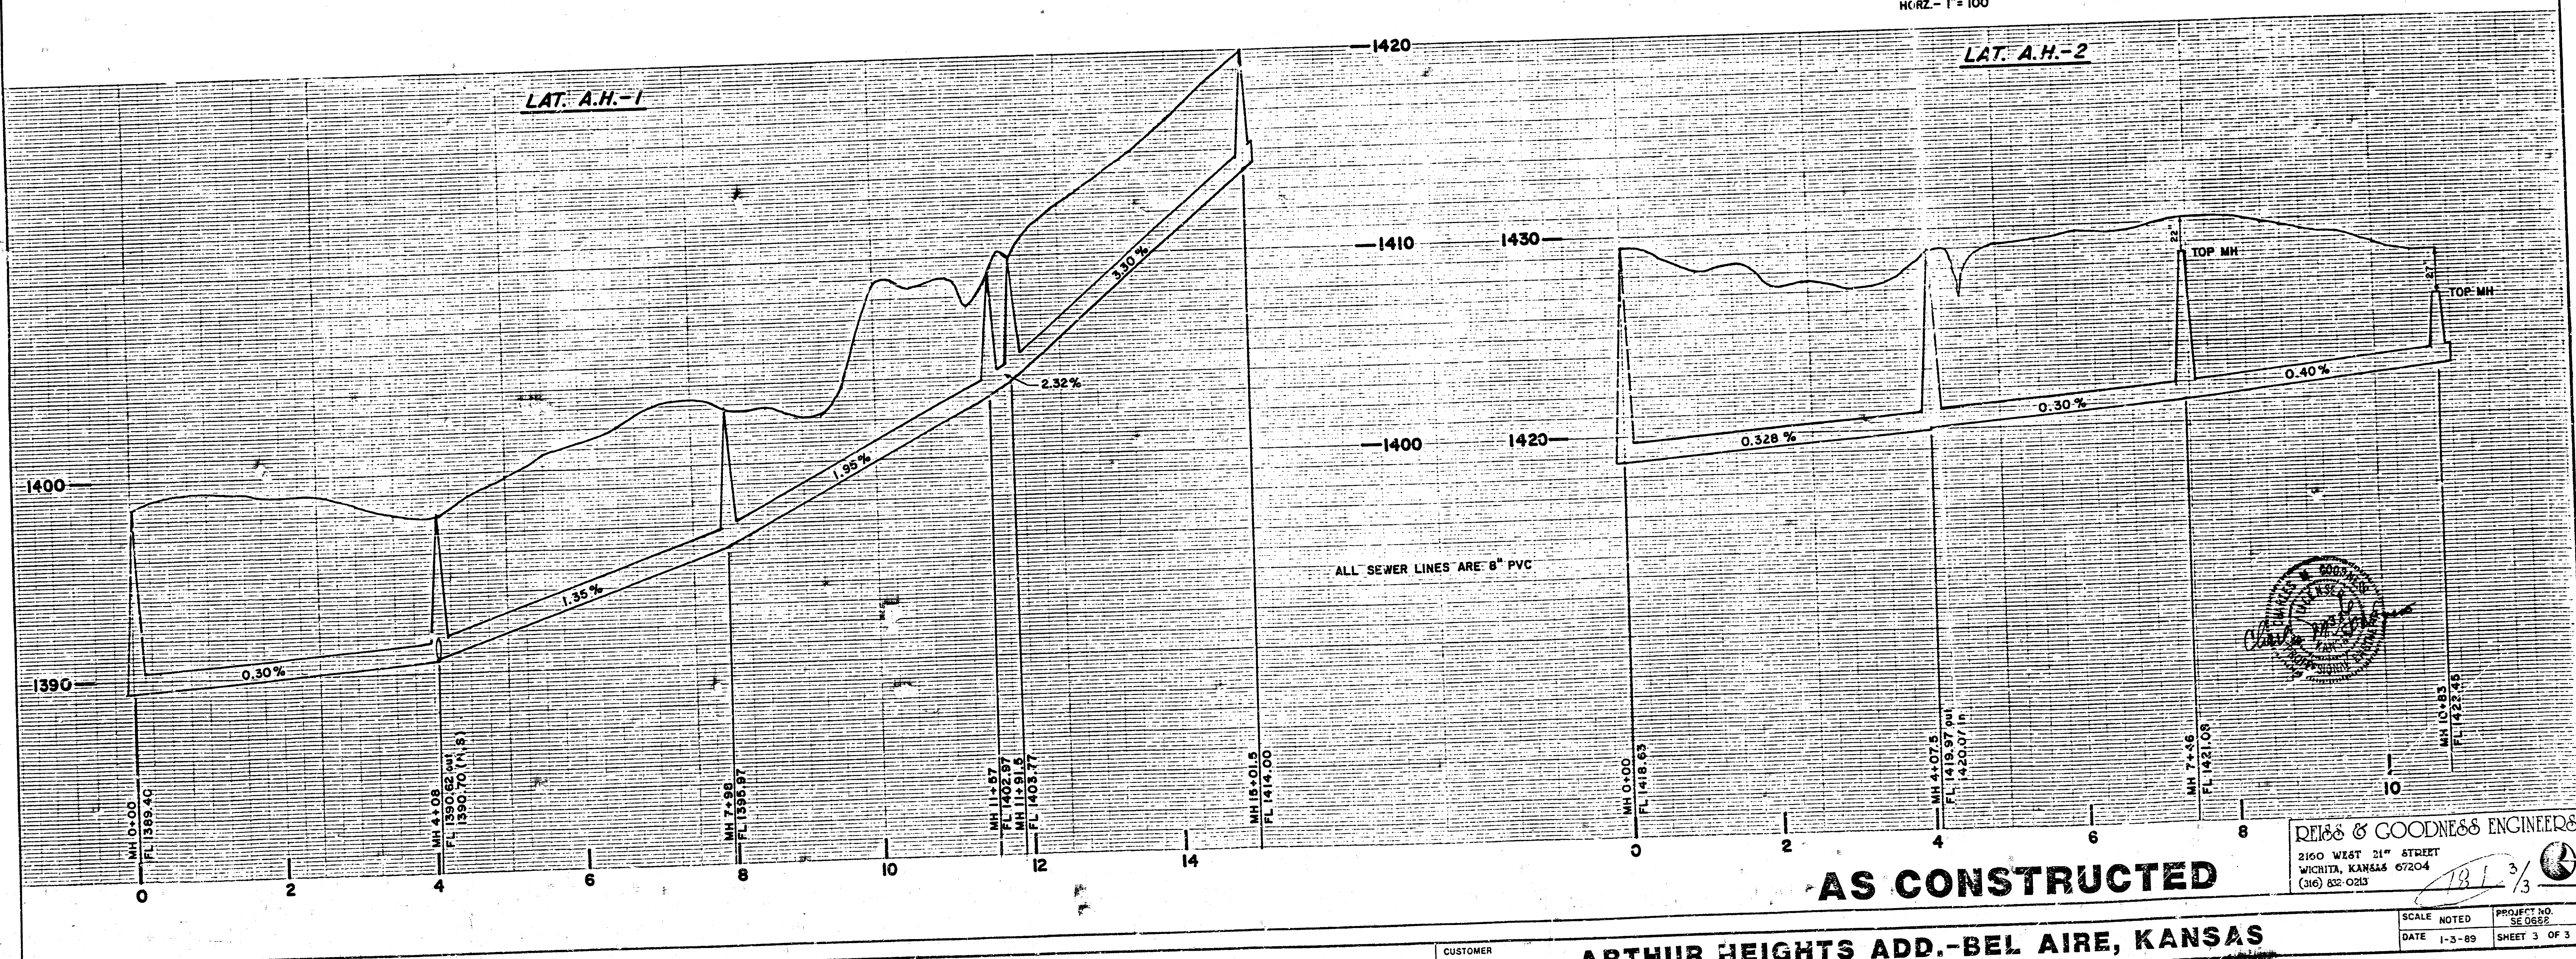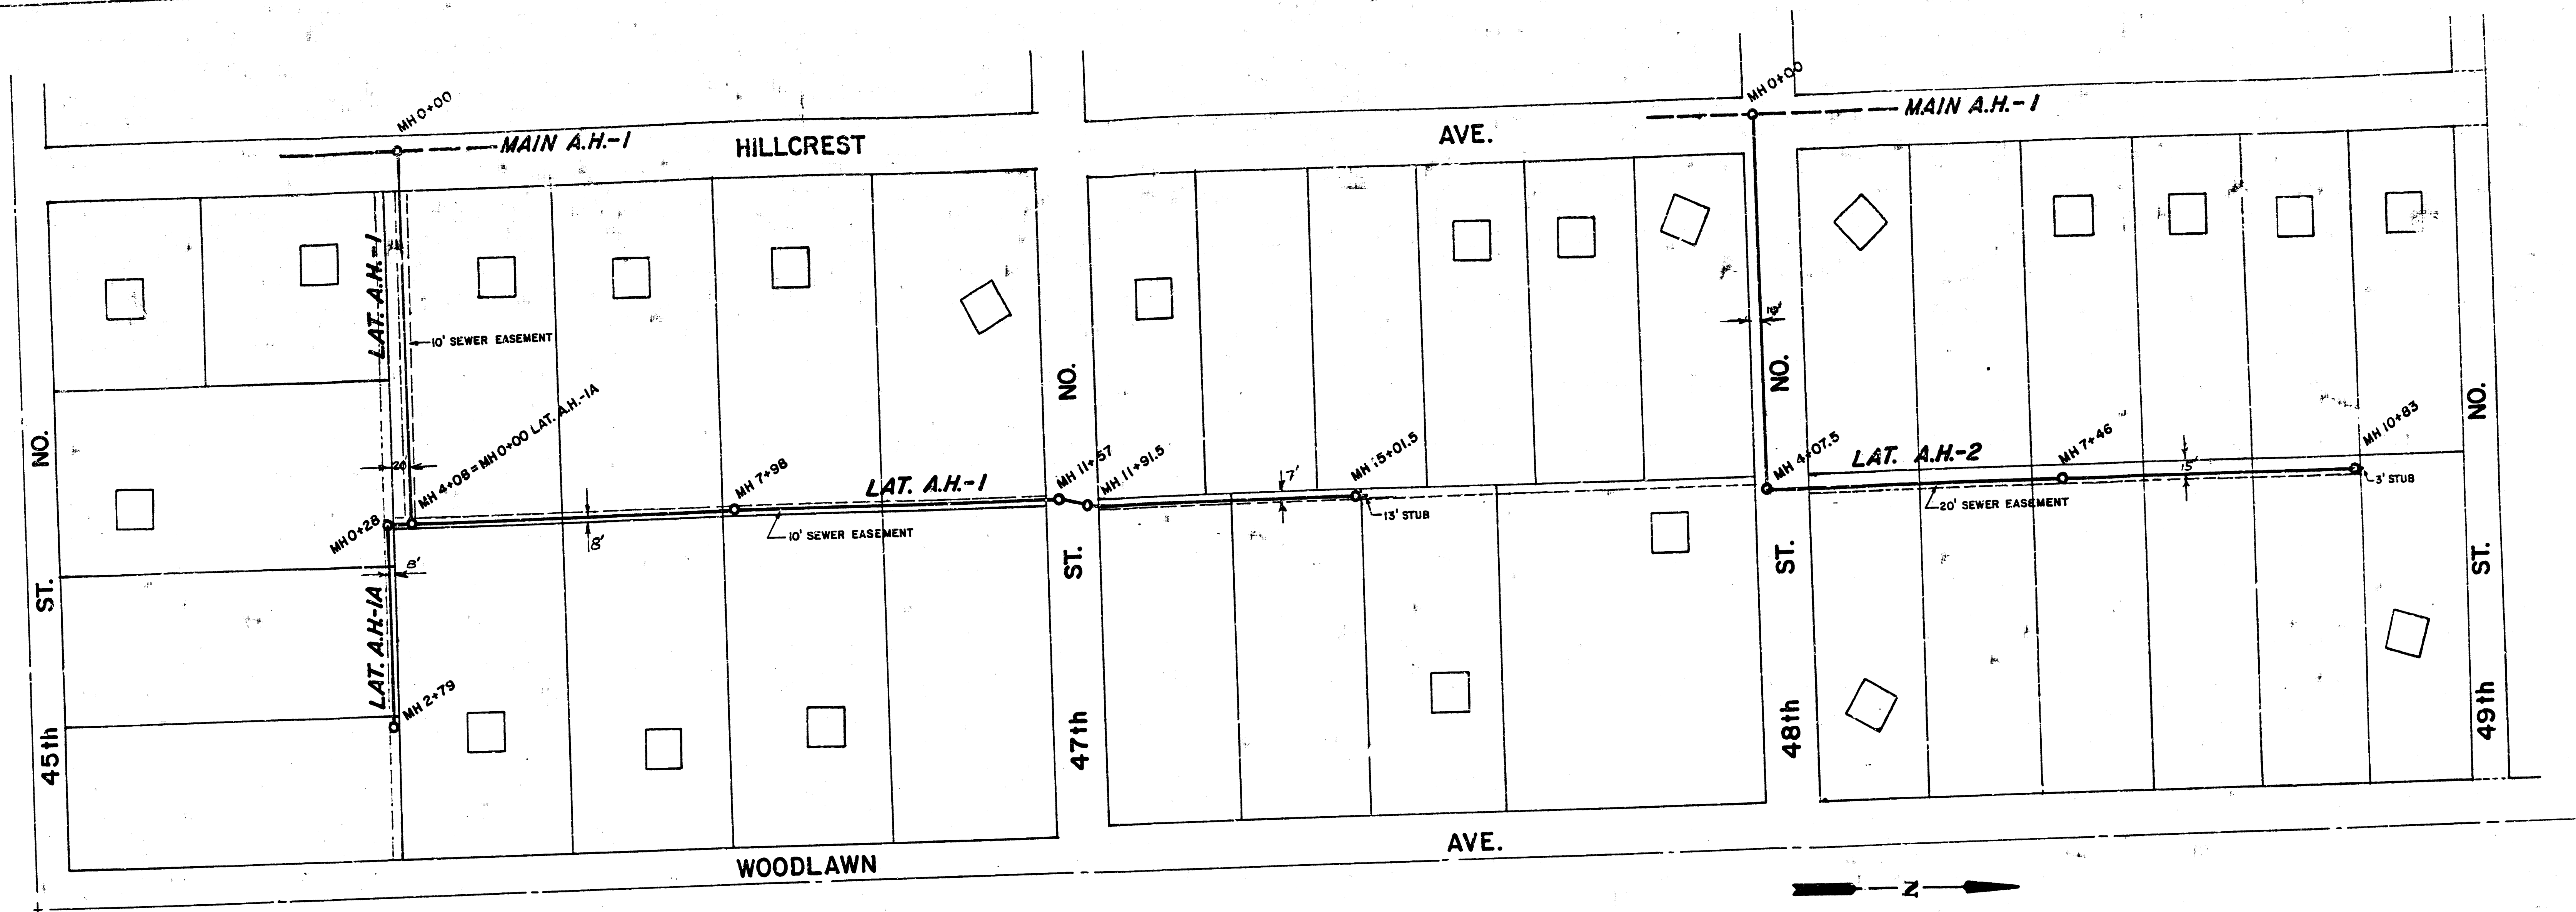

SANITARY SEWER EXTENSION					CUSTOMER		ARTHUR HEIGHTS ADD.-BEL AIRE, KANSAS		REISS & GOODNESS ENGINEERS	
REVISION	DRAWN BY	CHECKED BY	DESIGNED BY	PROJECT						
	CG	CG	CG							
	DEJ									

FILMED FROM THE BEST AVAILABLE COPY.....