

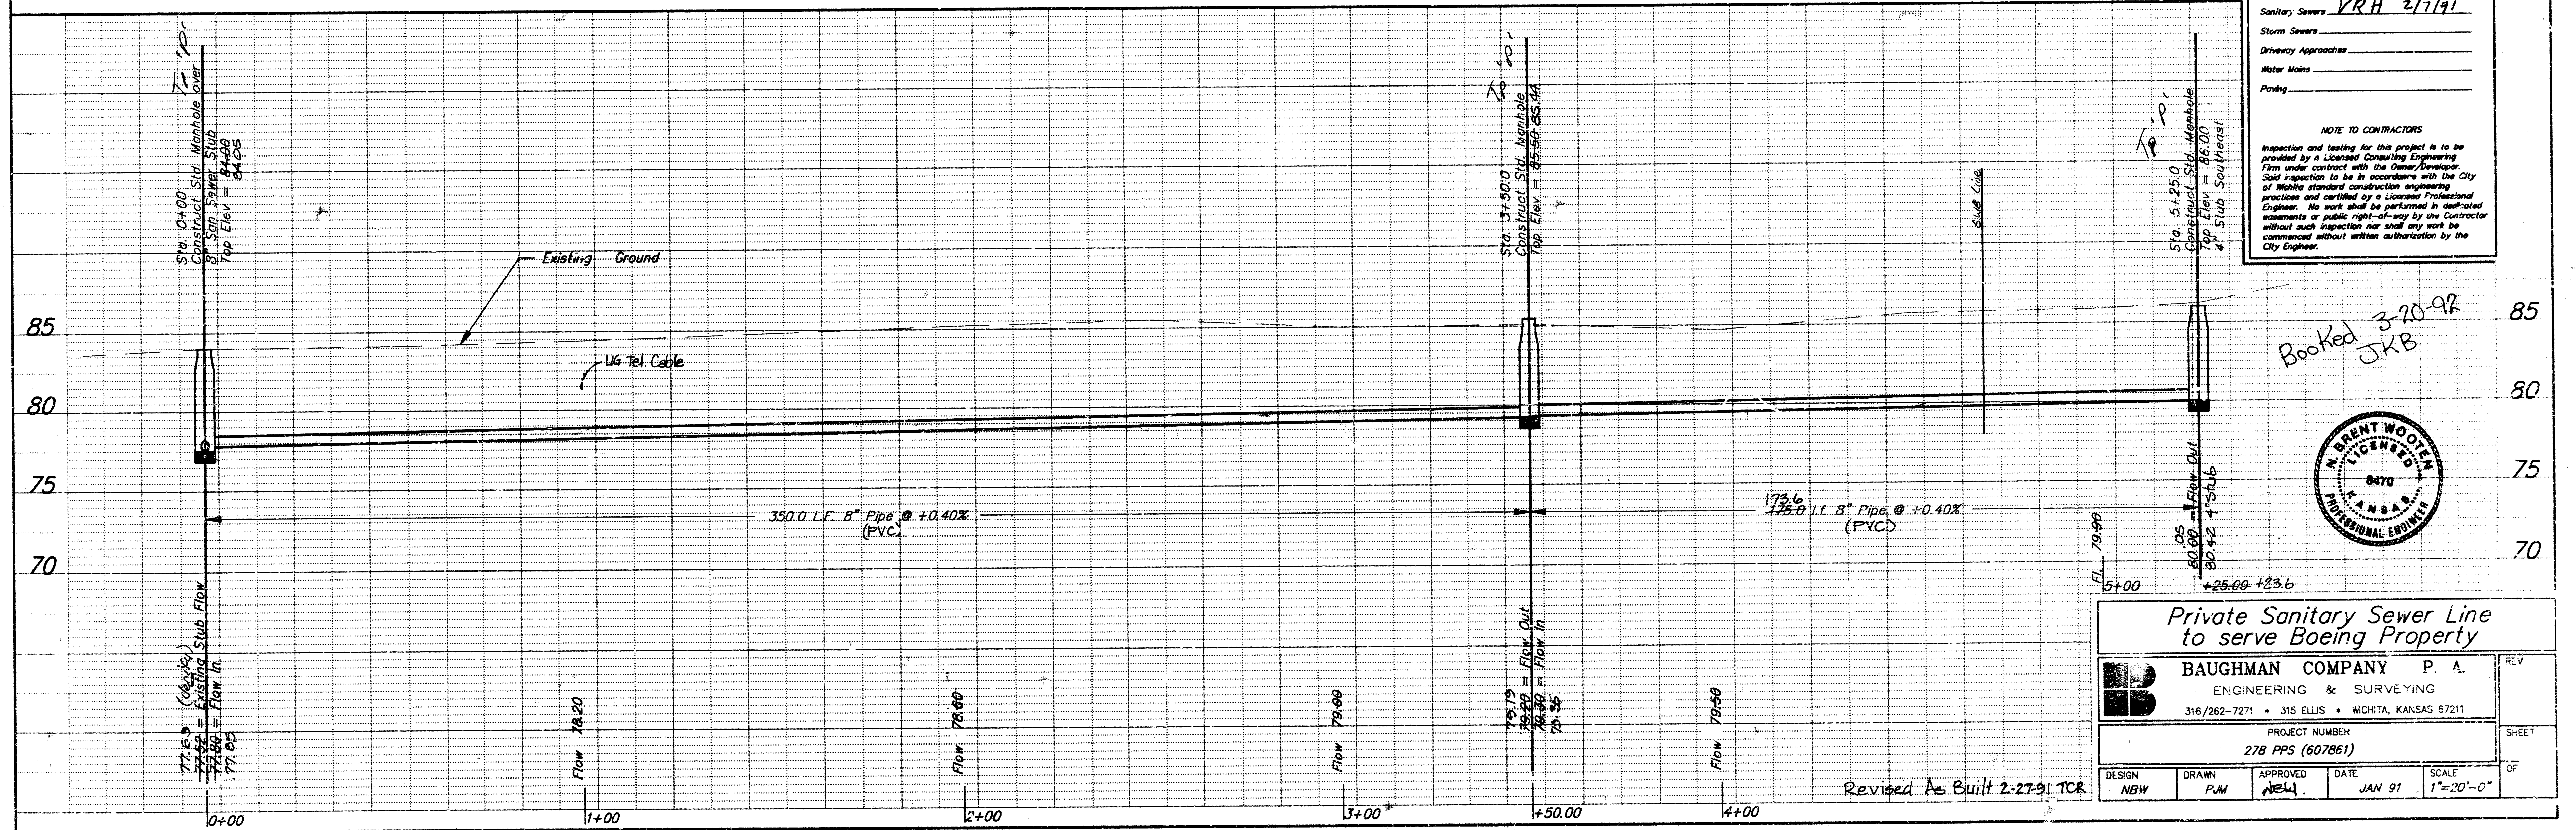


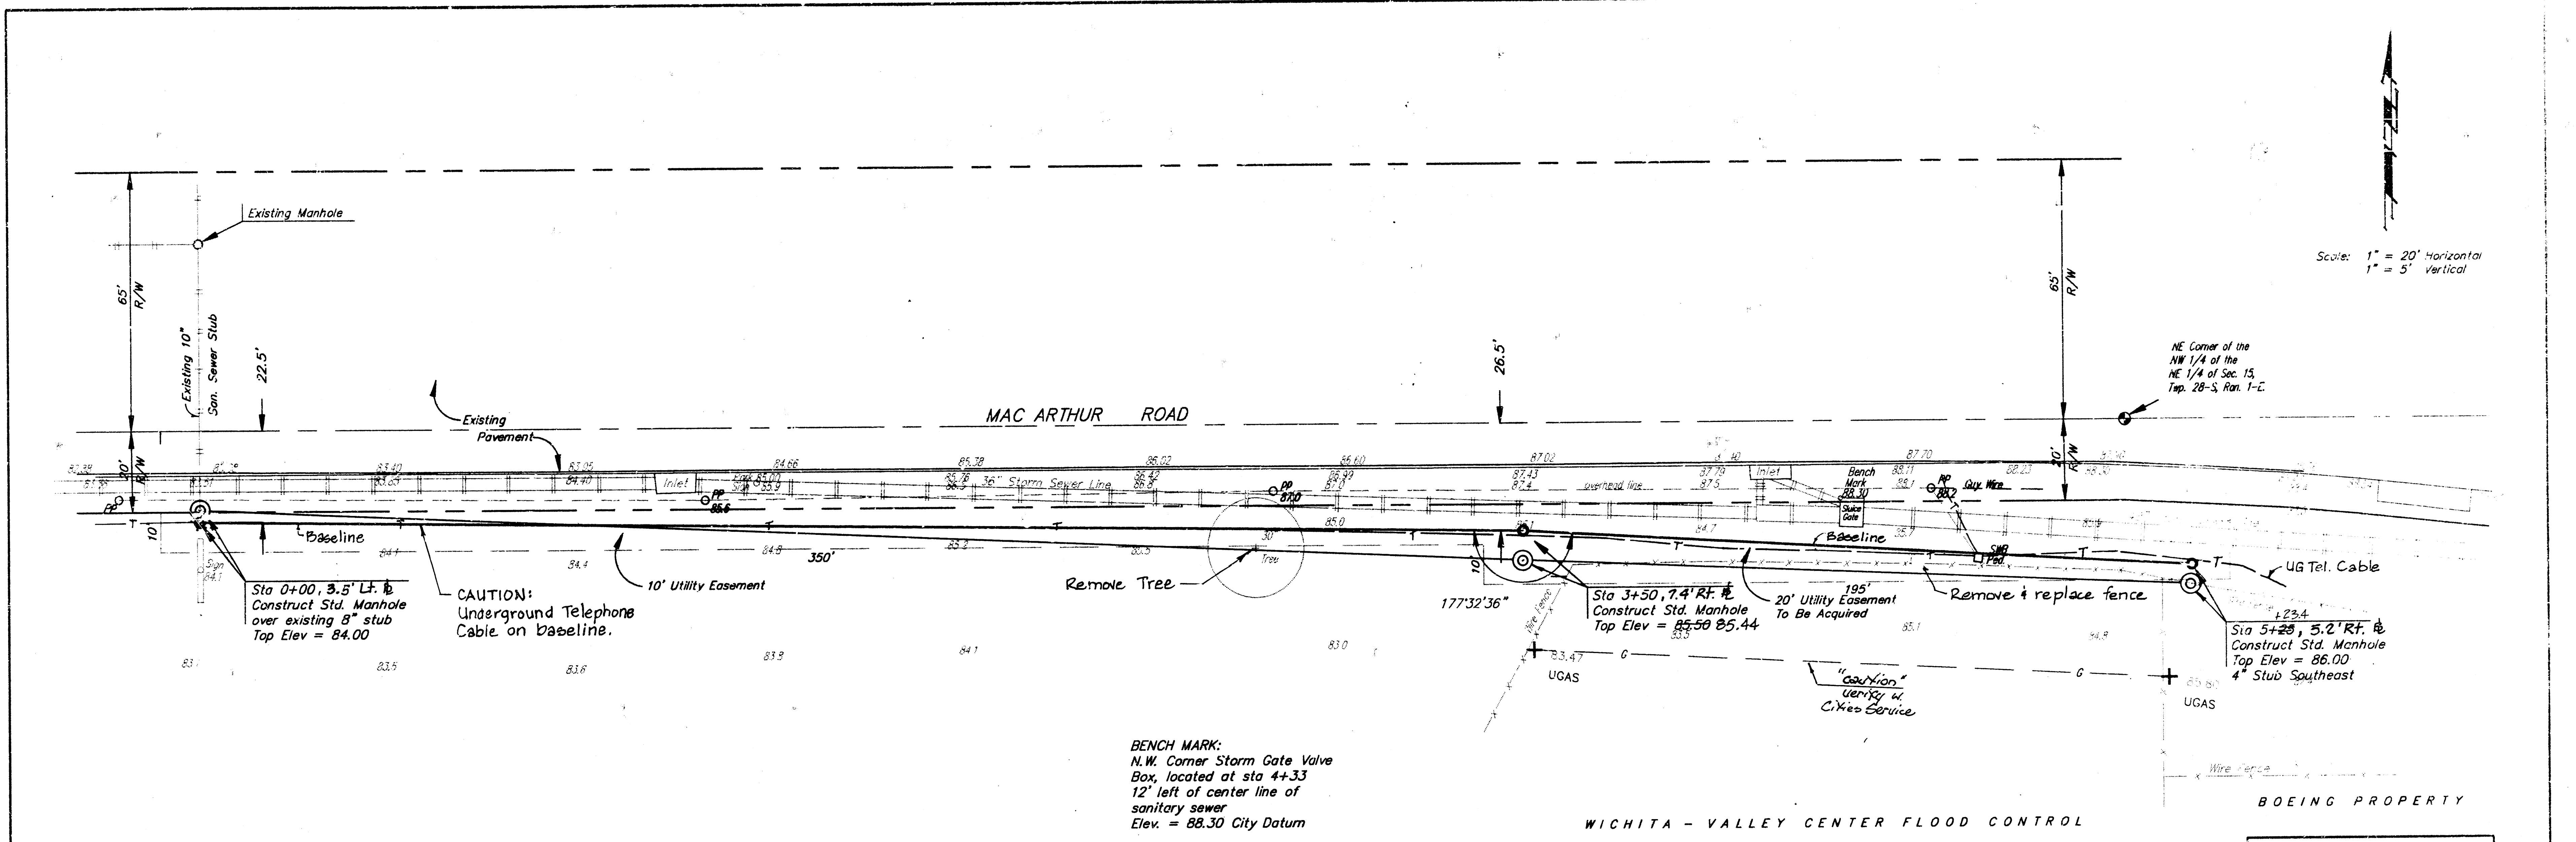

APPROVED AS NOTED
BY CITY ENGINEER OF WICHITA
Sanitary Sewers **VRH 2/17/91**
Storm Sewers _____
Driveway Approaches _____
Water Mains _____
Paving _____

NOTE TO CONTRACTORS
Inspection and testing for this project is to be provided by a Licensed Consulting Engineering Firm under contract with the Owner/Developer. Said inspection is to be in accordance with the City of Wichita standard construction engineering practices and verified by a Licensed Professional Engineer. No work shall be performed in dedicated easements or public right-of-way by the Contractor without such inspection nor shall any work be commenced without written authorization by the City Engineer.

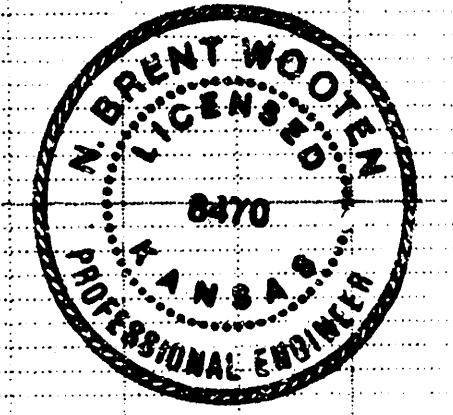

Private Sanitary Sewer Line to serve Boeing Property

BAUGHMAN COMPANY P. A.
ENGINEERING & SURVEYING
316/262-7271 • 315 ELLIS • WICHITA, KANSAS 67211

PROJECT NUMBER
278 PPS (607961)

DESIGN NBH	DRAWN FLM	APPROVED NEW	DATE JAN 91	SCALE 1"=20'-0"
---------------	--------------	-----------------	----------------	--------------------

Revised As Built 2-27-91 TCR