


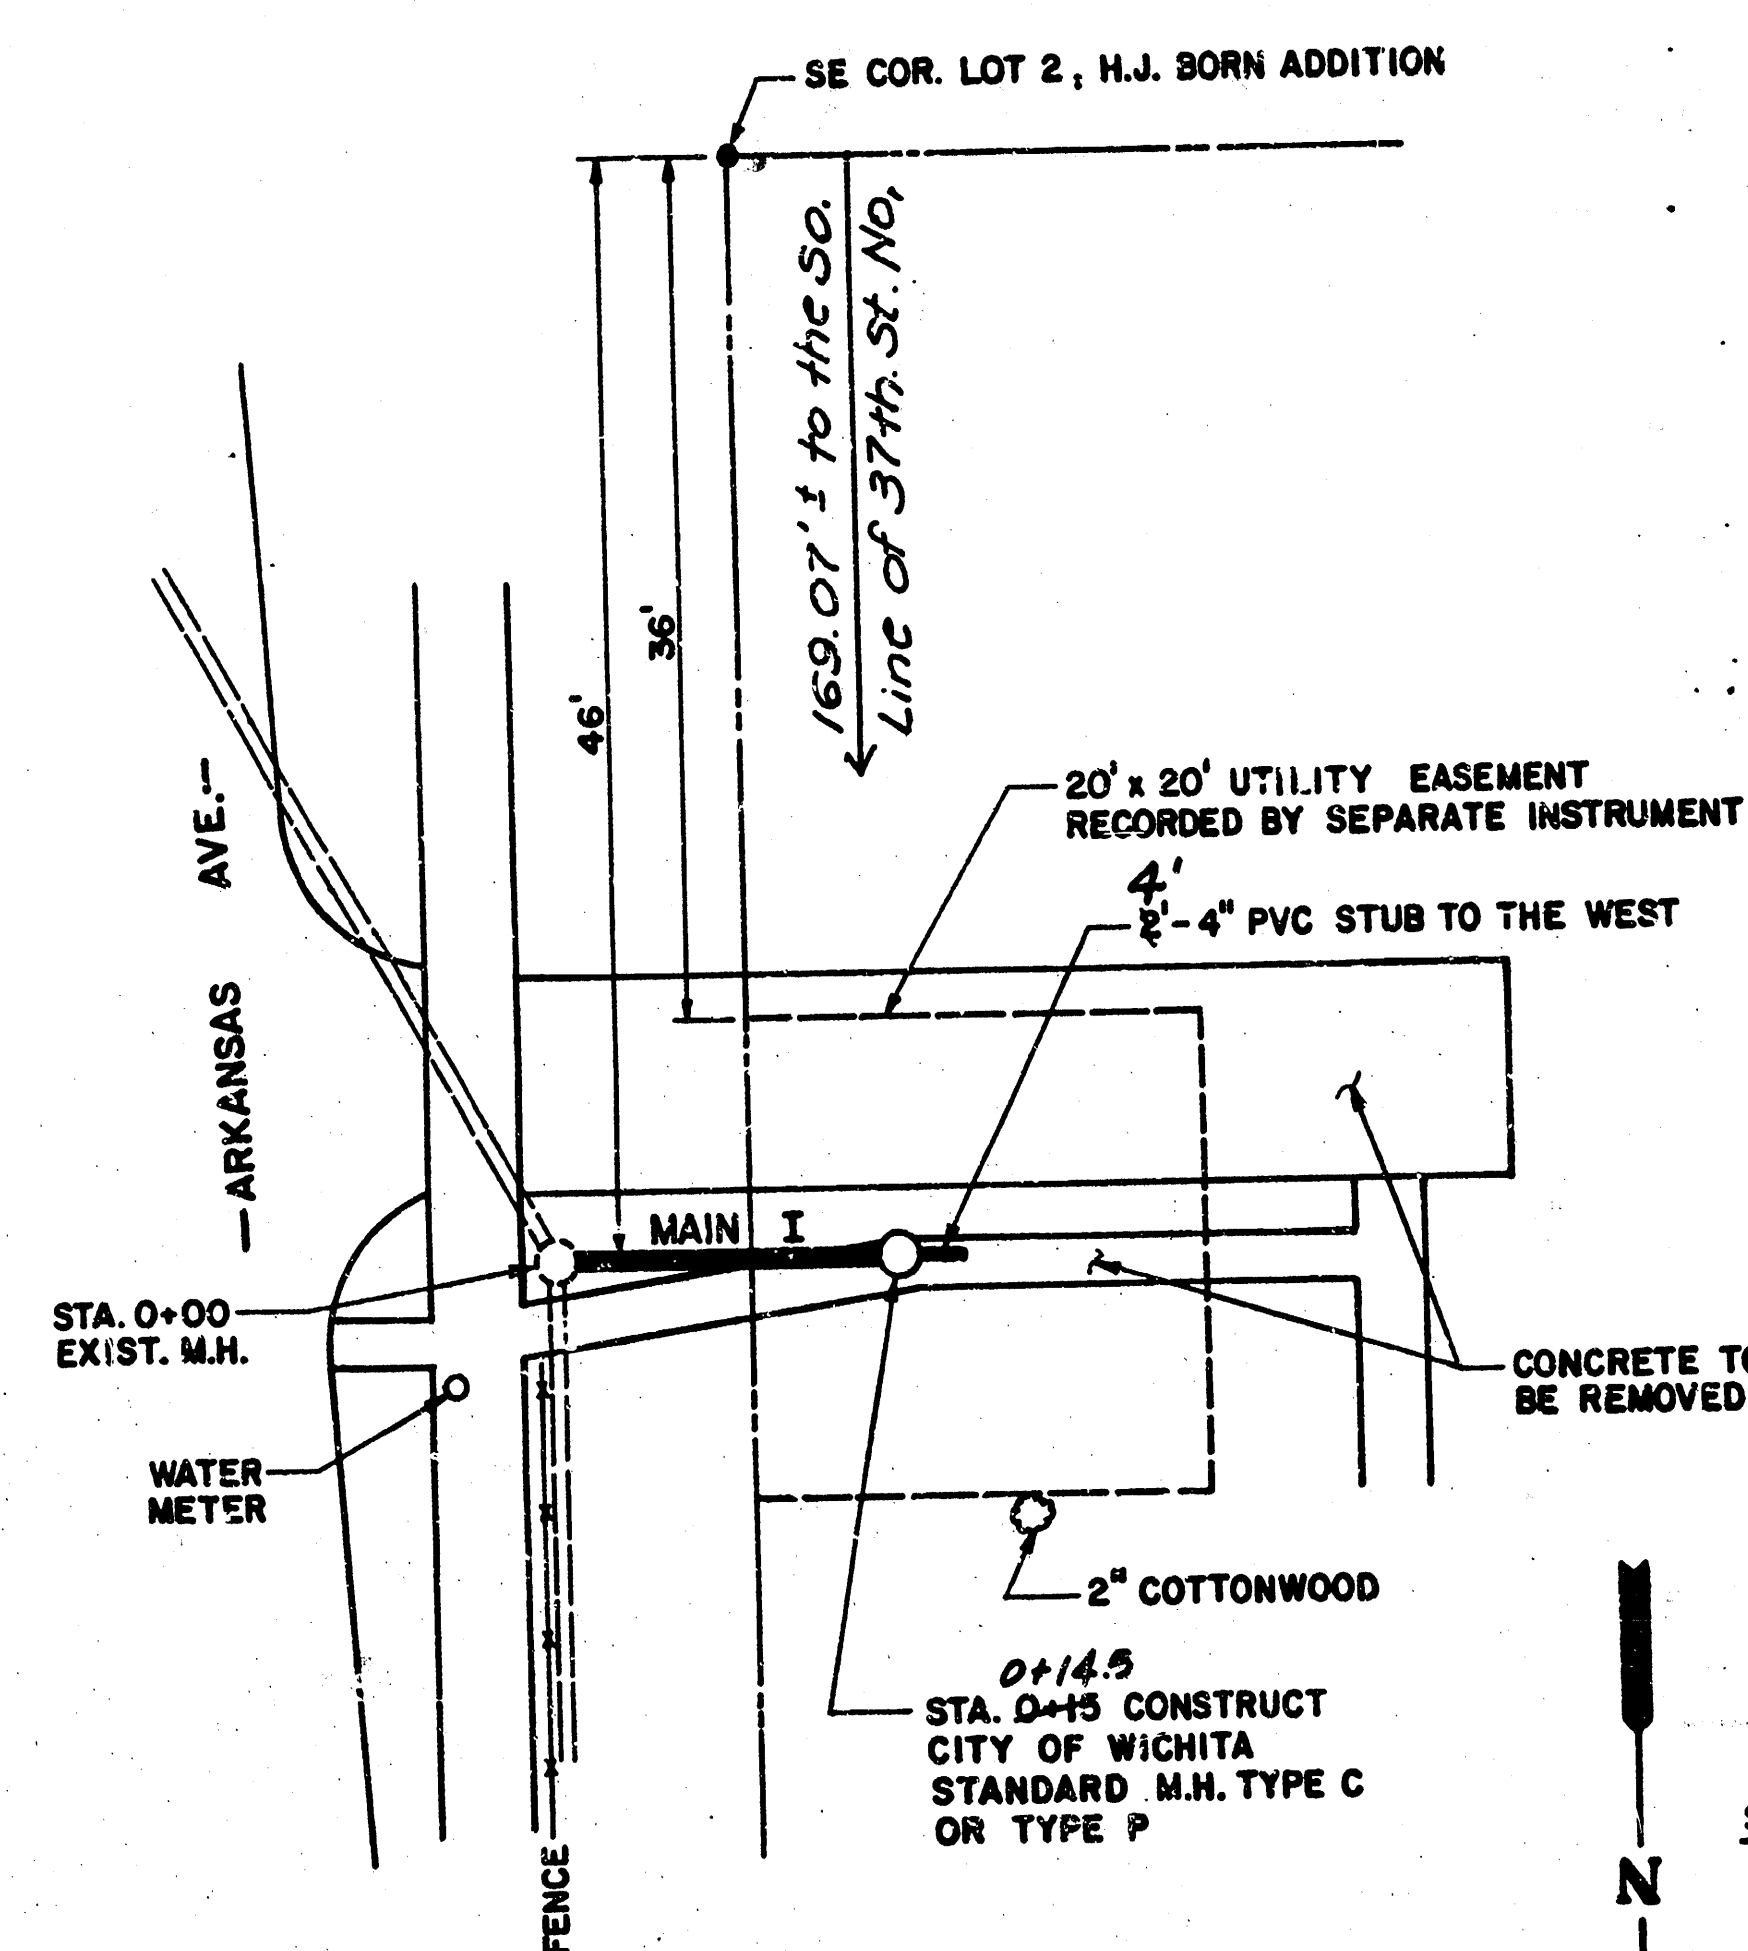


PLANS FOR SANITARY SEWER SYSTEM FOR


E. 150' OF LOT 2 EXCEPT S. 0.19' THEREOF
H.J. BORN ADD.
SEDGWICK COUNTY, KANSAS
CITY OF WICHITA PRIVATE PROJECT NO. 468-76-245-80001-000-000-175
1988

SCALE
HORIZONTAL: 1" = 10'
VERTICAL: 1" = 5'

B.M. = CITY DISC WEST FACE WALK
EAST SIDE ARKANSAS ON FLOOD CONTROL
DIKE, 100.4' NORTH OF 37th ST.
ELEV. = 135.75

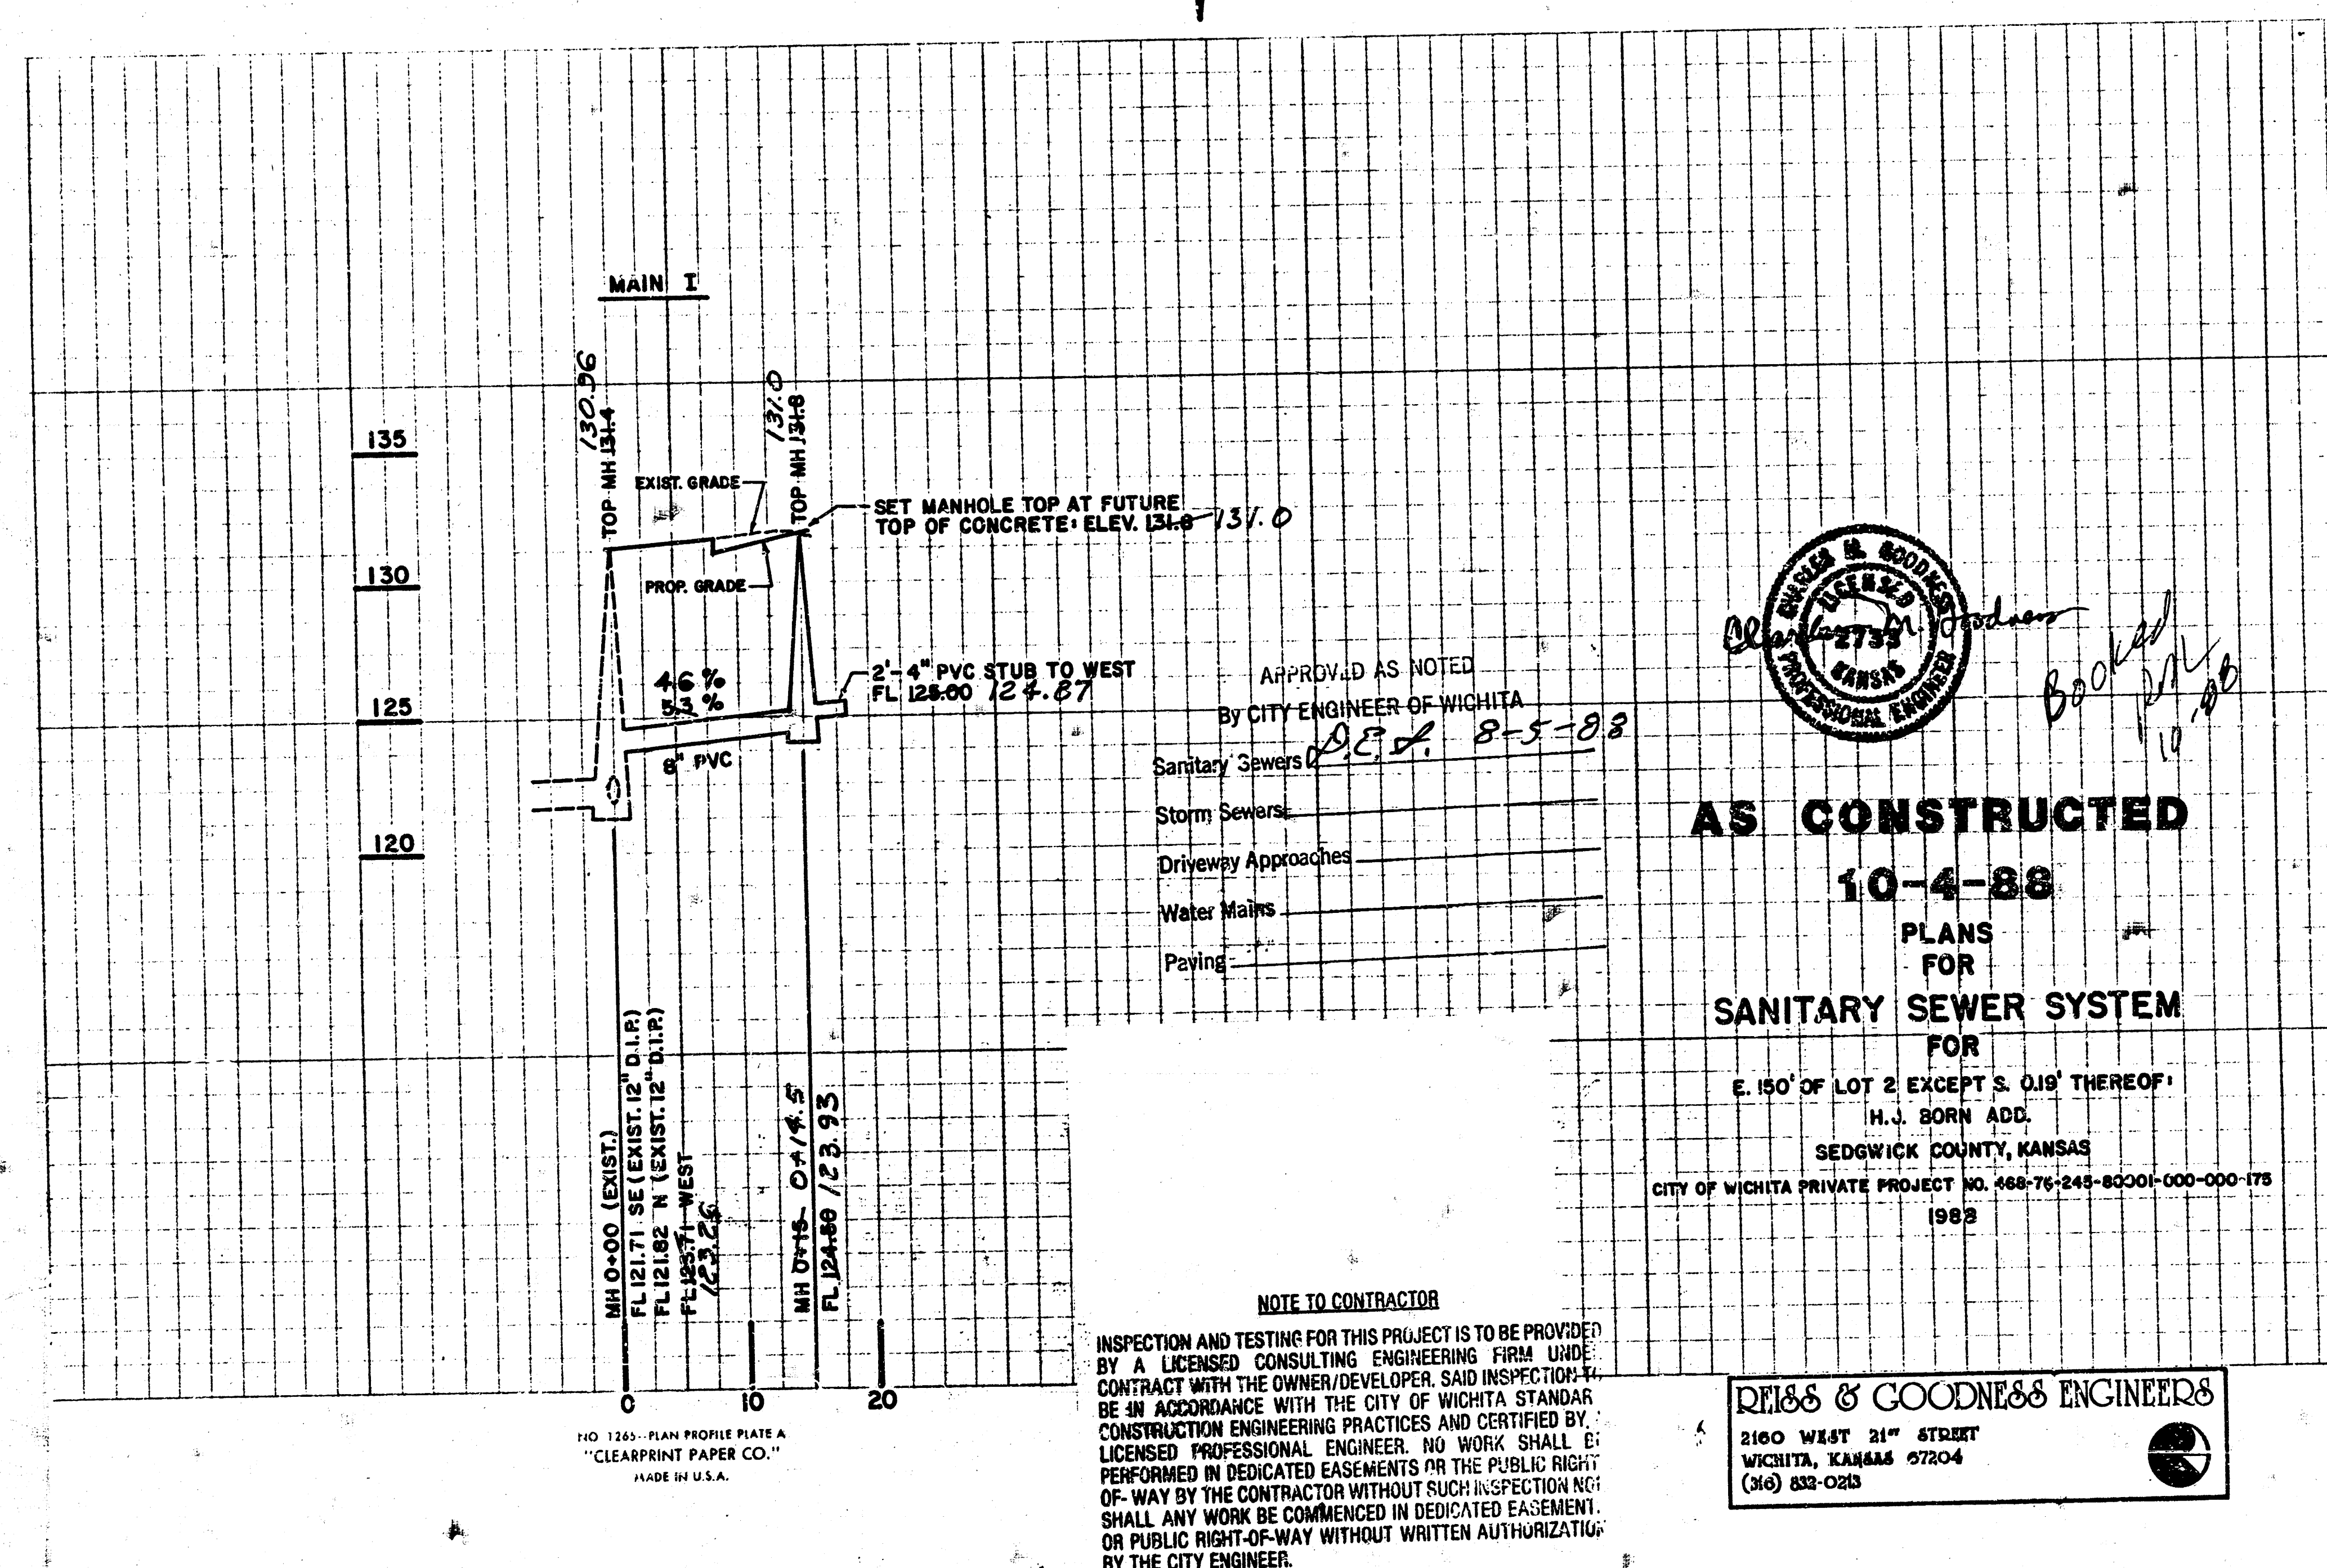

APPROVED AS NOTED
By CITY ENGINEER OF WICHITA
Sanitary Sewers
Storm Sewers
Driveway Approaches
Water Mains
Paving

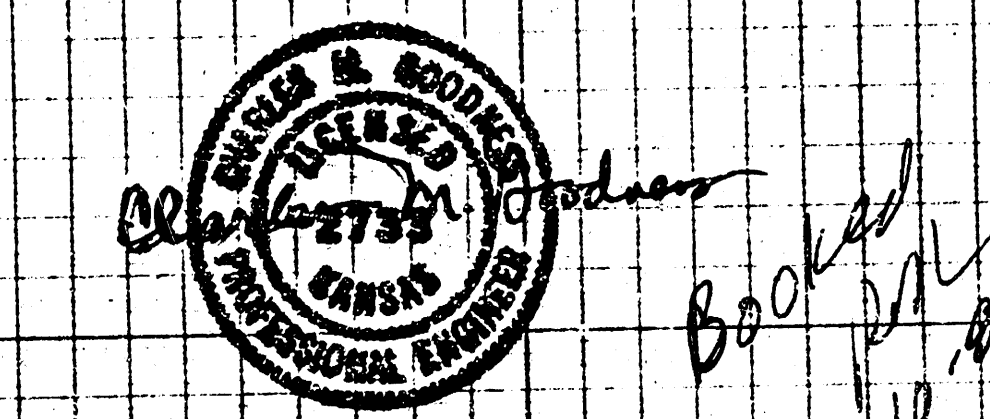

AS CONSTRUCTED
10-4-88

PLANS FOR SANITARY SEWER SYSTEM FOR

E. 150' OF LOT 2 EXCEPT S. 0.19' THEREOF
H.J. BORN ADD.
SEDGWICK COUNTY, KANSAS
CITY OF WICHITA PRIVATE PROJECT NO. 468-76-245-80001-000-000-175
1988

NOTE TO CONTRACTOR
INSPECTION AND TESTING FOR THIS PROJECT IS TO BE PROVIDED BY A LICENSED CONSULTING ENGINEERING FIRM UNDER CONTRACT WITH THE OWNER/DEVELOPER. SAID INSPECTION SHALL BE IN ACCORDANCE WITH THE CITY OF WICHITA STANDARD CONSTRUCTION ENGINEERING PRACTICES AND CERTIFIED BY A LICENSED PROFESSIONAL ENGINEER. NO WORK SHALL BE PERFORMED IN DEDICATED EASEMENTS OR THE PUBLIC RIGHT-OF-WAY BY THE CONTRACTOR WITHOUT SUCH INSPECTION NOT. SHALL ANY WORK BE COMMENCED IN DEDICATED EASEMENT, OR PUBLIC RIGHT-OF-WAY WITHOUT WRITTEN AUTHORIZATION BY THE CITY ENGINEER.

R. E. & GOODNESS ENGINEERS
2100 WEST 21ST STREET
WICHITA, KANSAS 67204
(316) 832-0213

FILMED FROM THE BEST
AVAILABLE COPY