

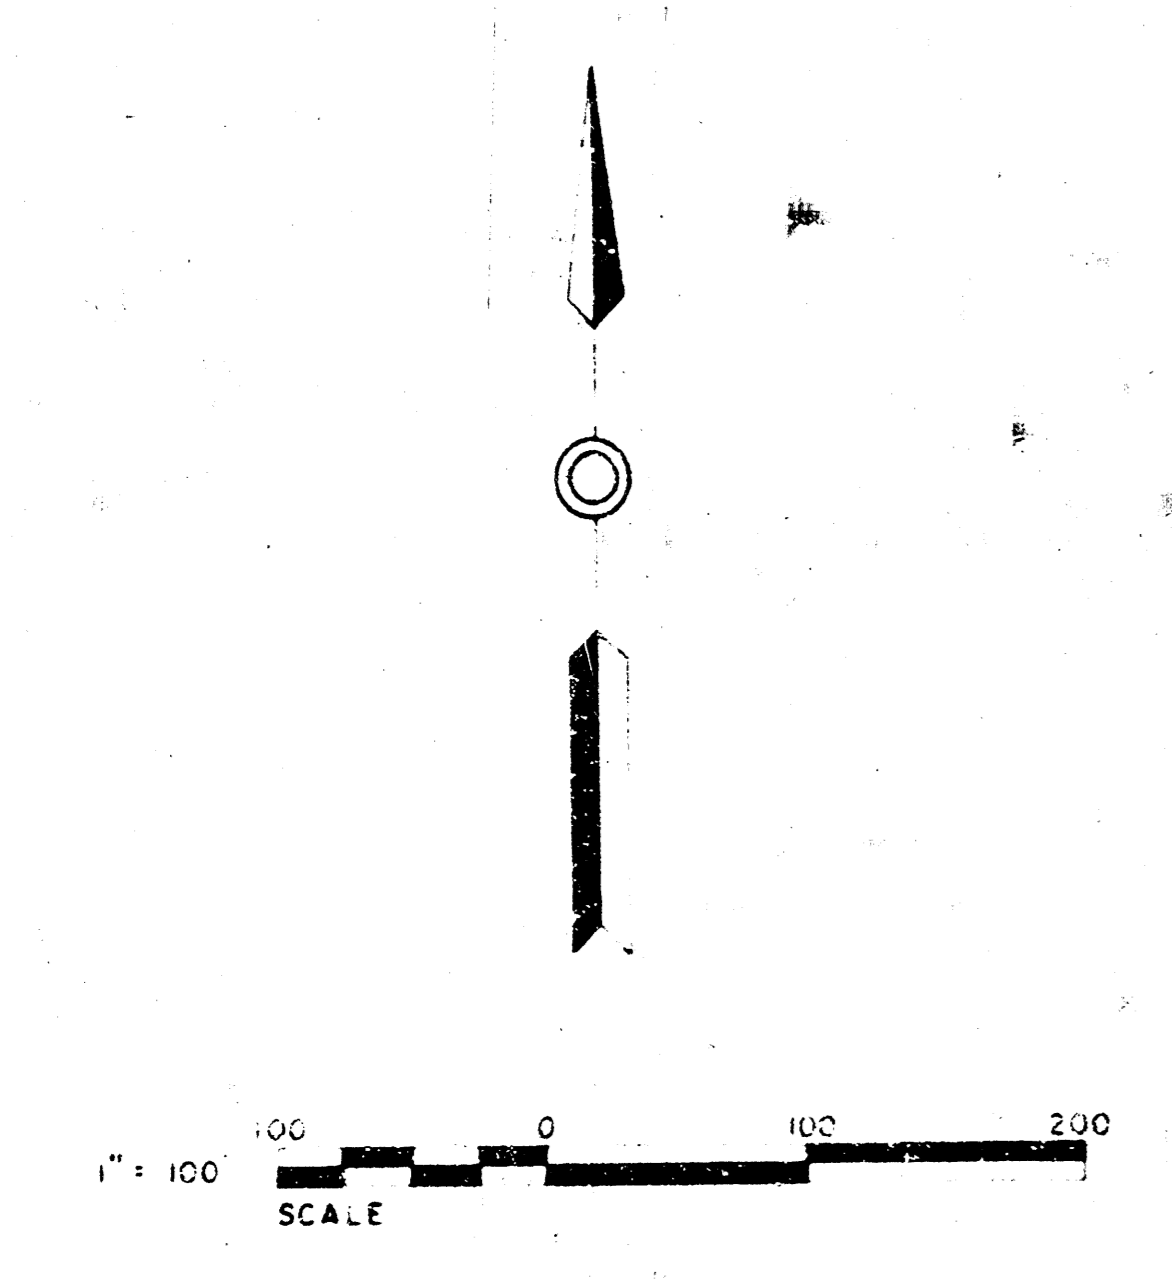


SANITARY SEWERS

AS CONSTRUCTED

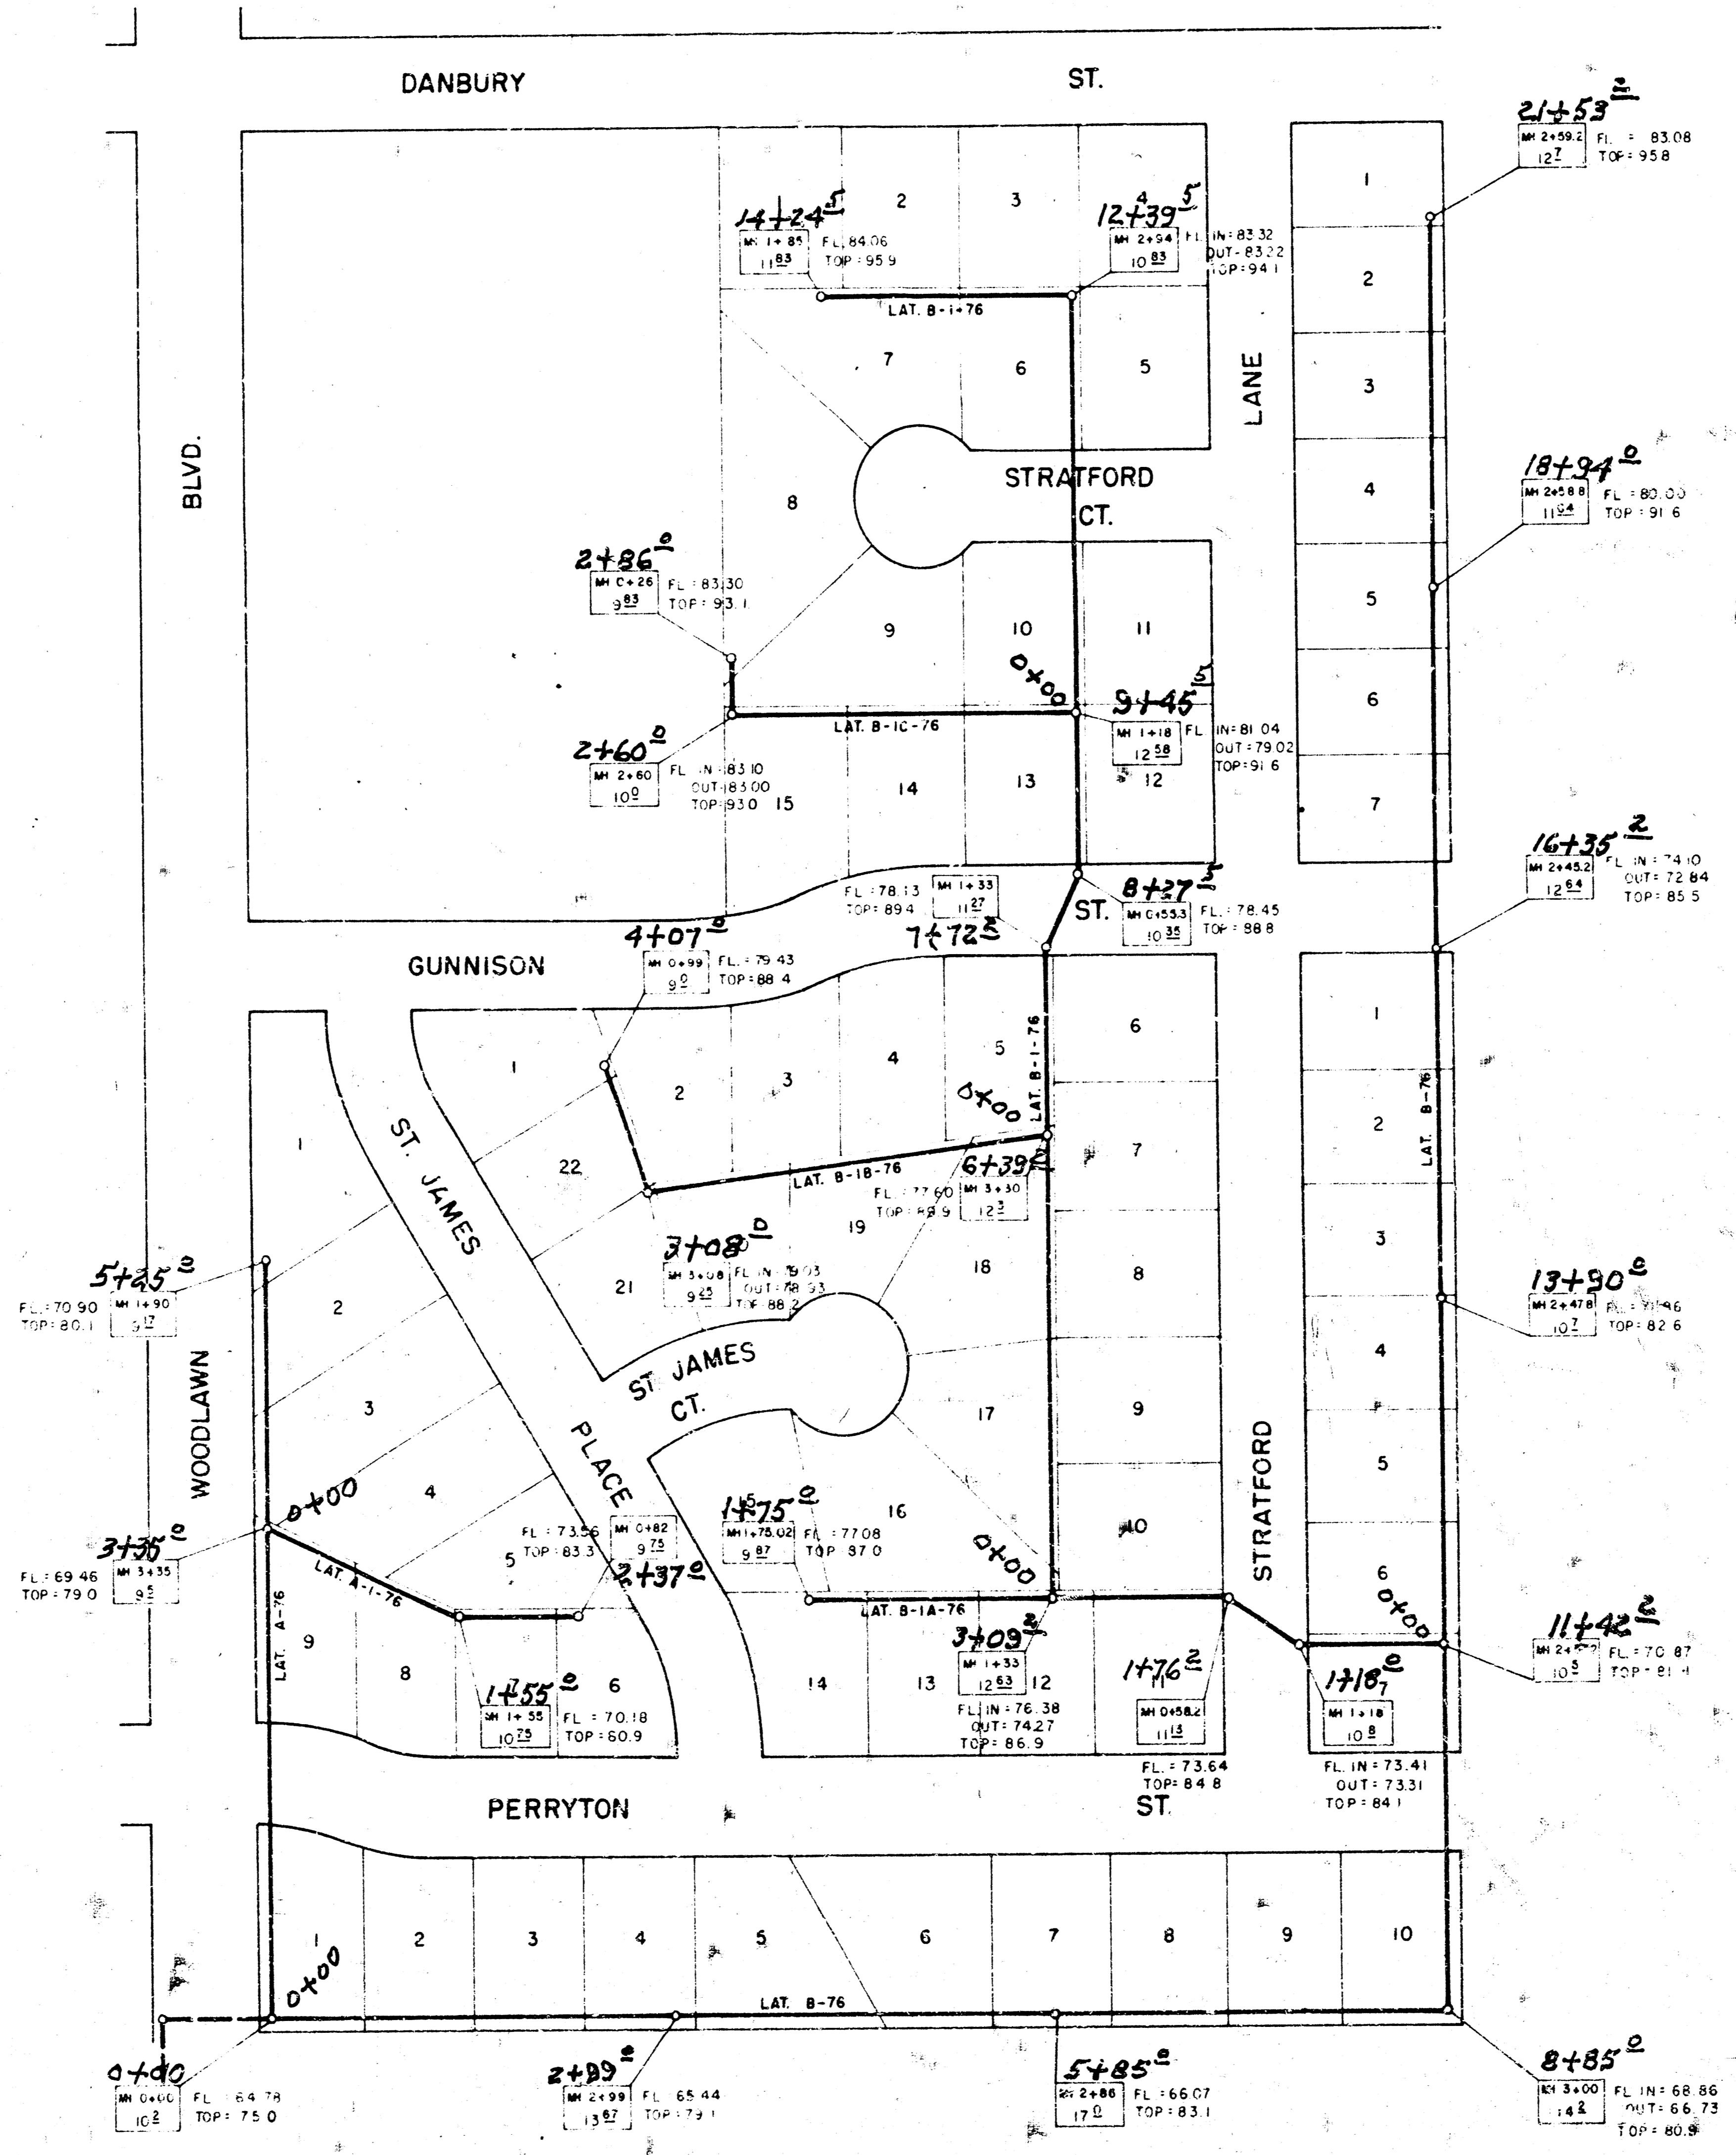

Stubs installed in manholes as shown by plan
 All manholes type C

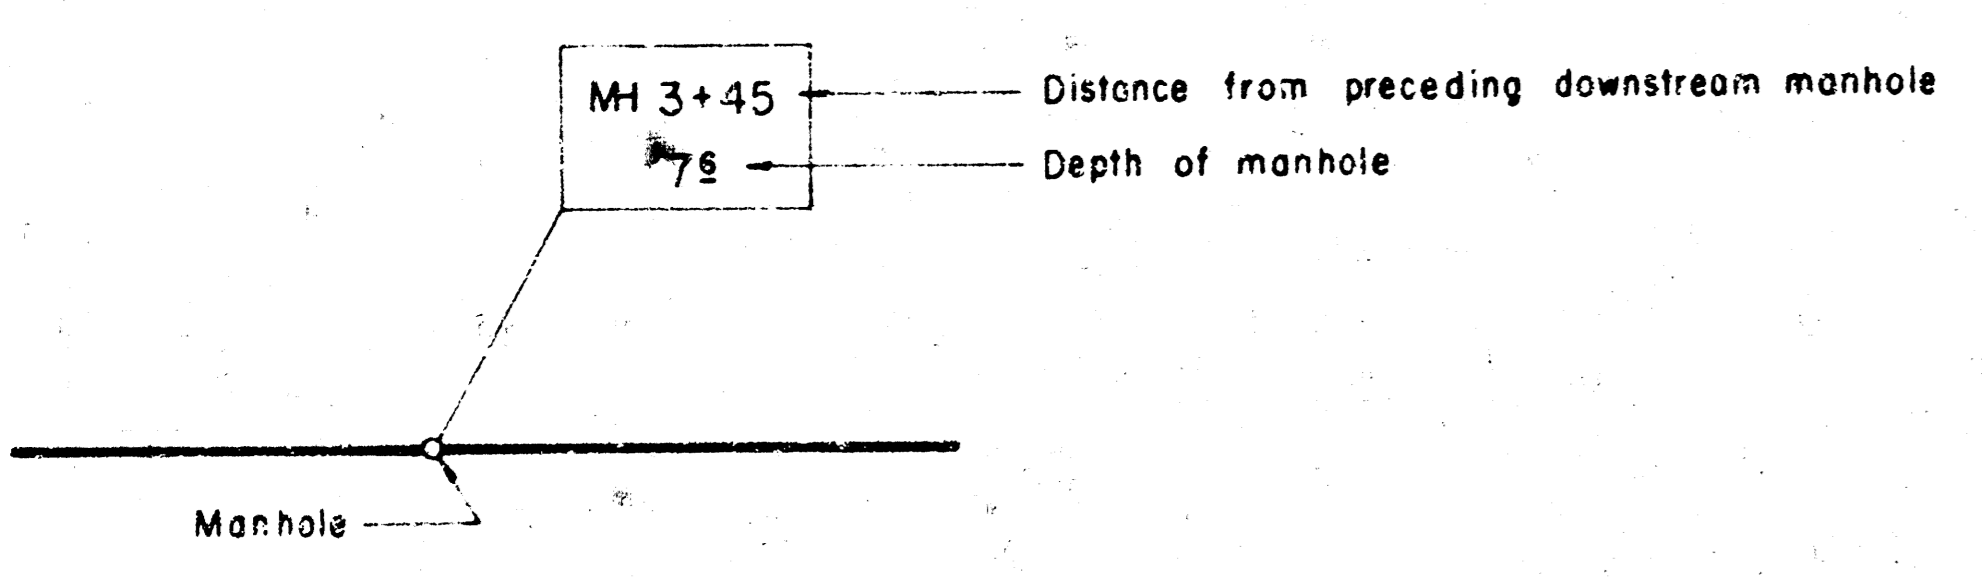

For U.S.G.S. Datum Add 1300.00 to Elevations Shown