


BENCH MARK: 4" CROSS ON BACK OF WALK, S.W. CORNER OF LOT 25, BLOCK 2, BRUSH CREEK ADDN. ELEV. 176.21 CITY DATUM

SCALE 1" = 40' PLAN
1" = 5' PROFILE

STATION 0+00 (LINE 4)
CONSTRUCT TYPE 1A
MH OVER EXISTING 18" PIPE
TOP 176.50, 4" STUB S.E.

+65.4
Station 2+00 Const.
Standard Manhole
Top Elevation 177.80
4" stub West

STATION 0+00 CONNECT
TO EXISTING TYPE 'A'
MANHOLE. MINIMUM
TOP ELEV. TO 176.25

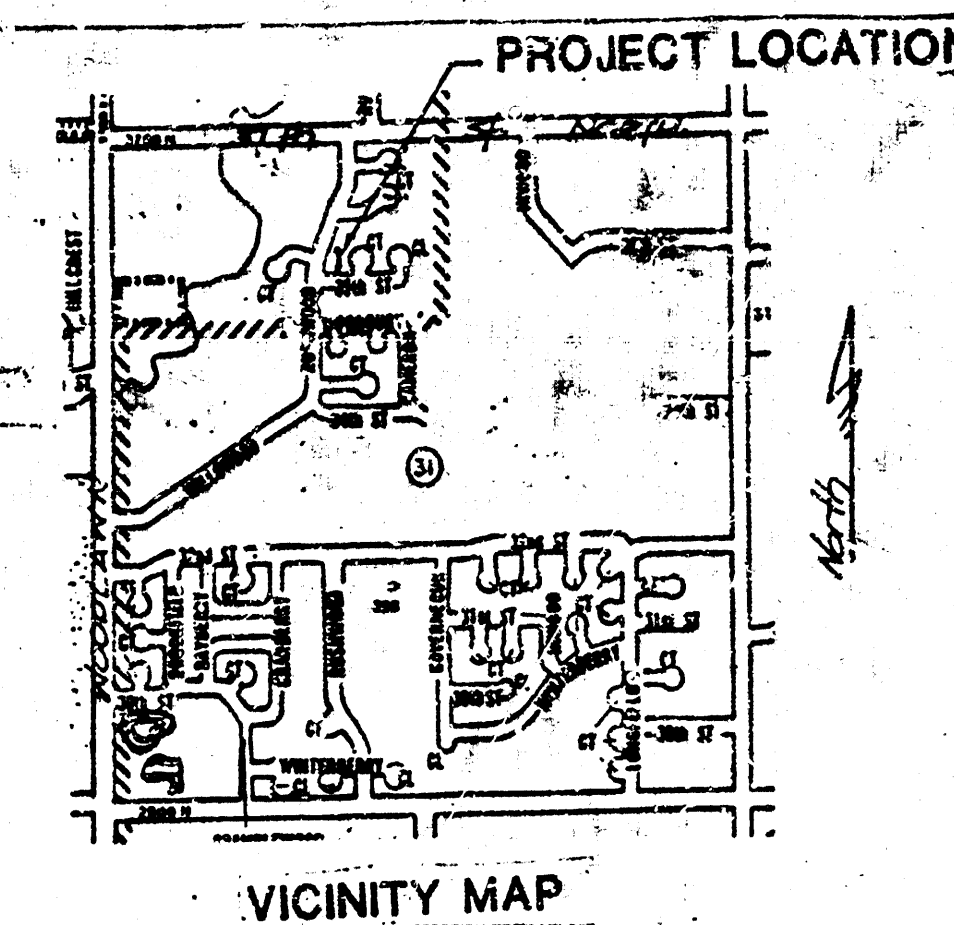

GENERAL NOTES

- Underground utility service lines and overhead utility pole lines are to be adjusted as necessary by others prior to construction. The Contractor shall be responsible for their location, as shown on the plan, and for their depth. The Contractor will be required to work around existing utilities within the right-of-way which do not conflict with proposed construction.
- The Contractor shall be responsible for preserving property lines. The Contractor will be required to re-establish any property lines which are damaged or destroyed by his construction operations. Such lines shall be re-established by a licensed land surveyor in accordance with state laws.

NOTE TO CONTRACTOR


INSPECTION AND TESTING FOR THIS PROJECT IS TO BE PROVIDED BY A LICENSED CONSULTING ENGINEERING FIRM UNDER CONTRACT WITH THE OWNER/DEVELOPER. SAID INSPECTION TO BE IN ACCORDANCE WITH THE CITY OF WICHITA STANDARD CONSTRUCTION ENGINEERING PRACTICES AND CERTIFIED BY A LICENSED PROFESSIONAL ENGINEER. WORK SHALL BE PERFORMED IN DEDICATED EASEMENTS OR THE PUBLIC RIGHT-OF-WAY BY THE CONTRACTOR WITHOUT SUCH INSPECTION AND SHALL ANY WORK BE COMMENCED IN DEDICATED EASEMENTS OR PUBLIC RIGHT-OF-WAY WITHOUT WRITTEN AUTHORIZATION BY THE CITY ENGINEER.

APPROVED AS NOTED

By CITY ENGINEER OF WICHITA

Sanitary Sewers: V.R.H. 8/10/88

Storm Sewers:

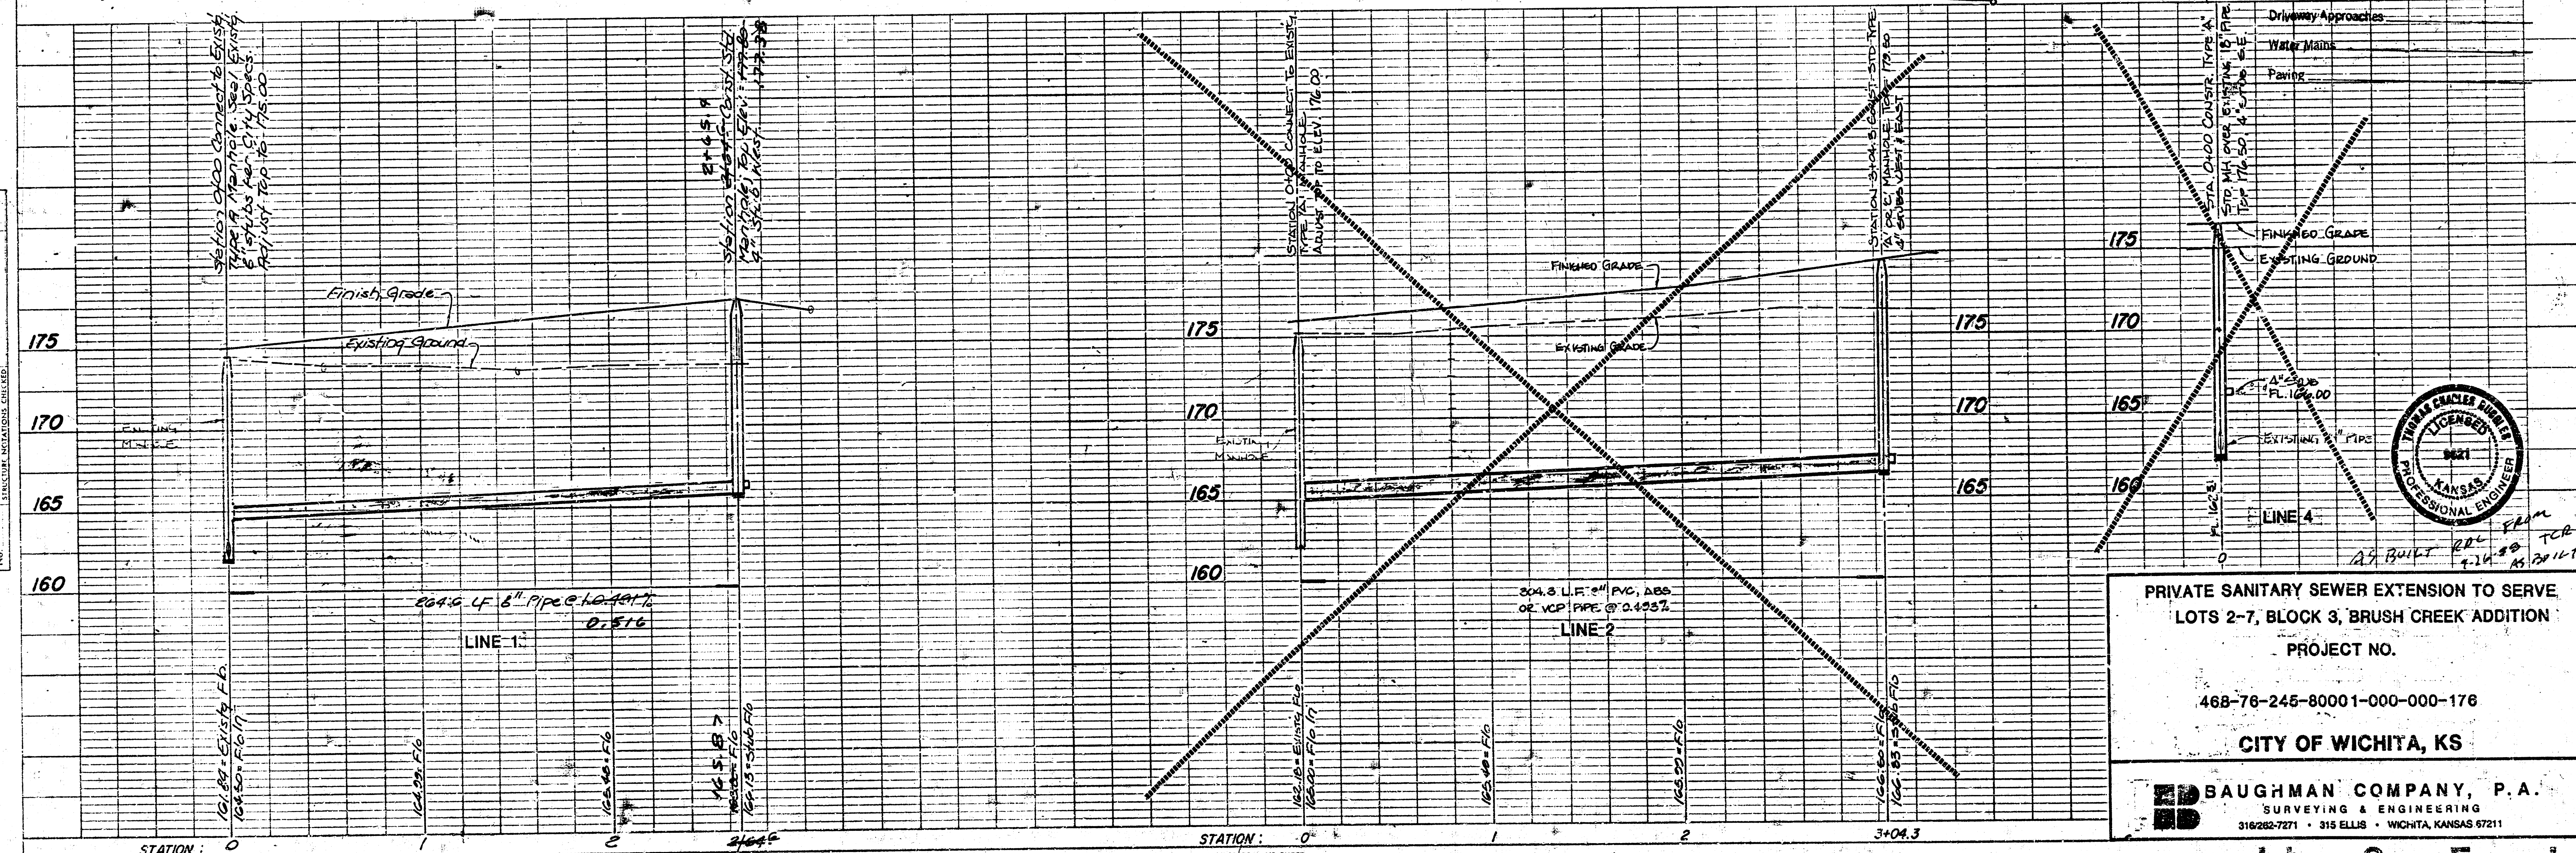

PRIVATE SANITARY SEWER EXTENSION TO SERVE
LOTS 2-7, BLOCK 3, BRUSH CREEK ADDN
PROJECT NO.

468-76-245-80001-000-000-178

CITY OF WICHITA, KS

BAUGHMAN COMPANY, P.A.
SURVEYING & ENGINEERING
316262-7271 • 315 ELLIS • WICHITA, KANSAS 67211

FILMED FROM THE BEST
AVAILABLE COPY