





BENCH MARK: "X" cross at S.W. corner of Lot 25, Block 2, Brush Creek Addition
Elevation = 175.24 City Datum

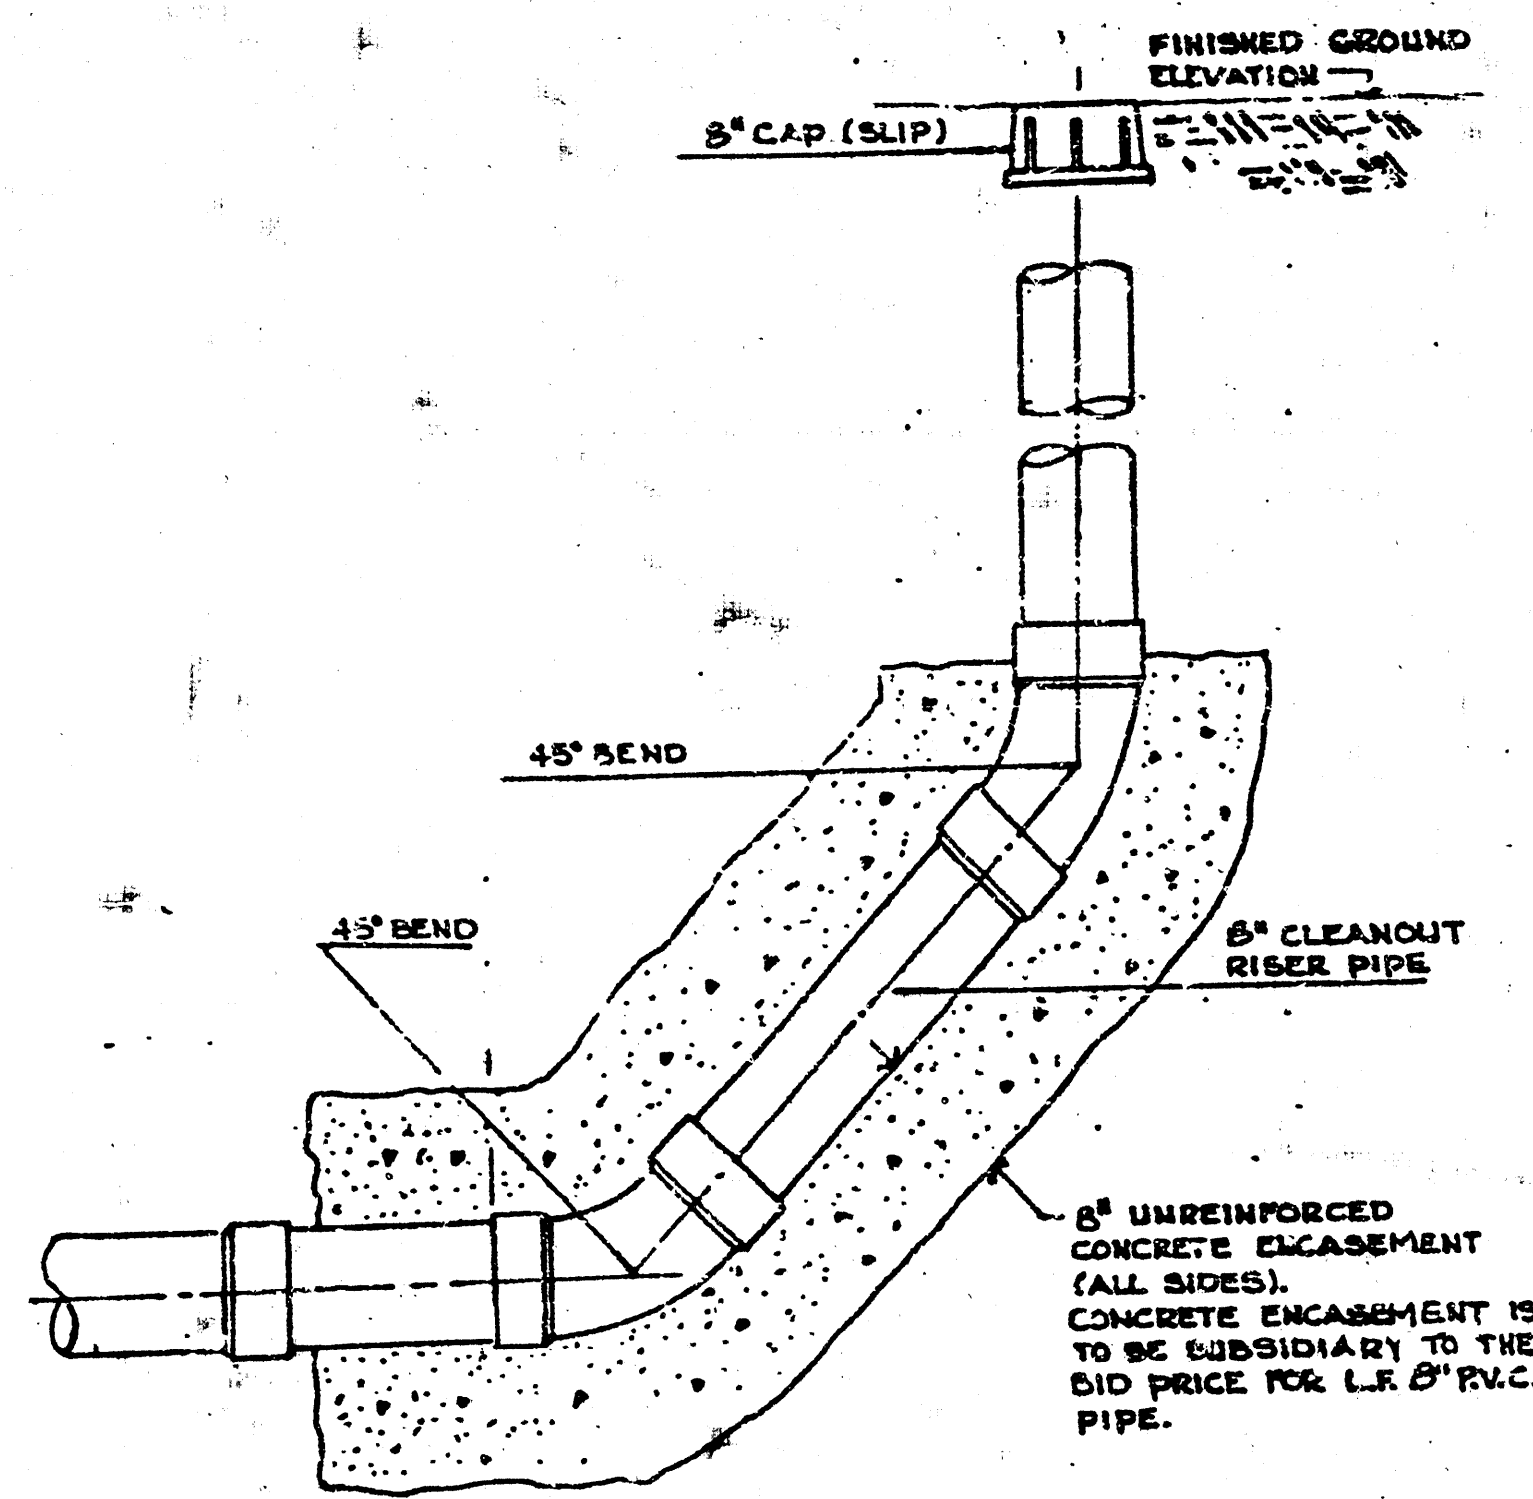

DETAIL 8" R.V.C. CLEANOUT RISER - END OF LINE-

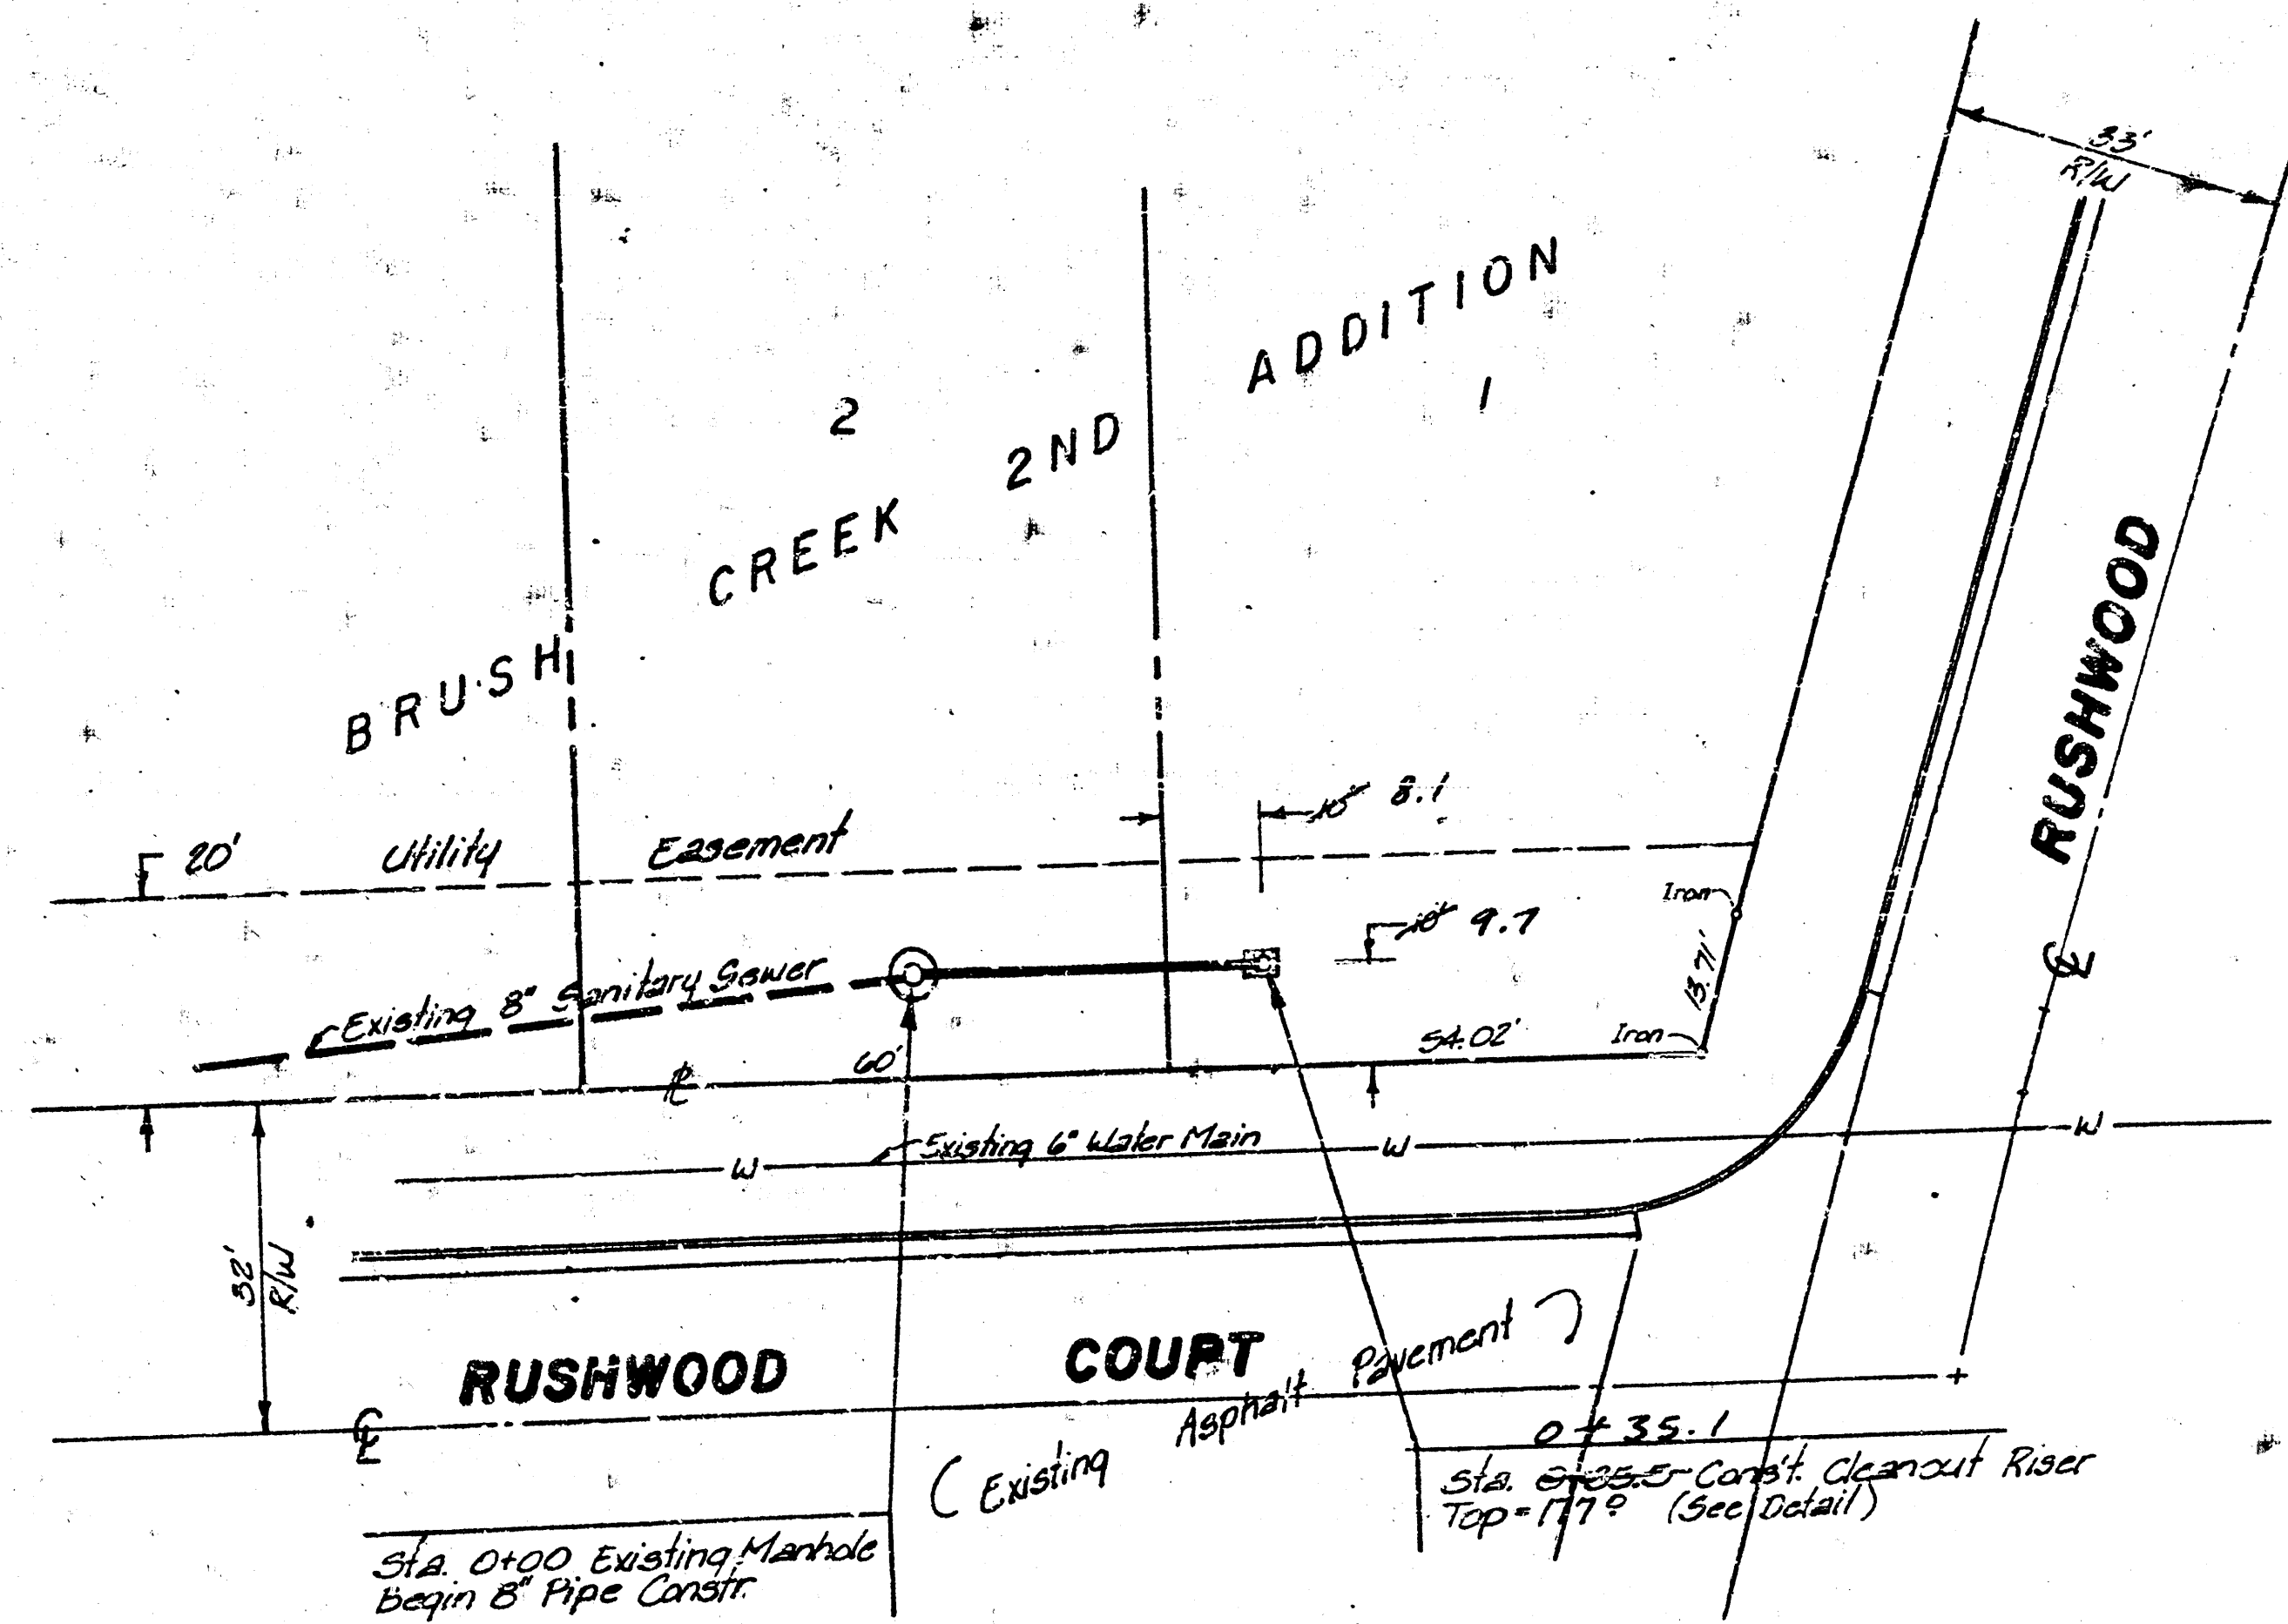

Scale: 1" = 20' Horiz.
1" = 5' Vert.

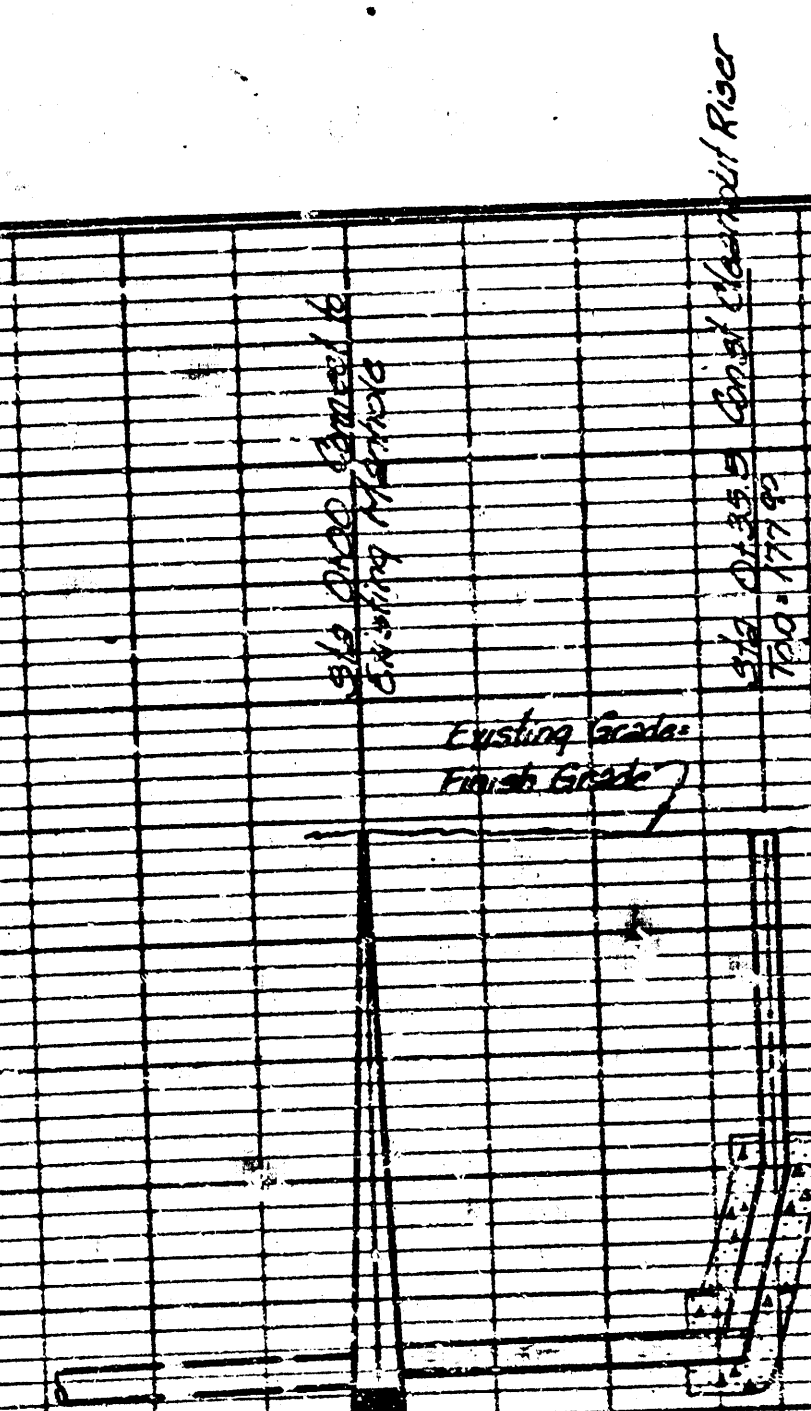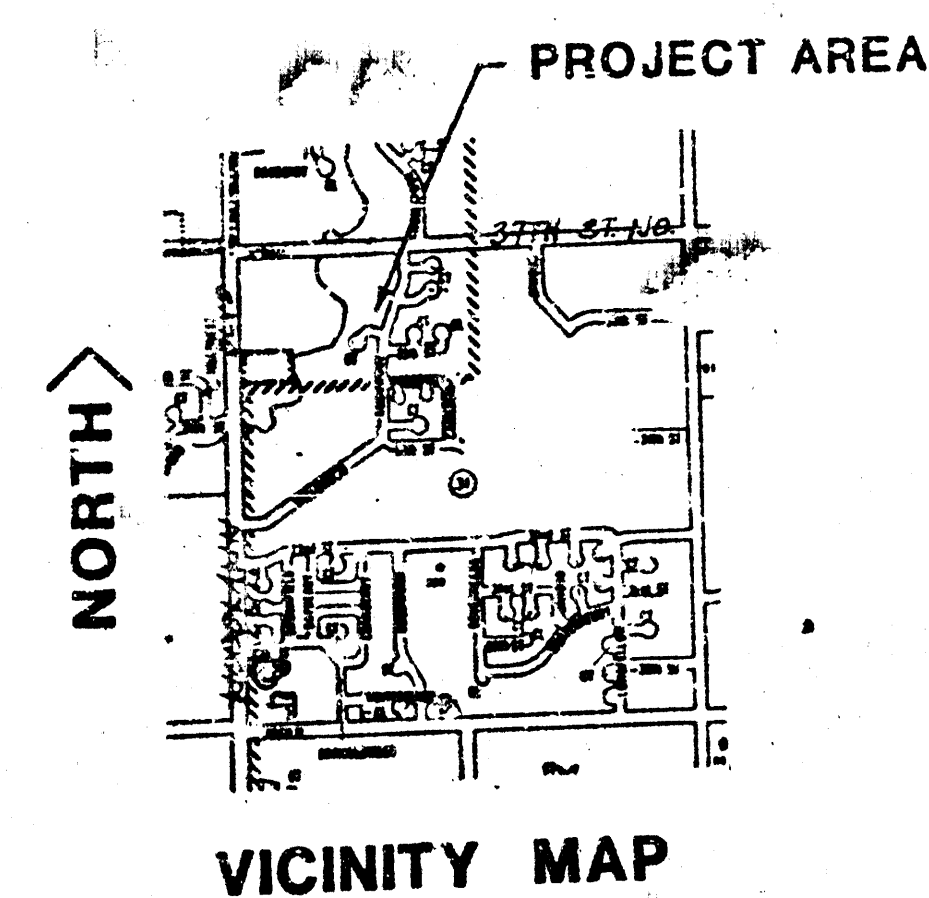

APPROVED AND
By CITY ENGINEER OF WICHITA

Sanitary Sewers
Storm Sewers
Driveway Approaches
Water Mains

NOTE TO CONTRACTOR
INSPECTION AND TESTING FOR THIS PROJECT IS TO BE PROVIDED BY THE LICENSED CIVIL ENGINEER, P.E. AND INSPECTION IN ACCORDANCE WITH THE WICHITA S.E.W.E.R. DEPARTMENT. NO WORK SHALL BE PERFORMED BY THE CONTRACTOR WITHOUT THE WRITTEN AUTHORIZATION OF THE CITY ENGINEER.



AS BUILT 9-26-88 TCR

PRIVATE SANITARY SEWER EXTENSION
TO SERVE LOT 1,
BRUSH CREEK 2ND ADDITION
PROJECT NO. 468-76-245-80001-000-000-171
BAUGHMAN COMPANY, P.A.
SURVEYING & ENGINEERING
315 2ND ST. • WICHITA, KANSAS 67211
Scale: 1" = 1' Date: Jun 88

FILMED FROM THE BEST AVAILABLE COPY.....