



DATE: 9-2-70 REVISED: 9-10-70 REVISED: 9-10-70	KEISS AND GOODNESS ENGINEERS 1402 E. DOUGLAS A. WINTA - KANSAS	SANITARY SEWER LINE EXTENSION OF LAT. 29 - WAC INDUSTRIES SEWER TO JERVE PAUL BLANETT ADDITION TO WINTA - KANSAS	SHEET NO. 3
--	---	--	----------------

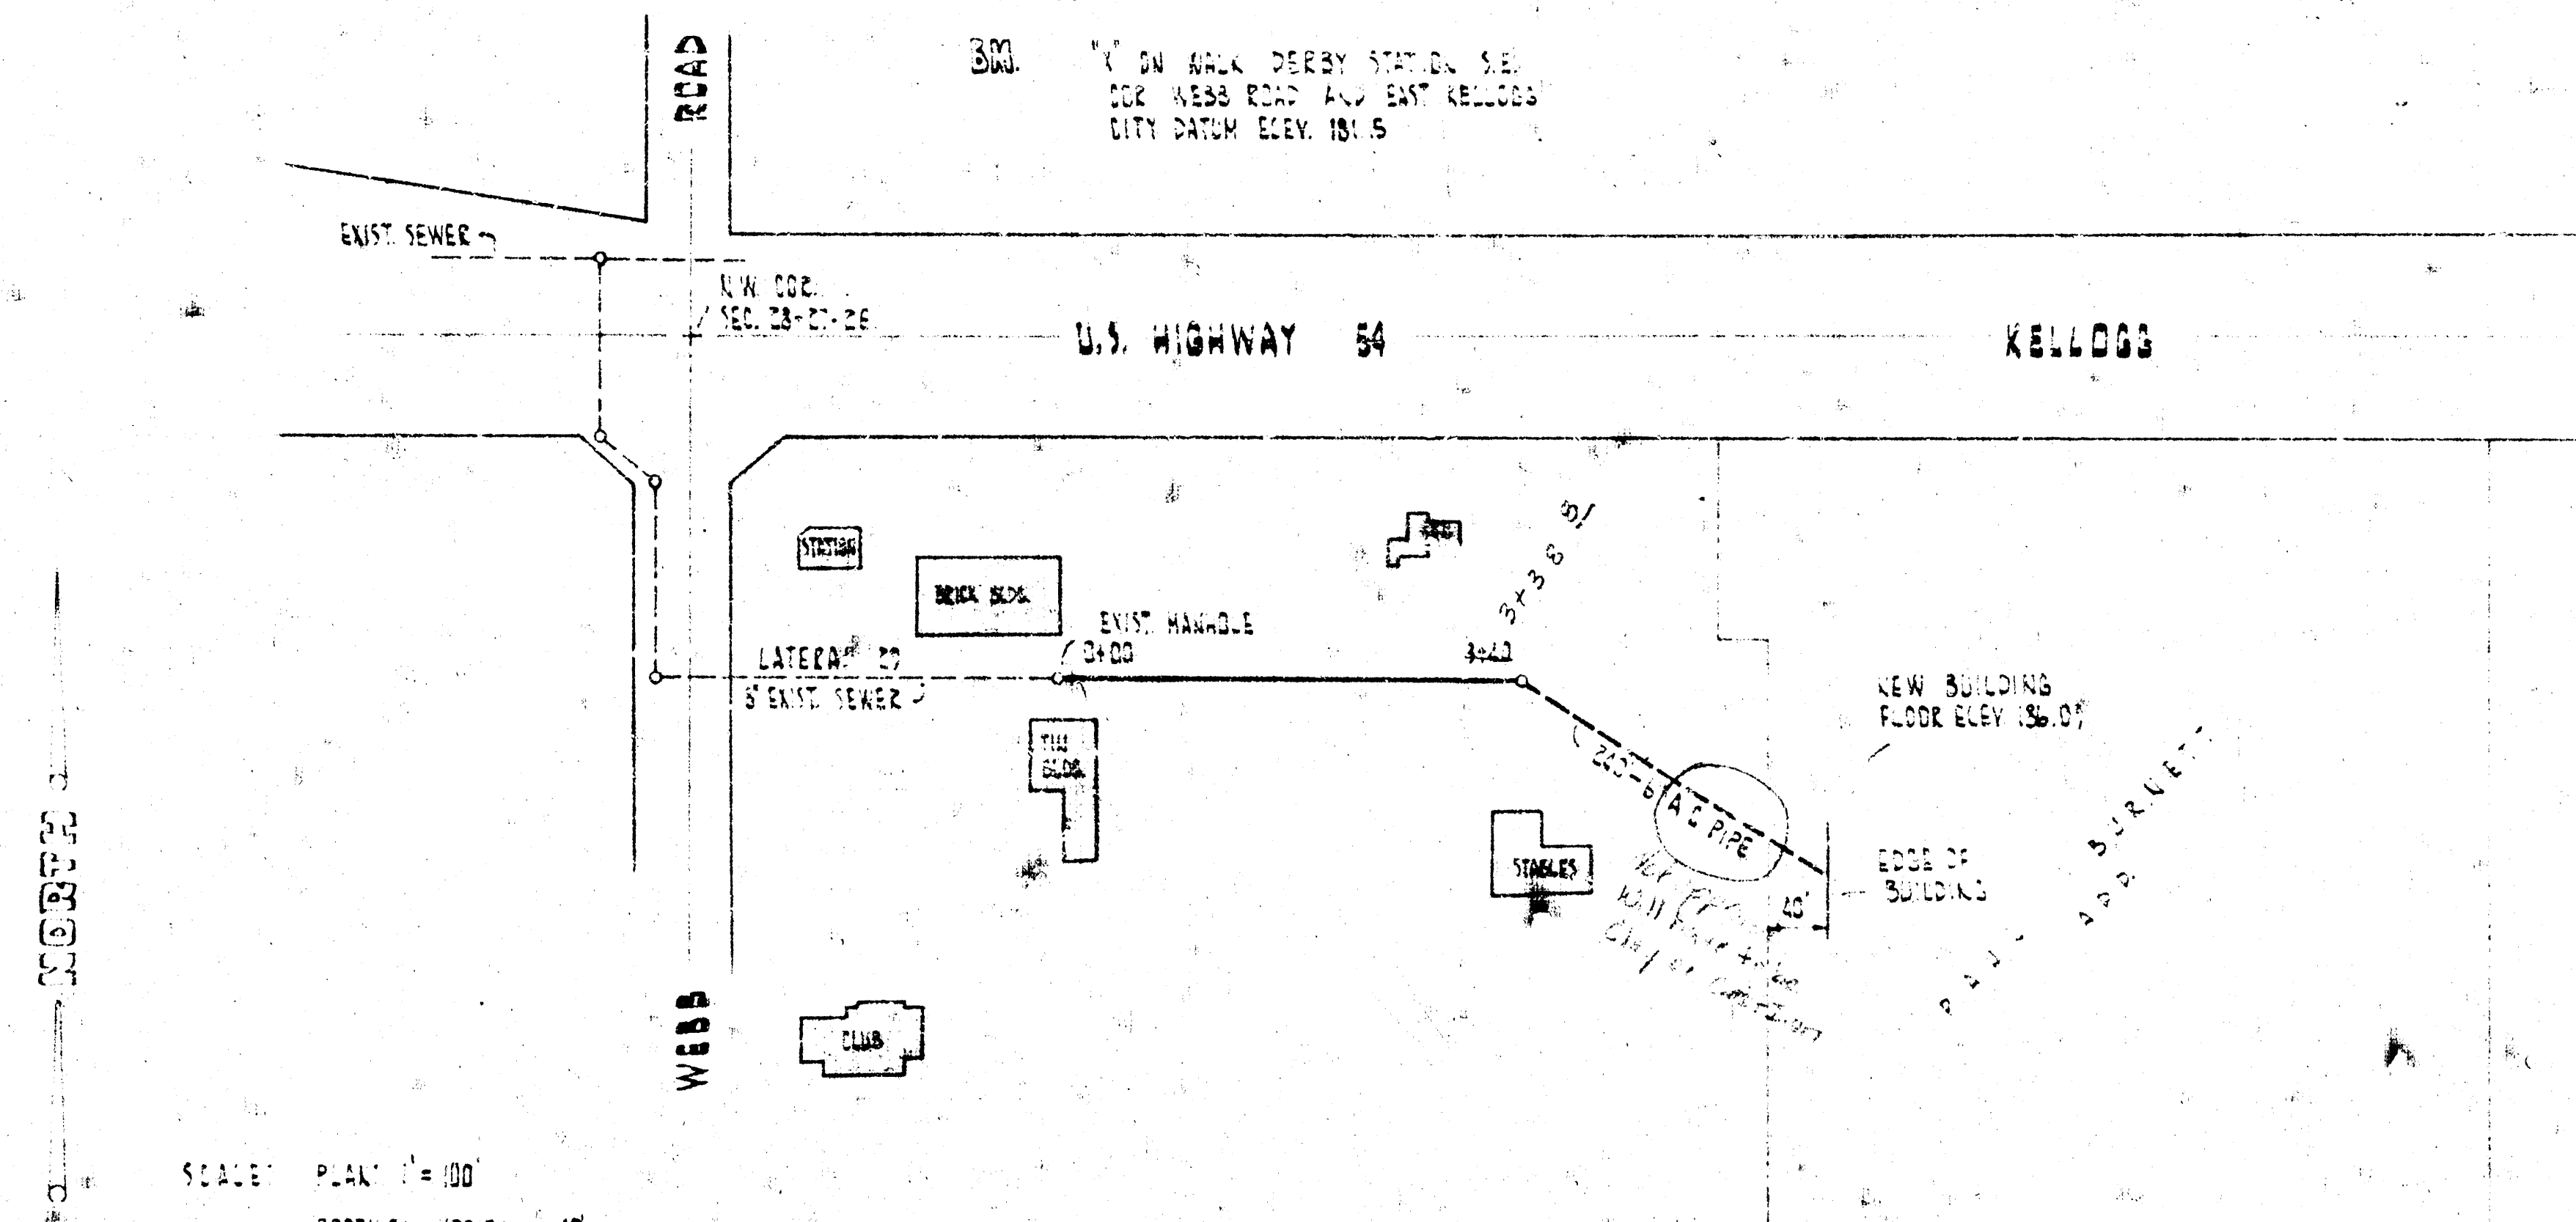

APPROVED AS NOTED
BY CITY ENGINEER
[Signature]
[Title]

NOTE TO CONTRACTOR
This project will be constructed under the supervision of the City Engineer and shall conform to the specifications of the City of WINTA. The CONTRACTOR shall maintain the City of WINTA's right of way and easements.

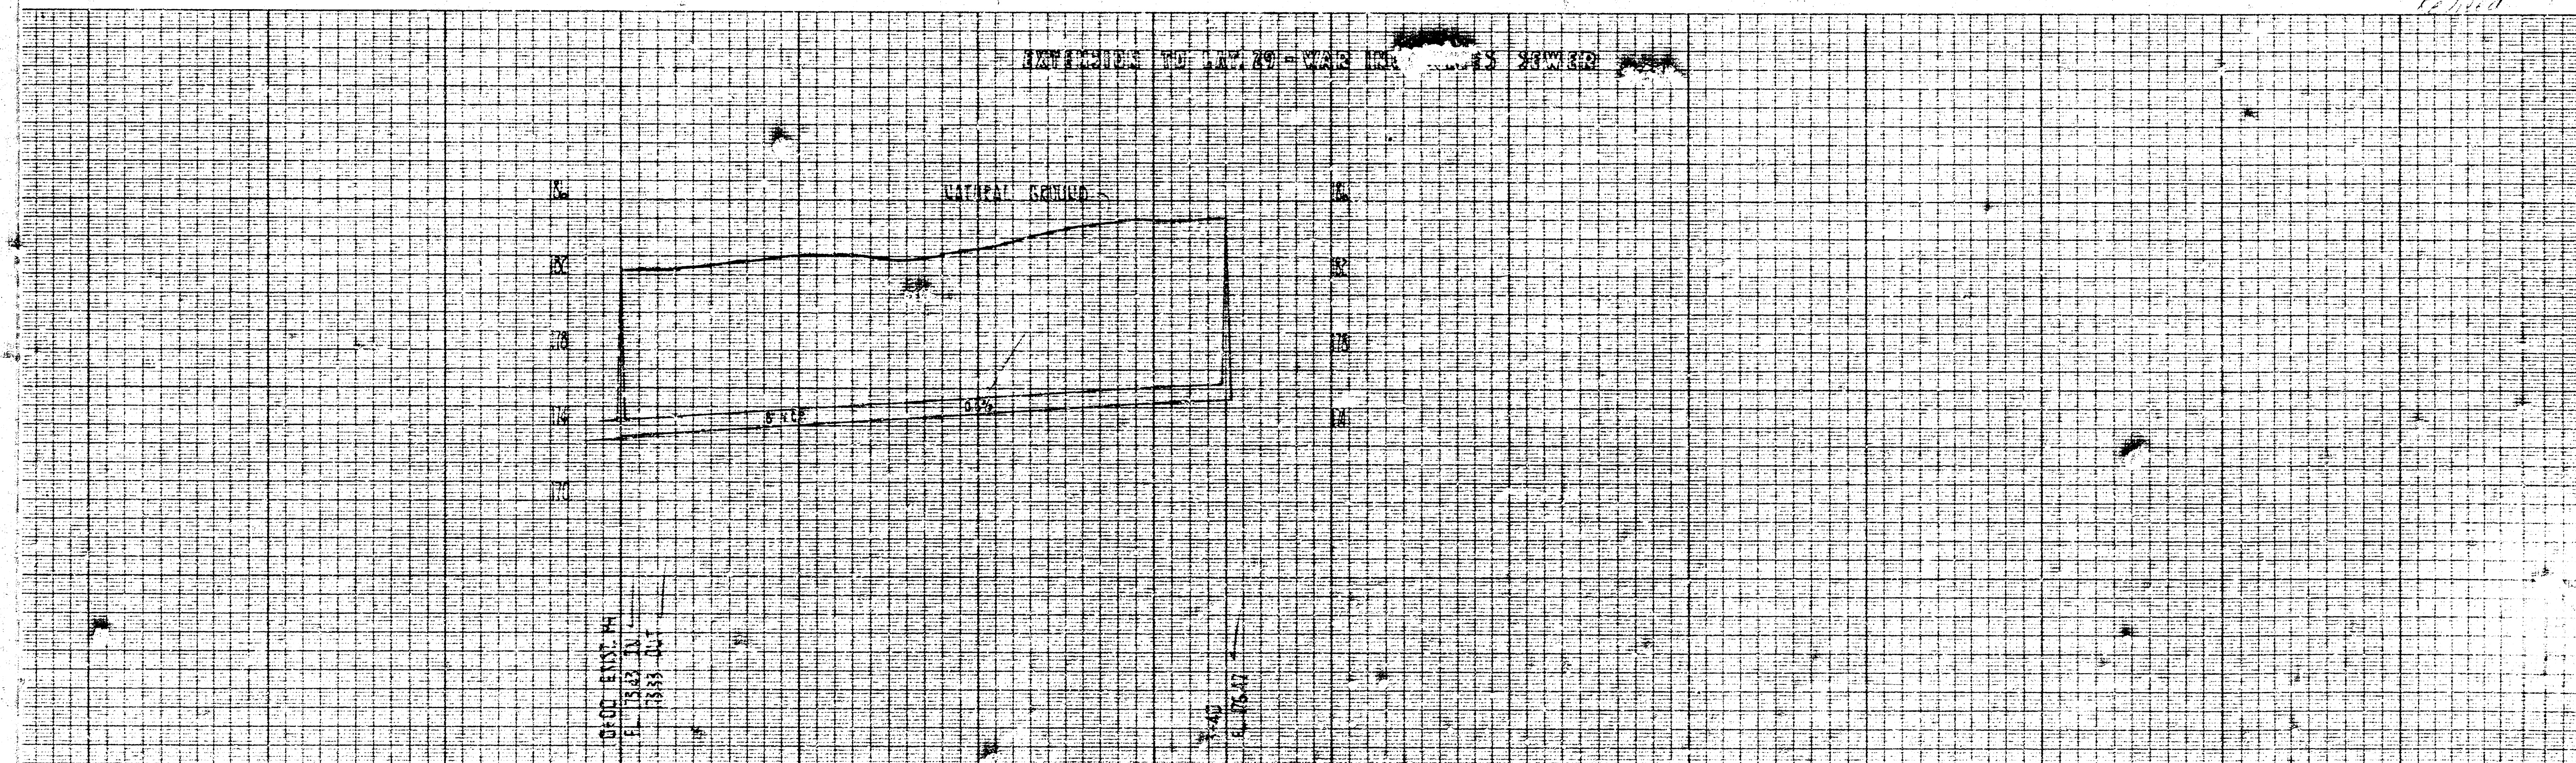

Ext. Lat. 29, W. I. S.
For Paul Burnett ADDN
Private Job