


PLANS
FOR
SANITARY SEWER SYSTEM
JACK CALDWELL ONE
SEDGWICK COUNTY, KANSAS

CITY OF WICHITA PRIVATE PROJECT NO. 607861-204PPS

1989


"AS CONSTRUCTED"

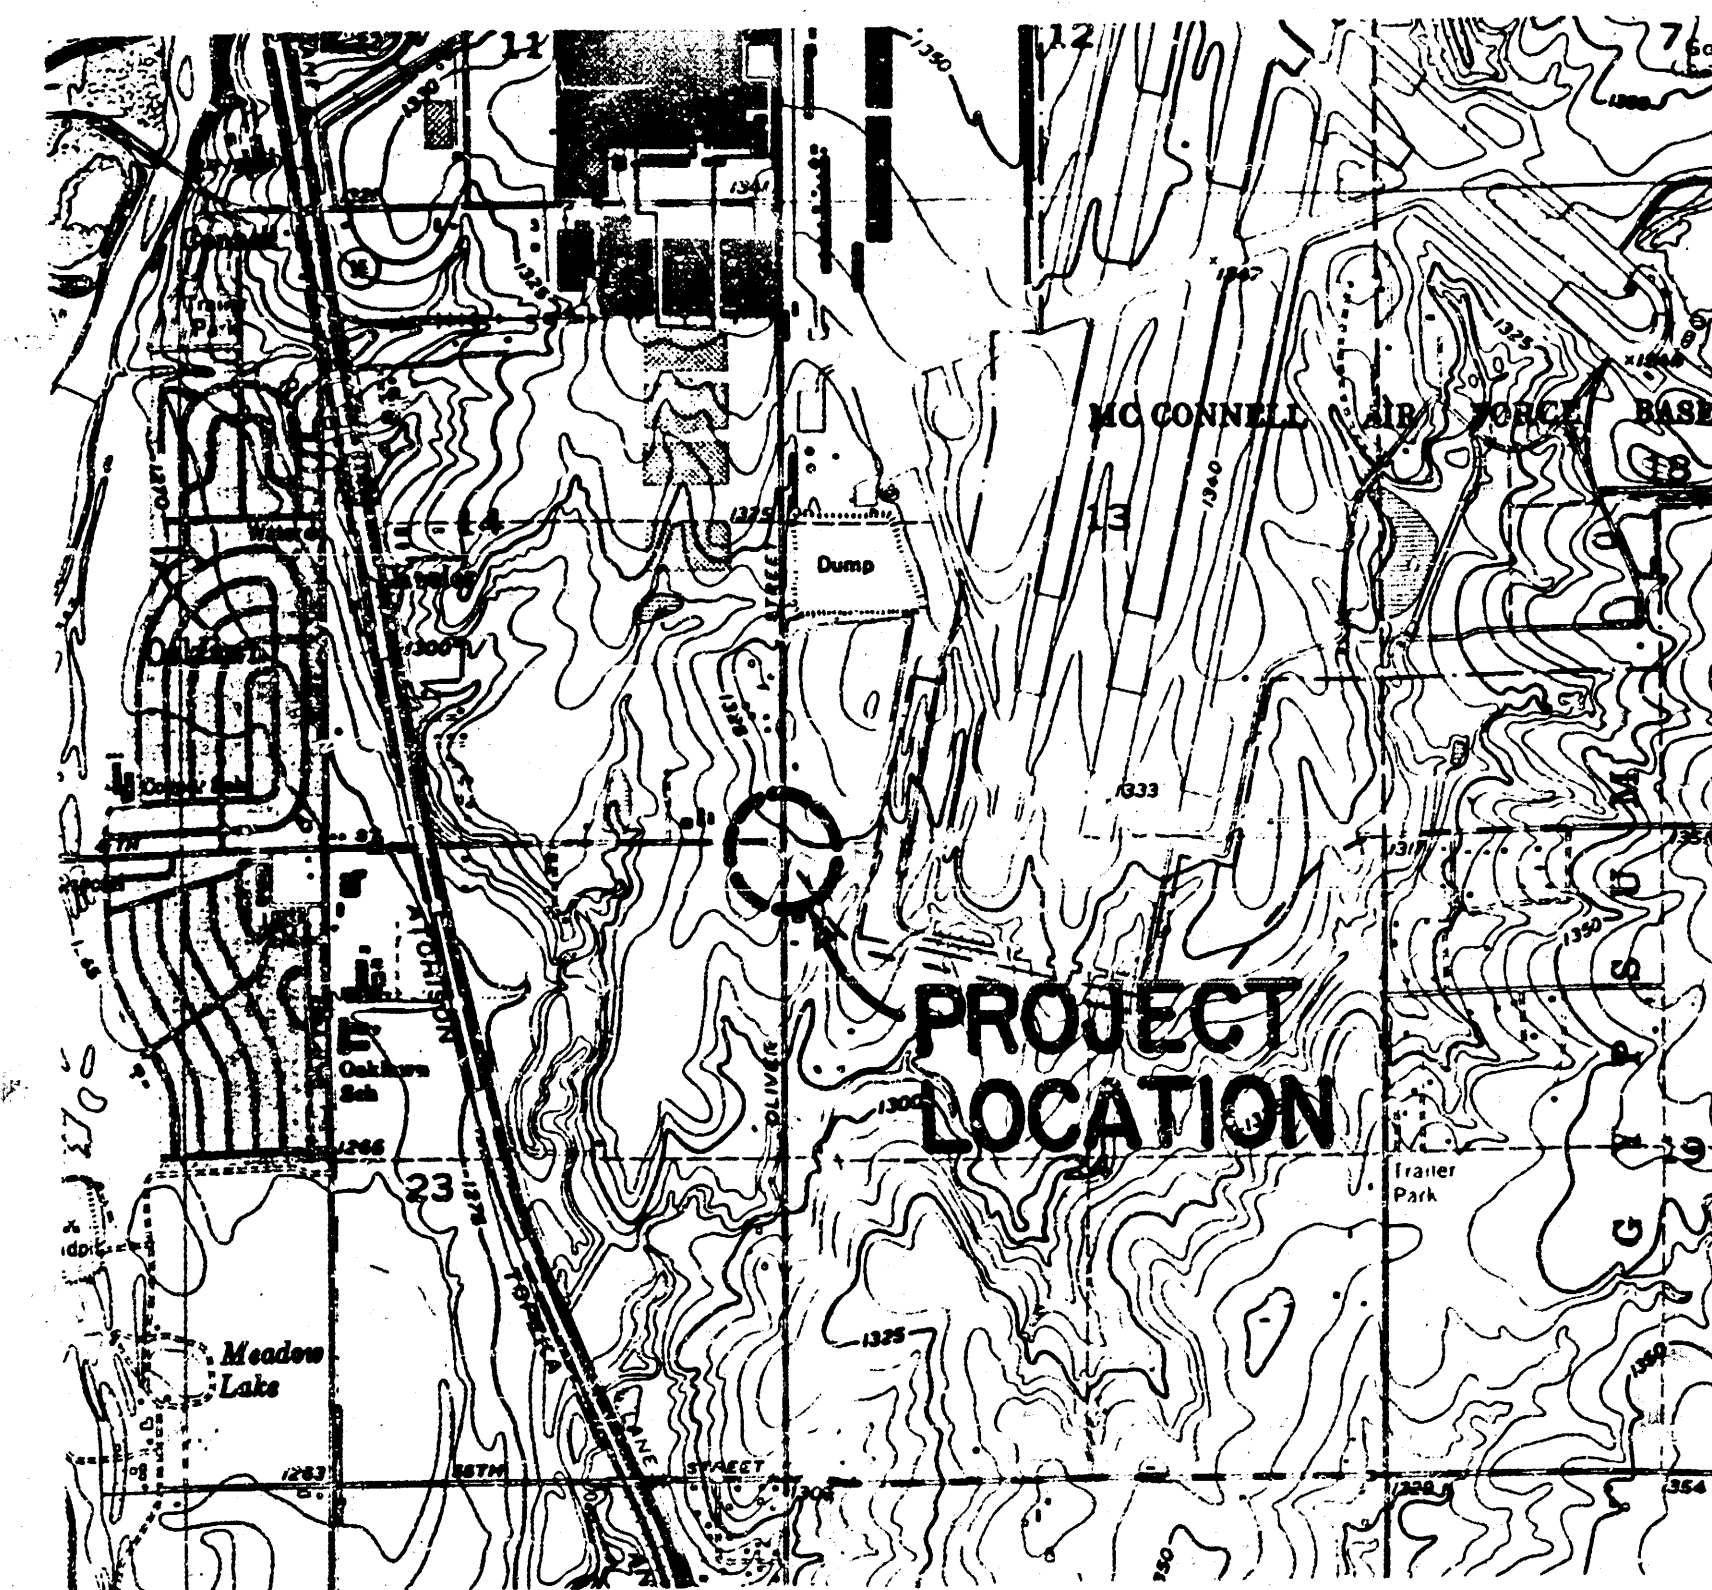

APPROVED AS NOTED
By CITY ENGINEER OF WICHITA
Sanitary Sewers 408 3/22/89
Storm Sewers _____
Driveway Approaches _____
Water Mains _____
Paving _____

NOTE TO CONTRACTOR
INSPECTION AND TESTING FOR THIS PROJECT IS TO BE PROVIDED BY A LICENSED CONSULTING ENGINEERING FIRM UNDER CONTRACT WITH THE OWNER/DEVELOPER. SAID INSPECTION SHALL BE IN ACCORDANCE WITH THE CITY OF WICHITA STANDARD CONSTRUCTION ENGINEERING PRACTICES AND CERTIFIED BY A LICENSED PROFESSIONAL ENGINEER. NO WORK SHALL BE PERFORMED IN DEDICATED EASEMENTS OR THE PUBLIC RIGHT-OF-WAY BY THE CONTRACTOR WITHOUT SUCH INSPECTION. NO SHALL ANY WORK BE CONSIDERED IN DEDICATED EASEMENTS OR PUBLIC RIGHT-OF-WAY WITHOUT WRITTEN AUTHORIZATION BY THE CITY ENGINEER.

Booked
RDL

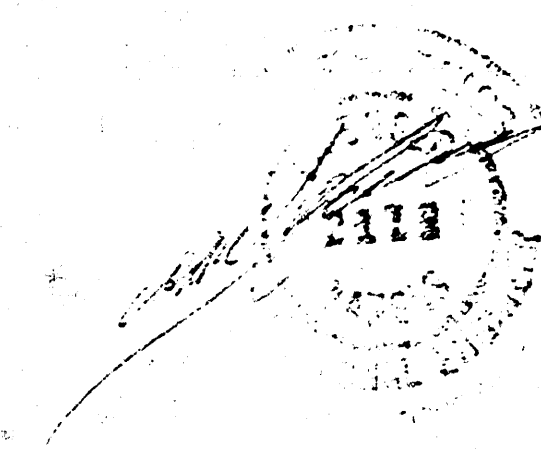

DEISS & GOODNESS ENGINEERS
2100 WEST 21ST STREET
WICHITA, KANSAS 67203
(910) 832-0218


REVISION	DRAWN BY	CHECKED BY	DESIGNED BY	PROJECT

CUSTOMER


SCALE
DATE
PROJECT NO.
SHEET 1 OF 3

FILMED FROM THE BEST
AVAILABLE COPY

BM=TOP RING MH 0+00 = 10+11
CHELSEA INDUSTRIAL PARK
ELEV. 1316.84

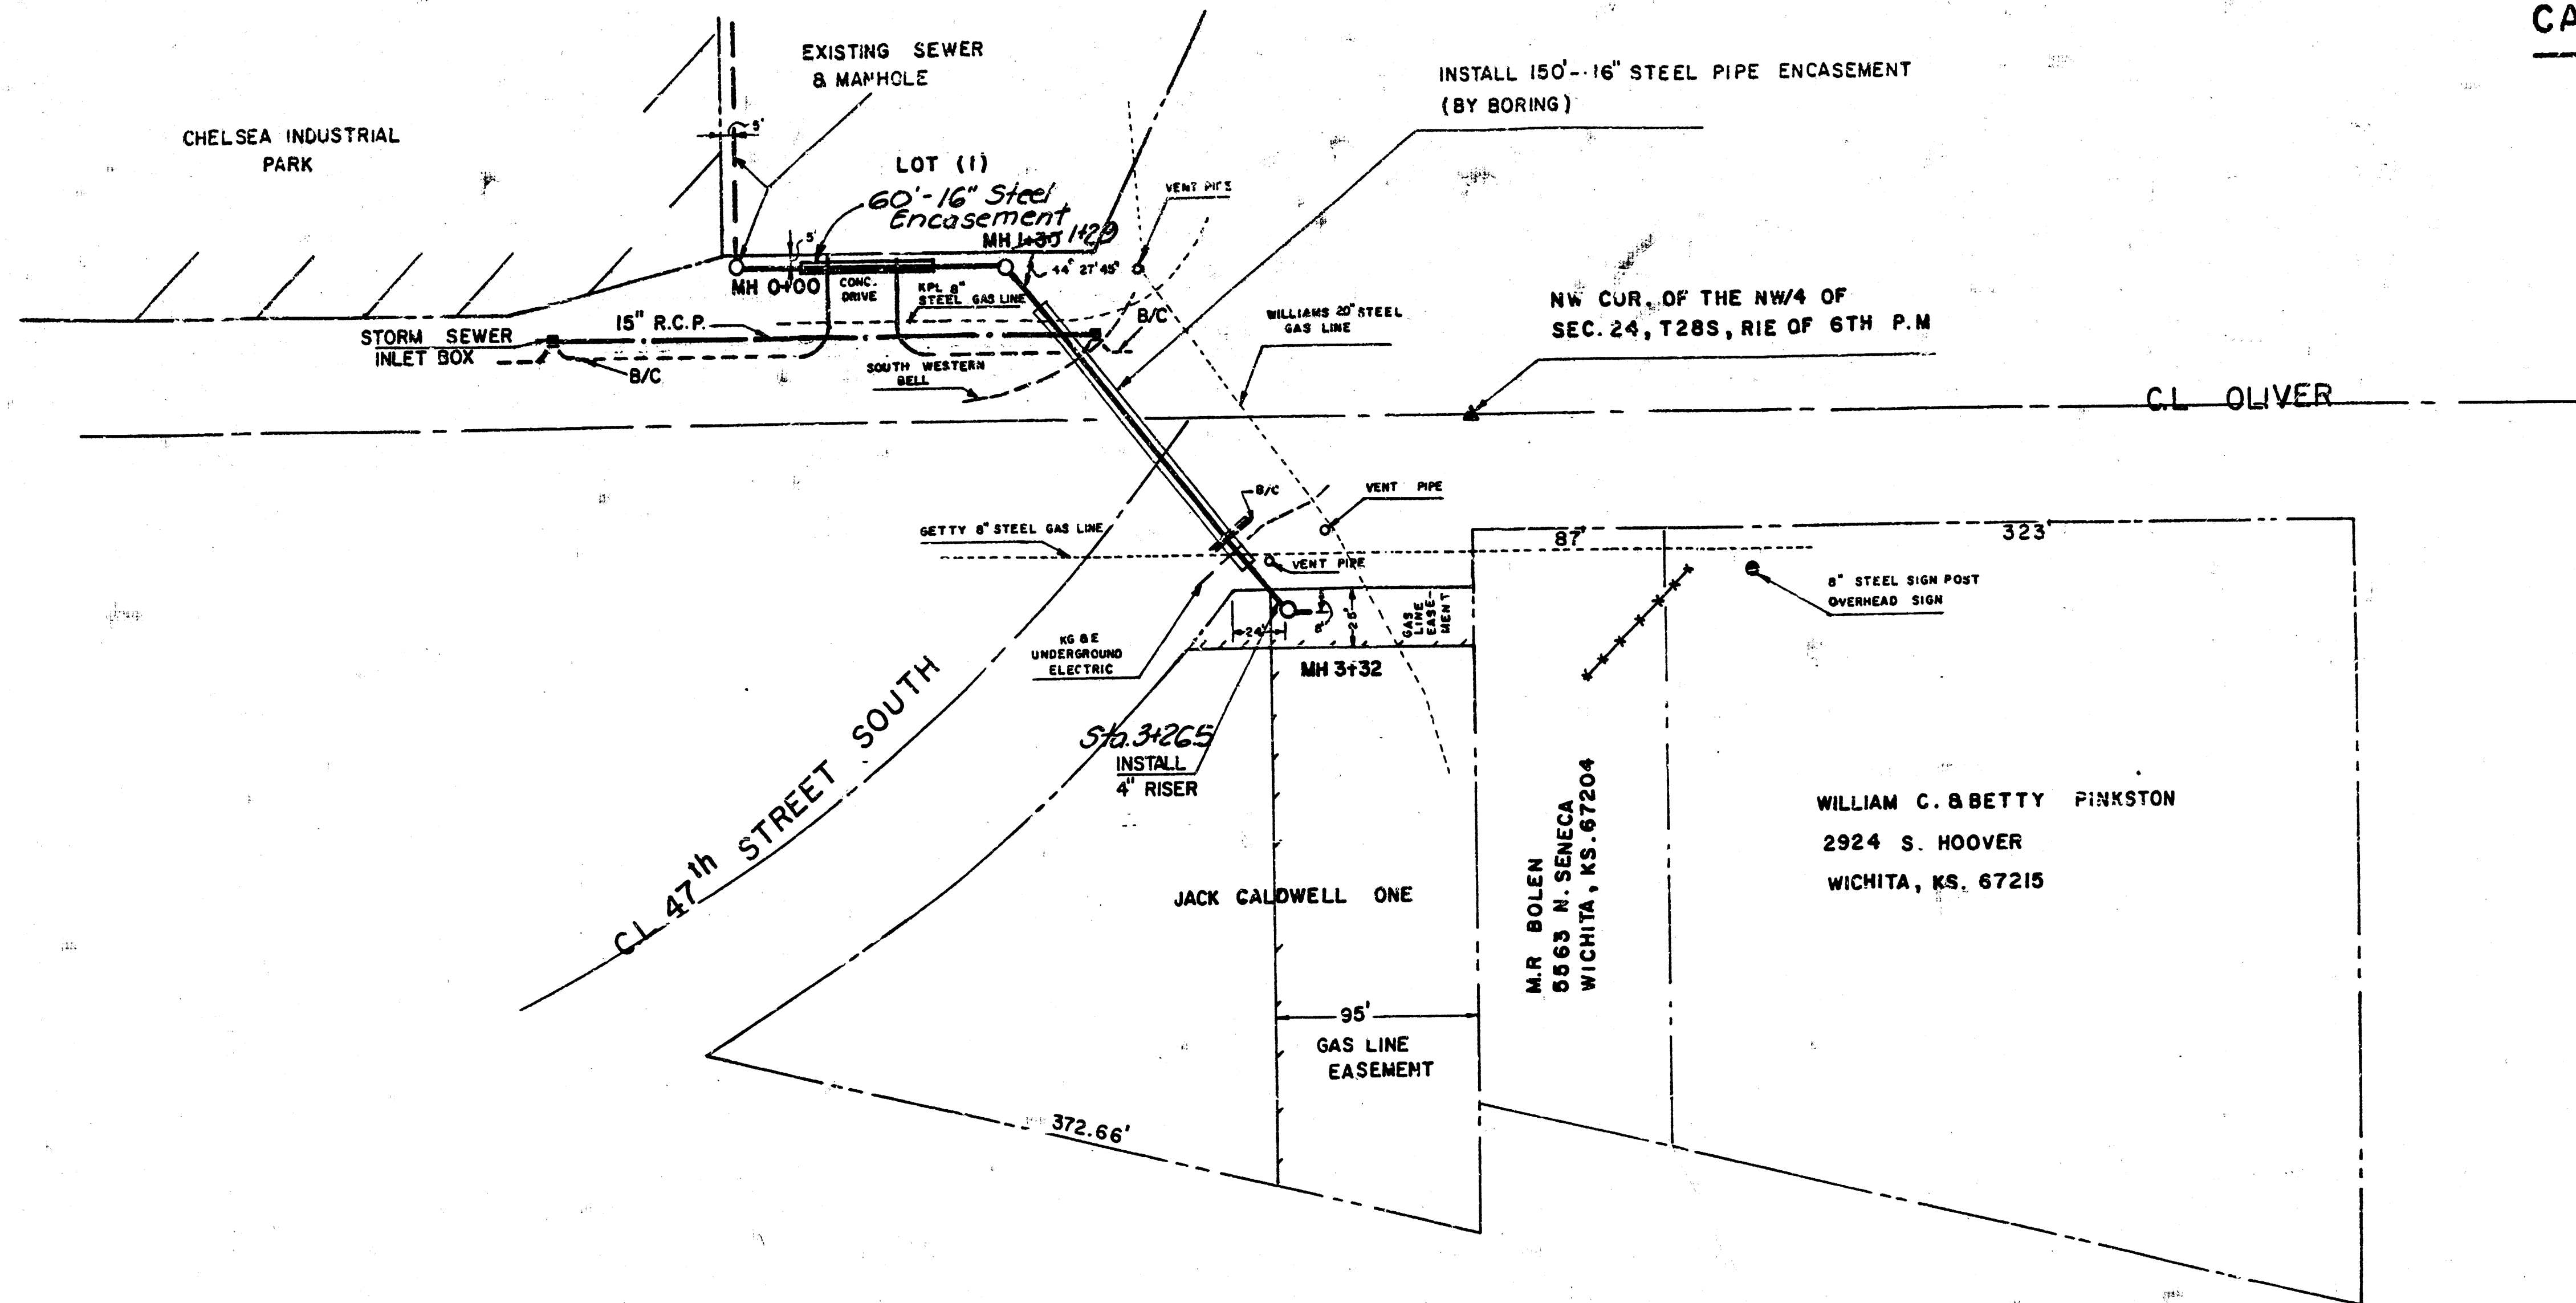

(ALL PIPE IS 8", ALL MANHOLES ARE PRECAST)

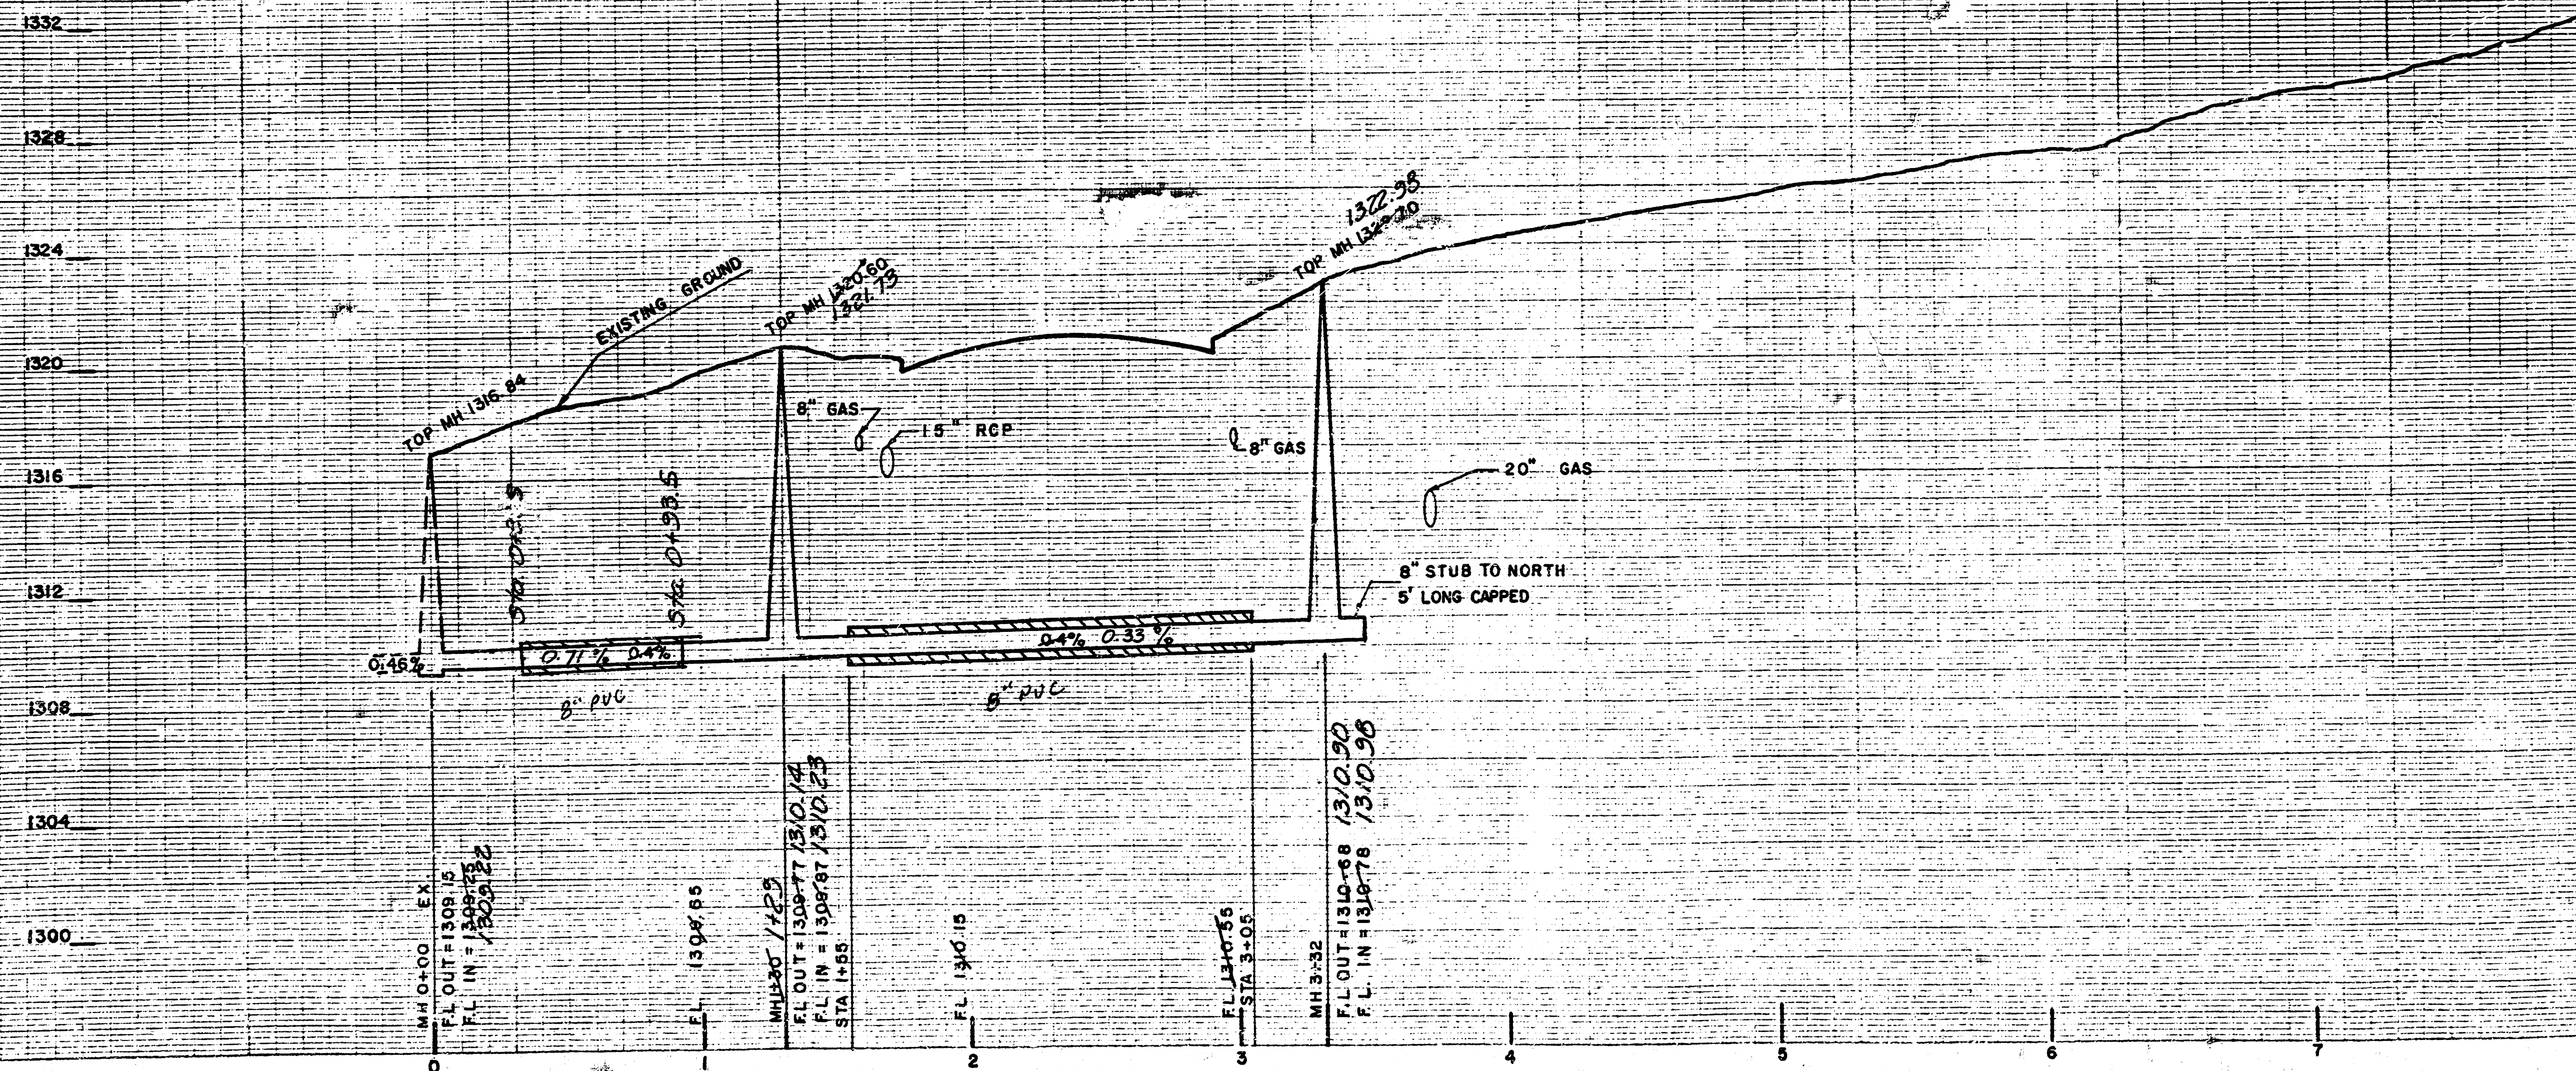

"AS CONSTRUCTED"

REISS & GOODNESS ENGINEERS
2100 WEST 21ST STREET
WICHITA, KANSAS 67204
(316) 832-0213

REVISION	DRAWN BY	CHECKED BY	DESIGNED BY	PROJECT	CUSTOMER	SCALE	PROJECT NO.
				SANITARY SEWER EXTENTION	JACK CALDWELL ONE	DATE	SHEET 2 OF 3

FILMED FROM THE BEST
AVAILABLE COPY....