



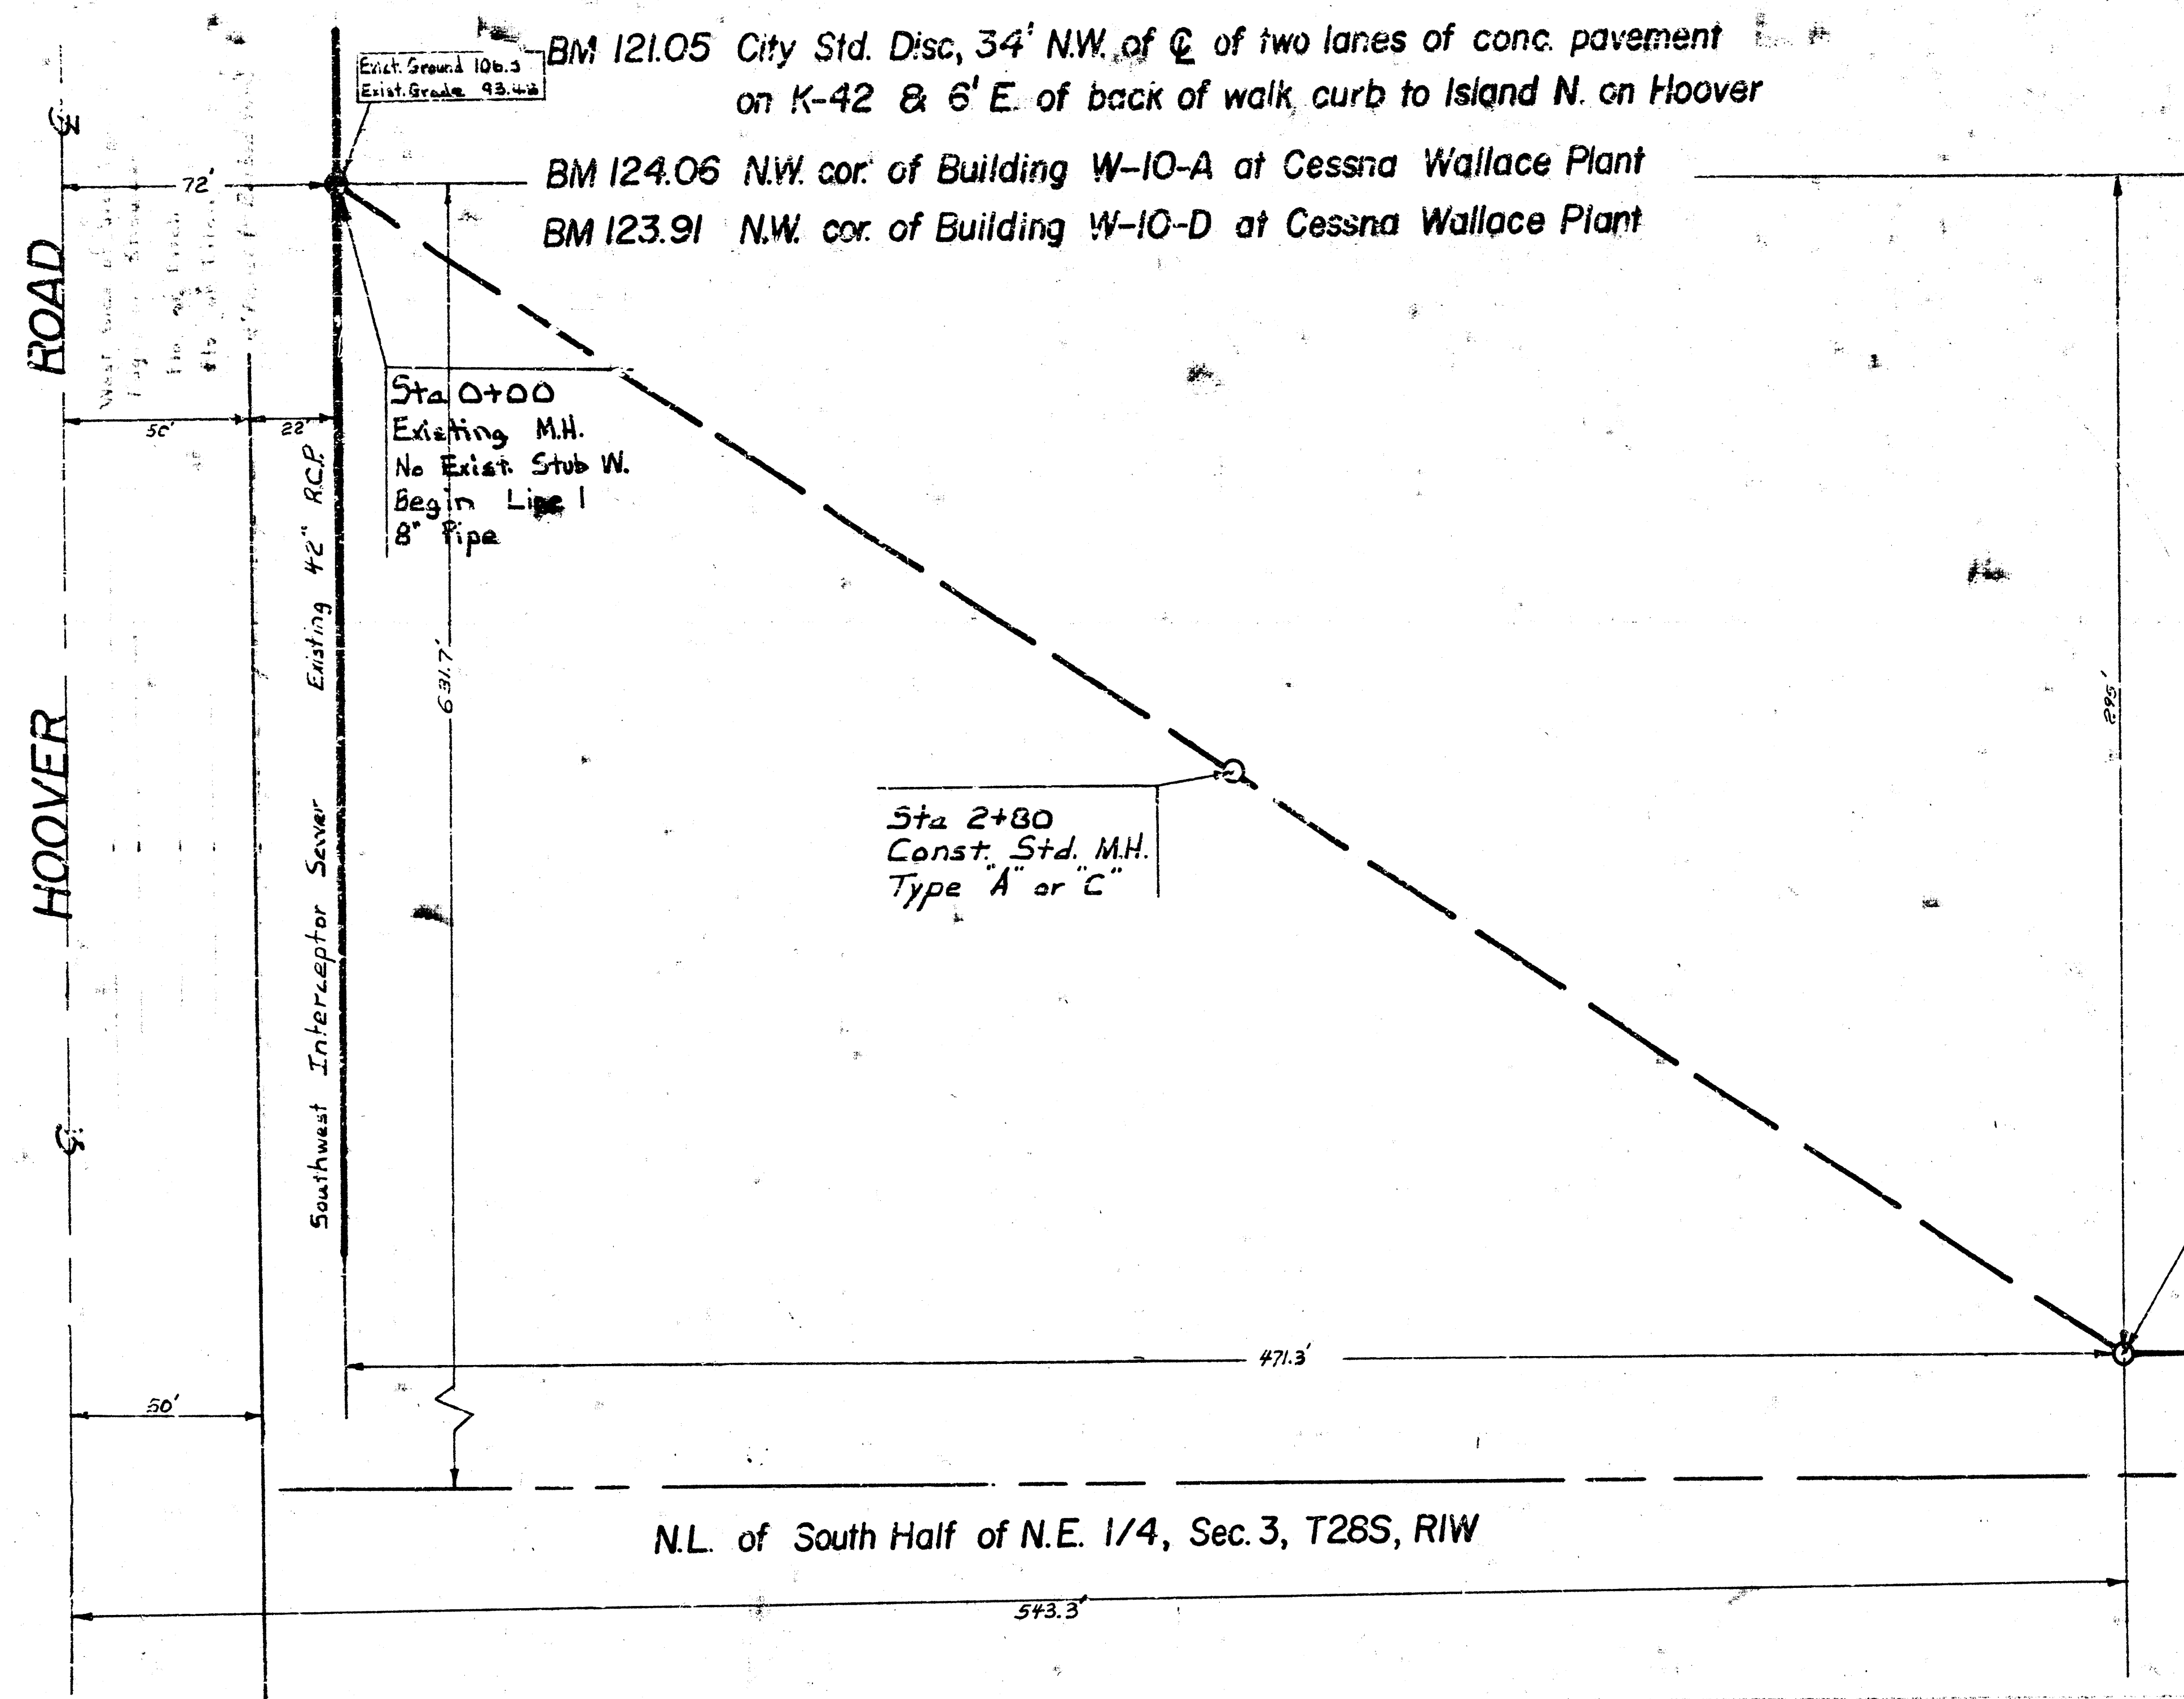




Plan Scale 1" = 40'



Profile Scale 1" = 40' Hor.
1" = 5' Vert.

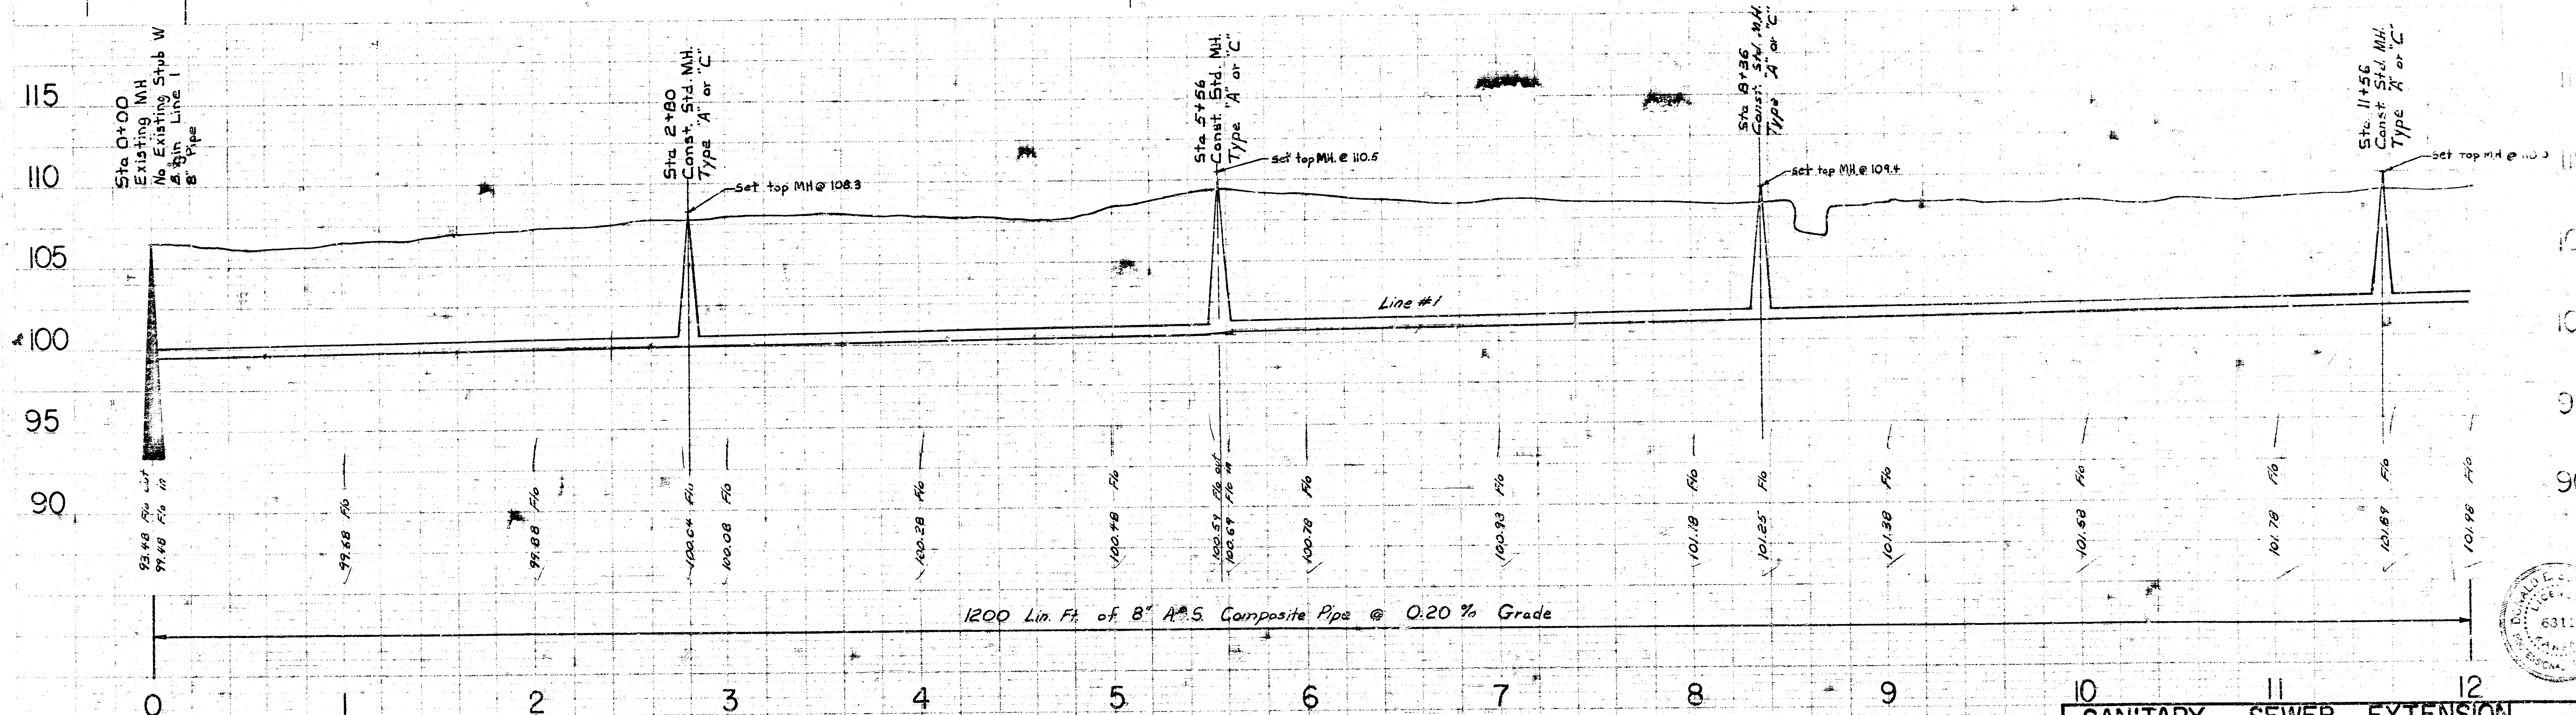



SANITARY SEWER EXTENSION
CESSNA WALLACE PLANT
 West of Hoover Rd. & North of K-42 Highway
 CITY OF WICHITA, KANSAS
 R. W. LINN — CITY ENGINEER
 Private Project No. DBKW706053

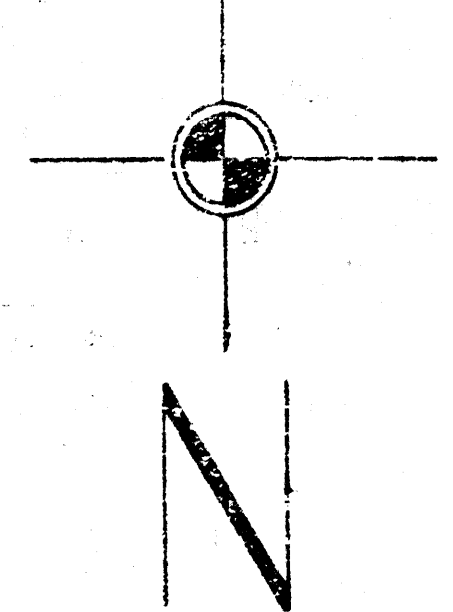

 Plan Scale 1" = 40'
 Profile Scale 1" = 40' Hor.
 1" = 5' Vert.

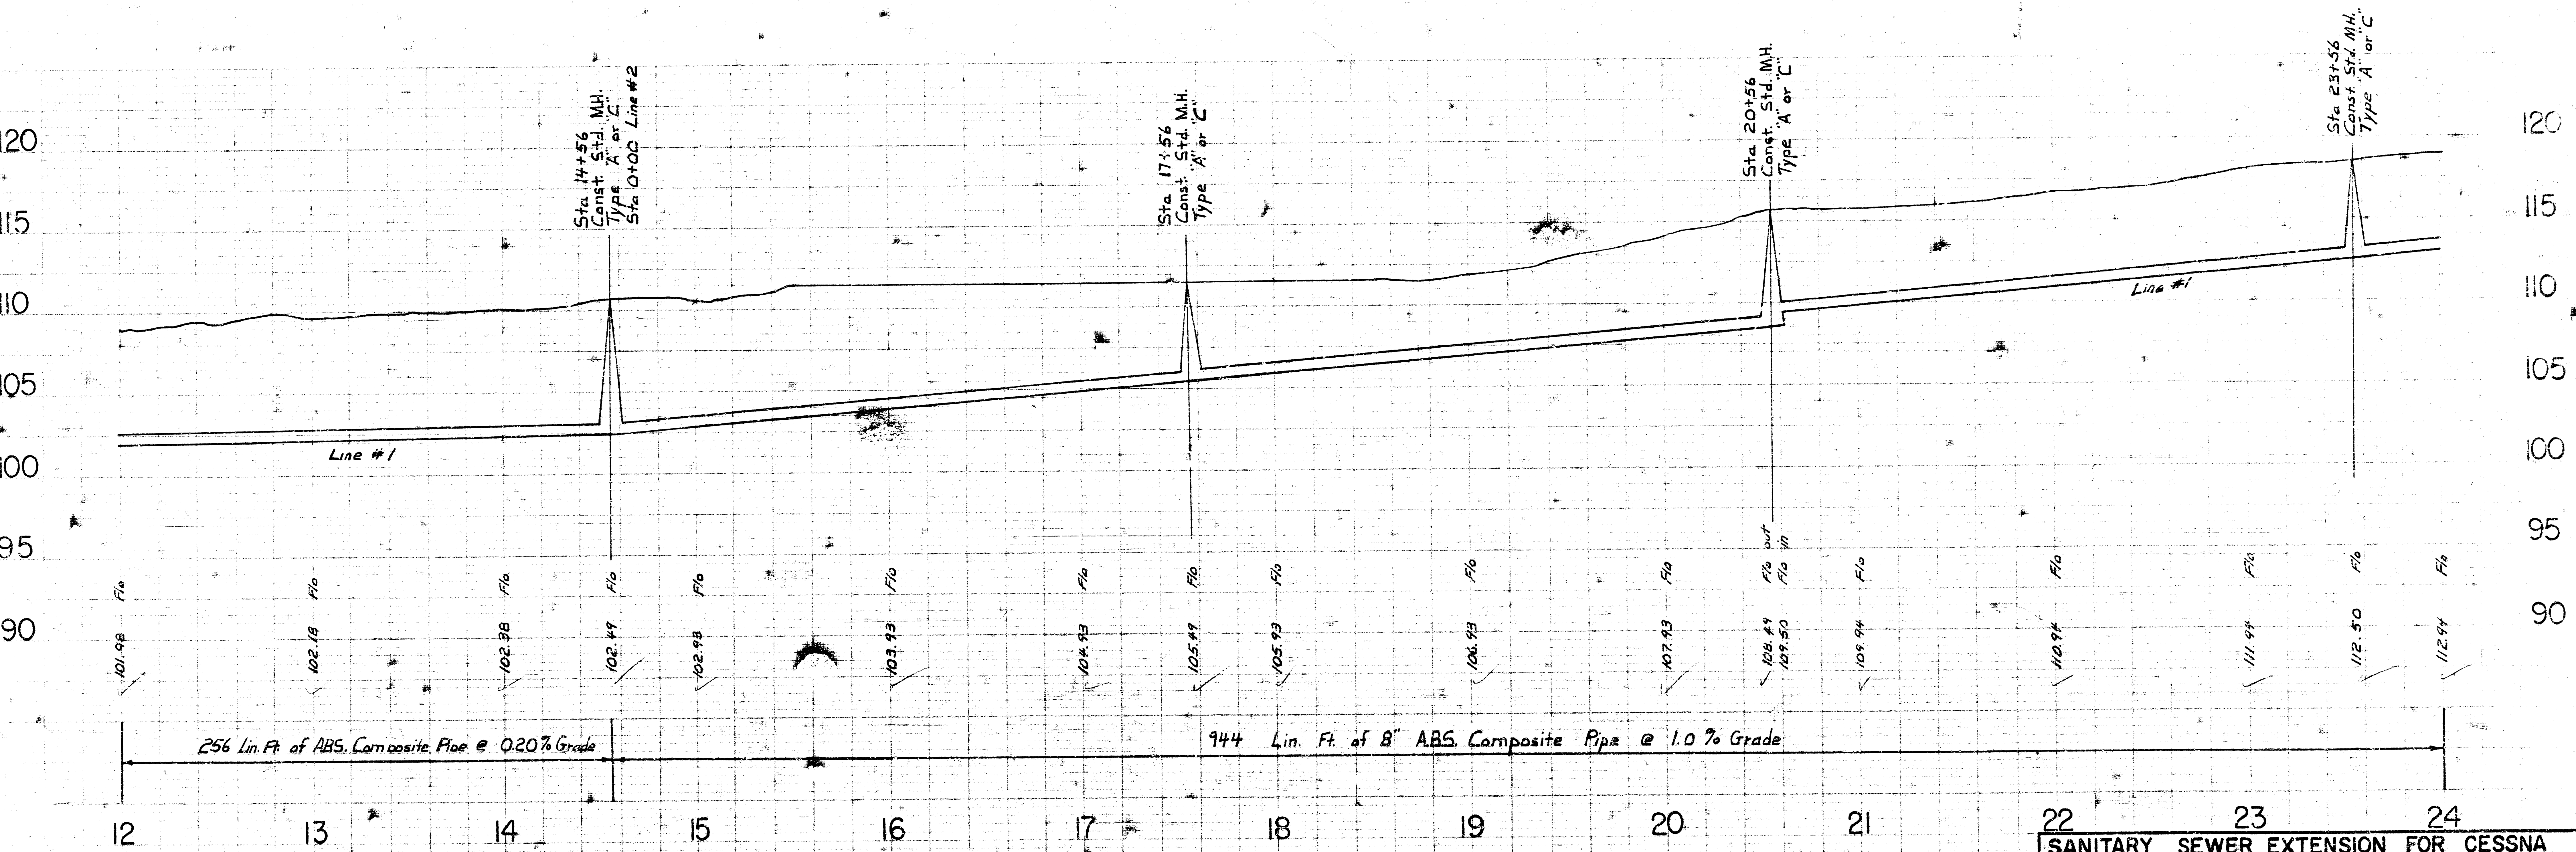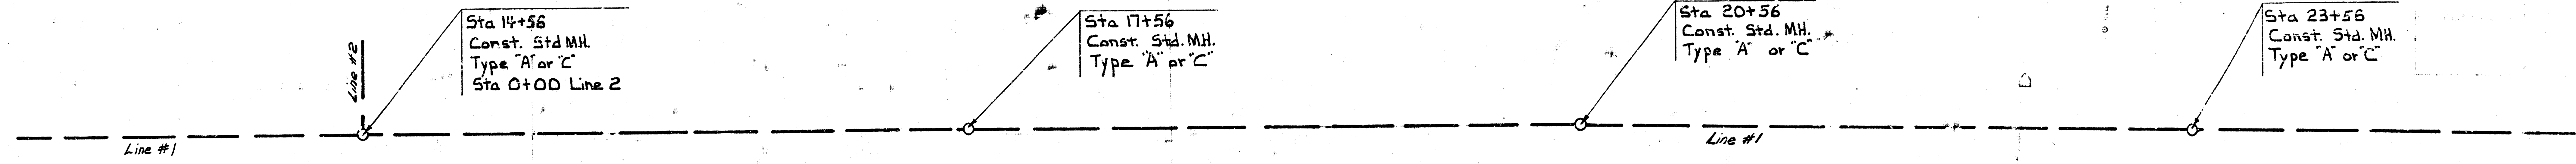

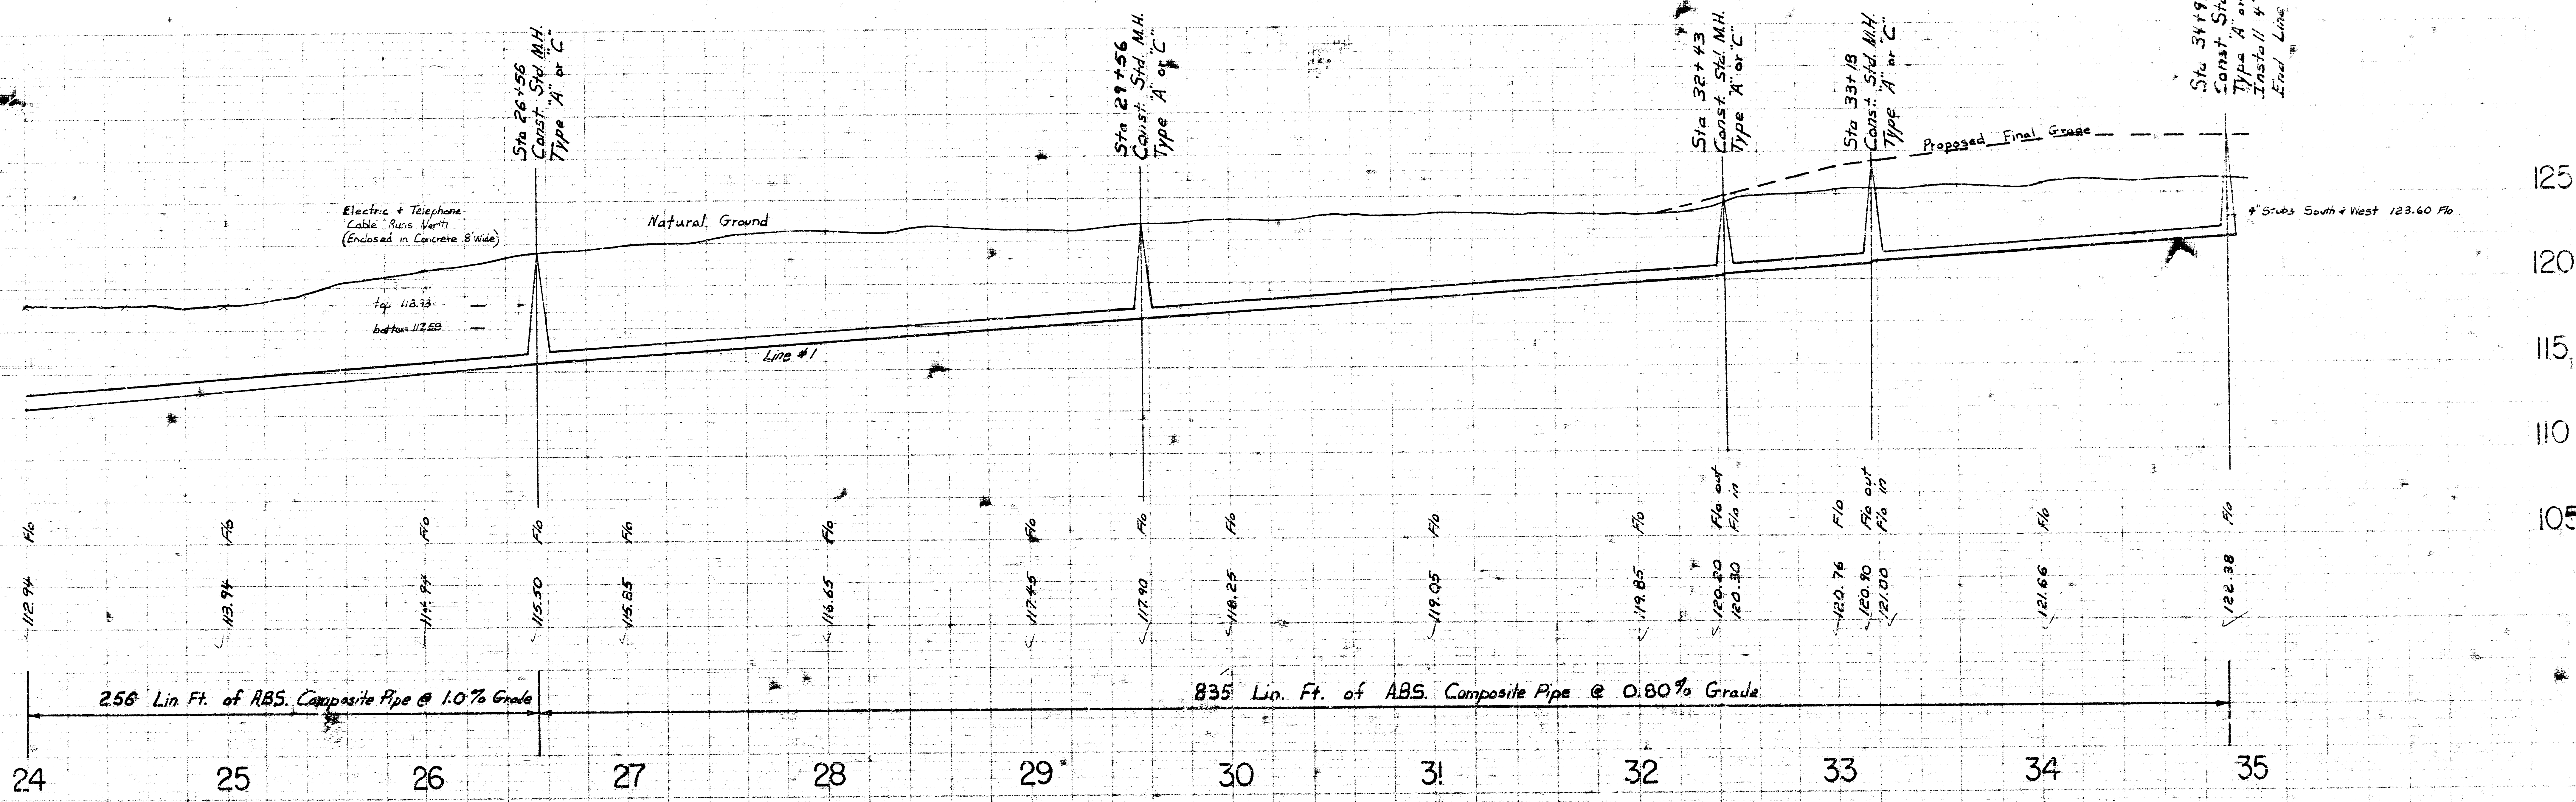
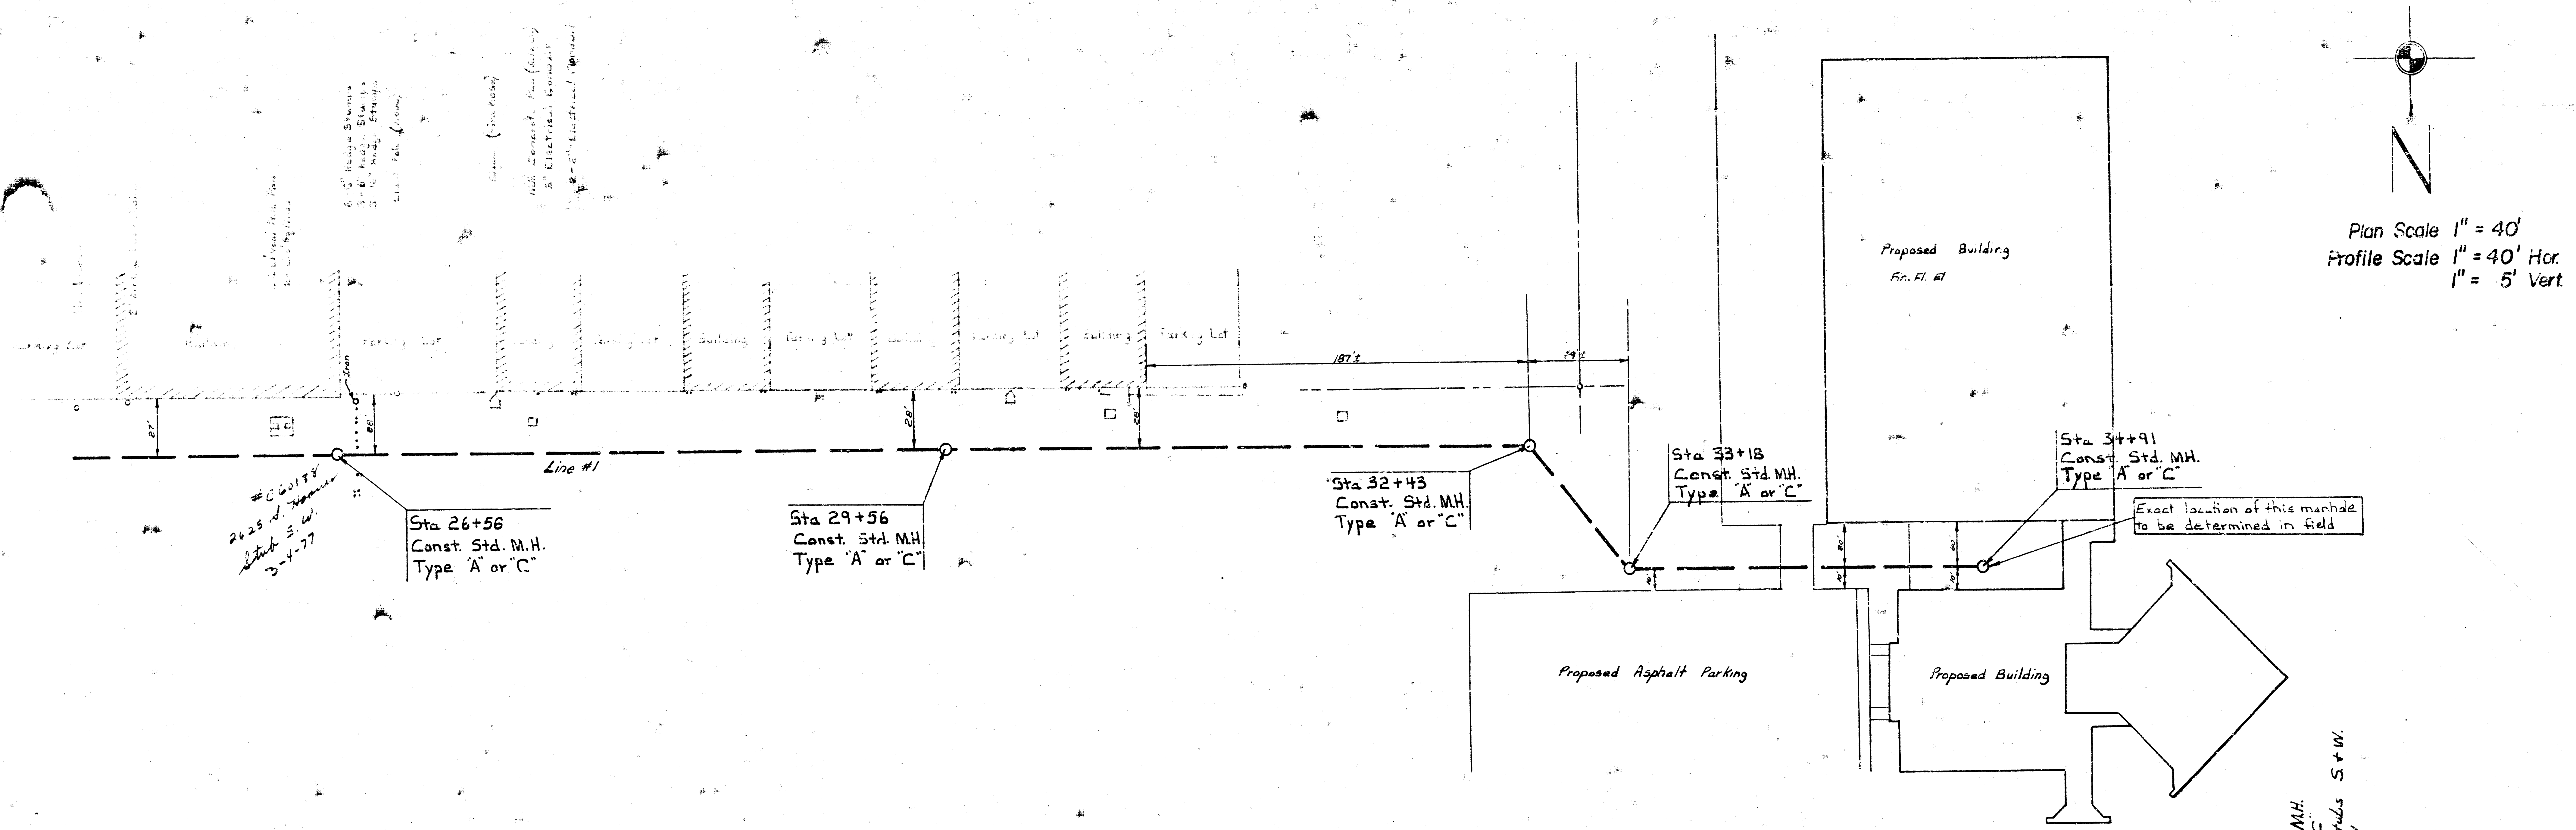


N
 Plan Scale 1" = 40'
 Profile Scale 1" = 40' Hor.
 1" = 5' Vert.

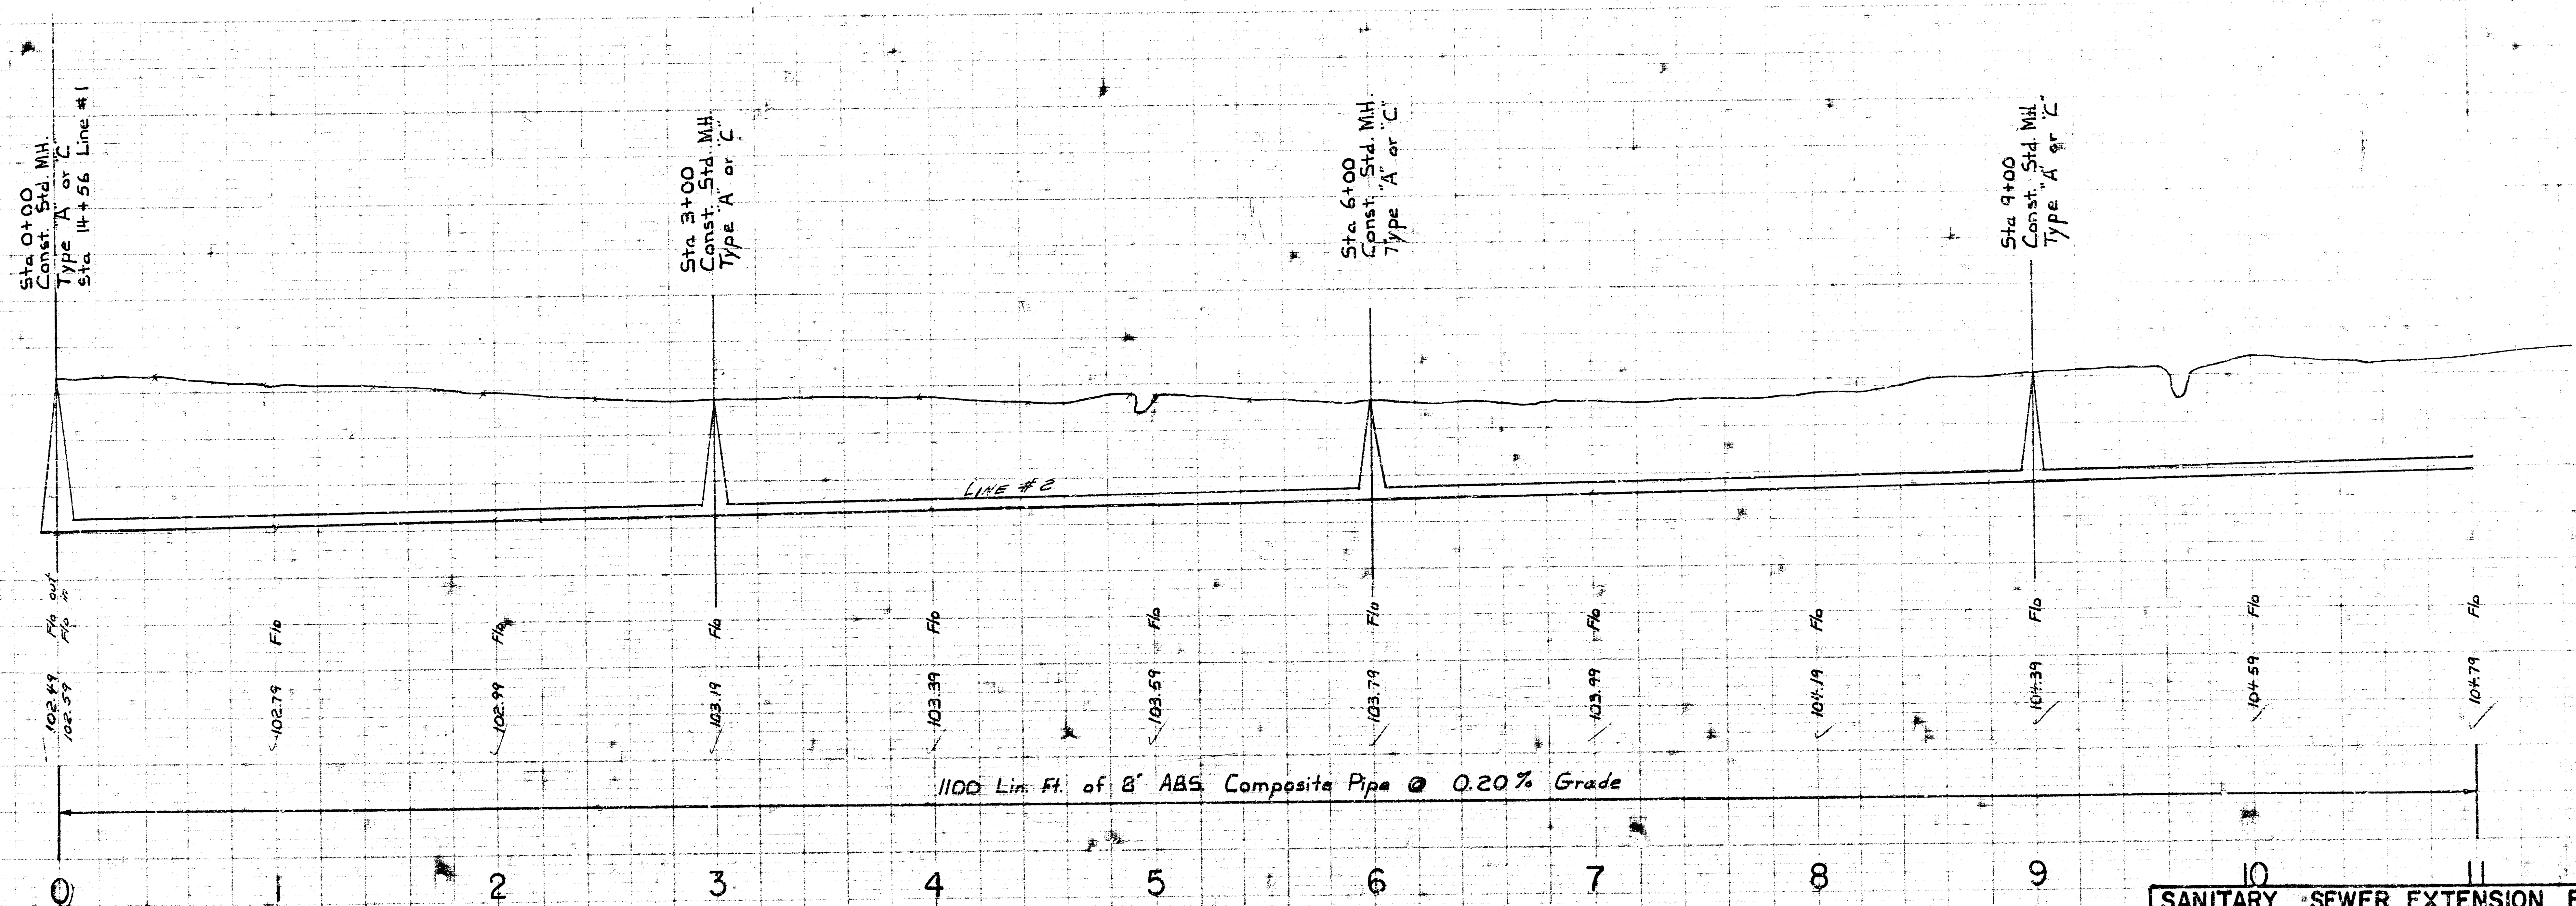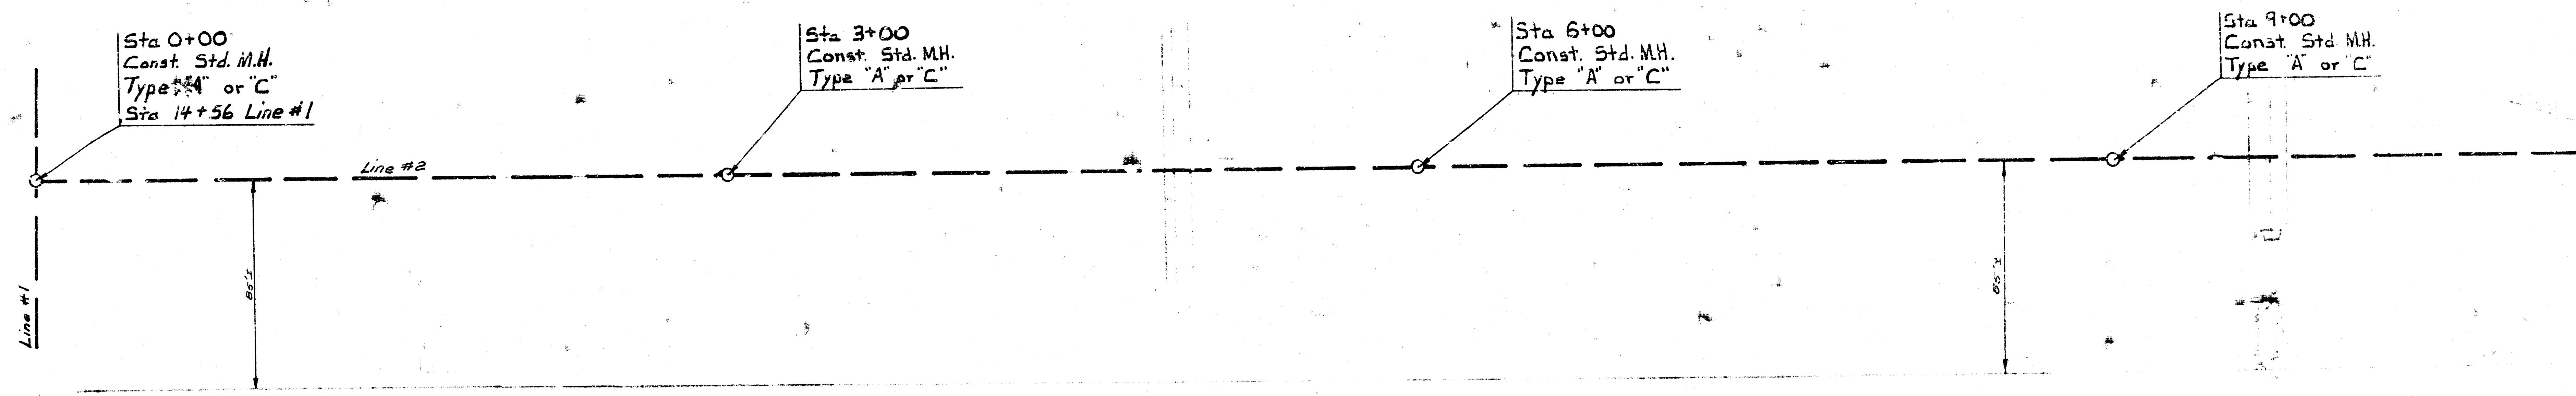

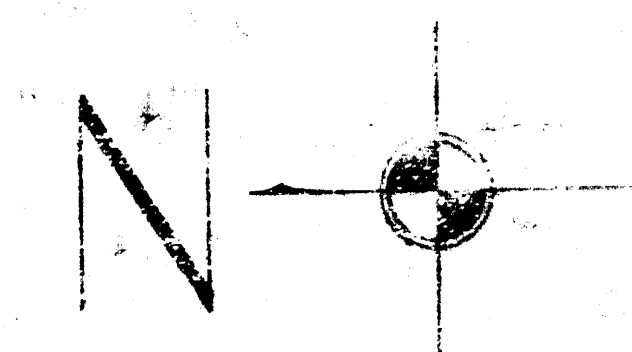



Plan Scale 1" = 40'
Profile Scale 1" = 40' hor
1" = 5' vert

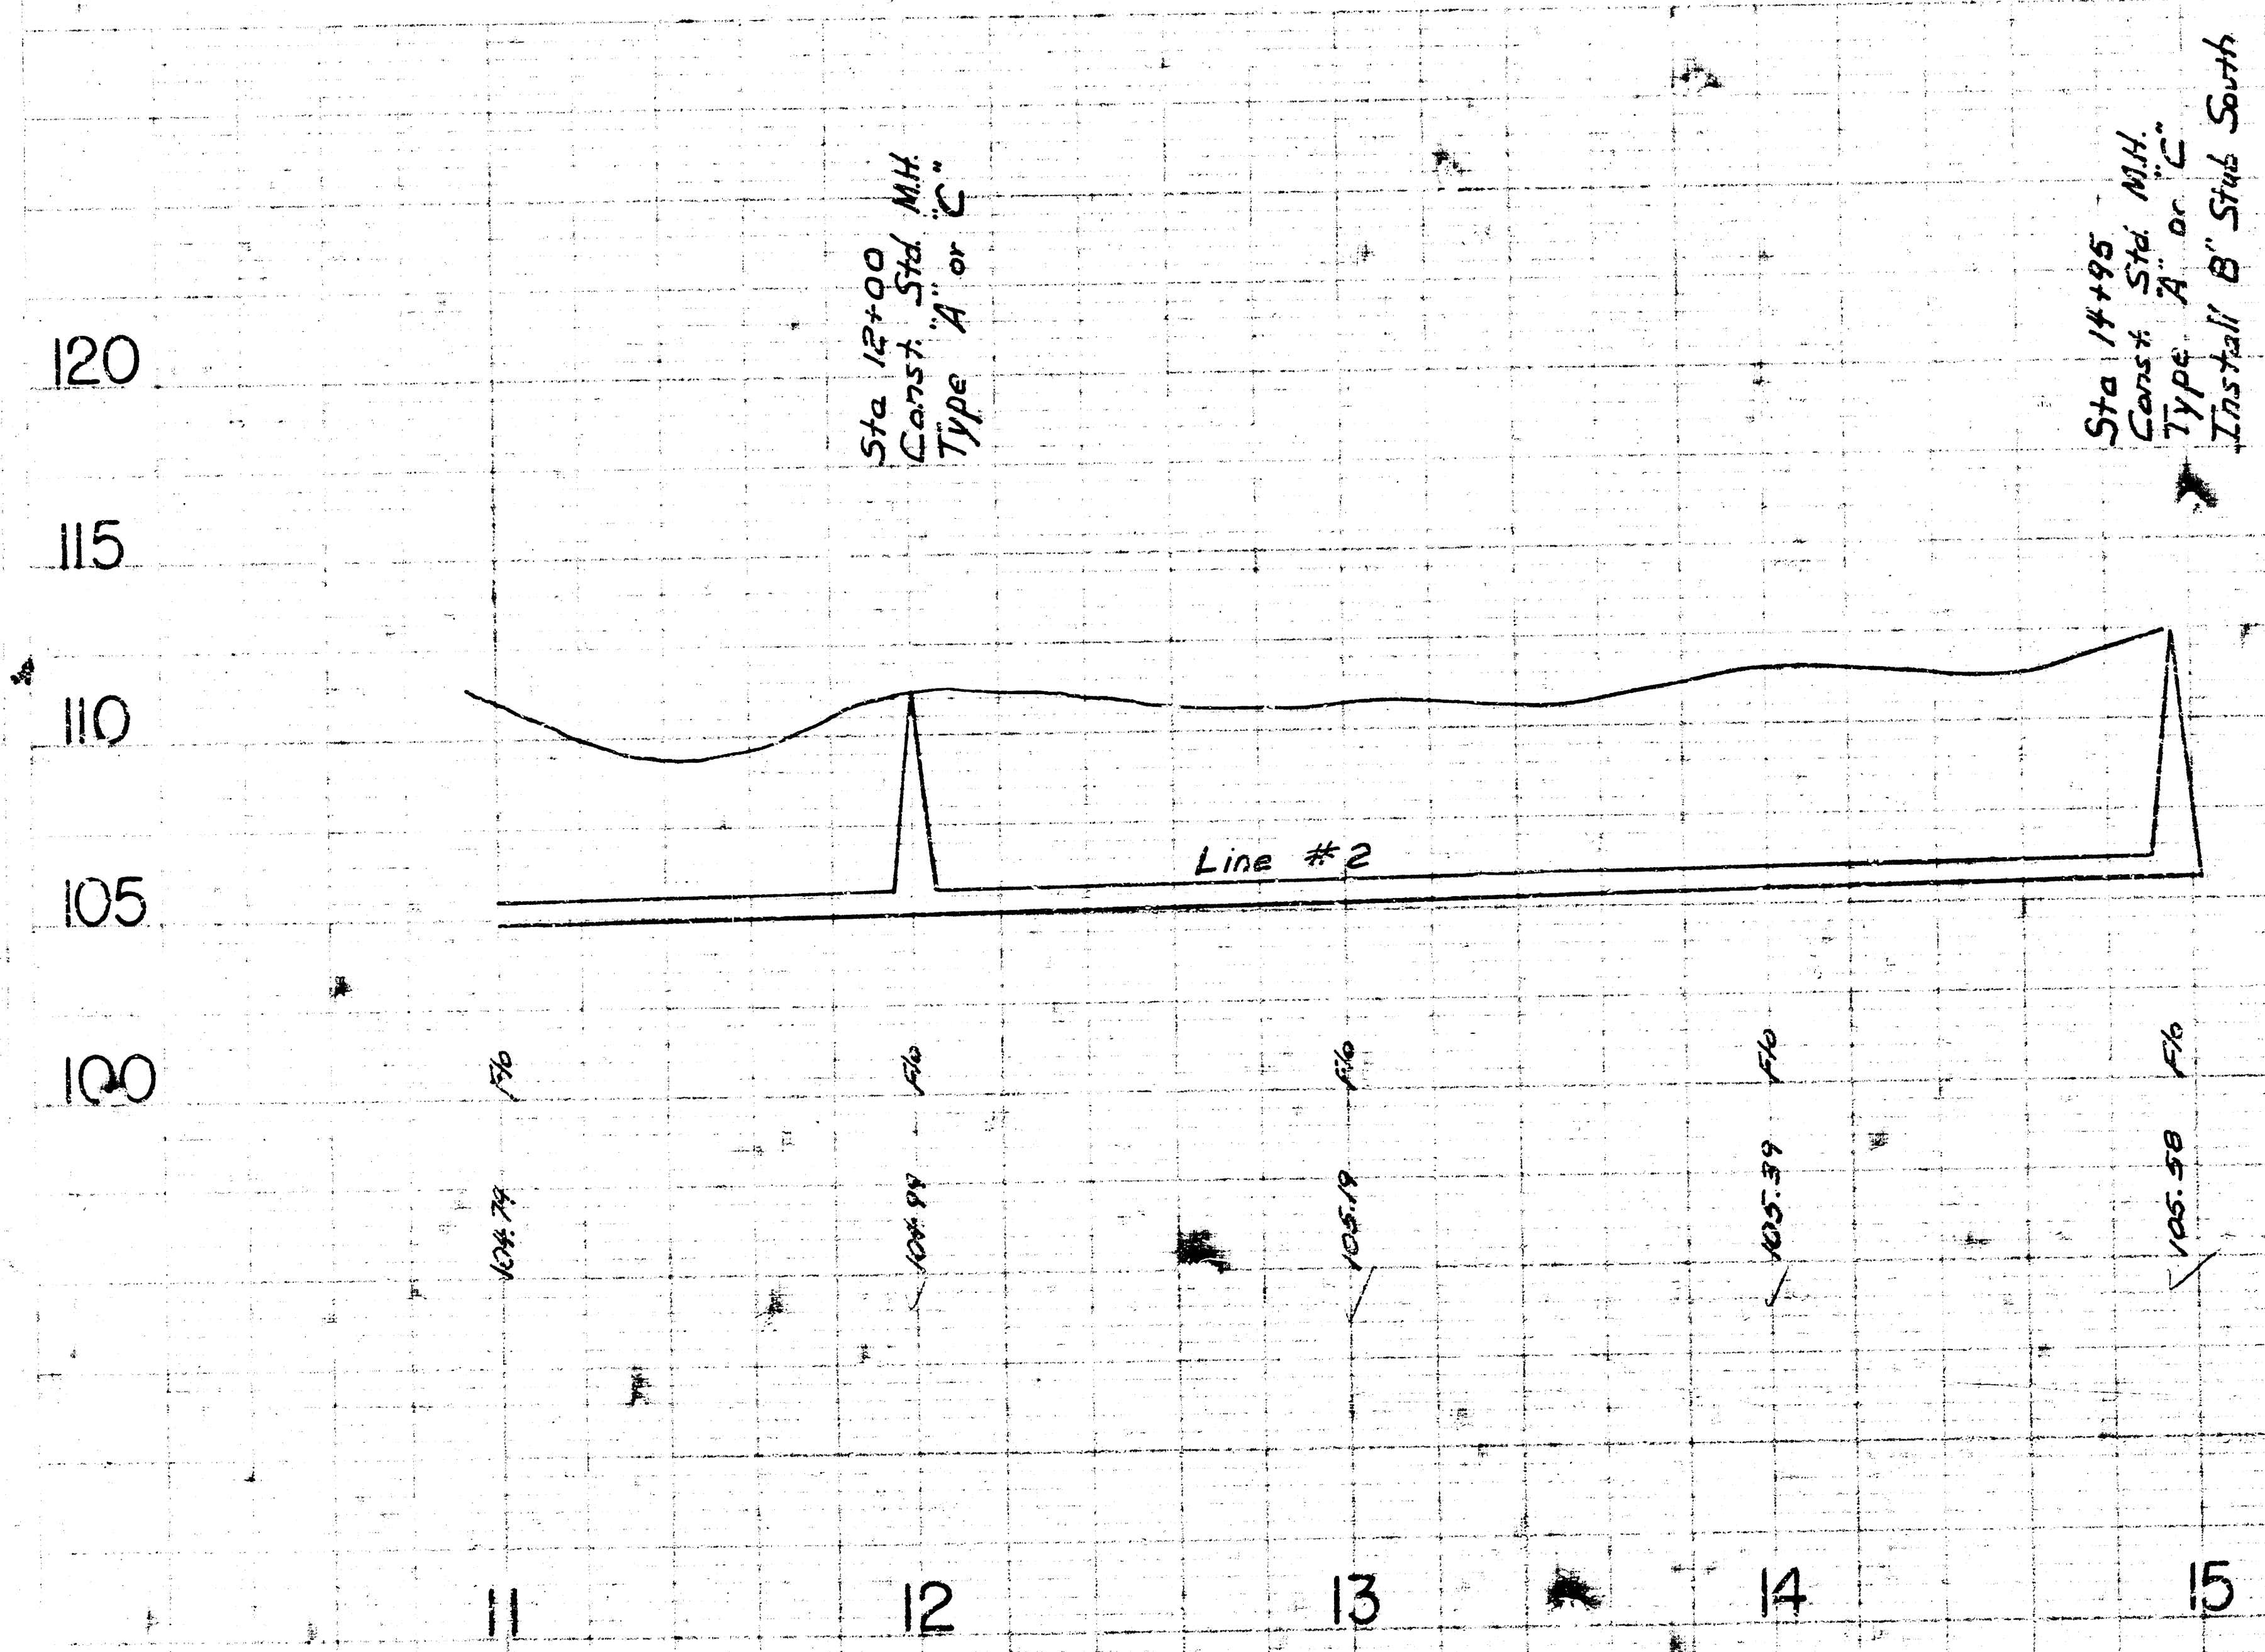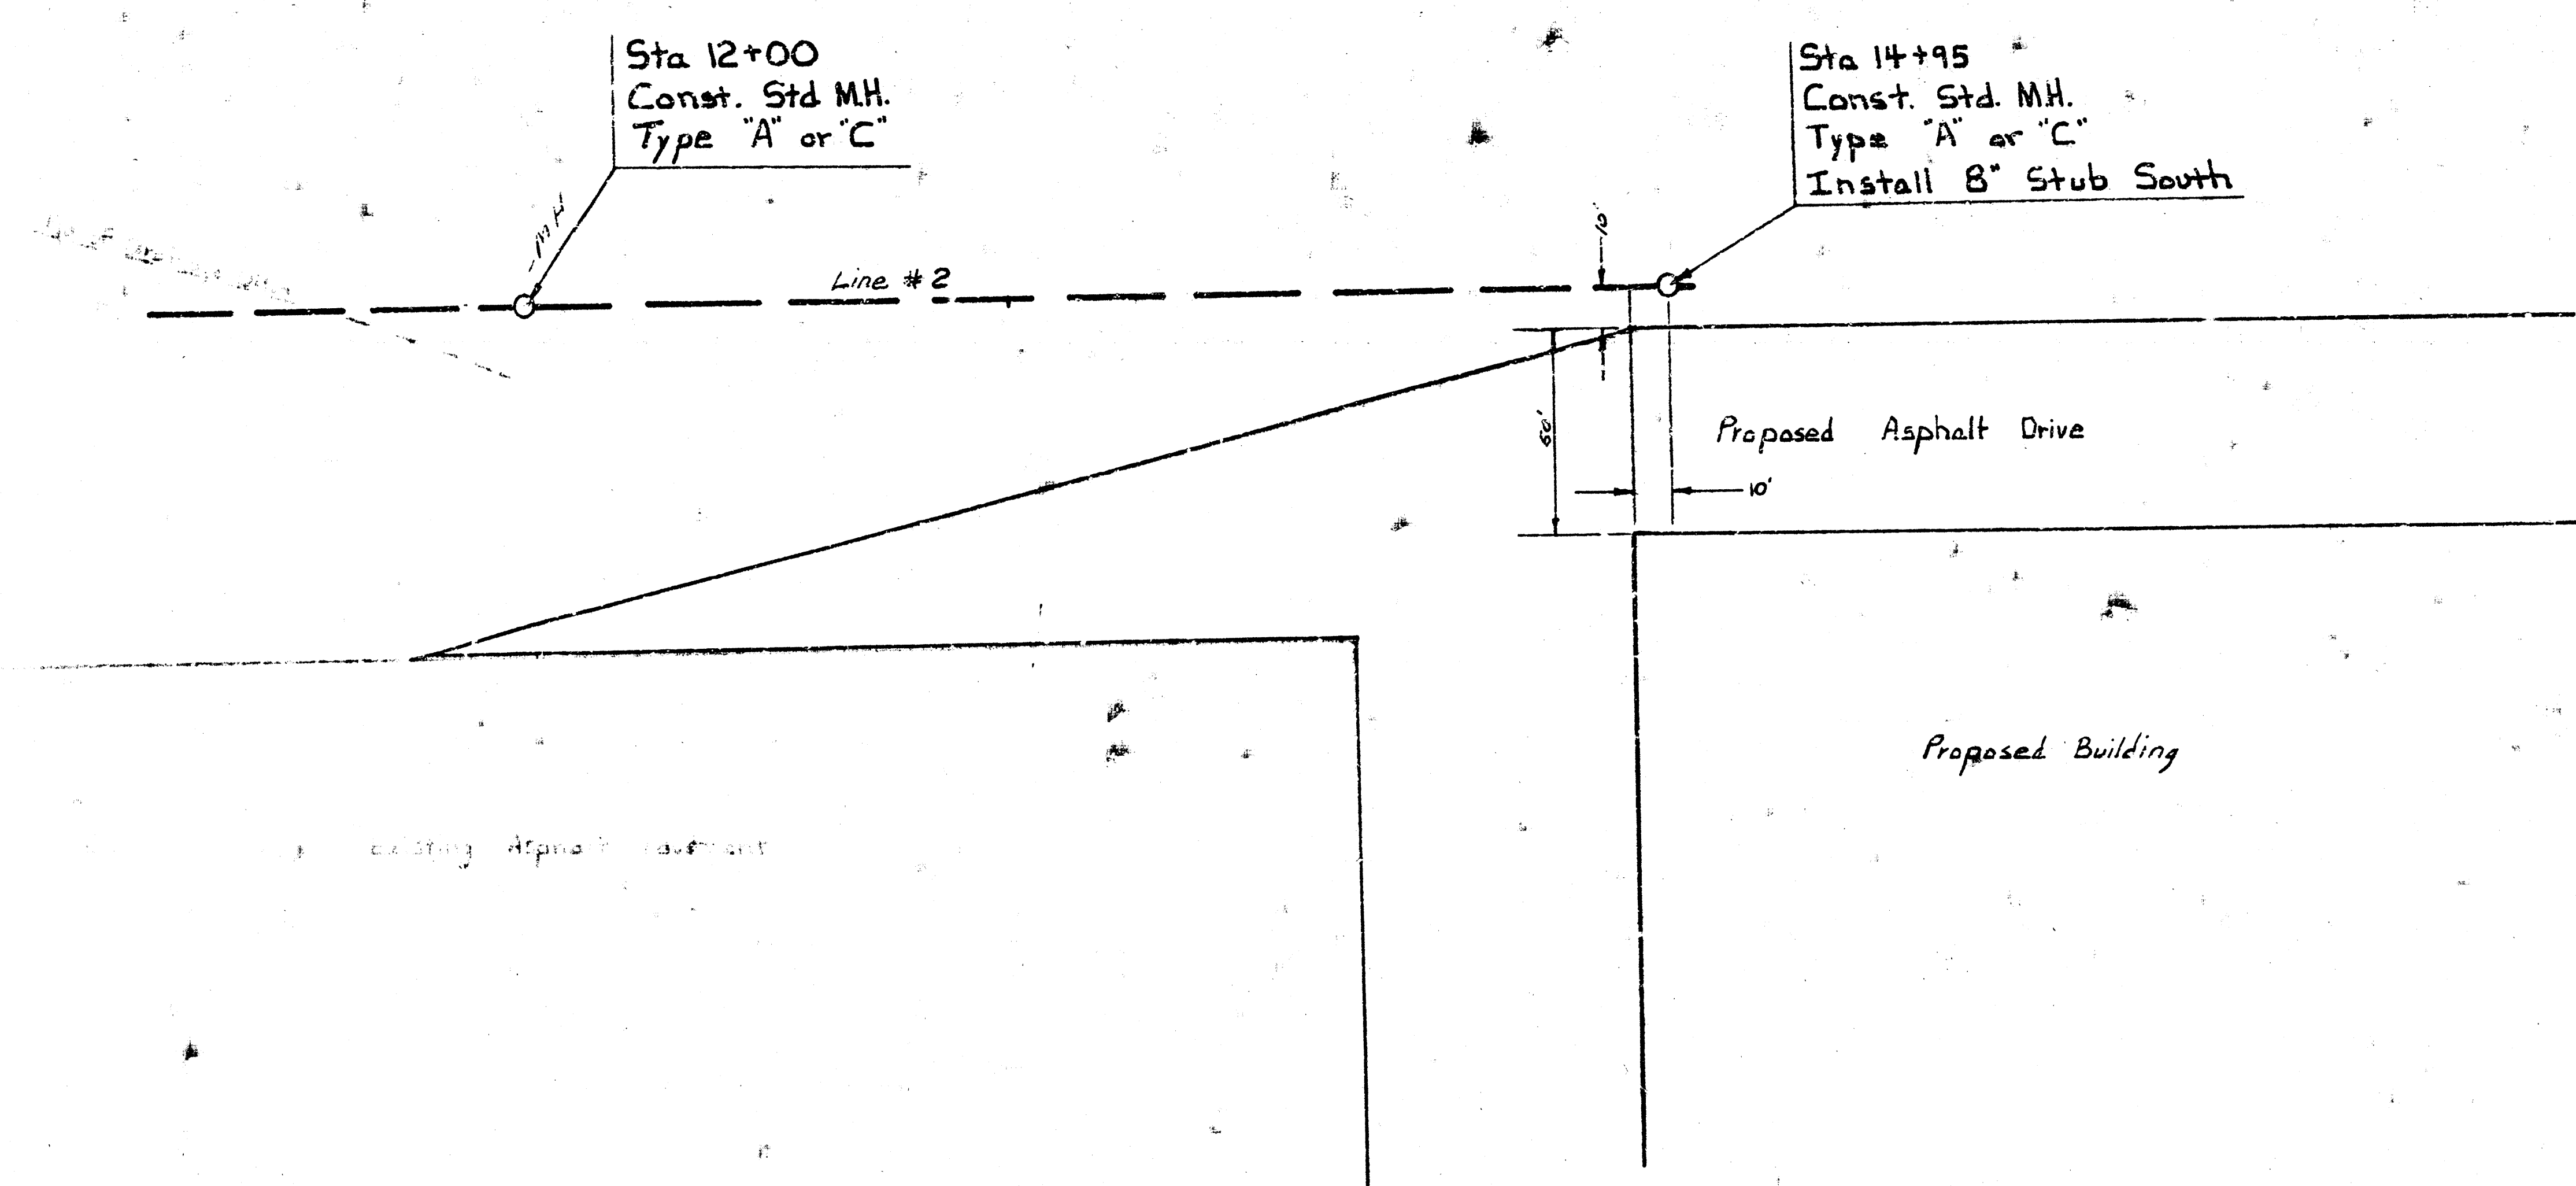


**EXTENSION FOR CESSNA
SANITARY SEWER**
West of Howe Rd. & North of 14th St.
CITY OF WICHITA, KANSAS
R. W. LINN - CITY ENGINEER
Private Project No. 141-11-1

NOTE TO CONTRACTOR
The sewer line to be installed under the driveway shall be 12" diameter and shall be installed at a depth of 48" below finished ground. The sewer line shall be installed in a trench 24" wide and shall be backfilled with 12" of compacted gravel. The trench shall be 12' long and shall be located 12' from the driveway. The sewer line shall be installed in a trench 24" wide and shall be backfilled with 12" of compacted gravel. The trench shall be 12' long and shall be located 12' from the driveway.

APPROVED AS NOTED
BY CITY ENGINEER OF WICHITA
S. J. J. J.
S. J. J. J.
S. J. J. J.

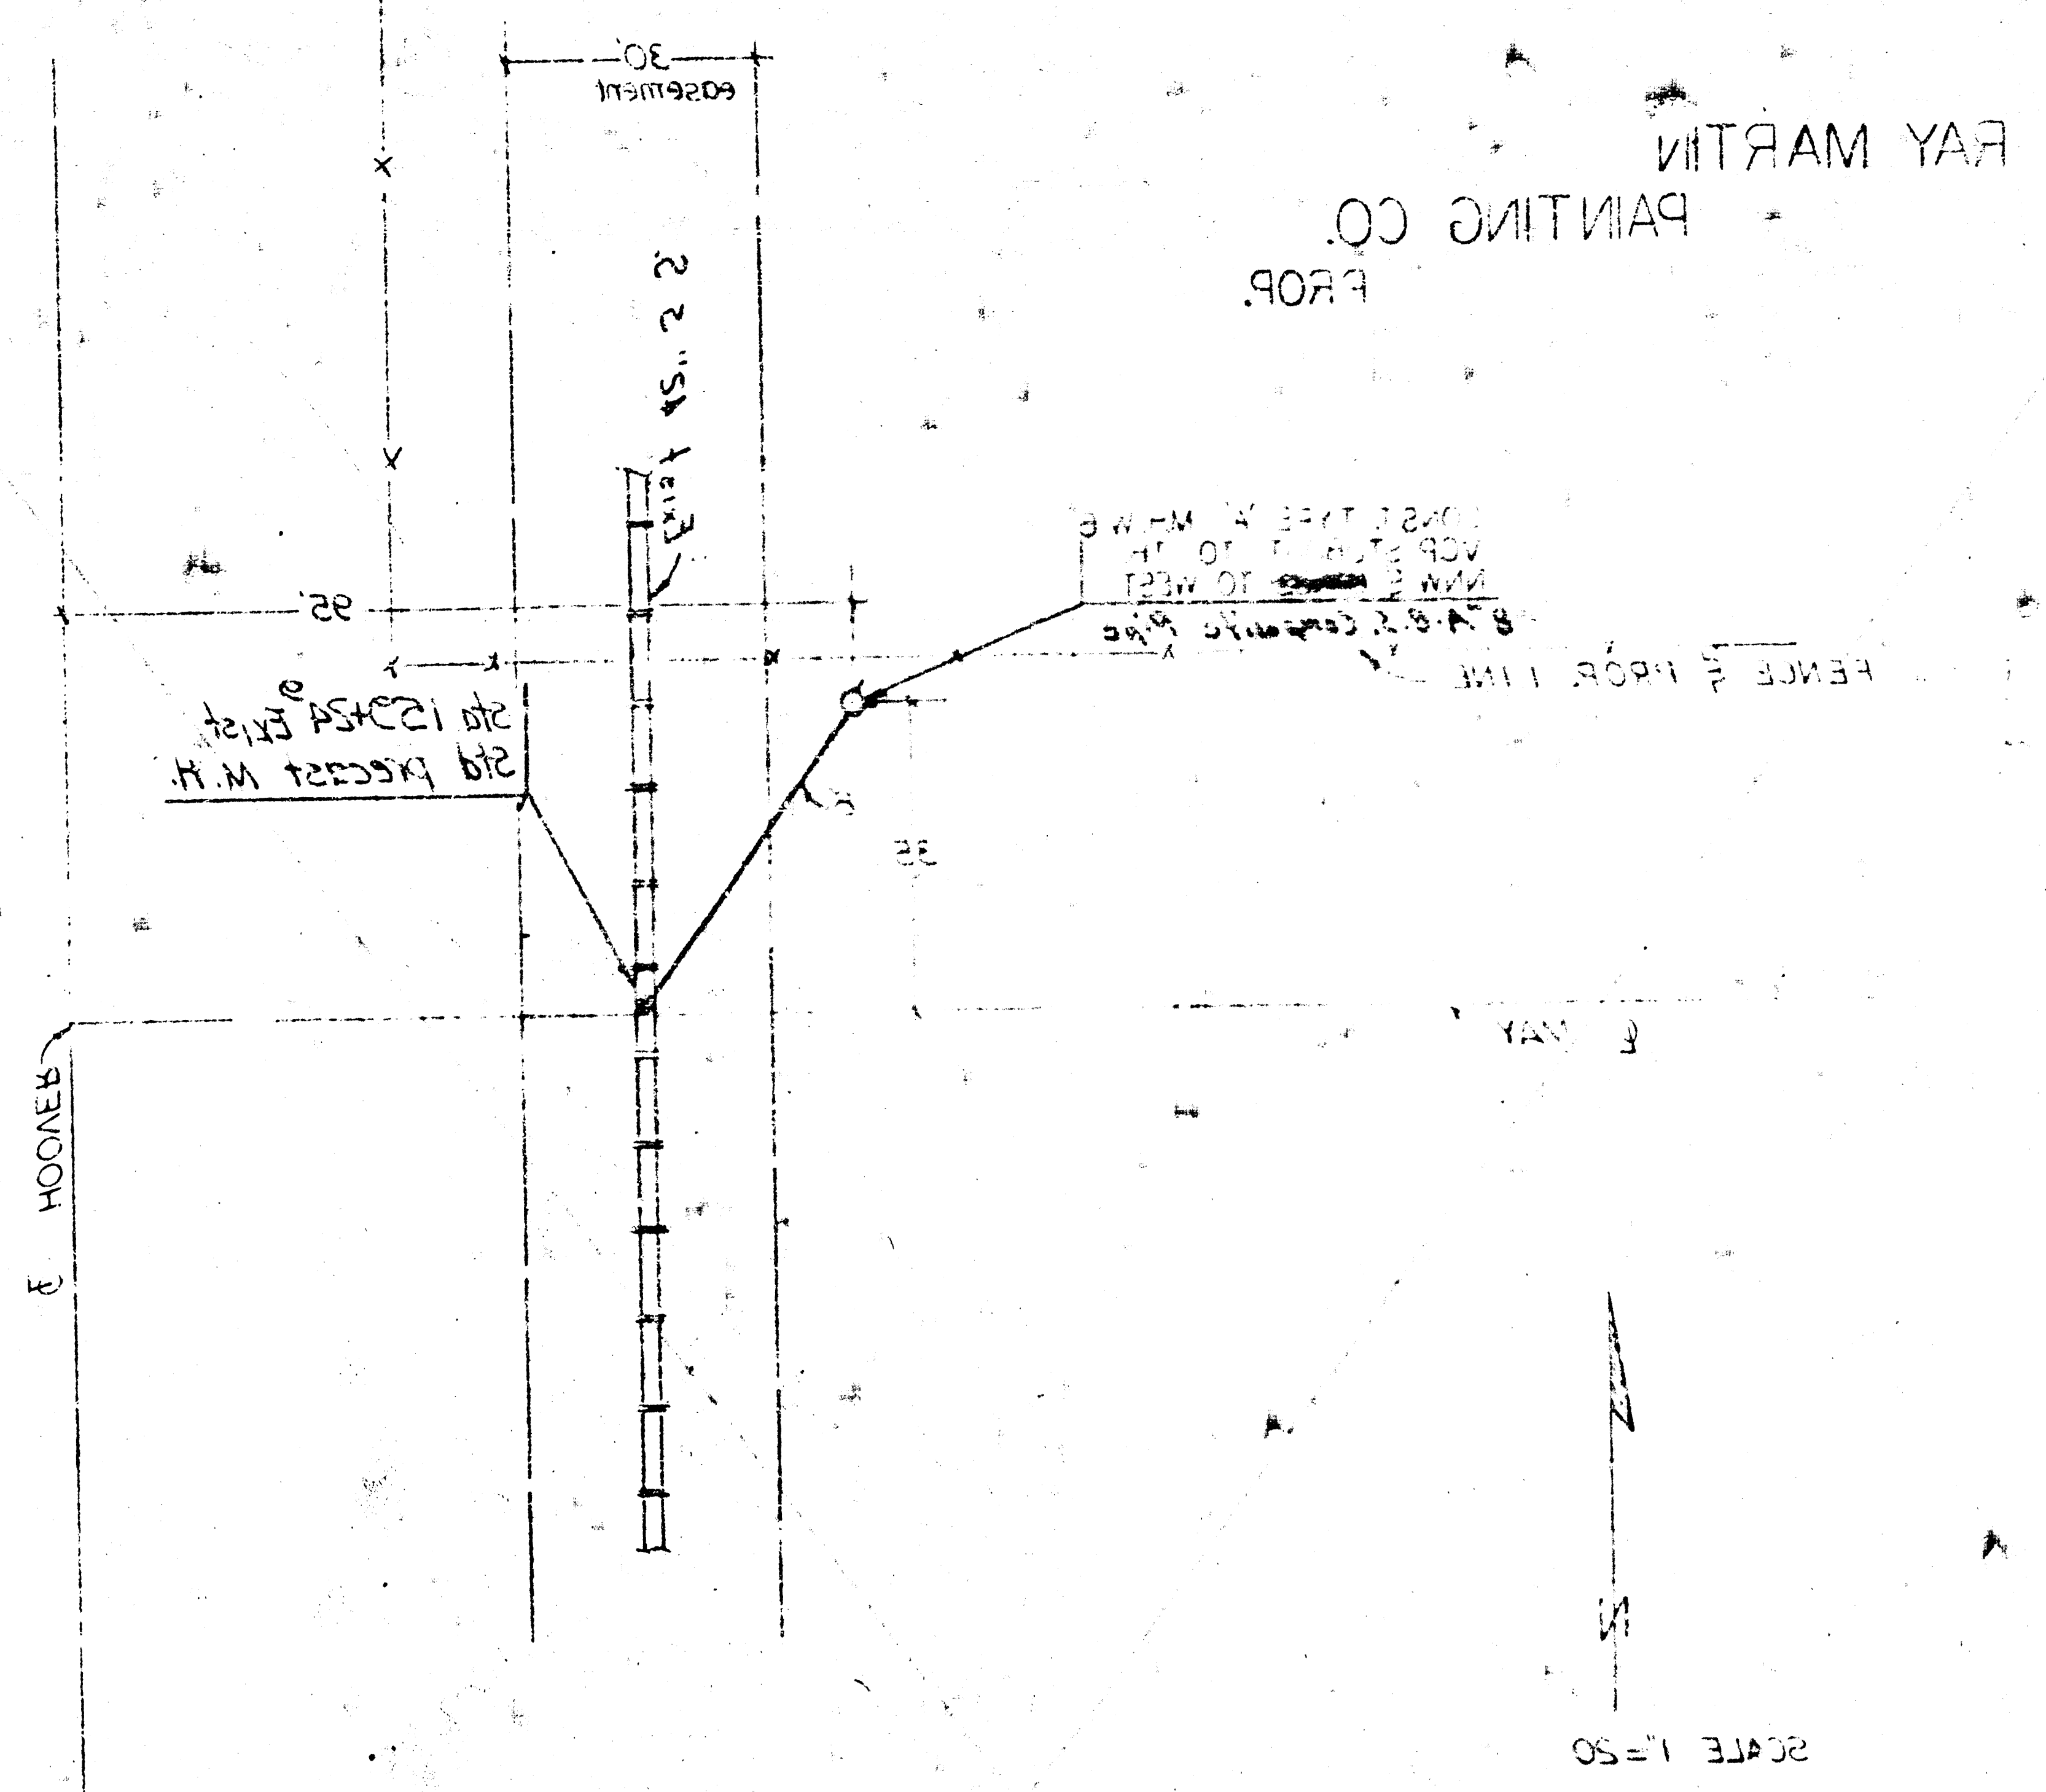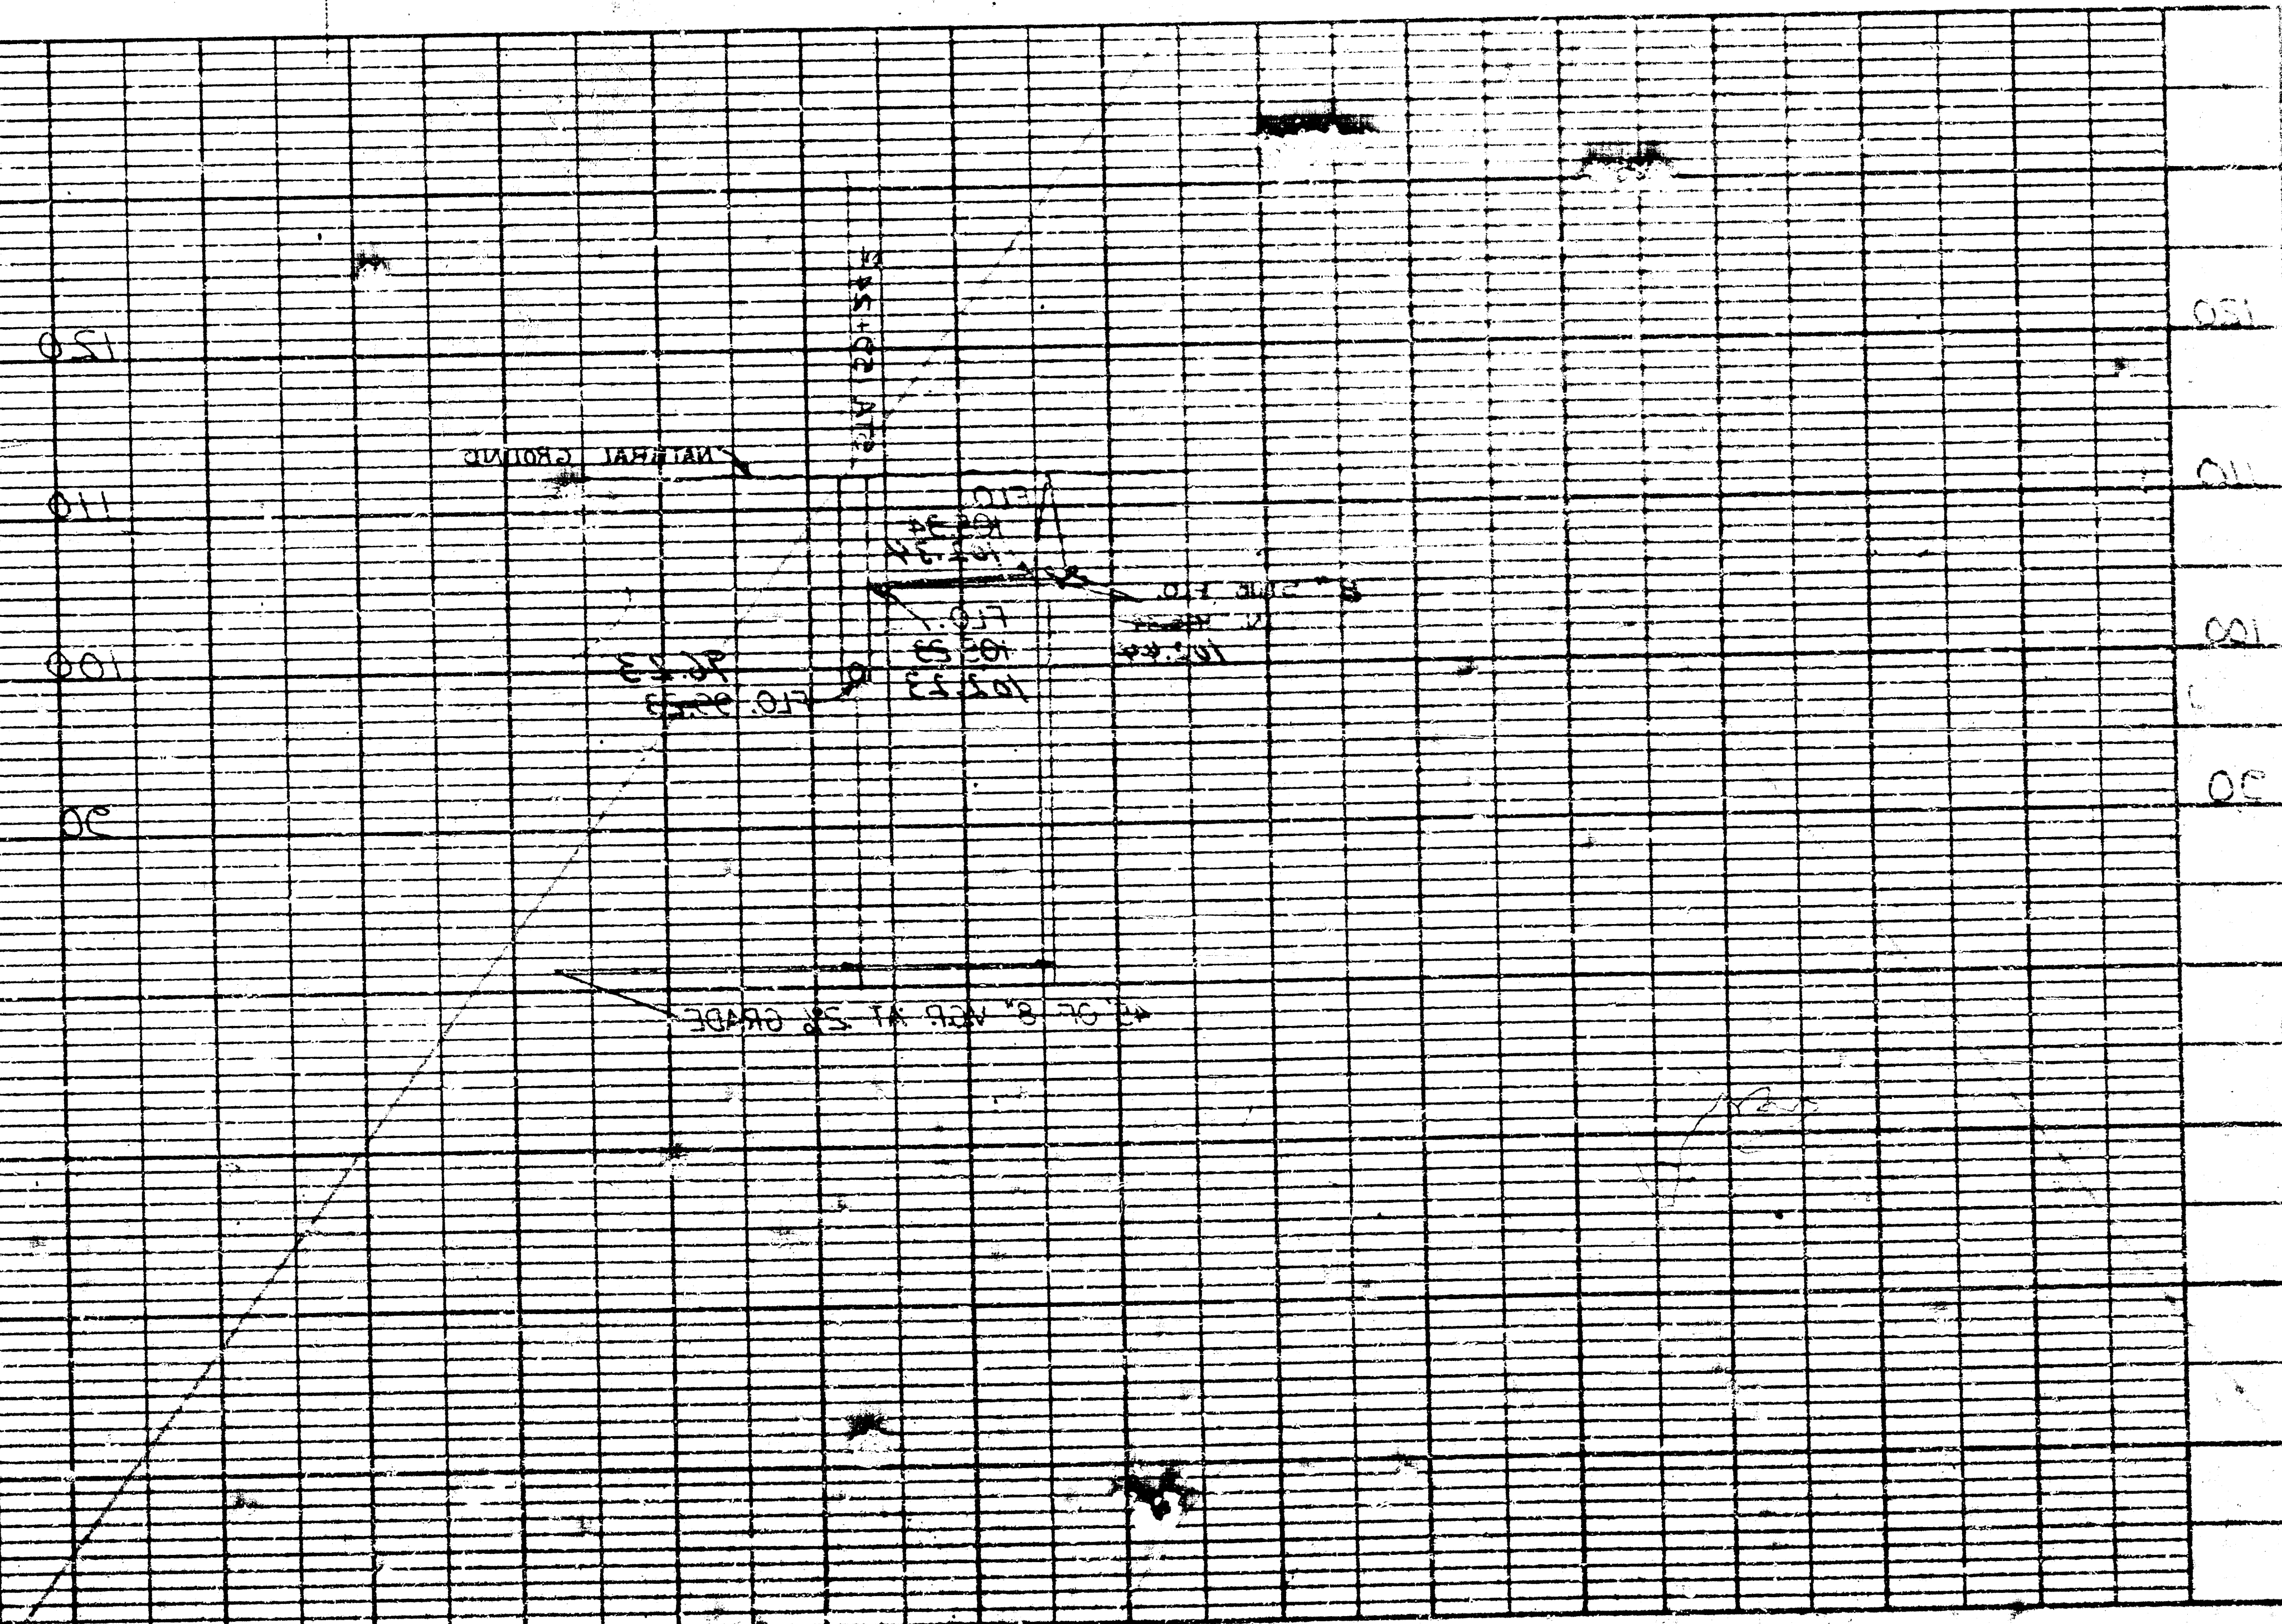

**CONNECTION FOR
PRECAST MAN-HOLE**
NO SCALE

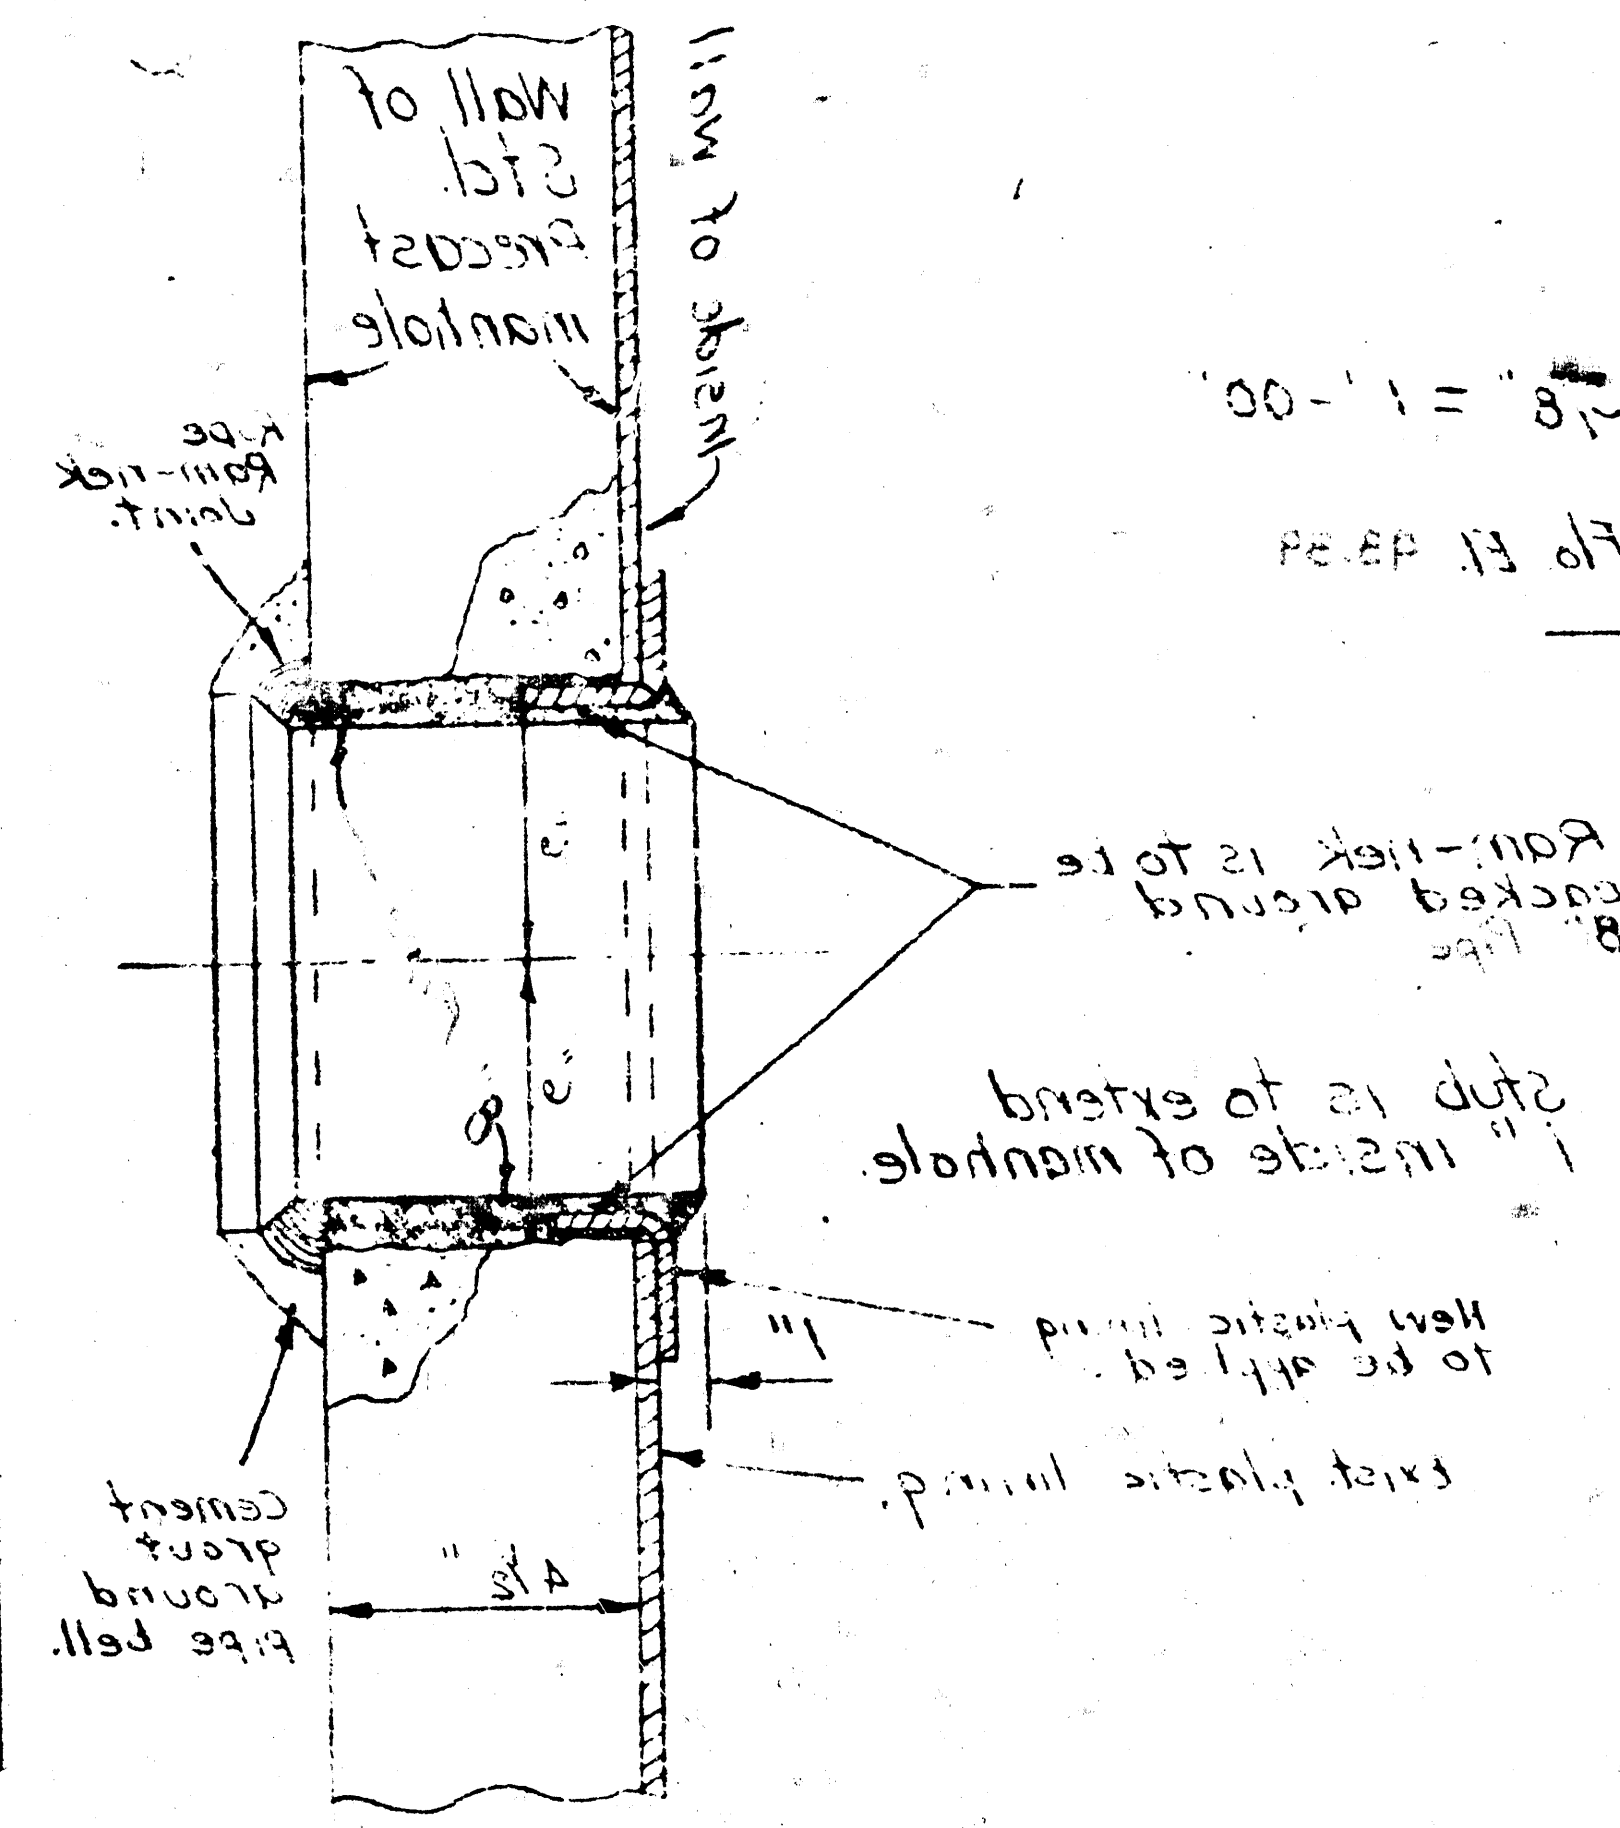


1" inside of manhole
step is to extend
Rough-rick is to be
packed around

First plastic lining
to be applied
New plastic lining
to be applied

Cement
around
pipe bell

Standard Precast
Manhole
Sta. 0+00.00 Exist




CAUTION:
Ventilate manhole
before drilling
holes into wall.

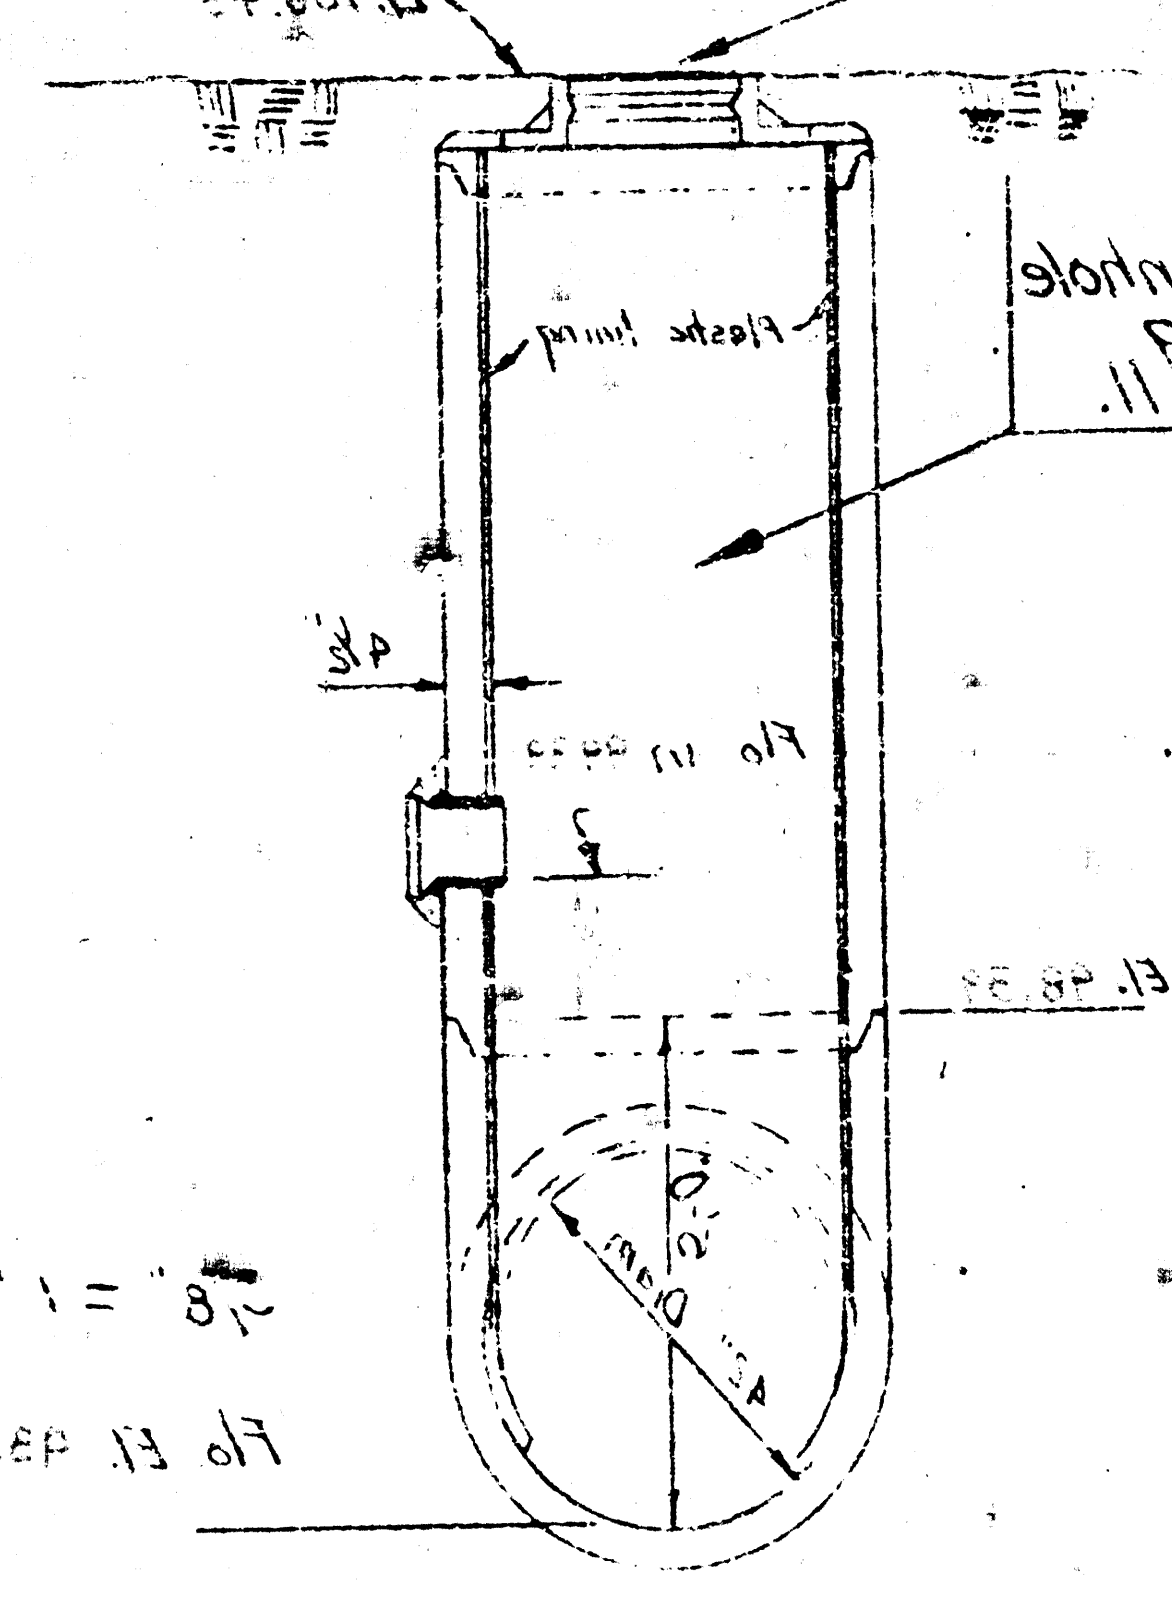

1" inside of manhole
step is to extend
Rough-rick is to be
packed around

First plastic lining
to be applied
New plastic lining
to be applied

Cement
around
pipe bell

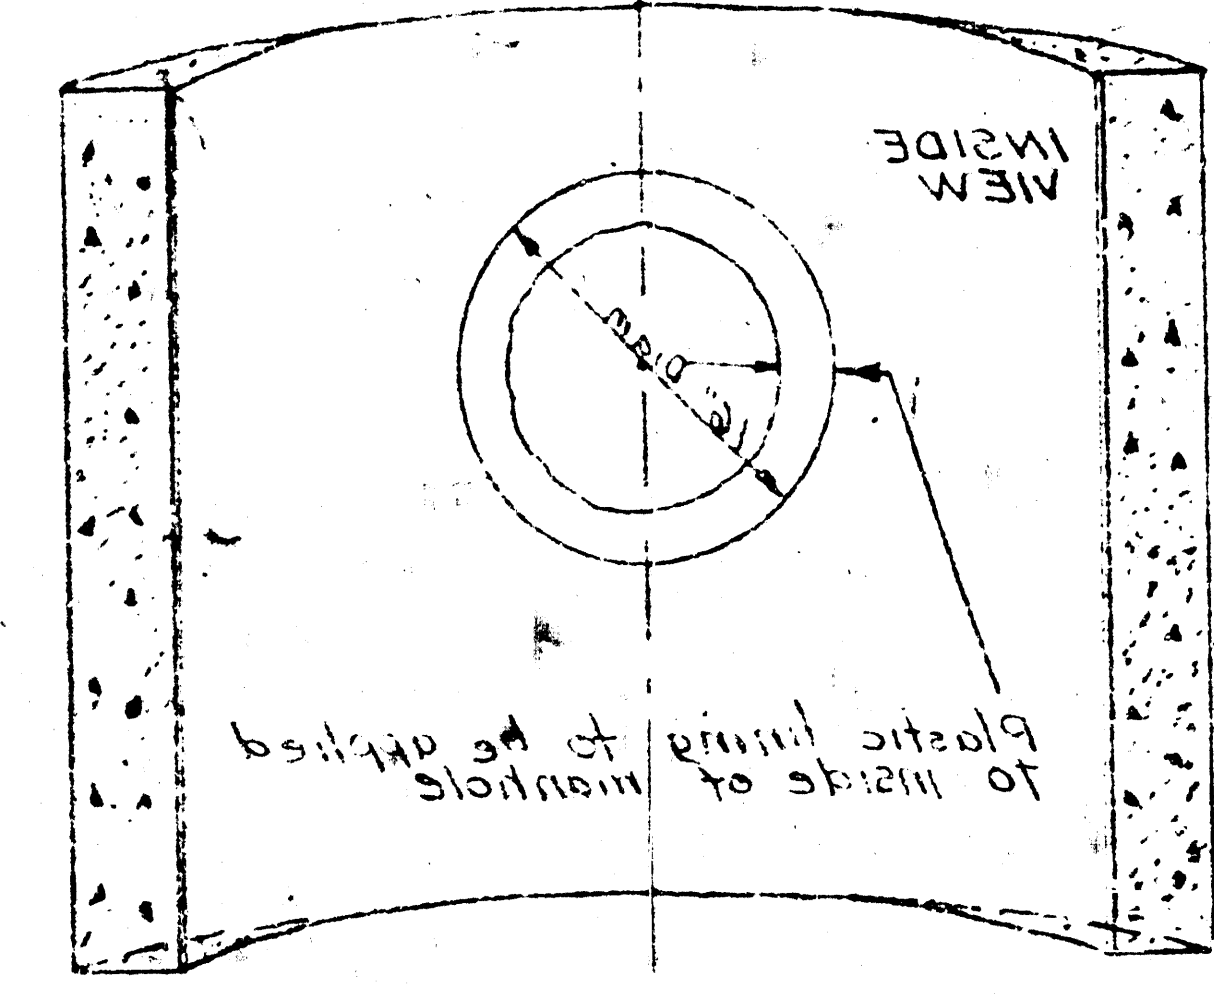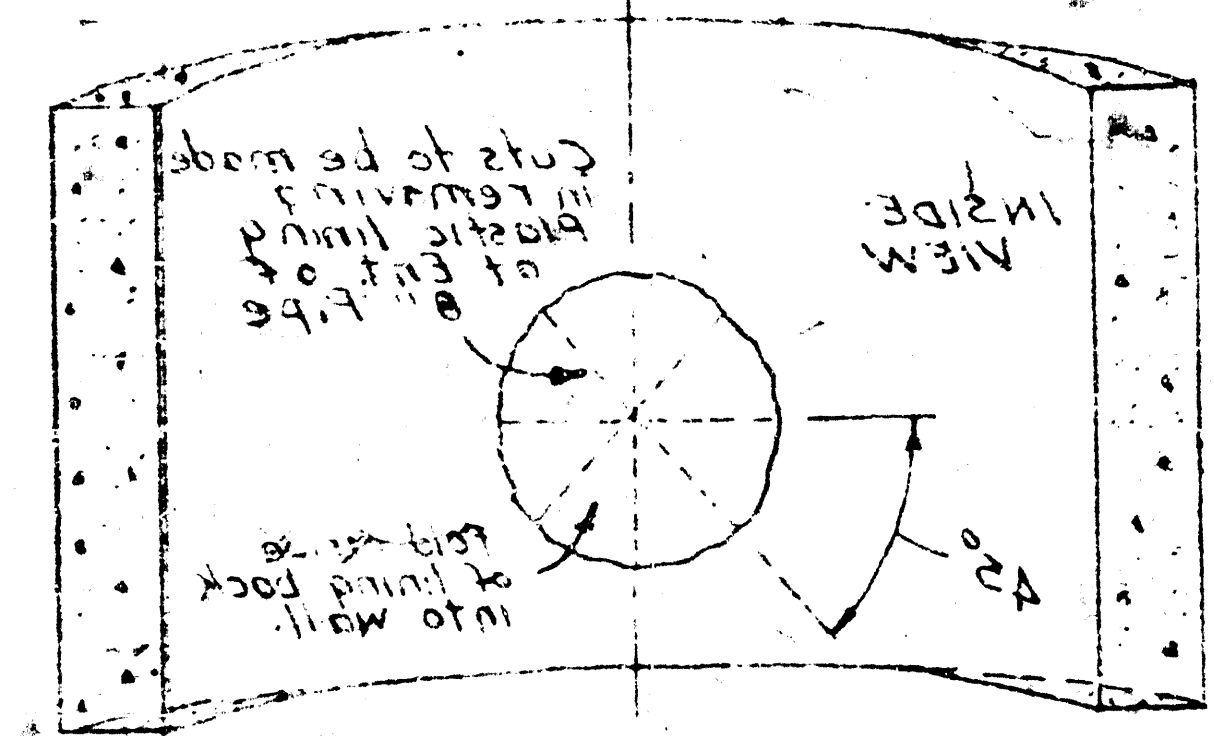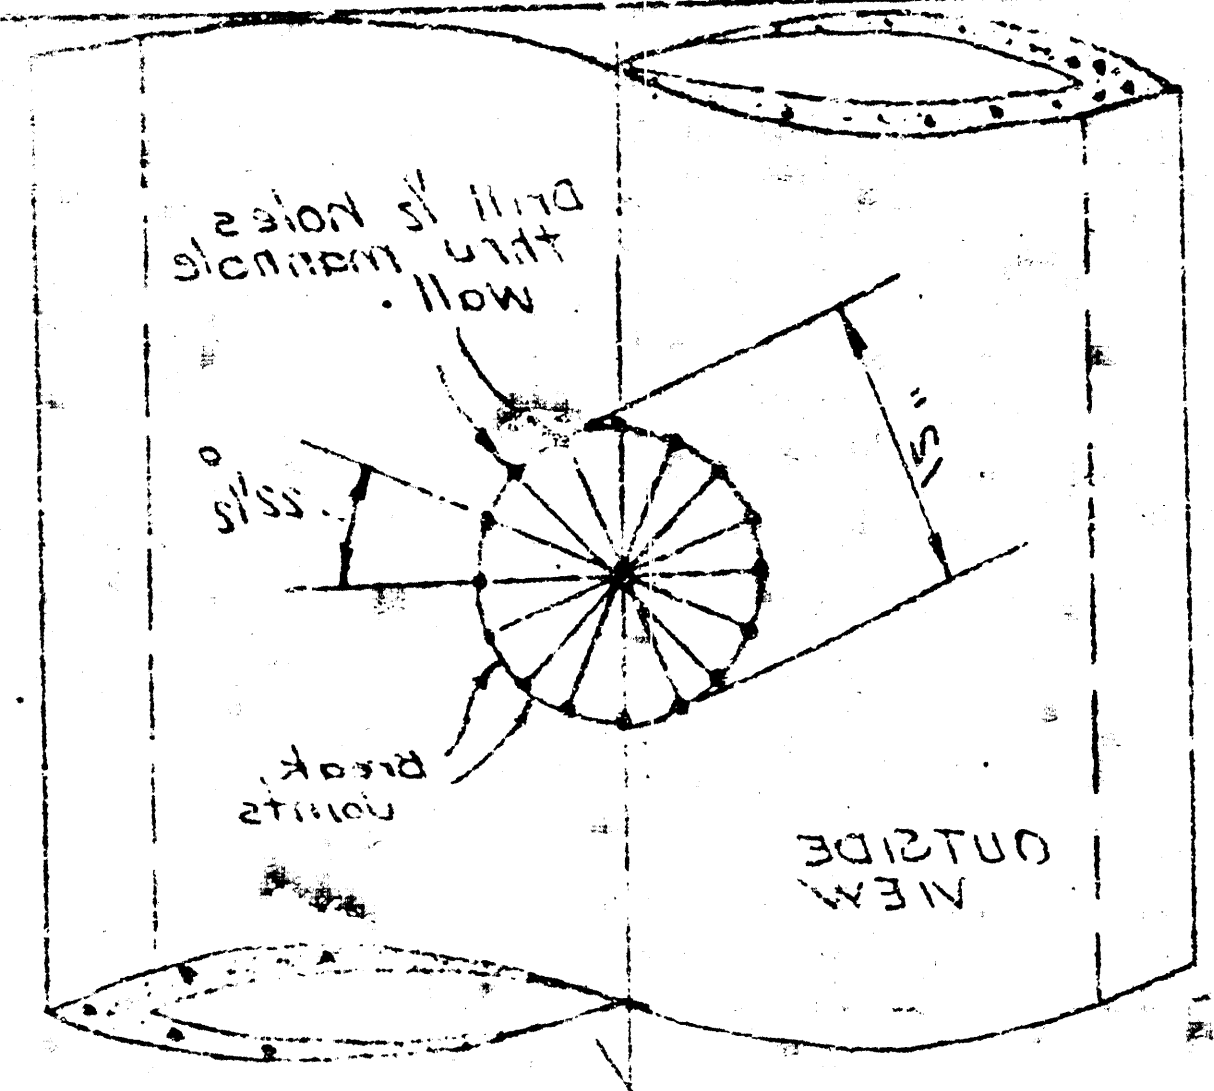

RAY MARTIN
PAINTING CO.
PROP.

SCALE 1"=50'