


Note: Dimensions and locations to be field checked.



• Bench mark "M" in Mueller on Fire Hydrant at NW corner Gilbert & Eastern 150.87

SANITARY SEWER TO SERVE CHARTER MEDICAL CENTER **SANITARY SEWER INSTALLATION** **PRIVATE PROJECT NO. 448-76-245-80001-000-000-127**

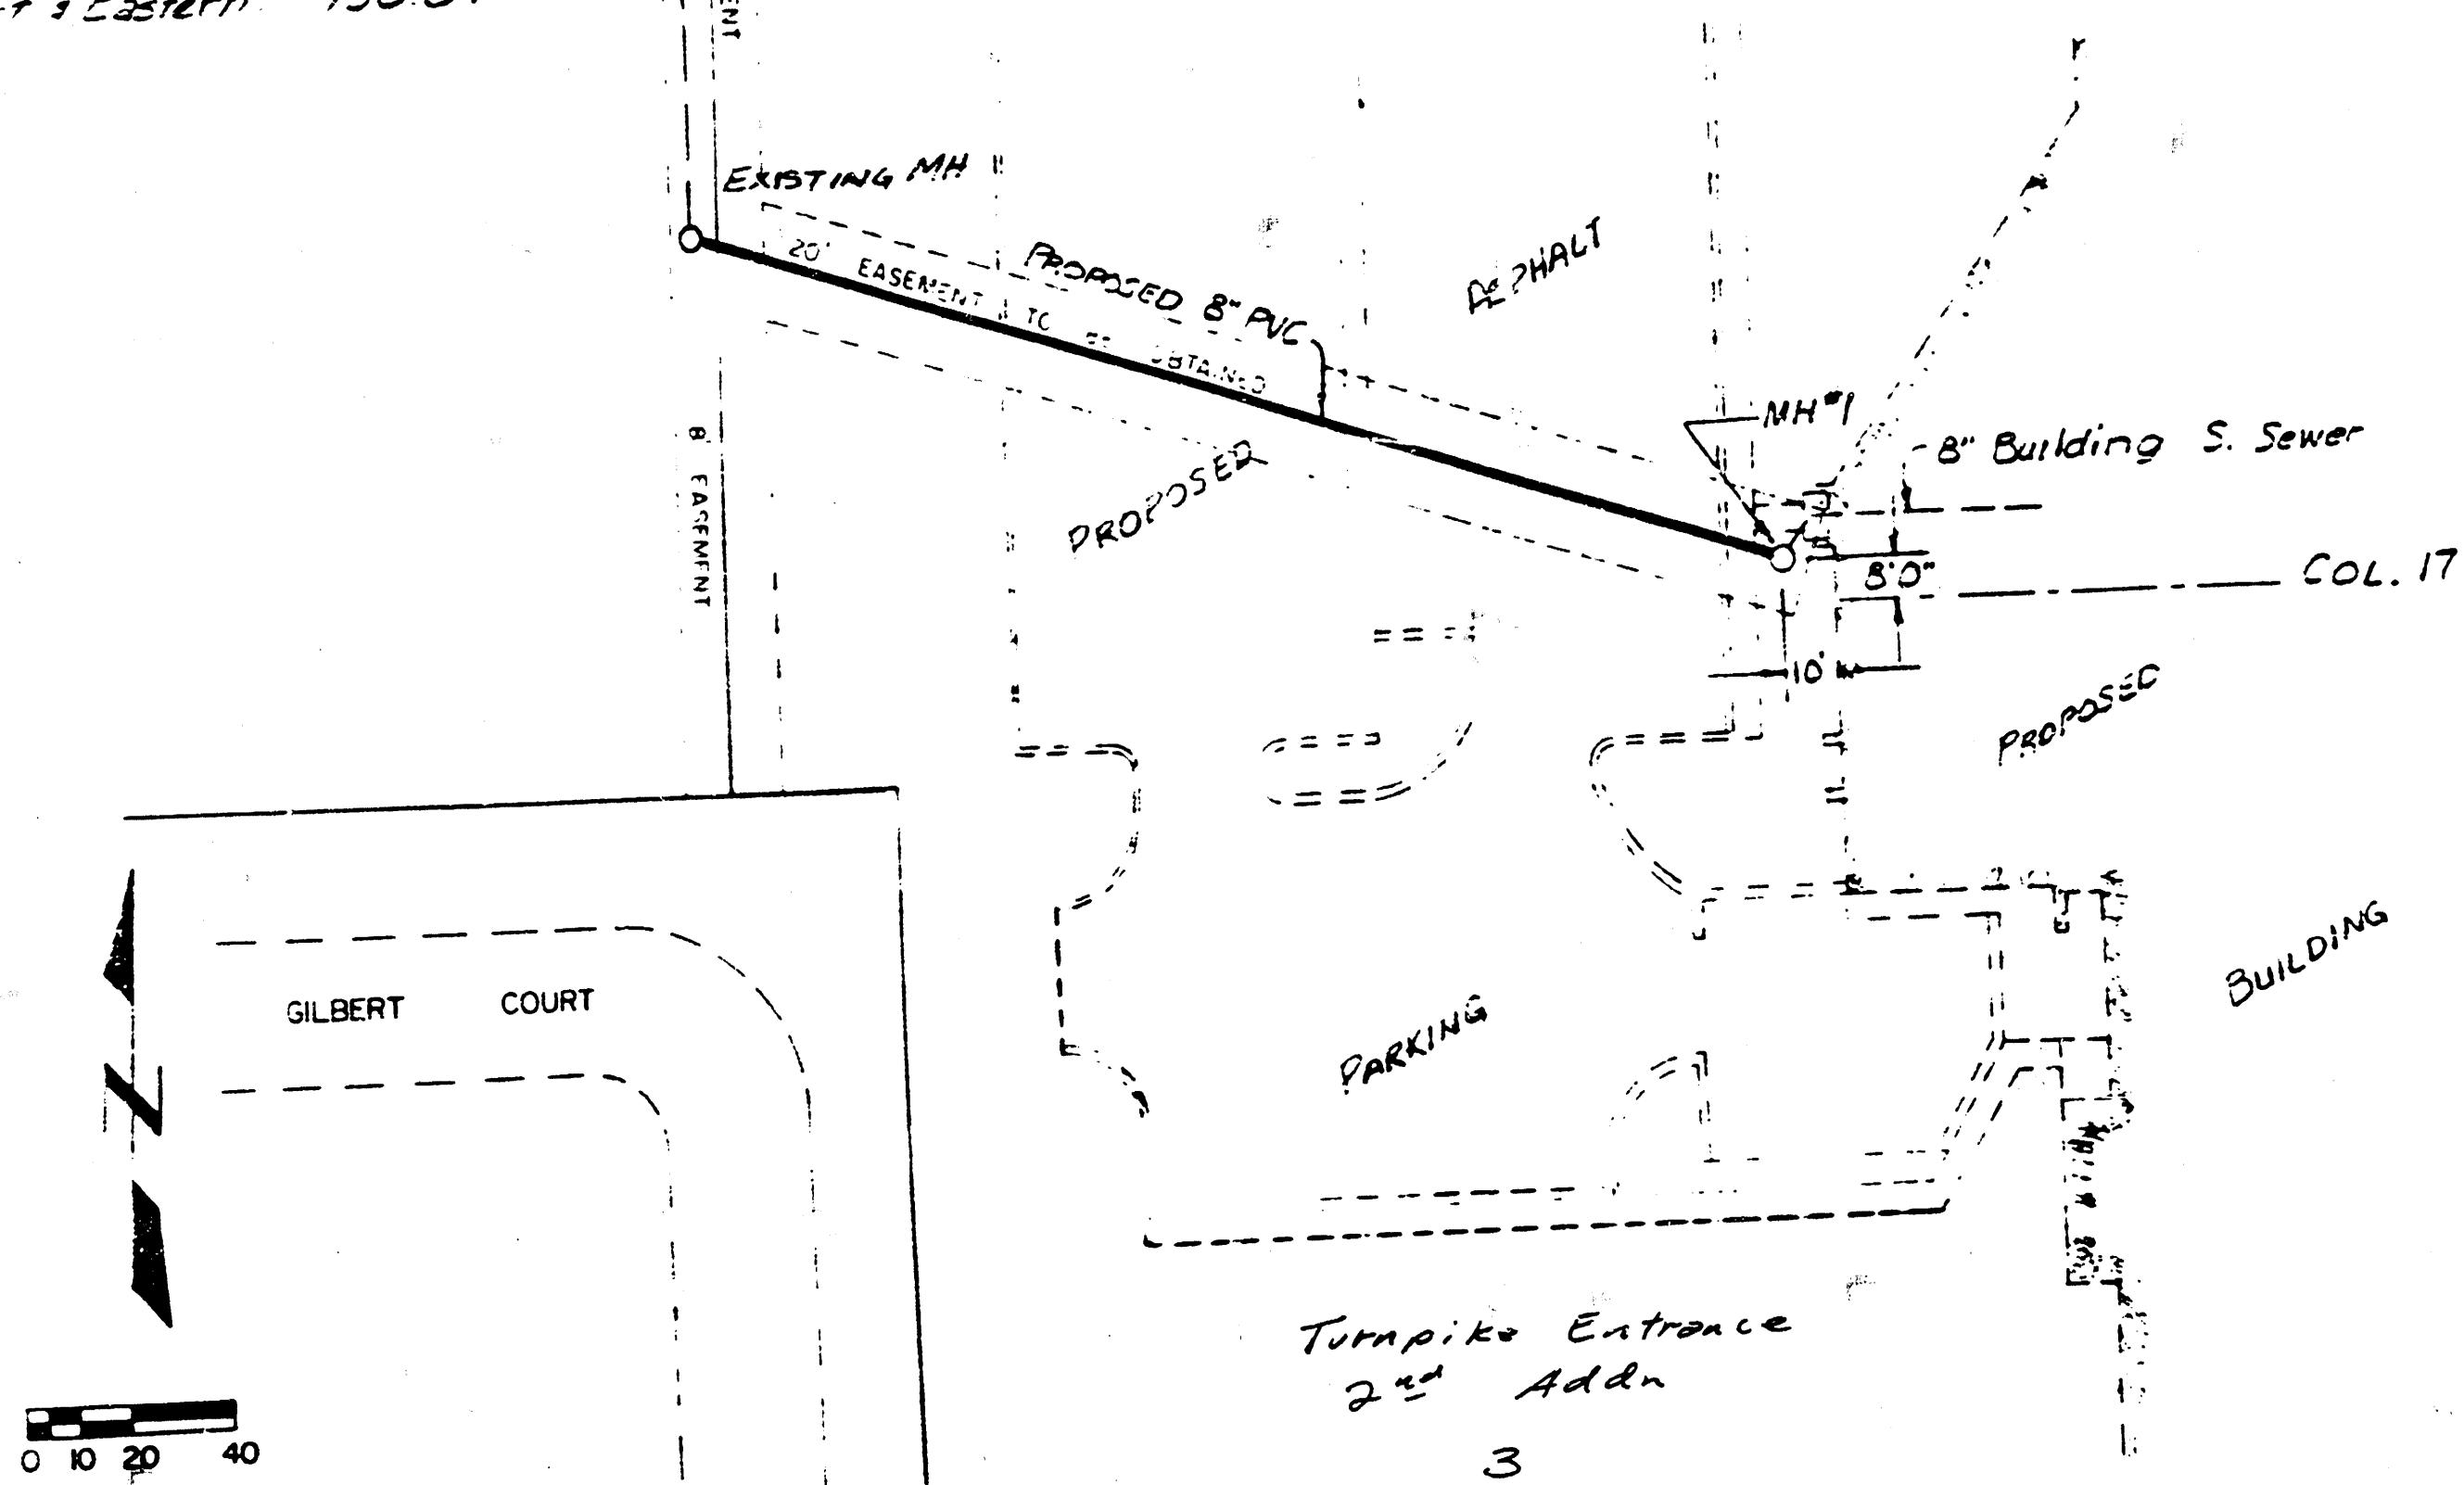

NOTE: See City of Wichita Sewer Specifications

8\"/>

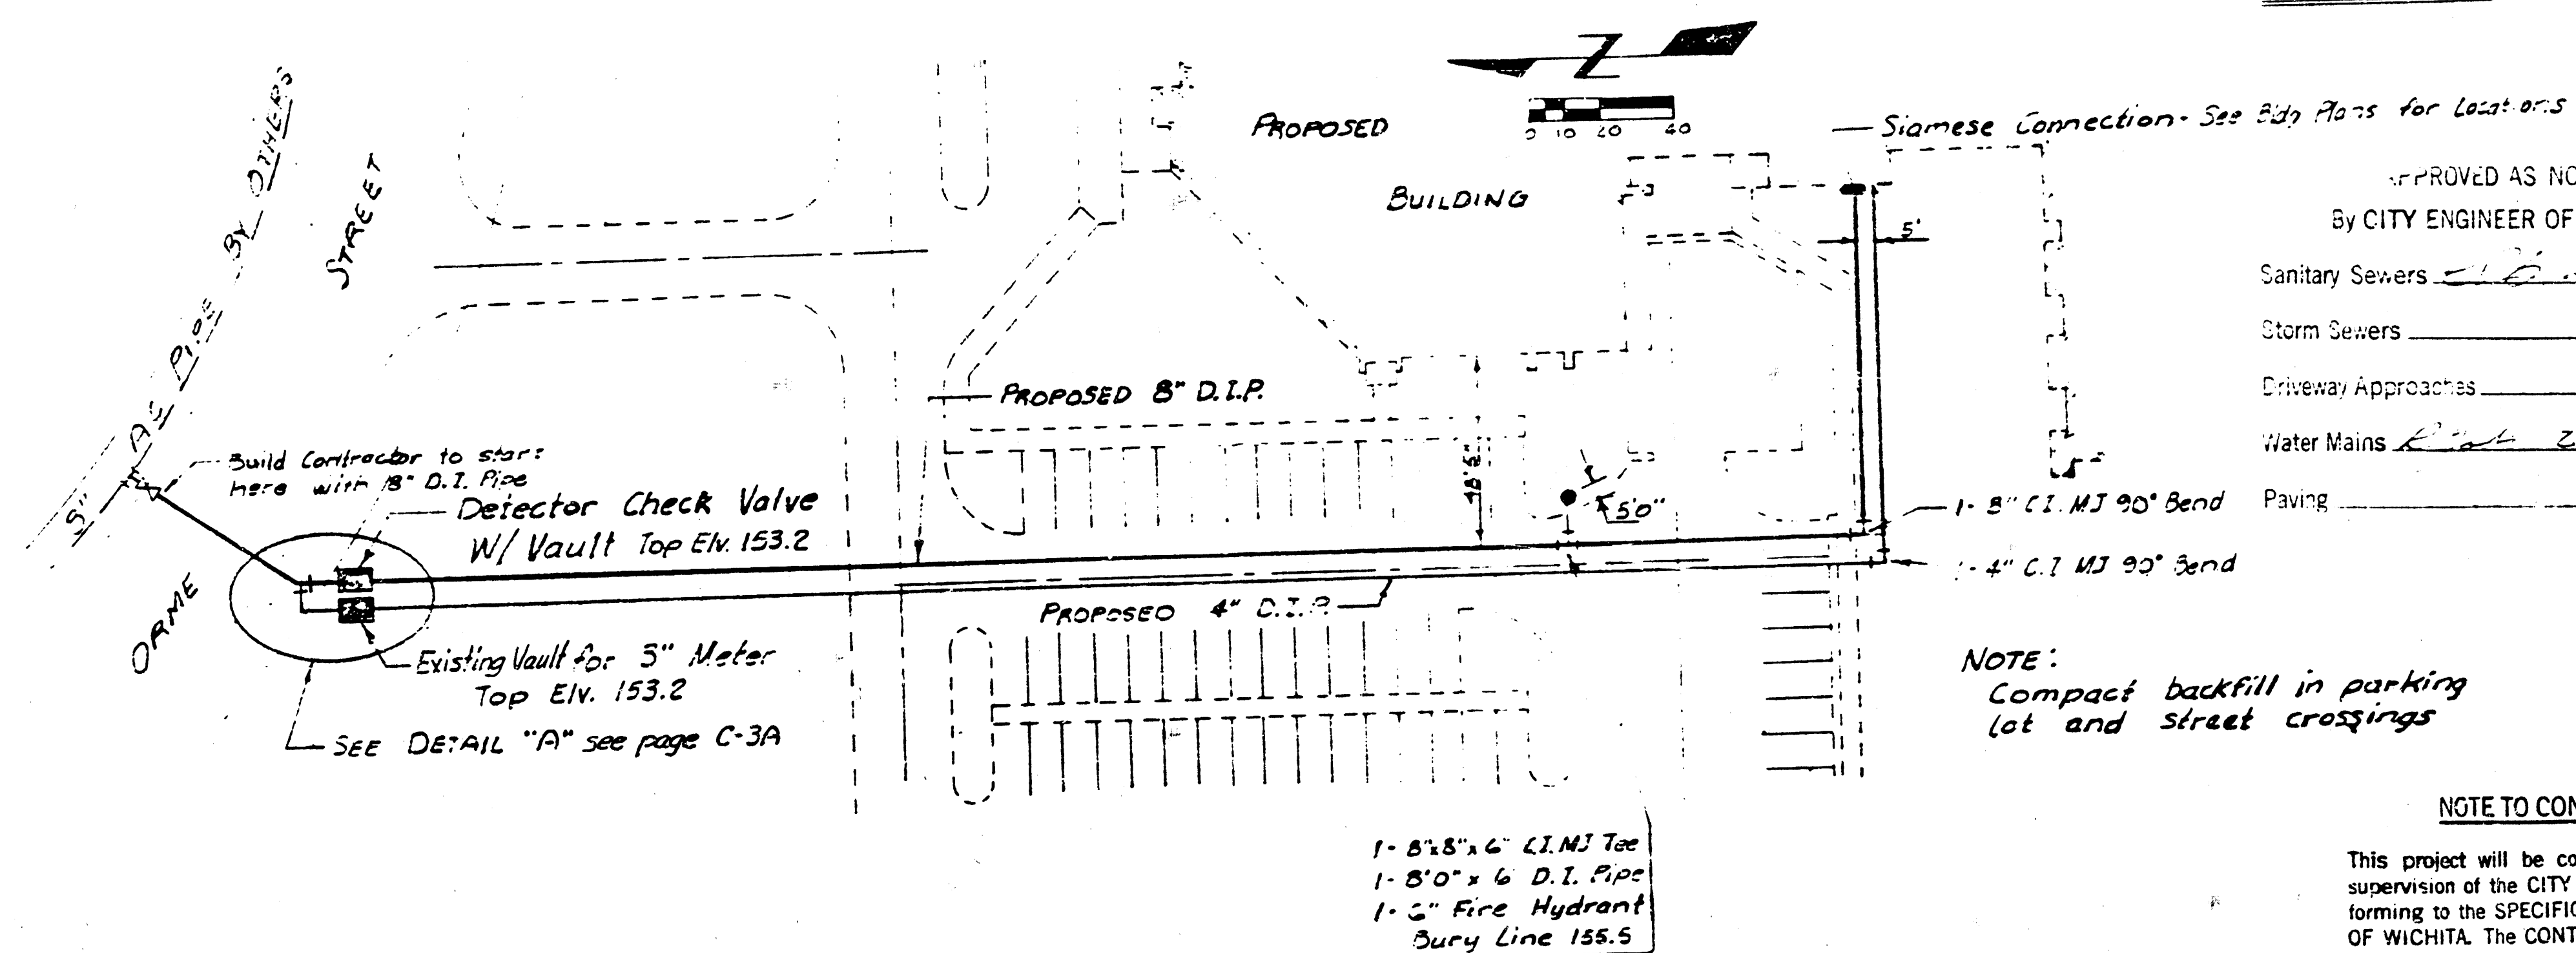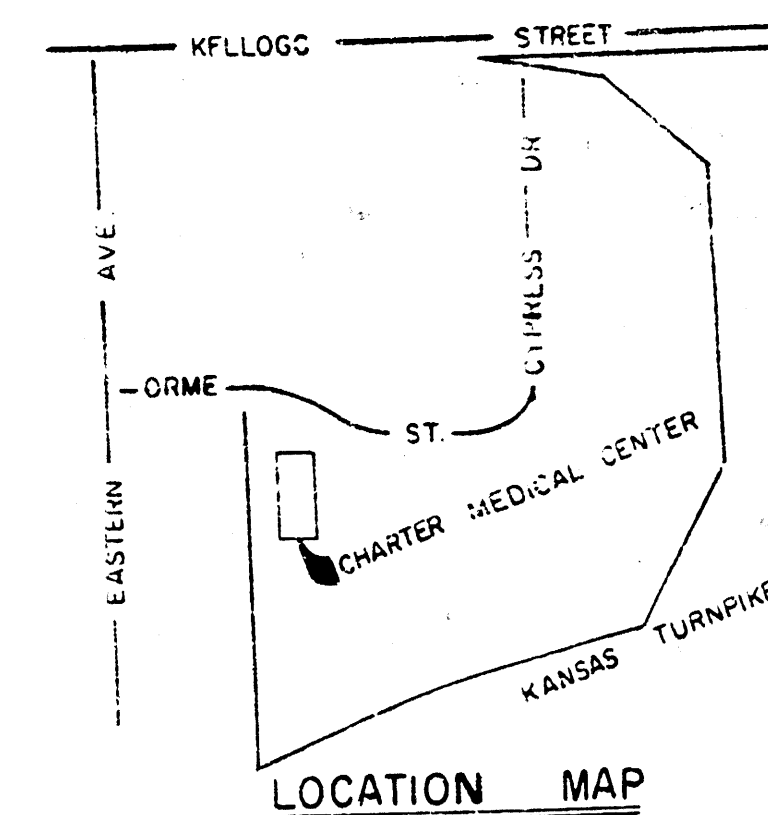


NOTE: Compact backfill in parking lot and street crossings

NOTE TO CONTRACTOR

This project will be constructed under the supervision of the CITY ENGINEER and conforming to the SPECIFICATIONS of the CITY OF WICHITA. The CONTRACTOR will pay the City of Wichita for all costs of plan review, inspection and looking per contract.


- △ Redesigned 8" PVC Sanitary Sewer - Feb. 12, 1986
- △ Redesigned 8" Water Service and locations of concrete Vaults

NOTE: Fill must be in place from Sta 3+00 to Sta 5+71 before water line is placed.

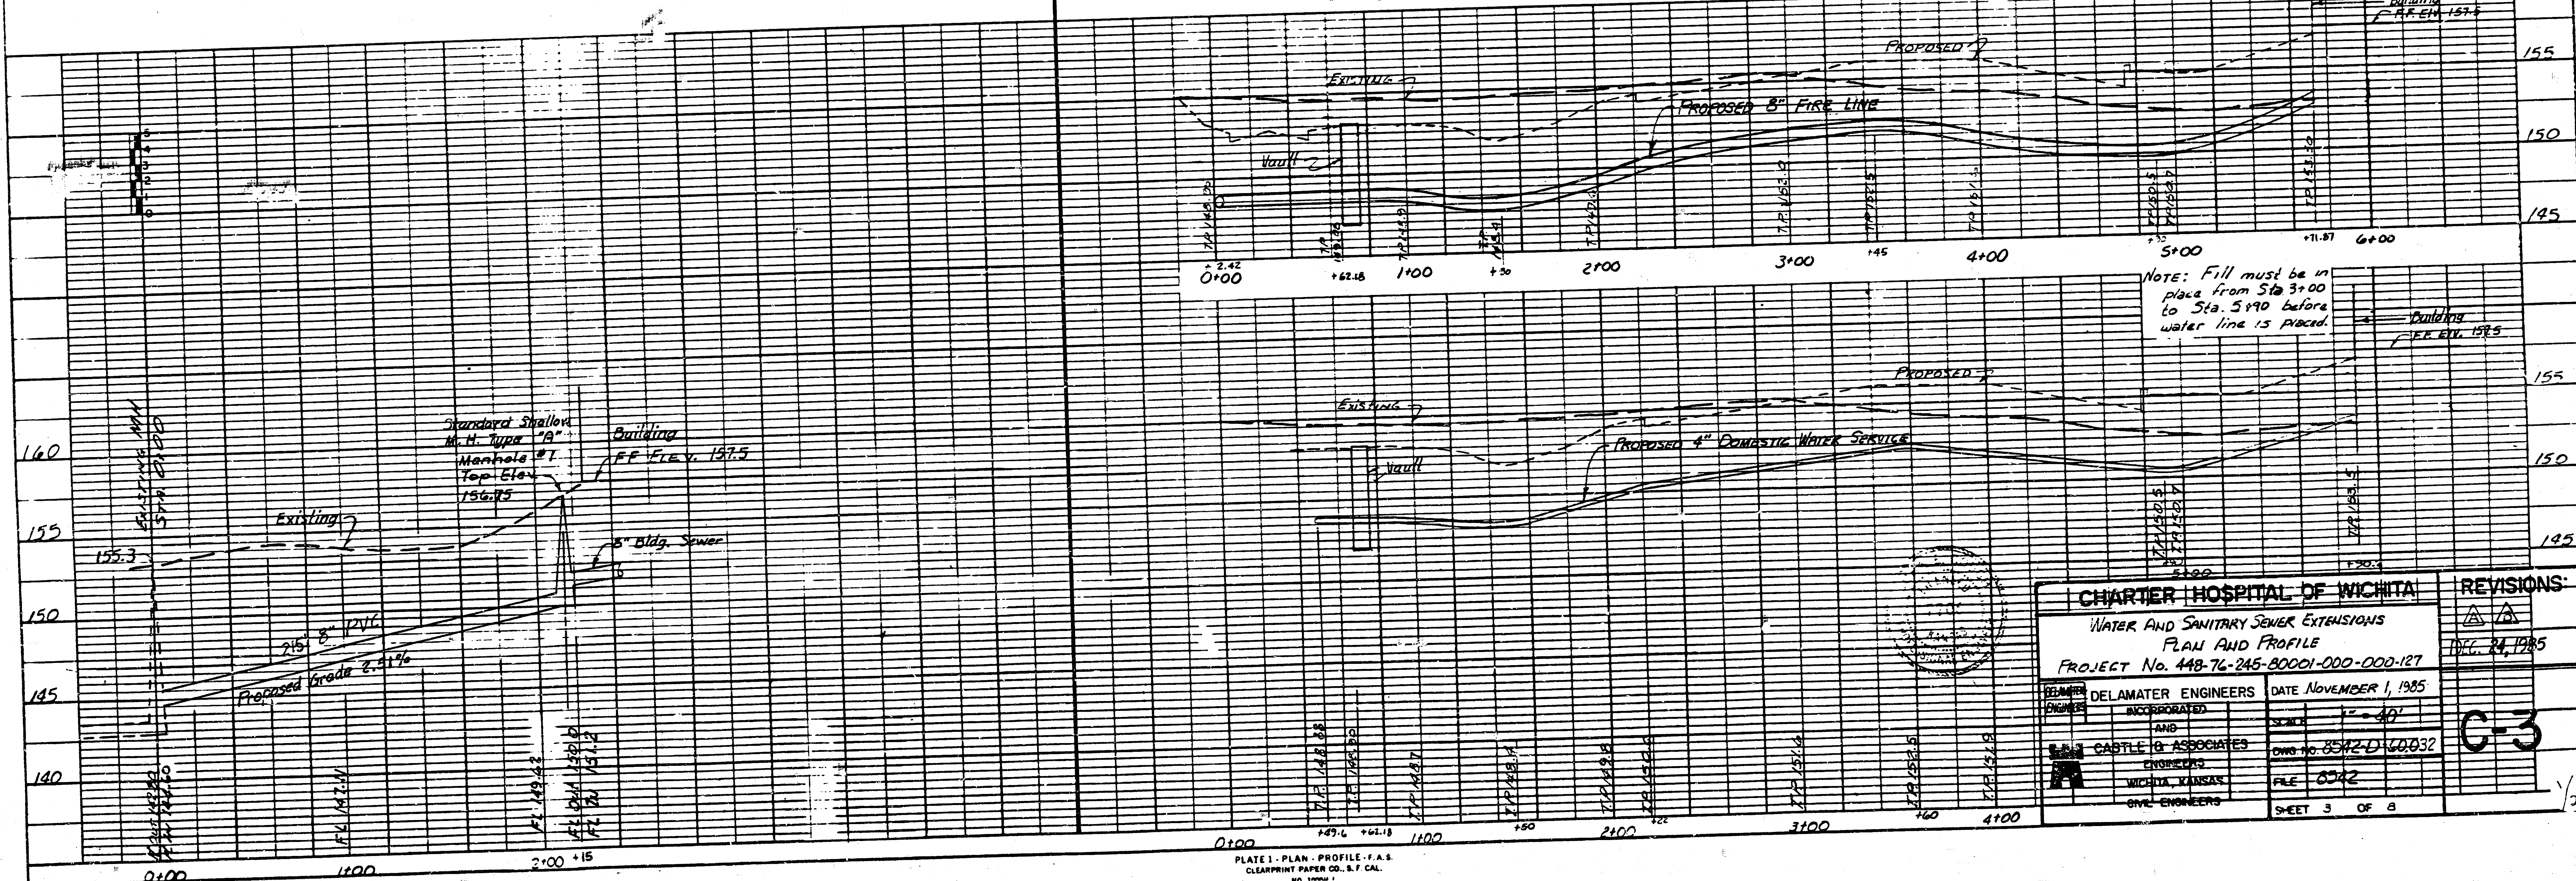

CHARTER HOSPITAL OF WICHITA		REVISIONS	
WATER AND SANITARY SEWER EXTENSIONS		DATE NOVEMBER 1, 1985	
PLAN AND PROFILE		BY C. E. 1985	
PROJECT NO. 448-76-245-80001-000-000-127		C-3	
DESIGNED BY DELAMATER ENGINEERS	DATE NOVEMBER 1, 1985	SHEET 3 OF 8	
CHECKED BY CASTLE & ASSOCIATES	DATE NOVEMBER 1, 1985		
APPROVED BY CASTLE & ASSOCIATES	DATE NOVEMBER 1, 1985		
WICHITA, KANSAS	DATE NOVEMBER 1, 1985		

FILMED FROM THE BEST AVAILABLE COPY

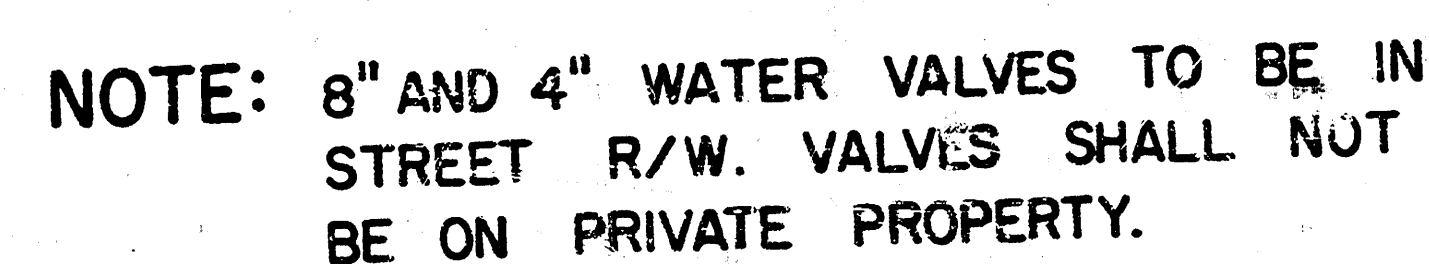

CHARTER HOSPITAL OF WICHITA		REVISIONS:
WATER AND SANITARY SEWER EXTENSIONS DETAIL AND SPECIFICATIONS PROJECT NO. 448-76-245-80001-000-000-127		 DEC. 24, 1985
DESIGNED BY ENGINEER	DELAWARE ENGINEERS INCORPORATED AND B. J. CASTLE & ASSOCIATES ENGINEERS WICHITA, KANSAS CIVIL ENGINEERS	DATE: NOVEMBER 1, 1983 SCALE: 1" = 40' DWS. NO. 35K-22 C-35033 FILE: 6742 SHEET 3A OF 8