

"AS CONSTRUCTED"

PLANS FOR


SANITARY SEWER EXTENSIONS

LOT 1, BLK. A CHELSEA INDUSTRIAL PARK

SEDGWICK CO., KS.

City of Wichita Proj. No. 468-76-245-80001-000-080-049

1985

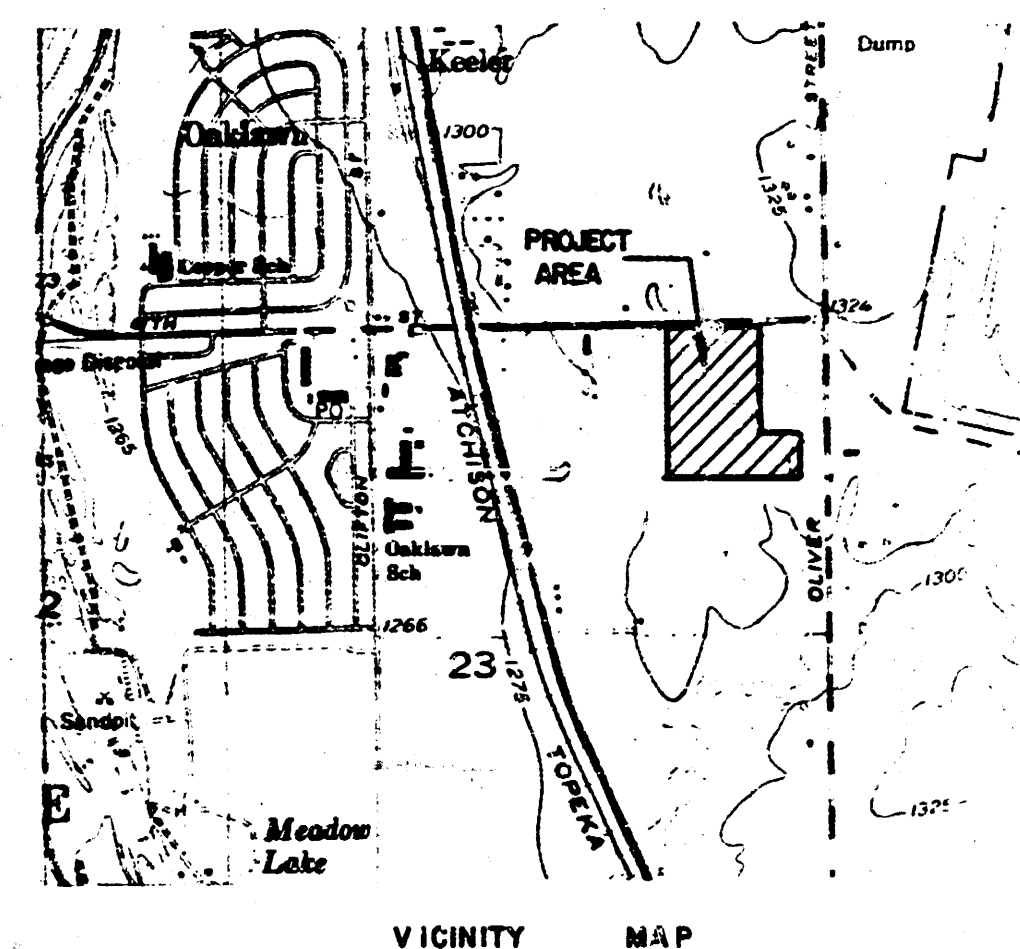

VICINITY MAP

APPROVED AS NOTED

By CITY ENGINEER OF WICHITA

Sanitary Sewers OK 1/6/86


Storm Sewers _____

Driveway Approaches _____

Water Mains _____

NOTE TO CONTRACTOR


This project will be constructed under the supervision of the CITY ENGINEER and conforming to the SPECIFICATIONS of the CITY OF WICHITA. The CONTRACTOR will pay the City of Wichita for all costs of plan review, inspection and booking per contract.

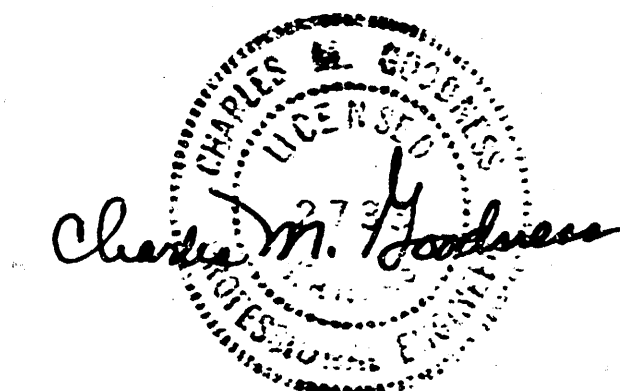

DEISS & GOODNESS ENGINEERS
2100 WEST 31ST STREET
WICHITA, KANSAS 67203
(316) 522-0233

REVISION	DRAWN BY	CHECKED BY	DESIGNED BY	PROJECT	CUSTOMER	SCALE	PROJECT NO.	SHEET	OF
							468-76-245-80001-000-080-049	1	4

FILMED FROM THE BEST
AVAILABLE COPY

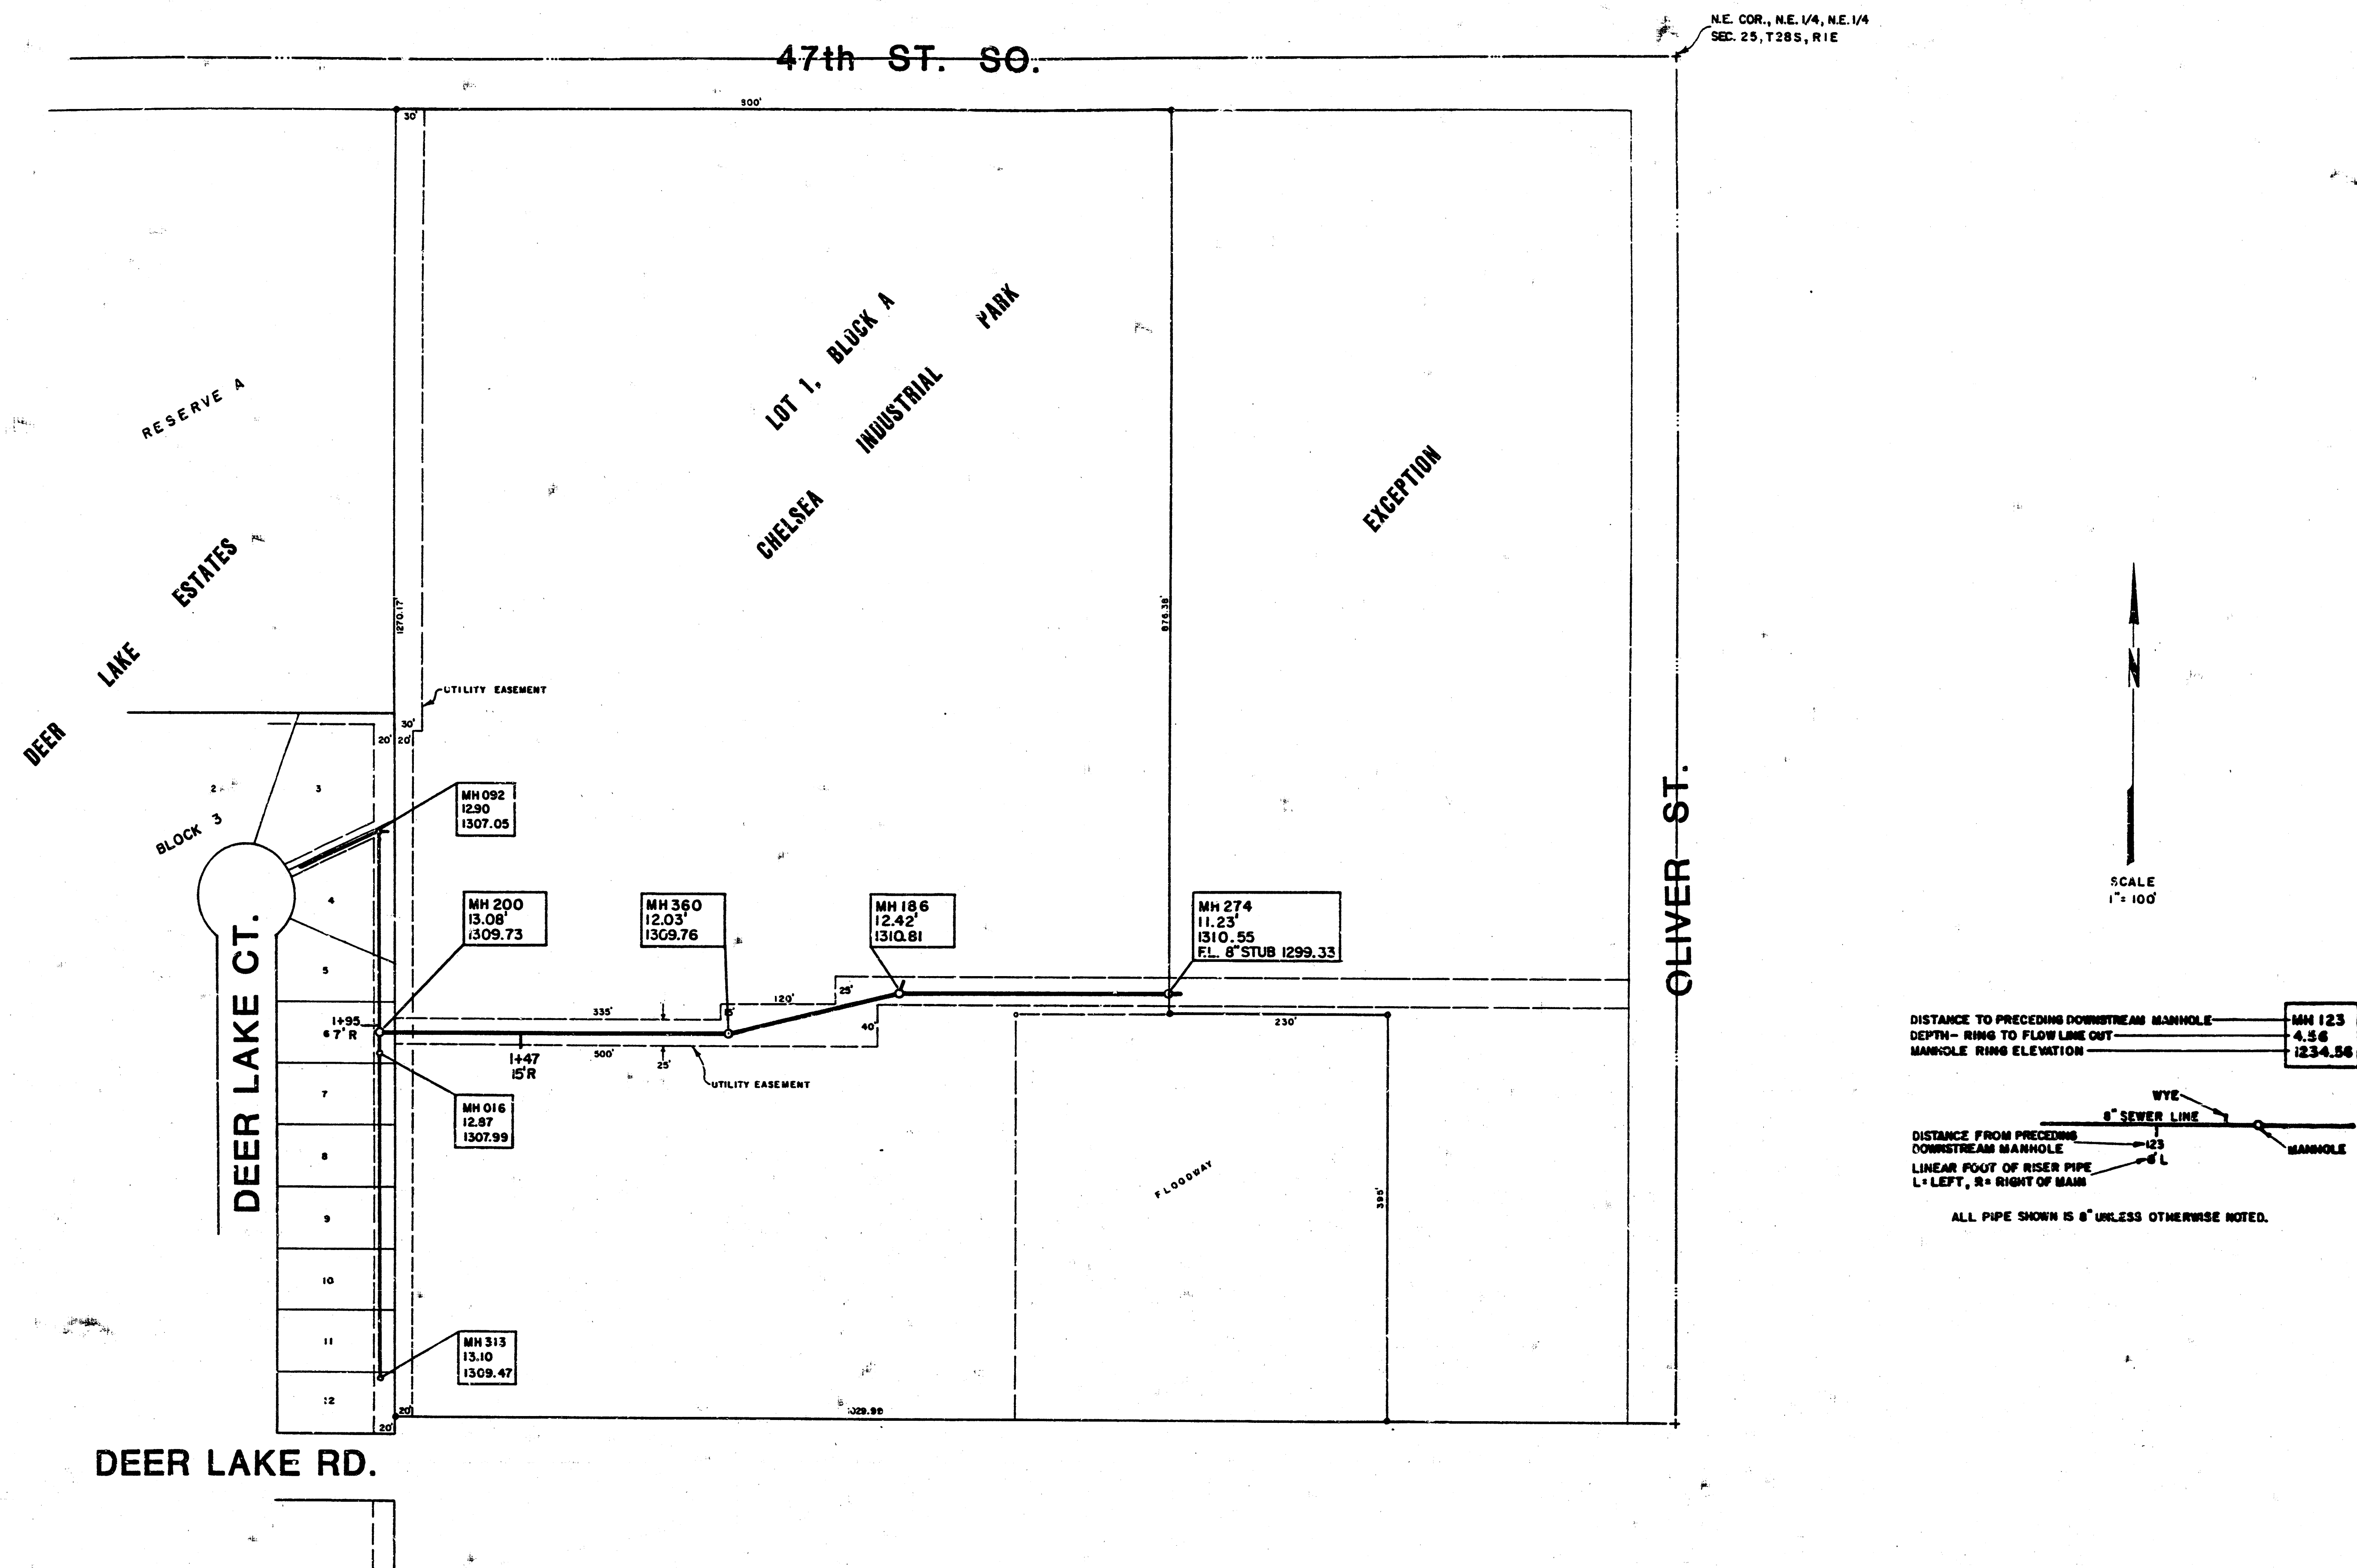

DISTANCE TO PRECEDING DOWNSTREAM MANHOLE
DEPTH - RING TO FLOW LINE OUT
MANHOLE RING ELEVATION

MH 123
4.56
1234.56

WYE
6" SEWER LINE
DISTANCE FROM PRECEDING
DOWNSTREAM MANHOLE
LINEAR FOOT OF RISER PIPE
L = LEFT, R = RIGHT OF MAIN

MANHOLE

ALL PIPE SHOWN IS 6" UNLESS OTHERWISE NOTED.

REISS & GOODNESS ENGINEERS
2160 WEST 21ST STREET
WICHITA, KANSAS 67203
(316) 832-0225

REVISION	DRAWN BY	CHECKED BY	DESIGNED BY	PROJECT	CUSTOMER	SCALE	PROJECT NO.
				"AS CONSTRUCTED" SANITARY SEWER SYSTEM	CHELSEA IND. PARK, SEDGWICK CO., KS.	DATE	SHEET 2/3

FILMED FROM THE BEST
AVAILABLE COPY

