


PLANS FOR SANITARY SEWER SYSTEM CHELSEA INDUSTRIAL 2ND LOTS 1 & 2, BLOCK A

SEDGWICK COUNTY, KANSAS


CITY OF WICHITA PRIVATE PROJECT NO. 468-76-245-80001-000-000-184

1988

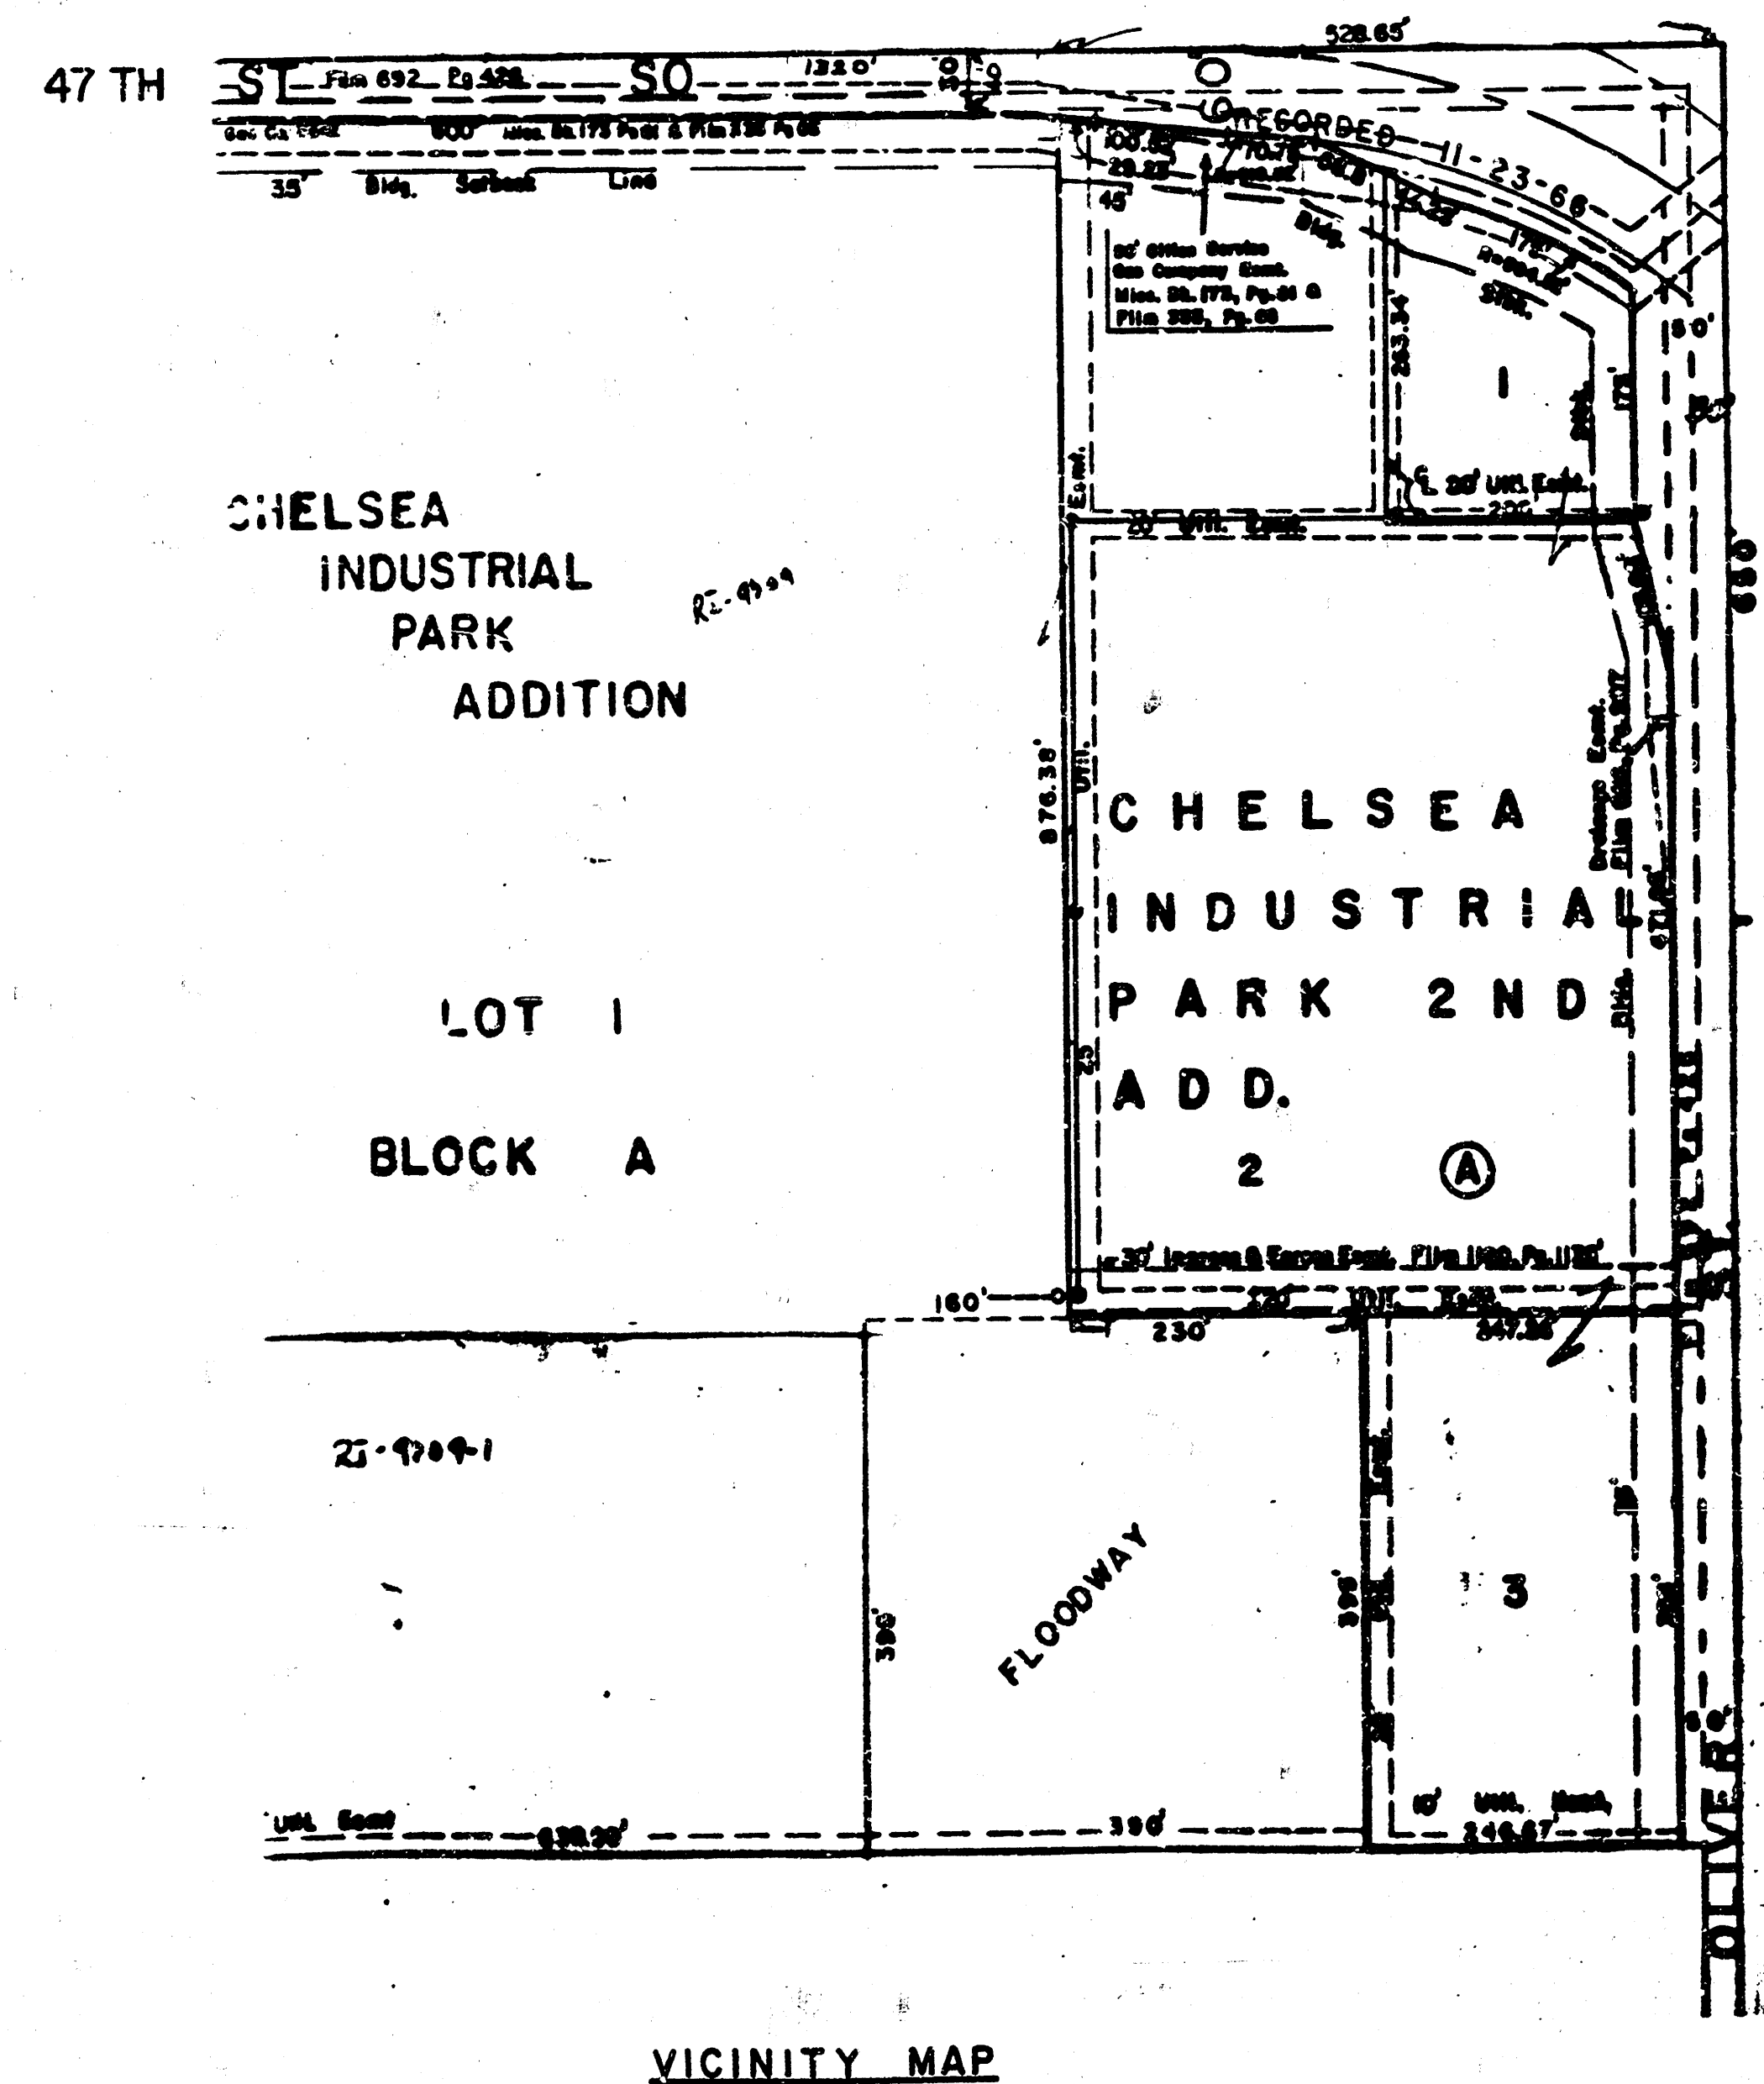

APPROVED AS NOTED
By CITY ENGINEER OF WICHITA
Sanitary Sewers *2/10/25/88*
Storm Sewers _____
Driveway Approaches _____
Water Mains _____
Paving _____

NOTE TO CONTRACTOR
INSPECTION AND TESTING FOR THIS PROJECT IS TO BE PROVIDED BY A LICENSED CONSULTING ENGINEERING FIRM UNDER CONTRACT WITH THE OWNER/DEVELOPER. SAID INSPECTION SHALL BE IN ACCORDANCE WITH THE CITY OF WICHITA STANDARD CONSTRUCTION SPECIFICATIONS, LATEST EDITION, AND CERTIFIED BY A LICENSED CONSULTING ENGINEER. NO WORK SHALL BE PROCEEDED UNTIL THE INSPECTION IS COMPLETED. THE CITY ENGINEER SHALL NOT BE RESPONSIBLE FOR SUCH INSPECTION. THE CITY ENGINEER SHALL NOT BE RESPONSIBLE FOR SUCH INSPECTION. THE CITY ENGINEER SHALL NOT BE RESPONSIBLE FOR SUCH INSPECTION.


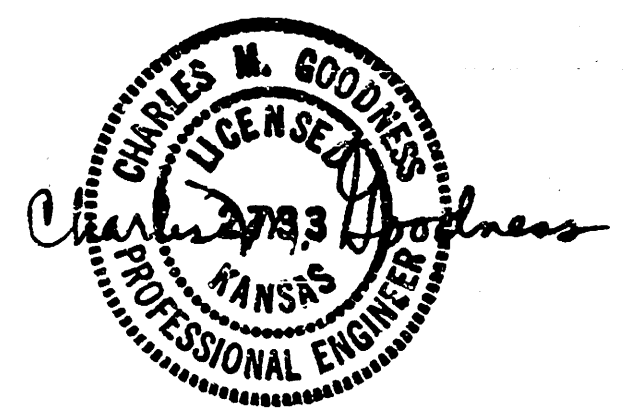


REISS & GOODNESS ENGINEERS
2100 WEST 21ST STREET
WICHITA, KANSAS 67203
(316) 838-0225

"AS CONSTRUCTED"

REVISION	DRAWN BY	CHECKED BY	DESIGNED BY	PROJECT	CUSTOMER	SCALE	PROJECT NO.
	DEJ	RP	RP			1/2"	DATE 10-28-88 SHEET 1 OF 5

FILMED FROM THE BEST AVAILABLE COPY....

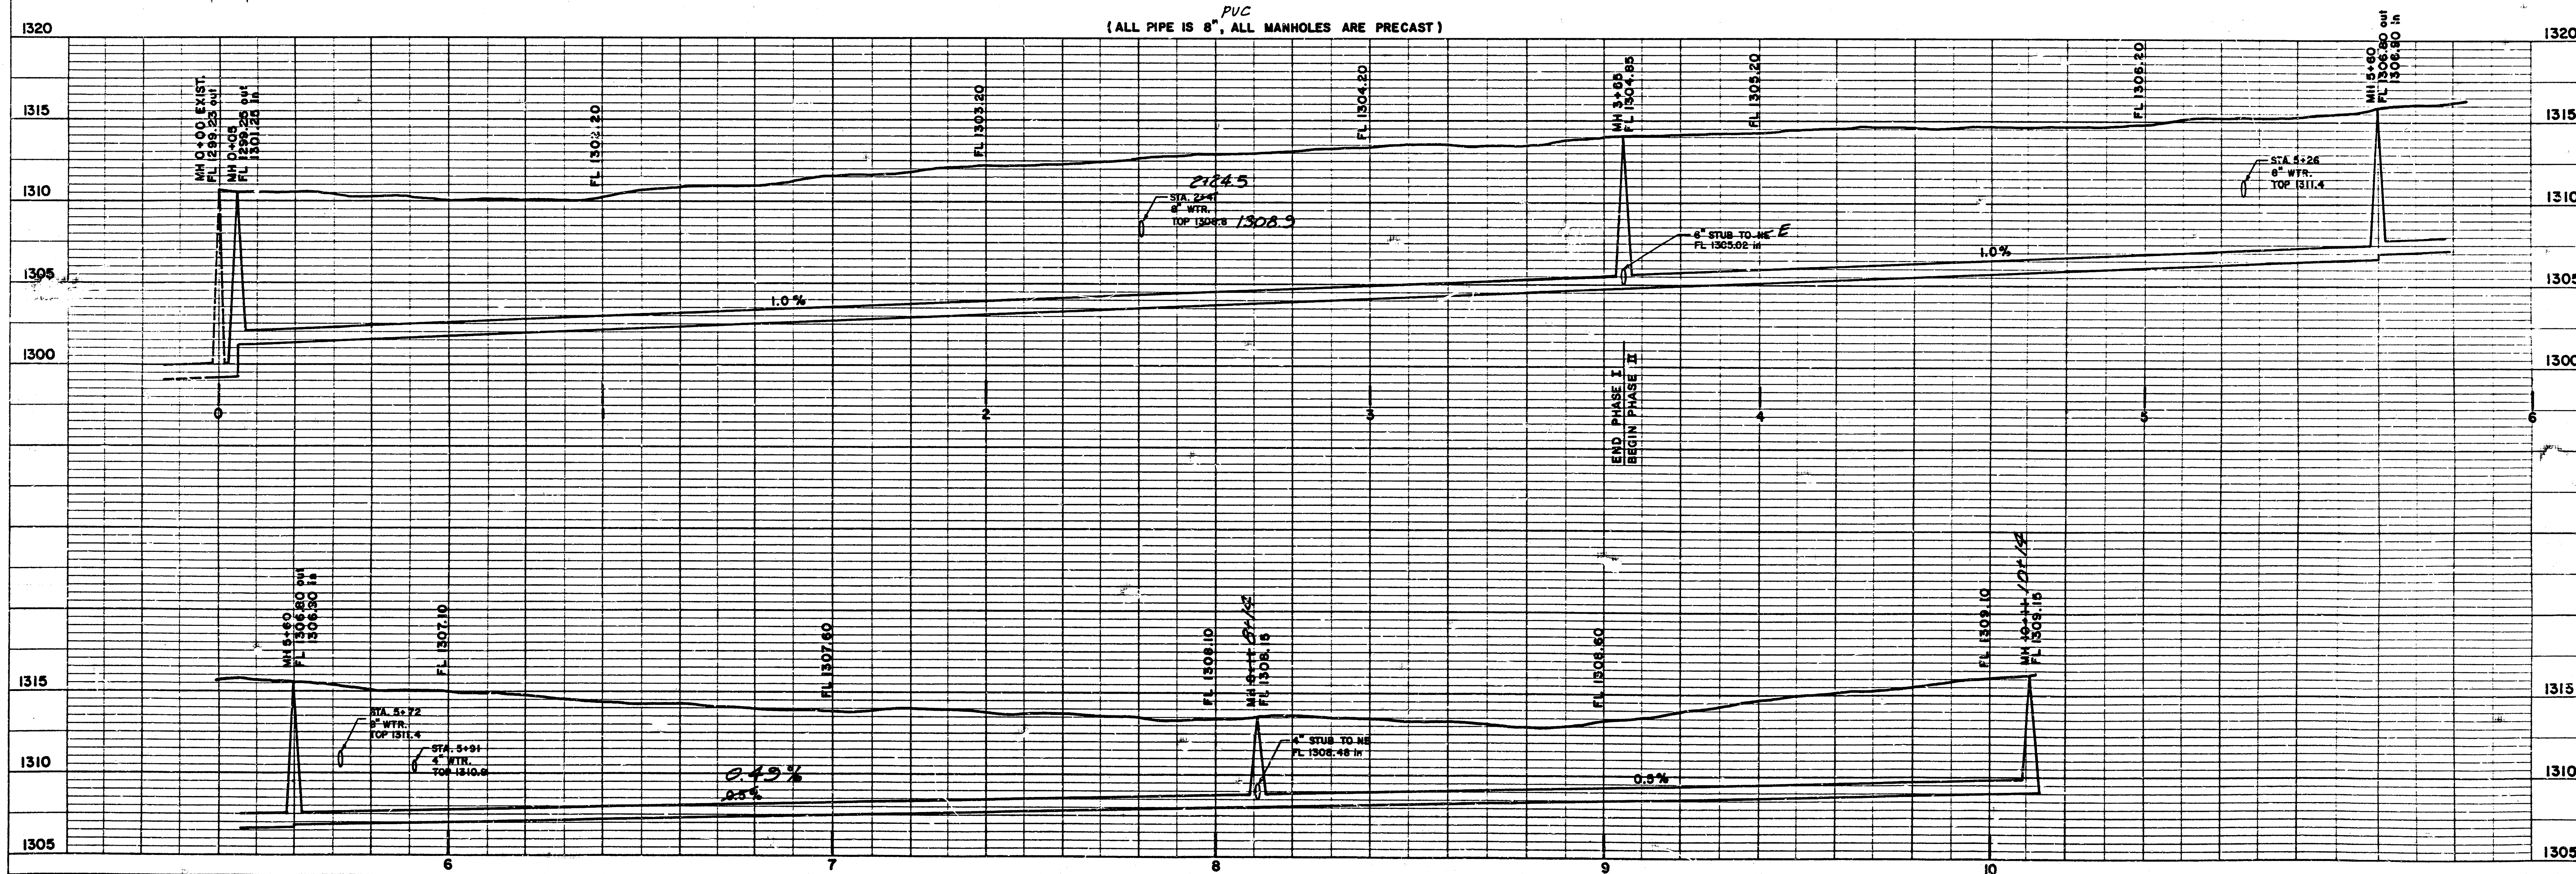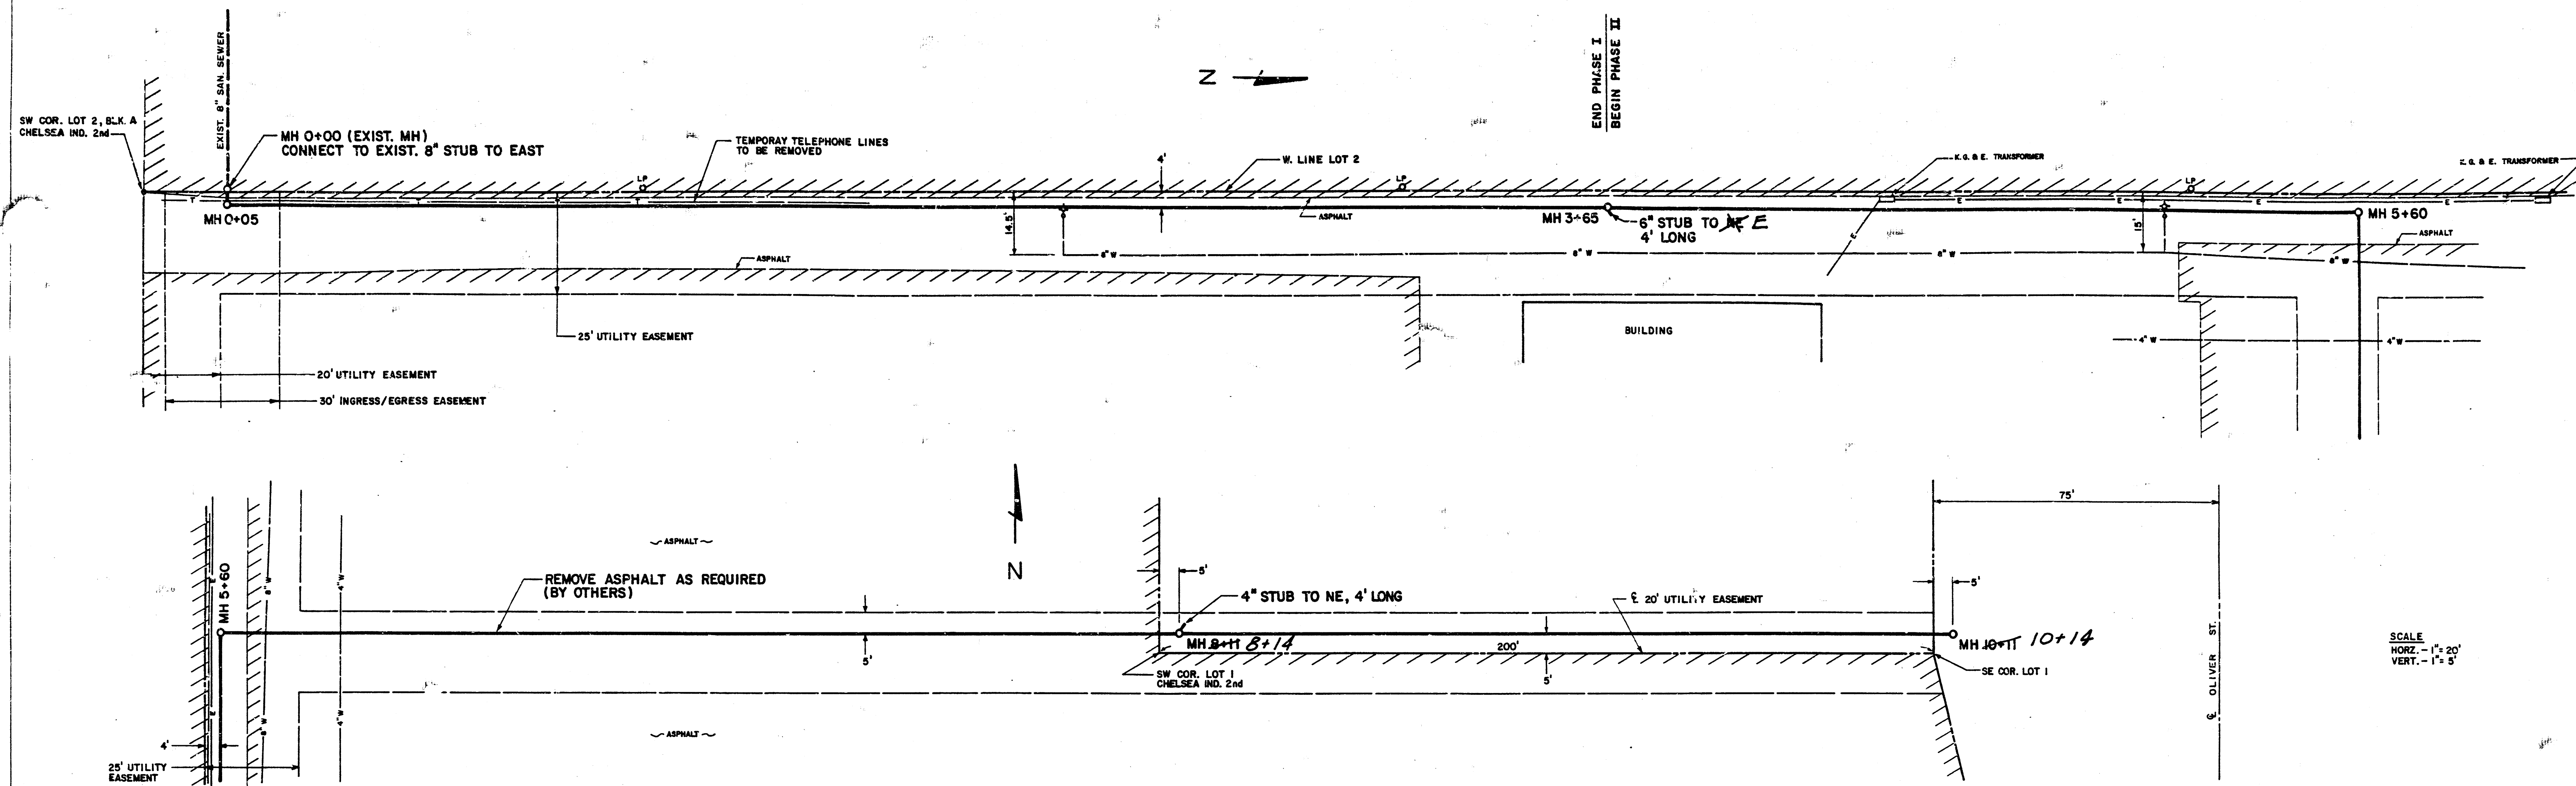

DEISS & GOODNESS ENGINEERS
2100 WEST 21ST STREET
WICHITA, KANSAS 67203
(316) 832-0225

REVISION	DRAWN BY	CHECKED BY	DESIGNED BY	PROJECT	CUSTOMER	SCALE NOTED	PROJECT NO.
	DEJ	RP	RP	SANITARY SEWER EXTENSIONS	LOTS 1 & 2, BLK. A, CHELSEA INDUSTRIAL 2nd	DATE 10-26-88	SHEET 2 OF 5

FILMED FROM THE BEST AVAILABLE COPY