
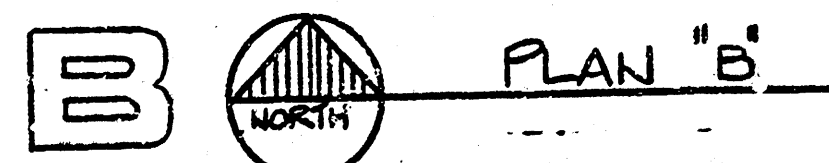
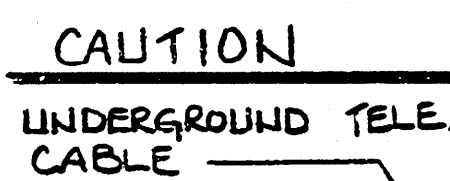


1. ALL NEW 8" SANITARY SEWER LINE AND NEW MANHOLES TO BE CONSTRUCTED IN ACCORDANCE WITH CITY OF WICHITA STANDARDS AND SPECIFICATIONS.
2. RIM ELEVATIONS OF MH#A1 & A-2 MAY BE ADJUSTED FROM THE TOP OF RIM (TR) ELEVATIONS SHOWN TO MATCH THE EXISTING GROUND ELEV.

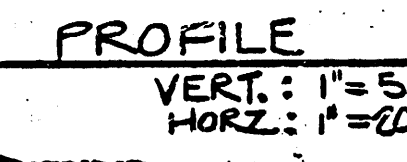

A SITE UTILITY PLAN

FOR CONSTRUCTION: 8/14/84.

A large, stylized, high-contrast black and white graphic of the letter 'K'. The letter is composed of thick, textured strokes, possibly representing a woodcut or a heavily inked print. It is set within a rectangular frame that also has a textured, slightly irregular border. The overall effect is graphic and bold.

A circular professional seal for Ben J. Kingdon, a Registered Architect in the State of Kansas. The seal features the text "REGISTERED ARCHITECT" along the top arc and "STATE OF KANSAS" along the bottom arc. In the center, the name "BEN J. KINGDON" is written above the year "1996". The seal is stamped in black ink on a white background.

**ALLIANCE LIFE
INSURANCE COMPANY
OFFICE BUILDING
WICHITA KANSAS
PROJECT NUMBER 7442**

KEY PLAN

SECRET

	SITE UTILITY PLAN	
	SHEET TITLE	SHEET NUMBER


$\frac{1}{2}$

100-443887-100

NOTES:








1. REFER TO PLUMBING PLANS FOR EXACT LOCATION AND ELEVATION OF UTILITIES AT THE BUILDING.
2. CONTRACTOR TO COORDINATE WITH UTILITY COMPANIES TO INSTALL NEW GAS AND NEW WATER METERS. CONTRACTOR TO PROVIDE METER VAULT, FAD, CONNECTIONS, ETC. AS REQUIRED BY UTILITY COMPANY.

LEGEND

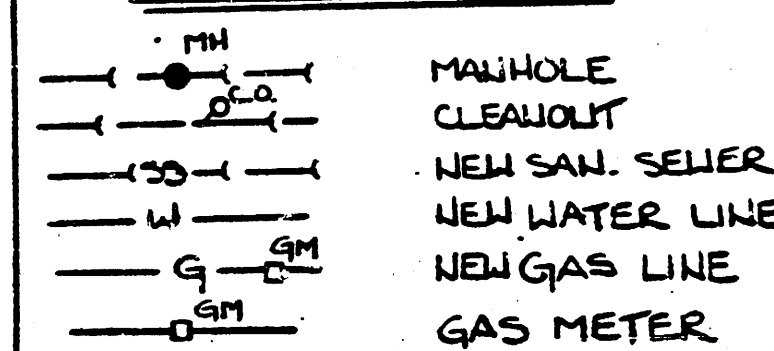

SEWER AND STORM SEWER
EXTENSION TO SERVE PART OF LOT 3.
CHELSEA NORTH ADDITION
City of Wichita

FILMED FROM THE BEST
AVAILABLE COPY.....

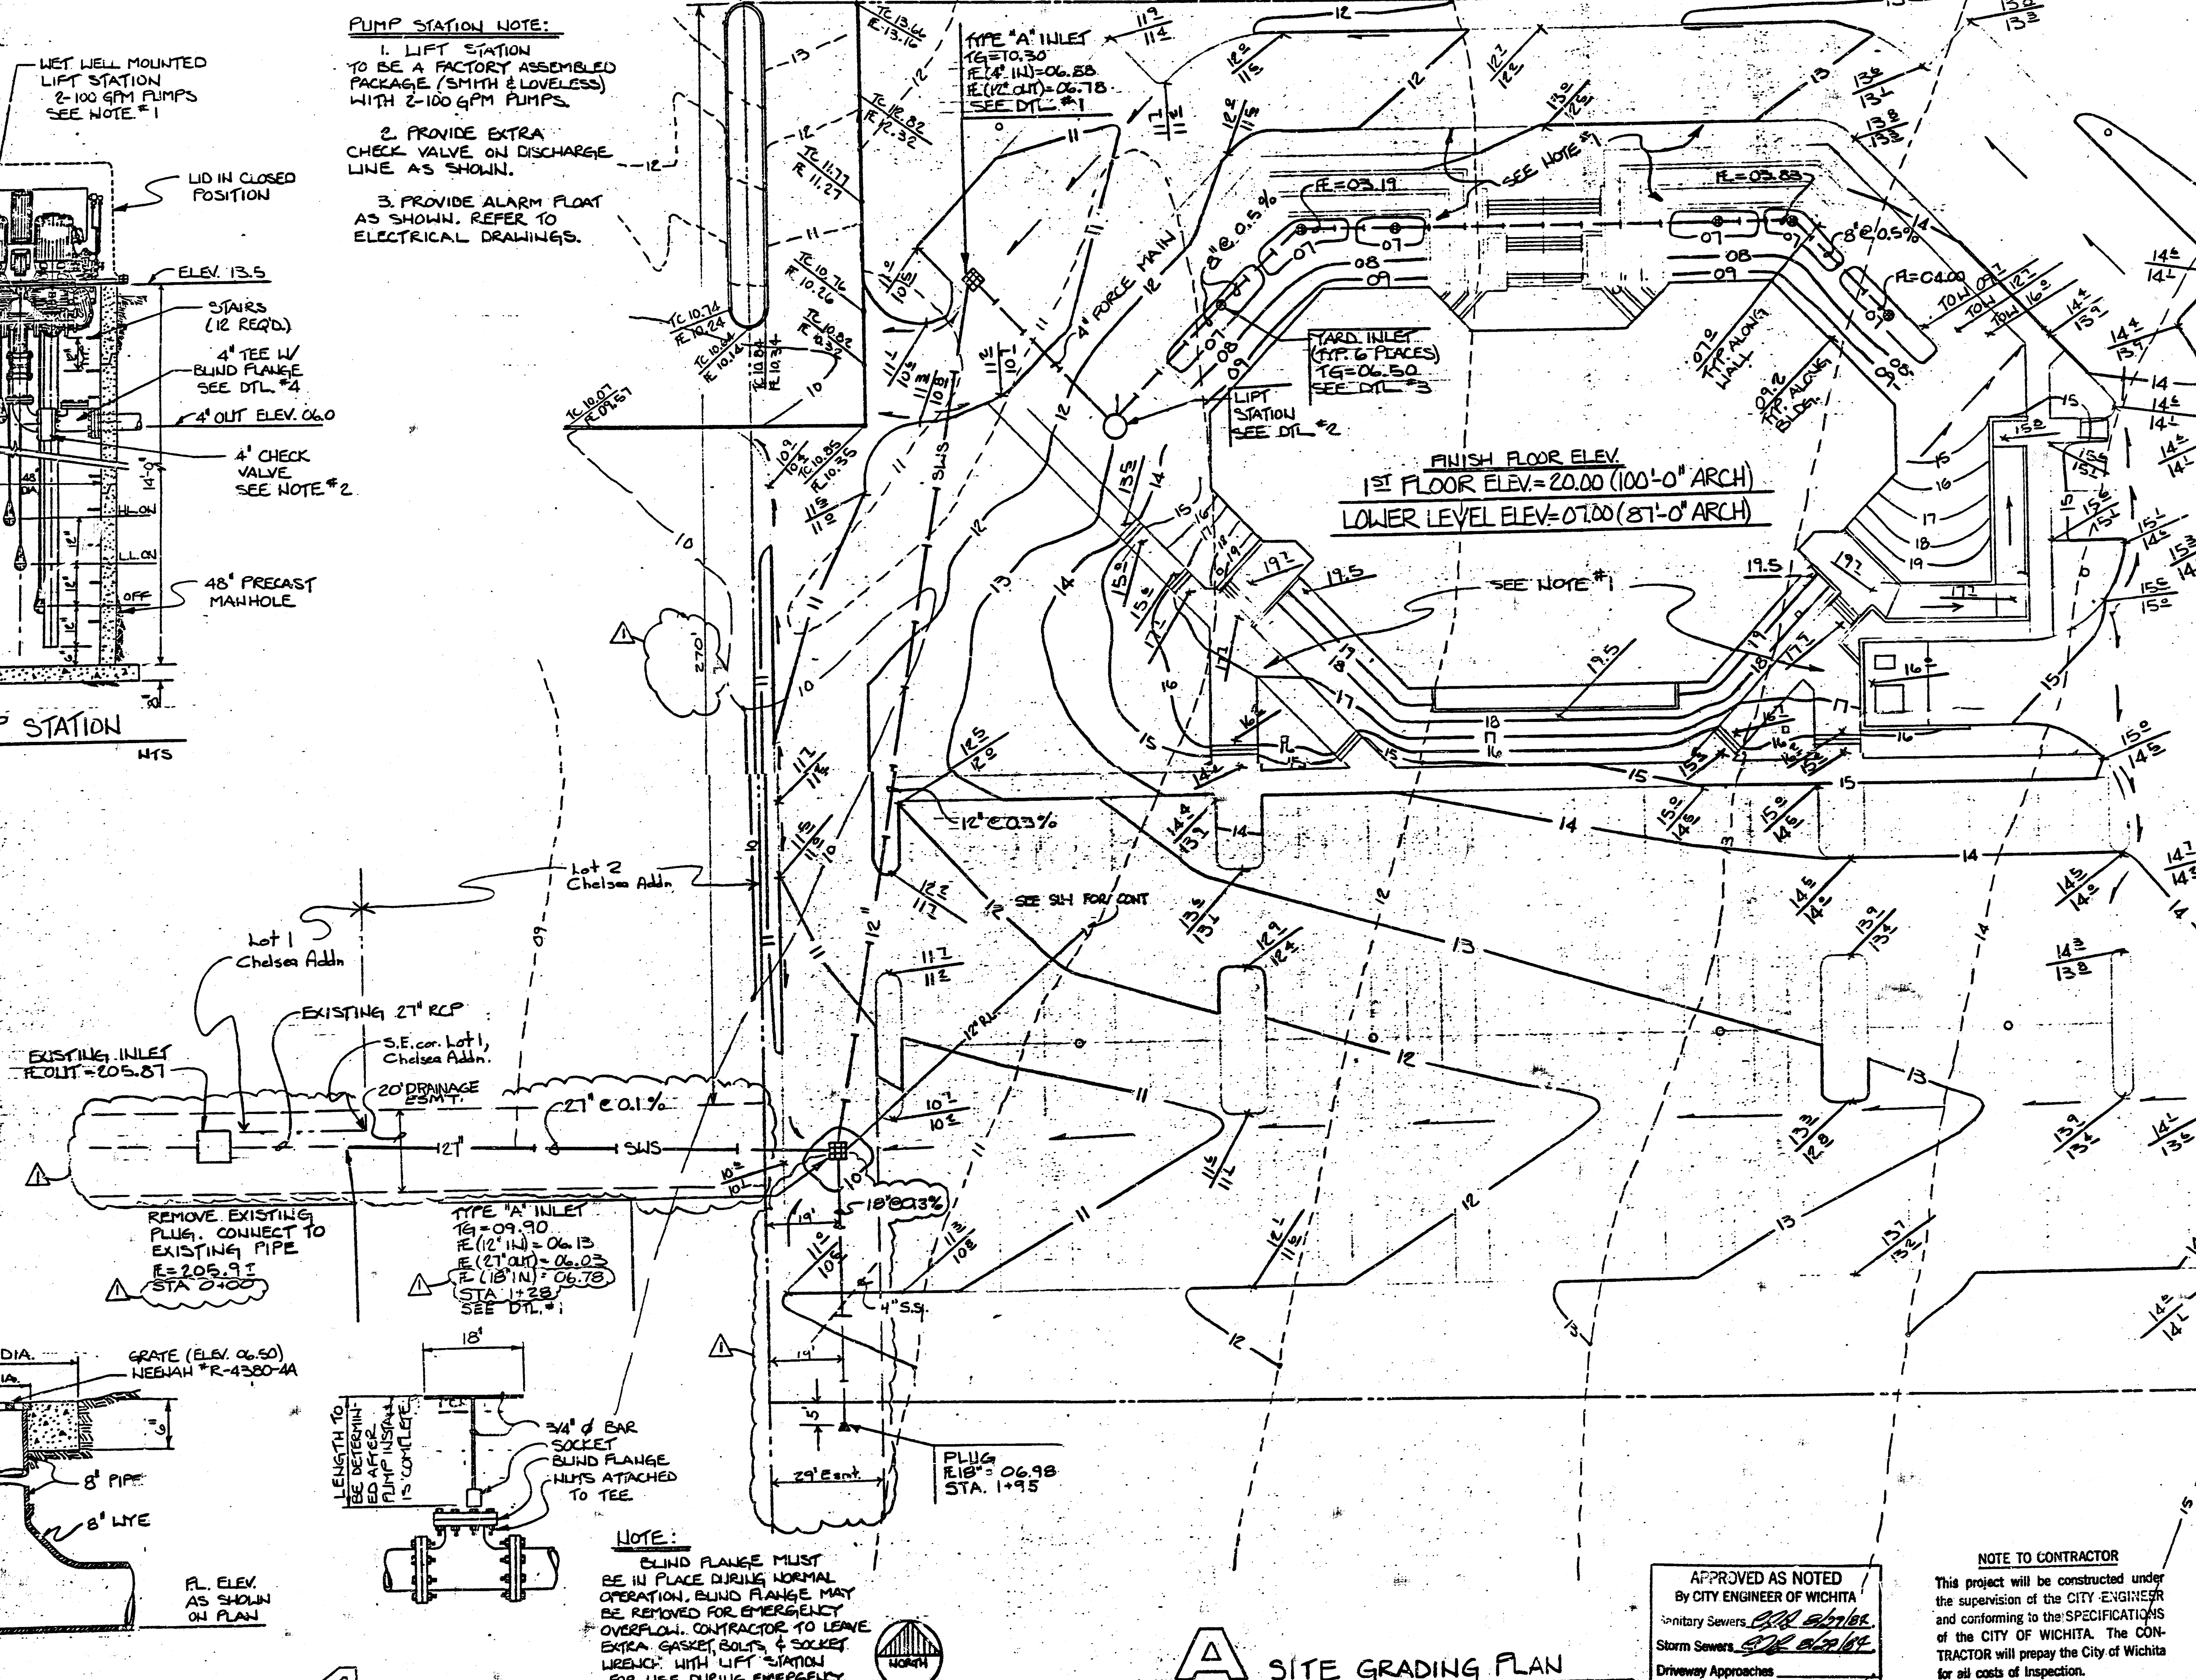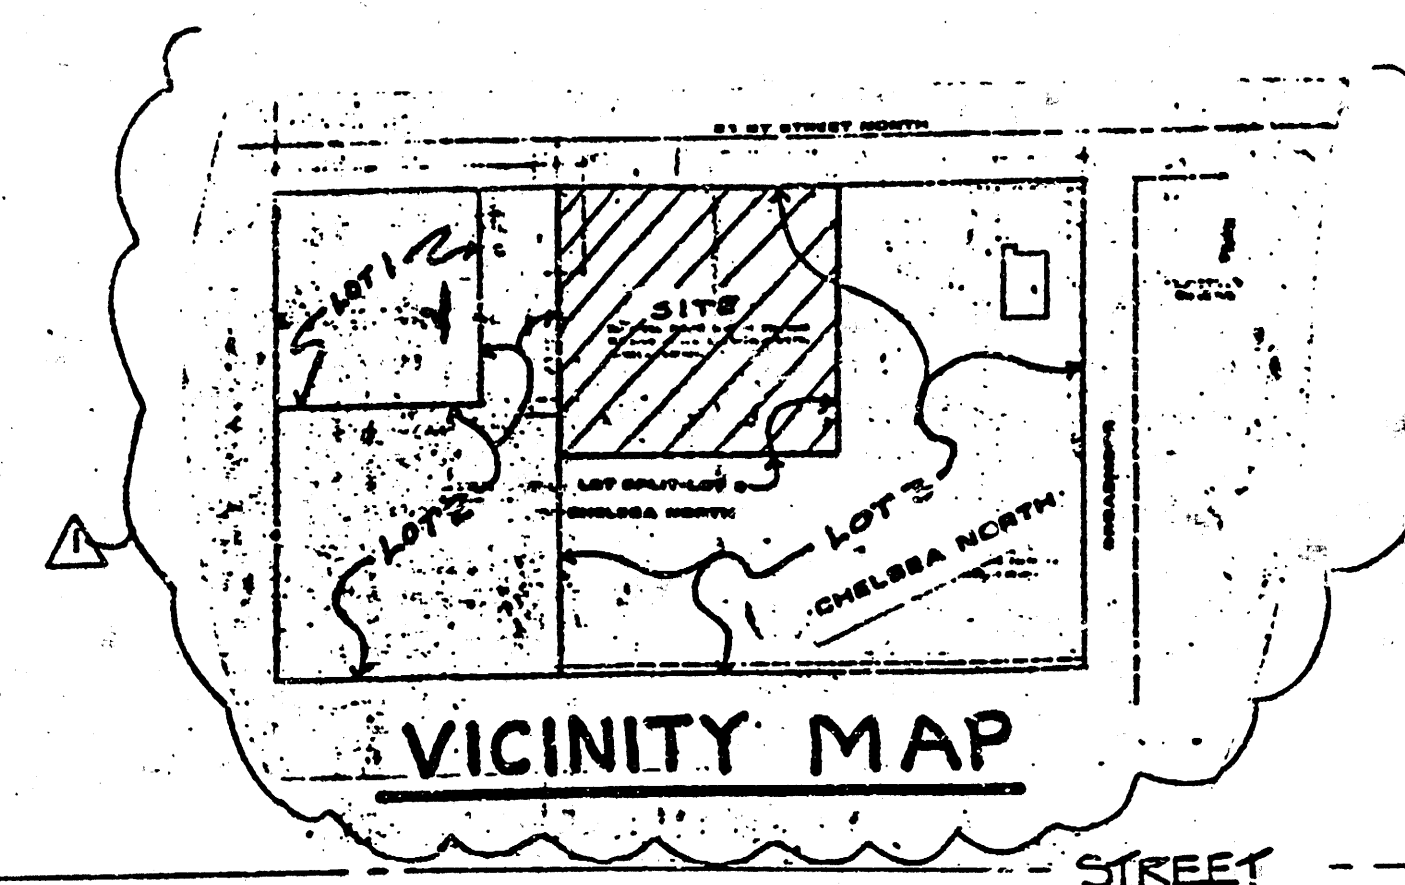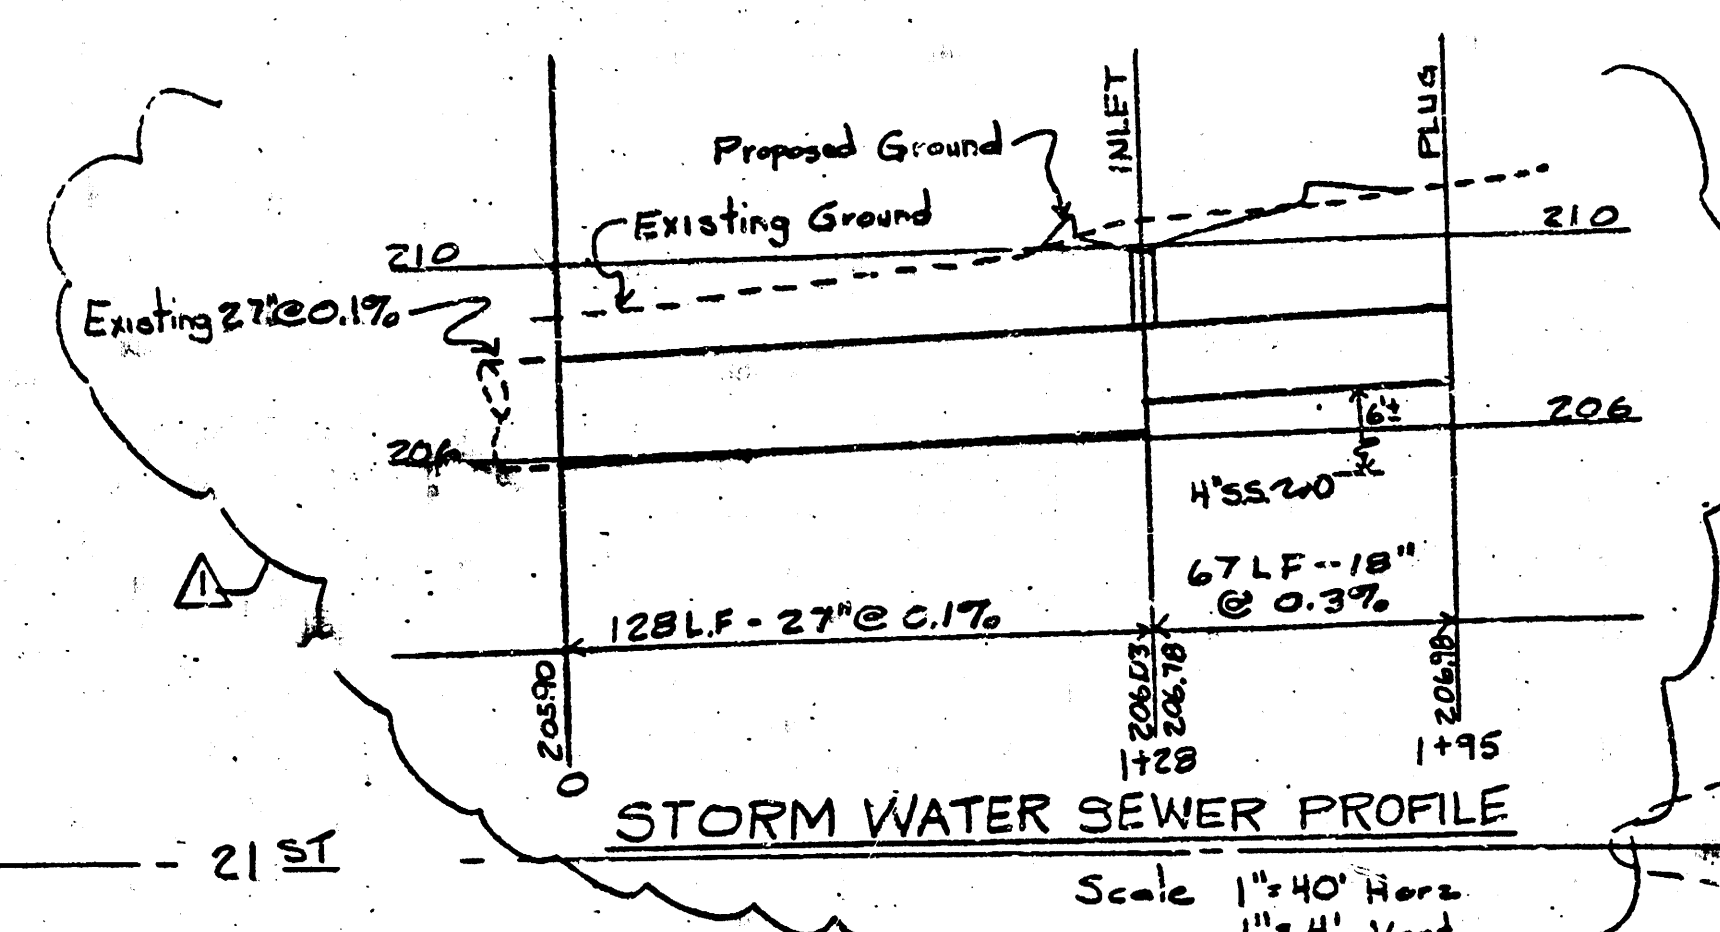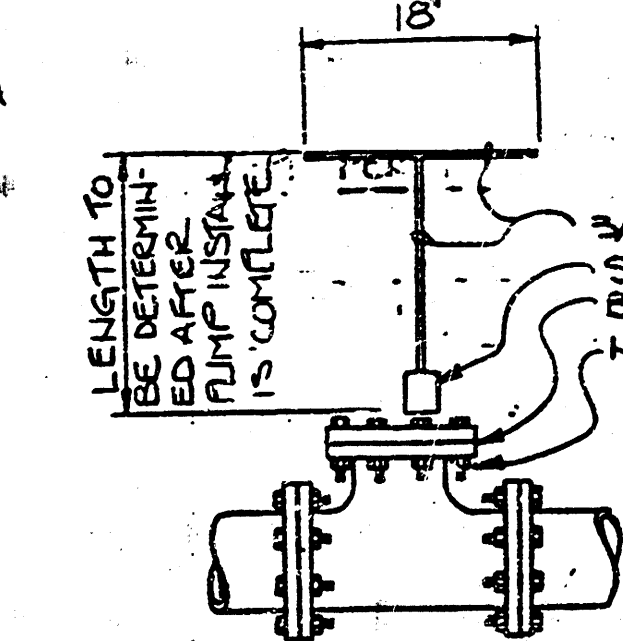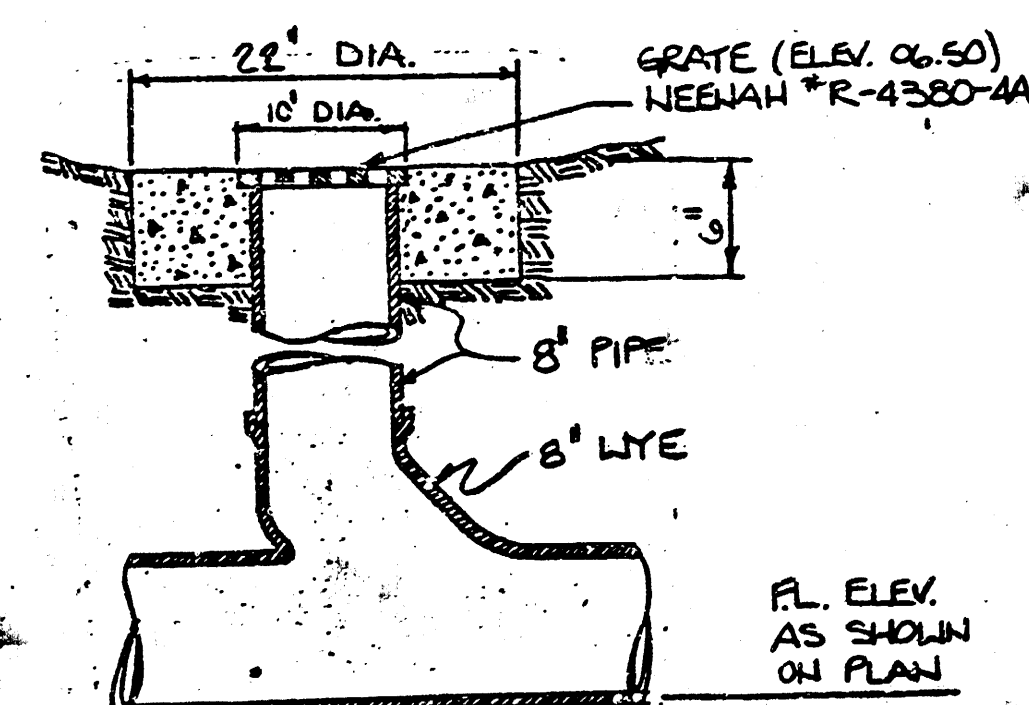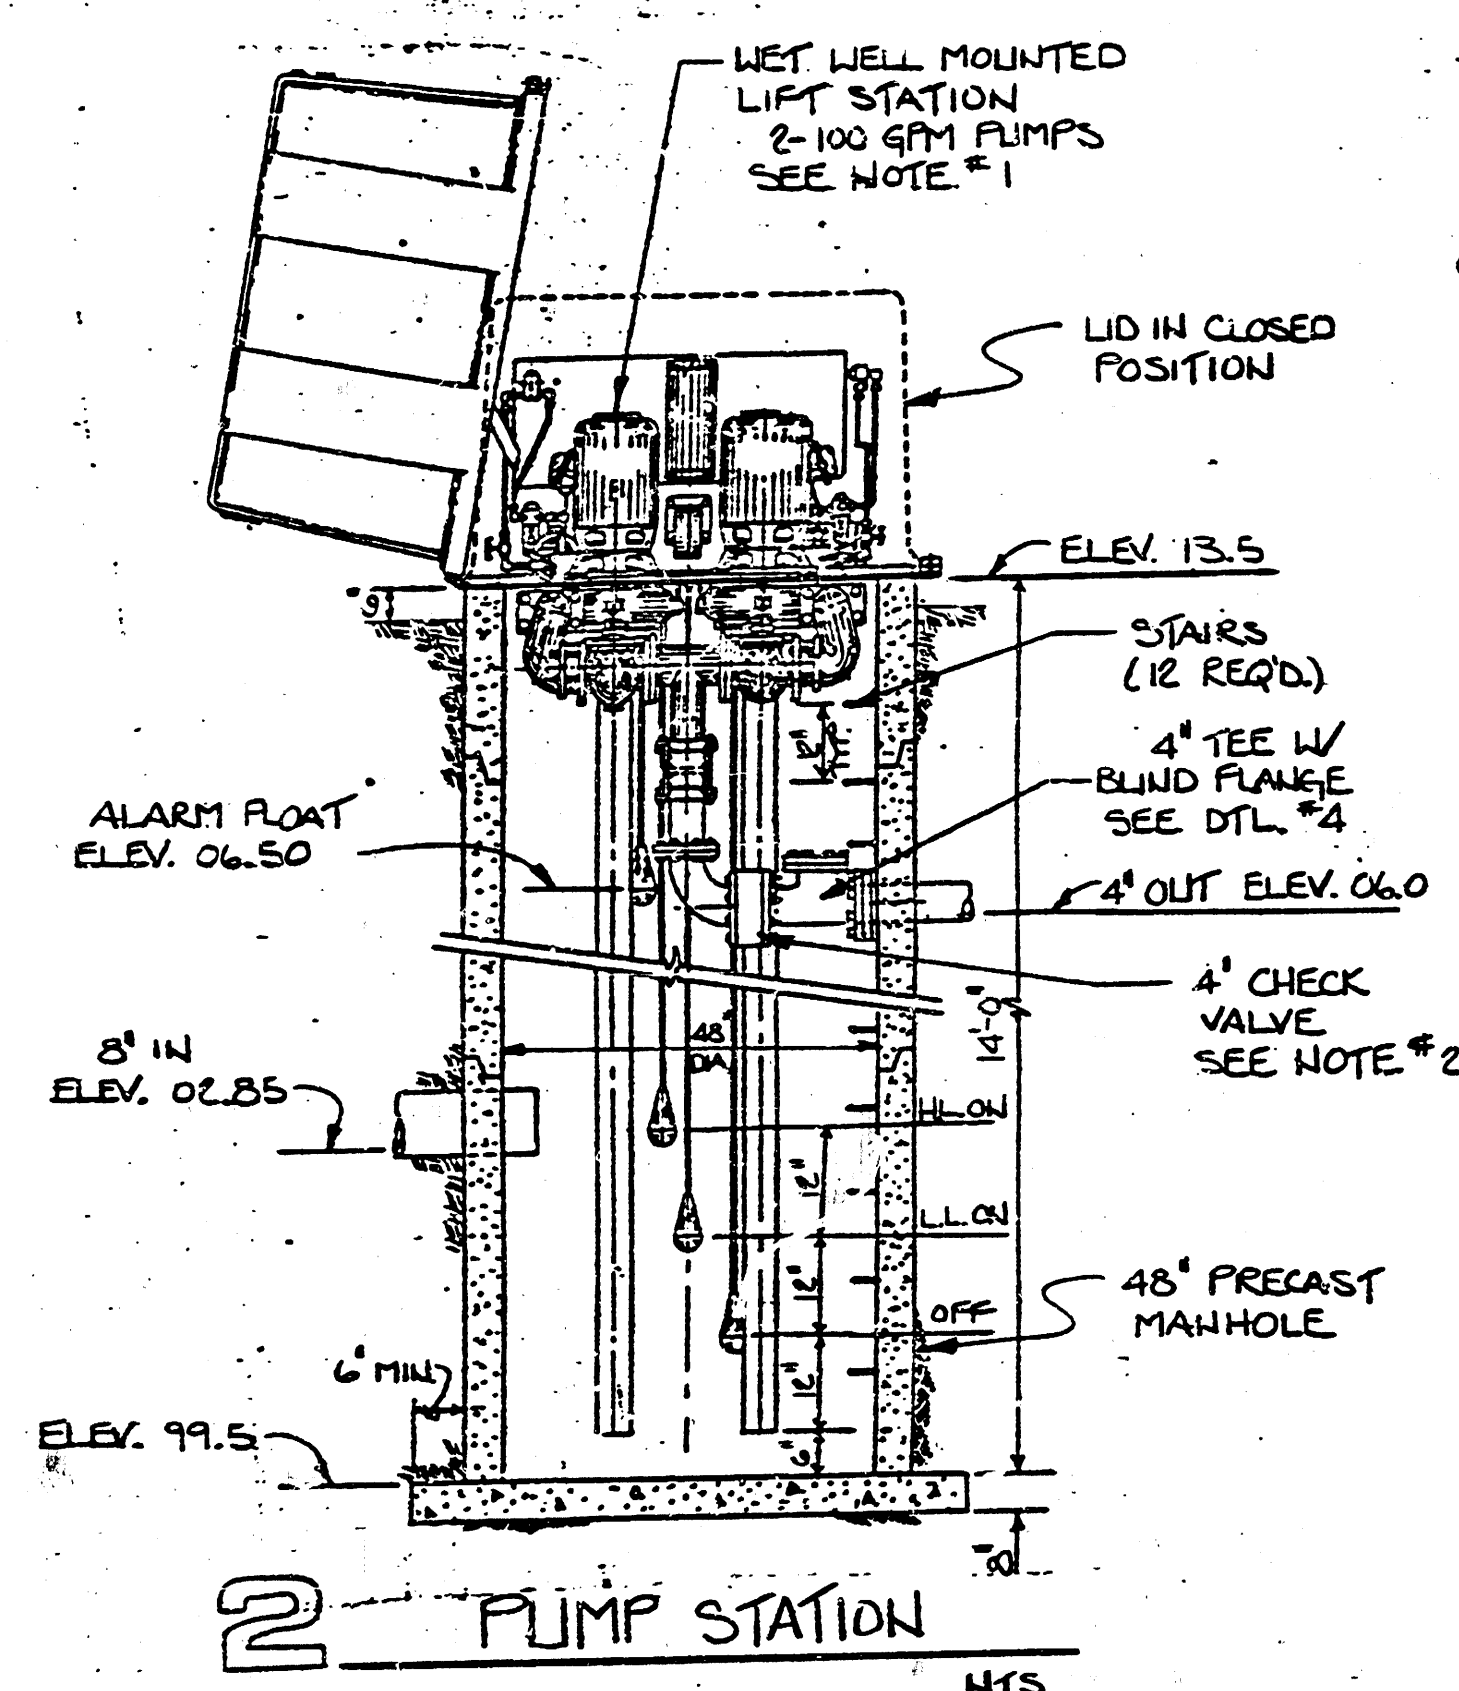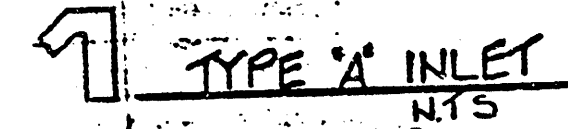

NOTE : -

1. REFER TO SHT. A2 FOR EXACT ELEVATIONS OF STAIRS, RETAINING WALLS, RAMPS, ETC. ADJACENT TO BUILDING OR WITHIN CURBED AREA. GRADES WITHIN THIS AREA ARE SHOWN FOR ROUGH GRADING ONLY.

LEGEND

EXIST.. CONTOUR
NEW CONTOUR
EXIST. STORM WTR. SEW.
NEW STORM WTR. SEW.
INLET
EXIST. SPOT ELEV.
NEW SPOT ELEV.
TOP OF CURB
FLOWLINE
DRAINAGE ARROW
TOP OF WALL

APPROVED AS NOTED
By CITY ENGINEER OF WICHITA
Sanitary Sewers CE 6/27/64
Storm Sewers CE 6/27/64
Driveway Approaches

NOTE TO CONTRACTOR

This project will be constructed under the supervision of the CITY ENGINEER and conforming to the SPECIFICATIONS of the CITY OF WICHITA. The CONTRACTOR will prepay the City of Wichita for all costs of inspection.

SANITARY SEWER AND STORM SEWER
EXTENSION TO SERVE PART OF LOT 3,
CHELSEA NORTH ADDITION
City of Wichita
Project 2 155-244-80000


FILMED FROM THE BEST
AVAILABLE COPY

[illegible]

FOR CONSTRUCTION: 2/14/84

[illegible]

LAW/KINGDON, INC.
ARCHITECTS & ENGINEERS
348 EVERVIEW, WICHITA, KANSAS 67203
Phone: (316) 268-6220 CARRIER © 1987

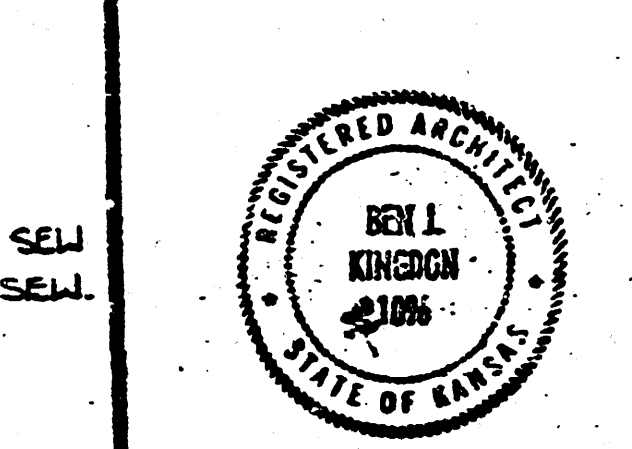

DRAWN		CHECKED	
DPI			
RELATED DRAWINGS			
SHELL			
DETAILS			
STRUCTURE			
MECHANICAL			
ELECTRICAL			
OTHER			
SEQUENCE NUMBER			

**ALLIANCE LIFE
INSURANCE COMPANY
OFFICE BUILDING
WICHITA KANSAS
PROJECT NUMBER 7442**

[illegible]

KEY PLAN

SITE GRADING P.

STATE OF NEW YORK
IN SENATE
JANUARY 11, 1911.

6/18		5000
------	--	------

1

1 2/ SSG

 $\frac{1}{2}$ 222

4