




- LEGEND**
- POWER POLE
 - EXIST. SAN. SEWER
 - PROPOSED SAN. SEWER W/ M.H.
 - CLEAN-OUT
 - PROPOSED WATER
 - PROPOSED WATER VALVE
 - PROPOSED FIRE HYDRANT W/ VALVE
 - UNDERGROUND BLEC. SEAW
 - TRANSFORMER

NOTES

1. M.H.'S TO BE CONCT. AS PER CITY STDS. & SPECS.
2. SAND FILL & FLUSH SAN. SEWER & WATER LINE DITCHES.
3. TOP OF M.H. TO BE ESTABLISHED BY FINISHED GRADE.
4. M.H.'S TYPE A STD. UNLESS OTHERWISE NOTED.

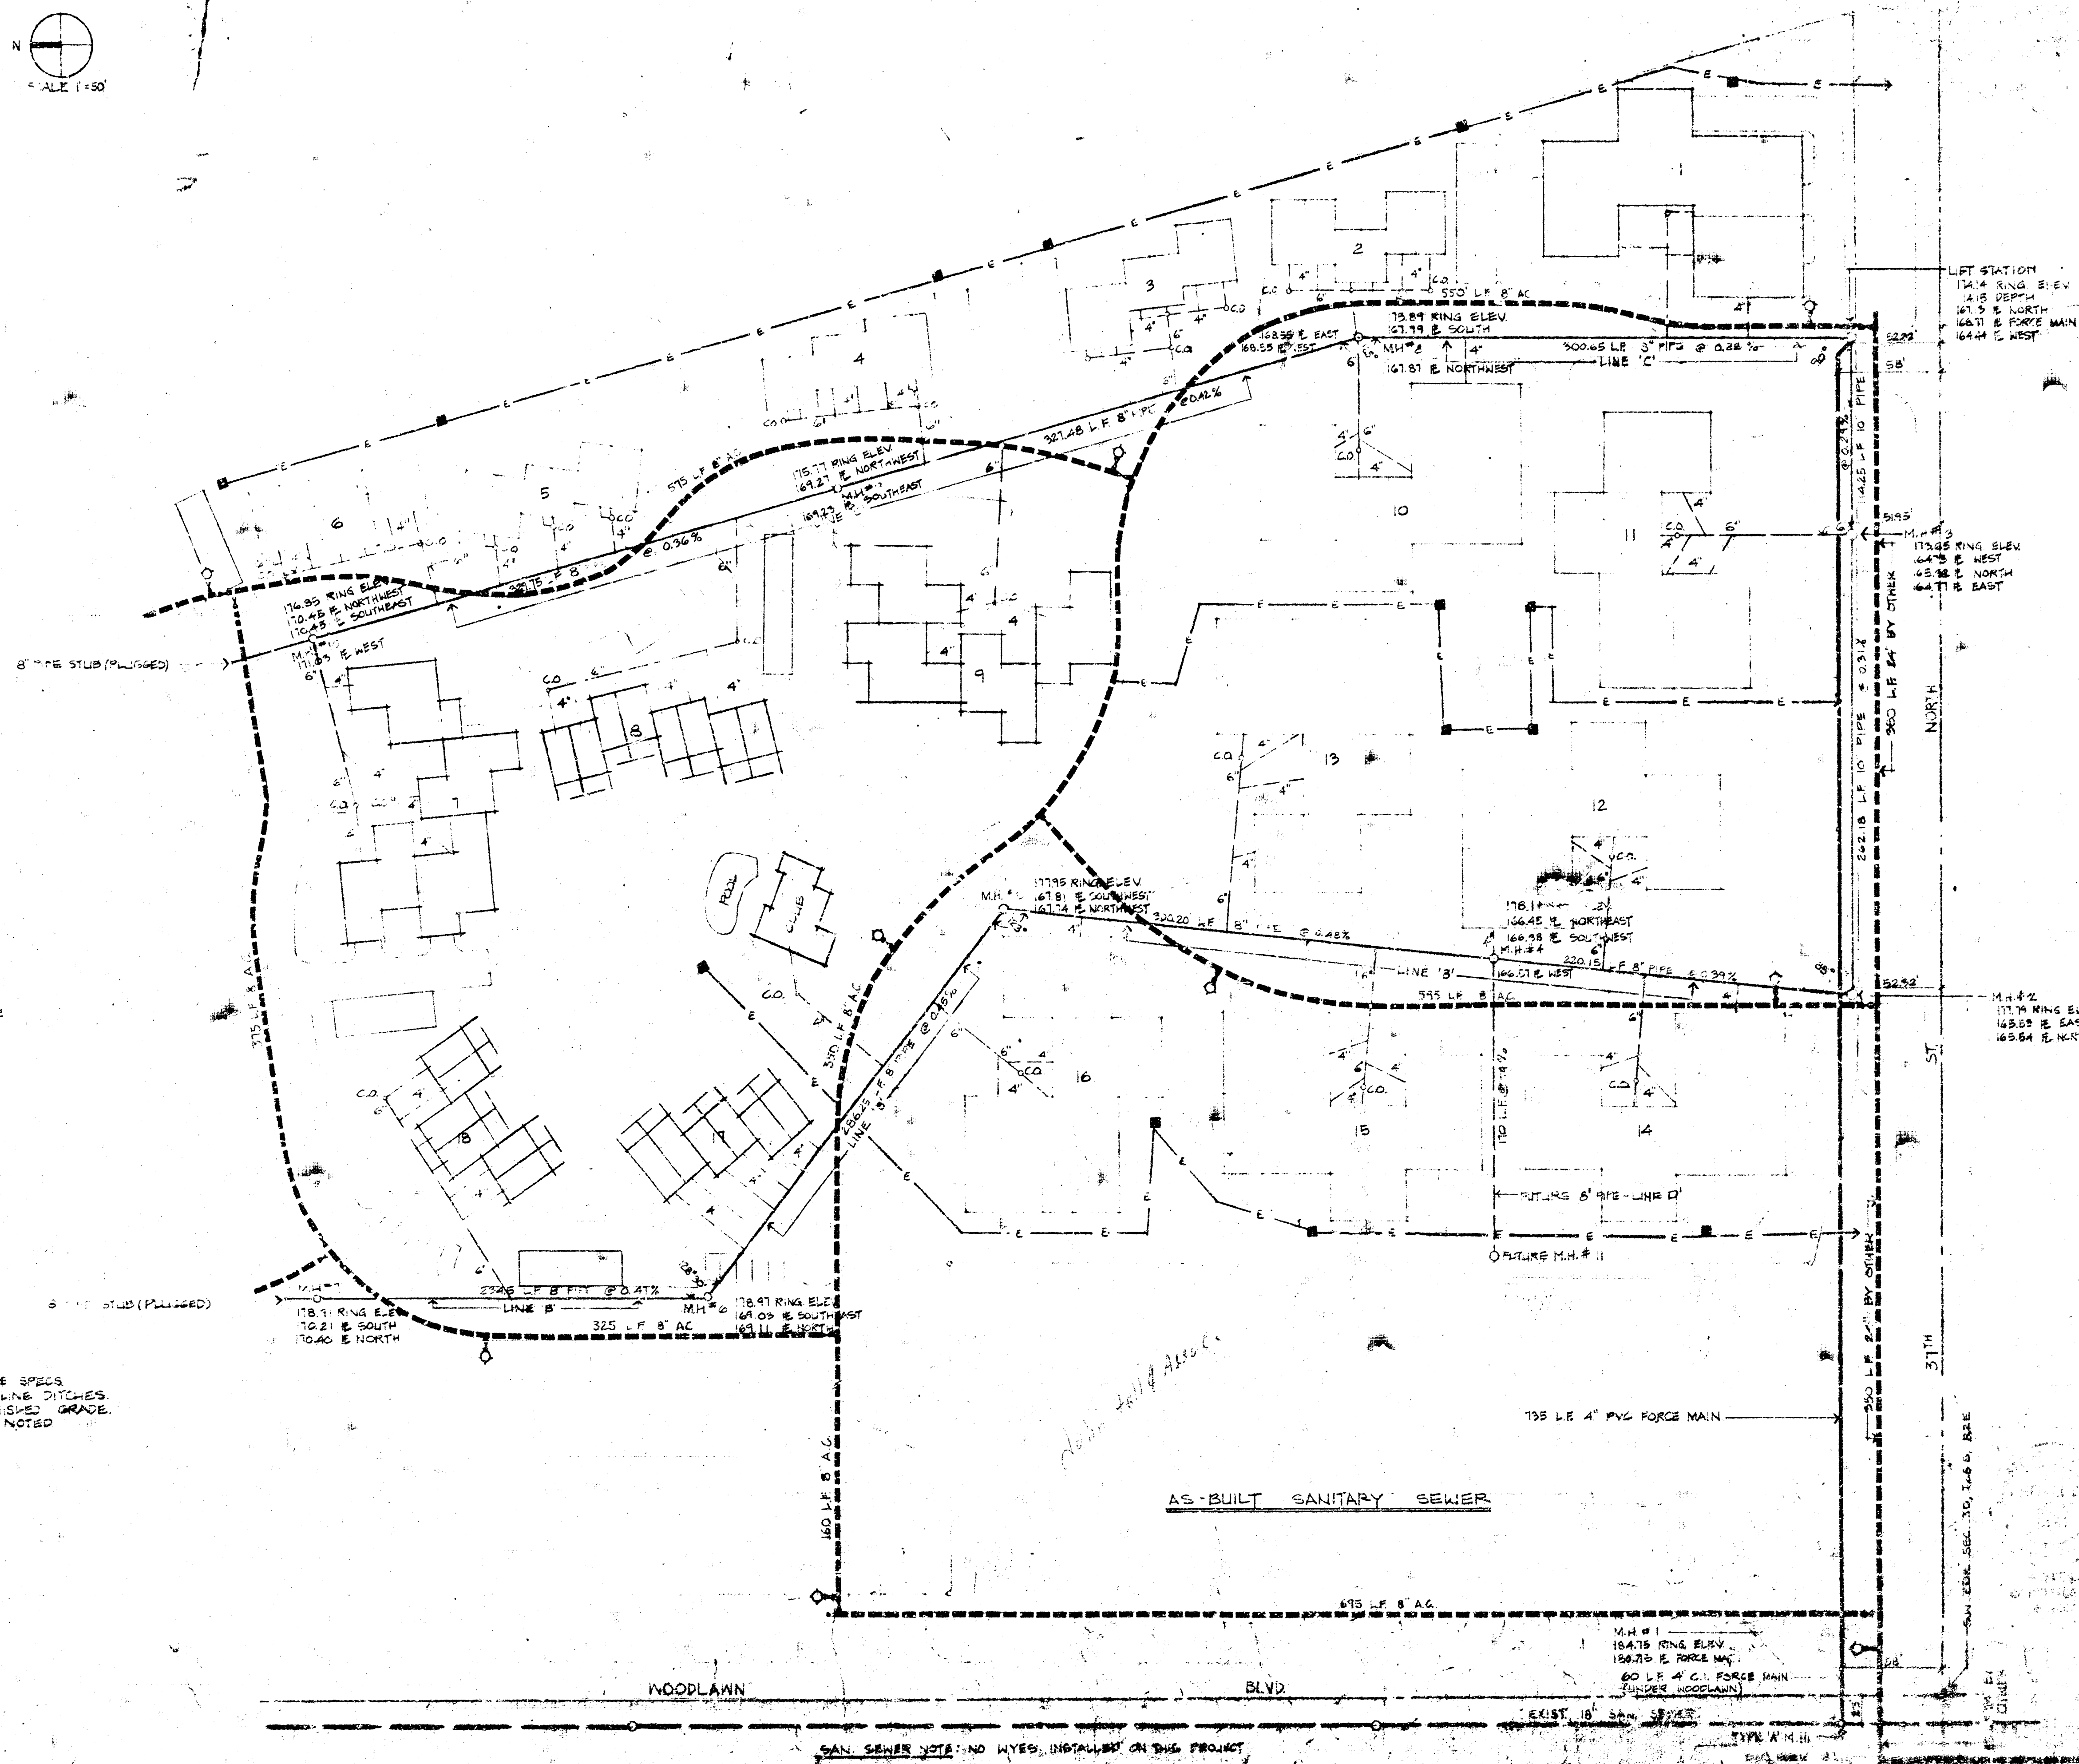

CHISHOLM CREEK - UTILITY PLAN
REVISION 7/2/78
CHISHOLM CREEK