

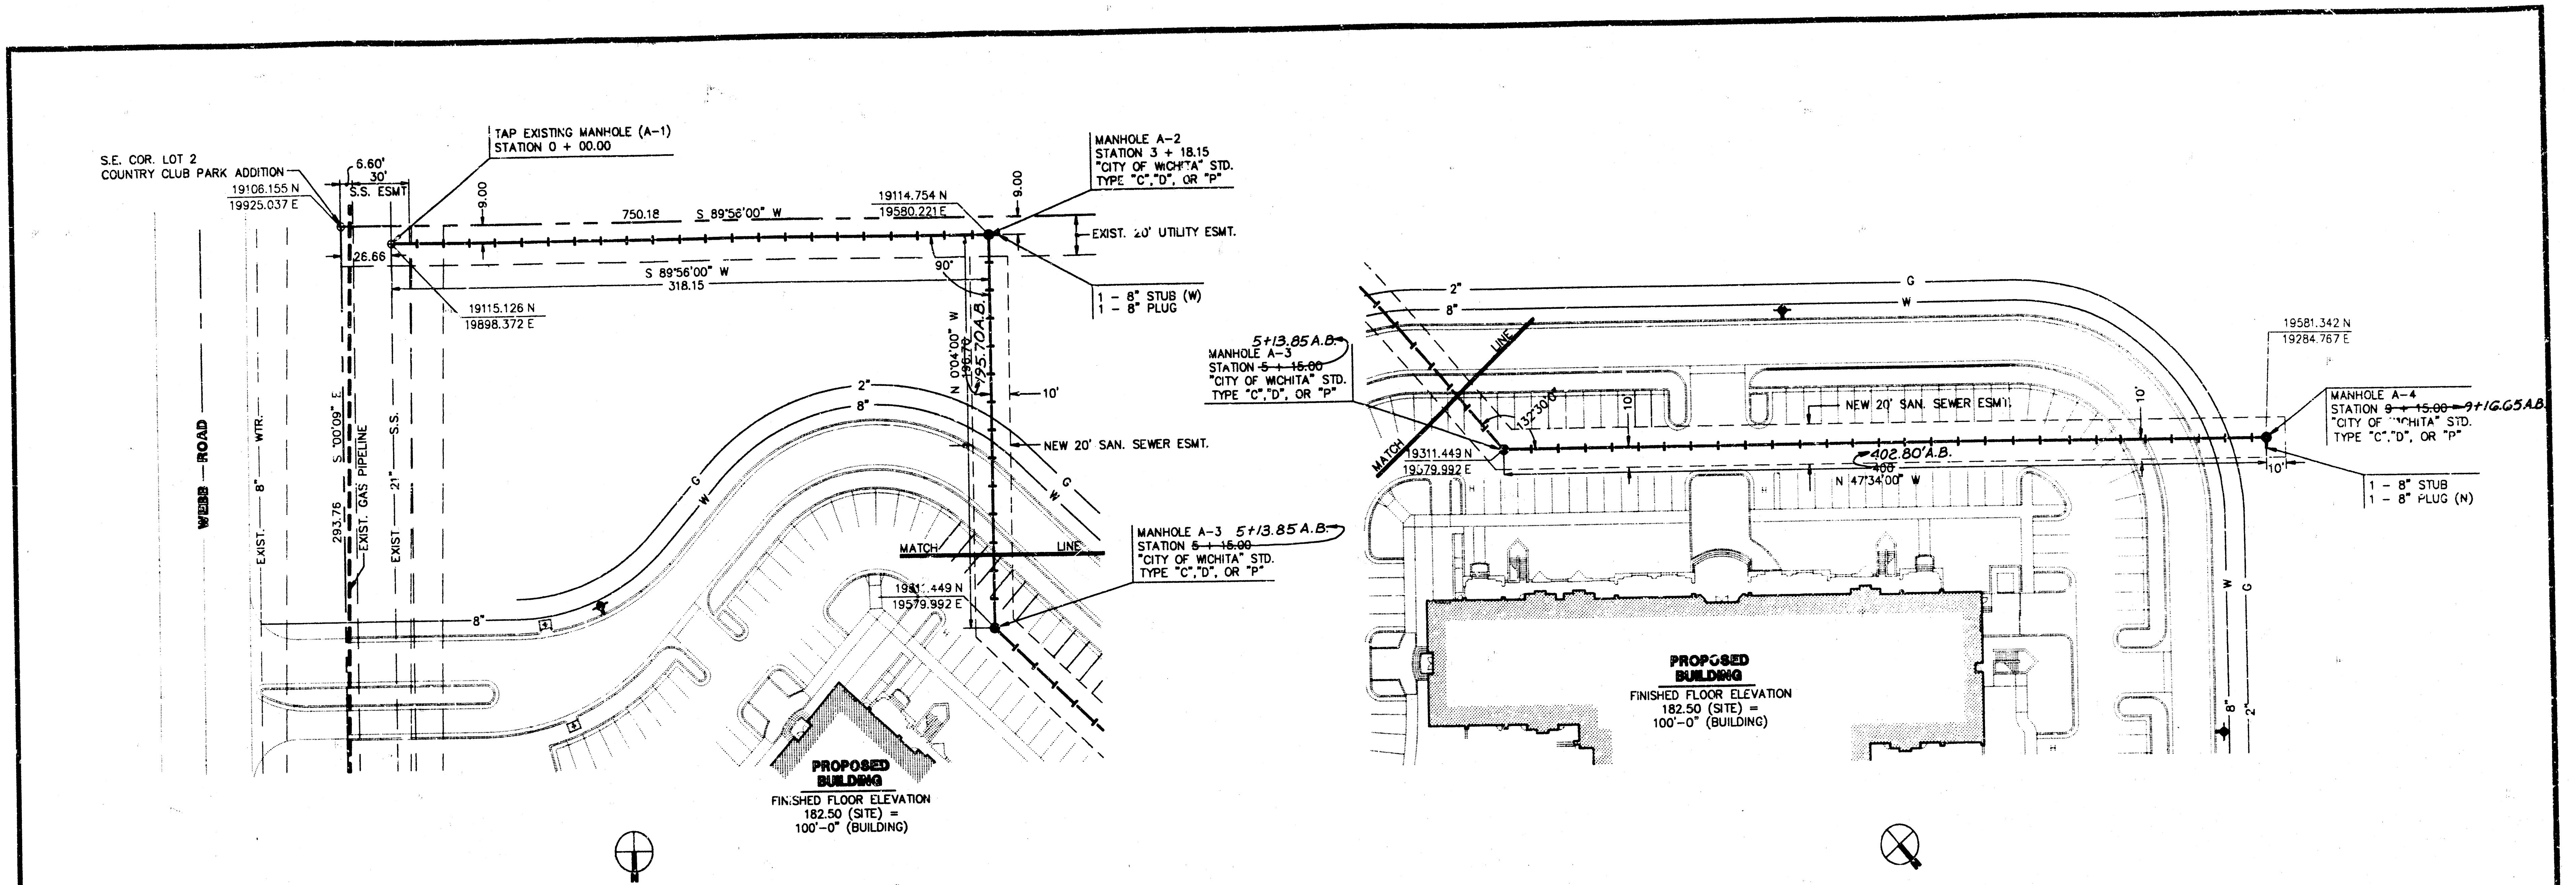


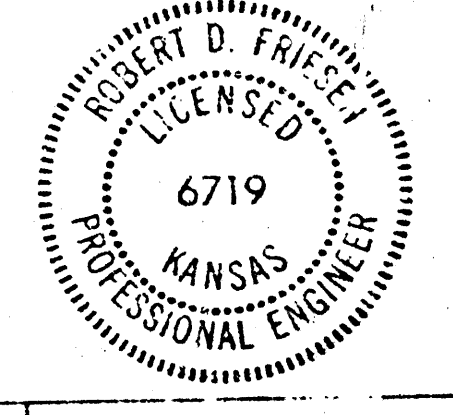

A SANITARY SEWER PLAN AND PROFILE

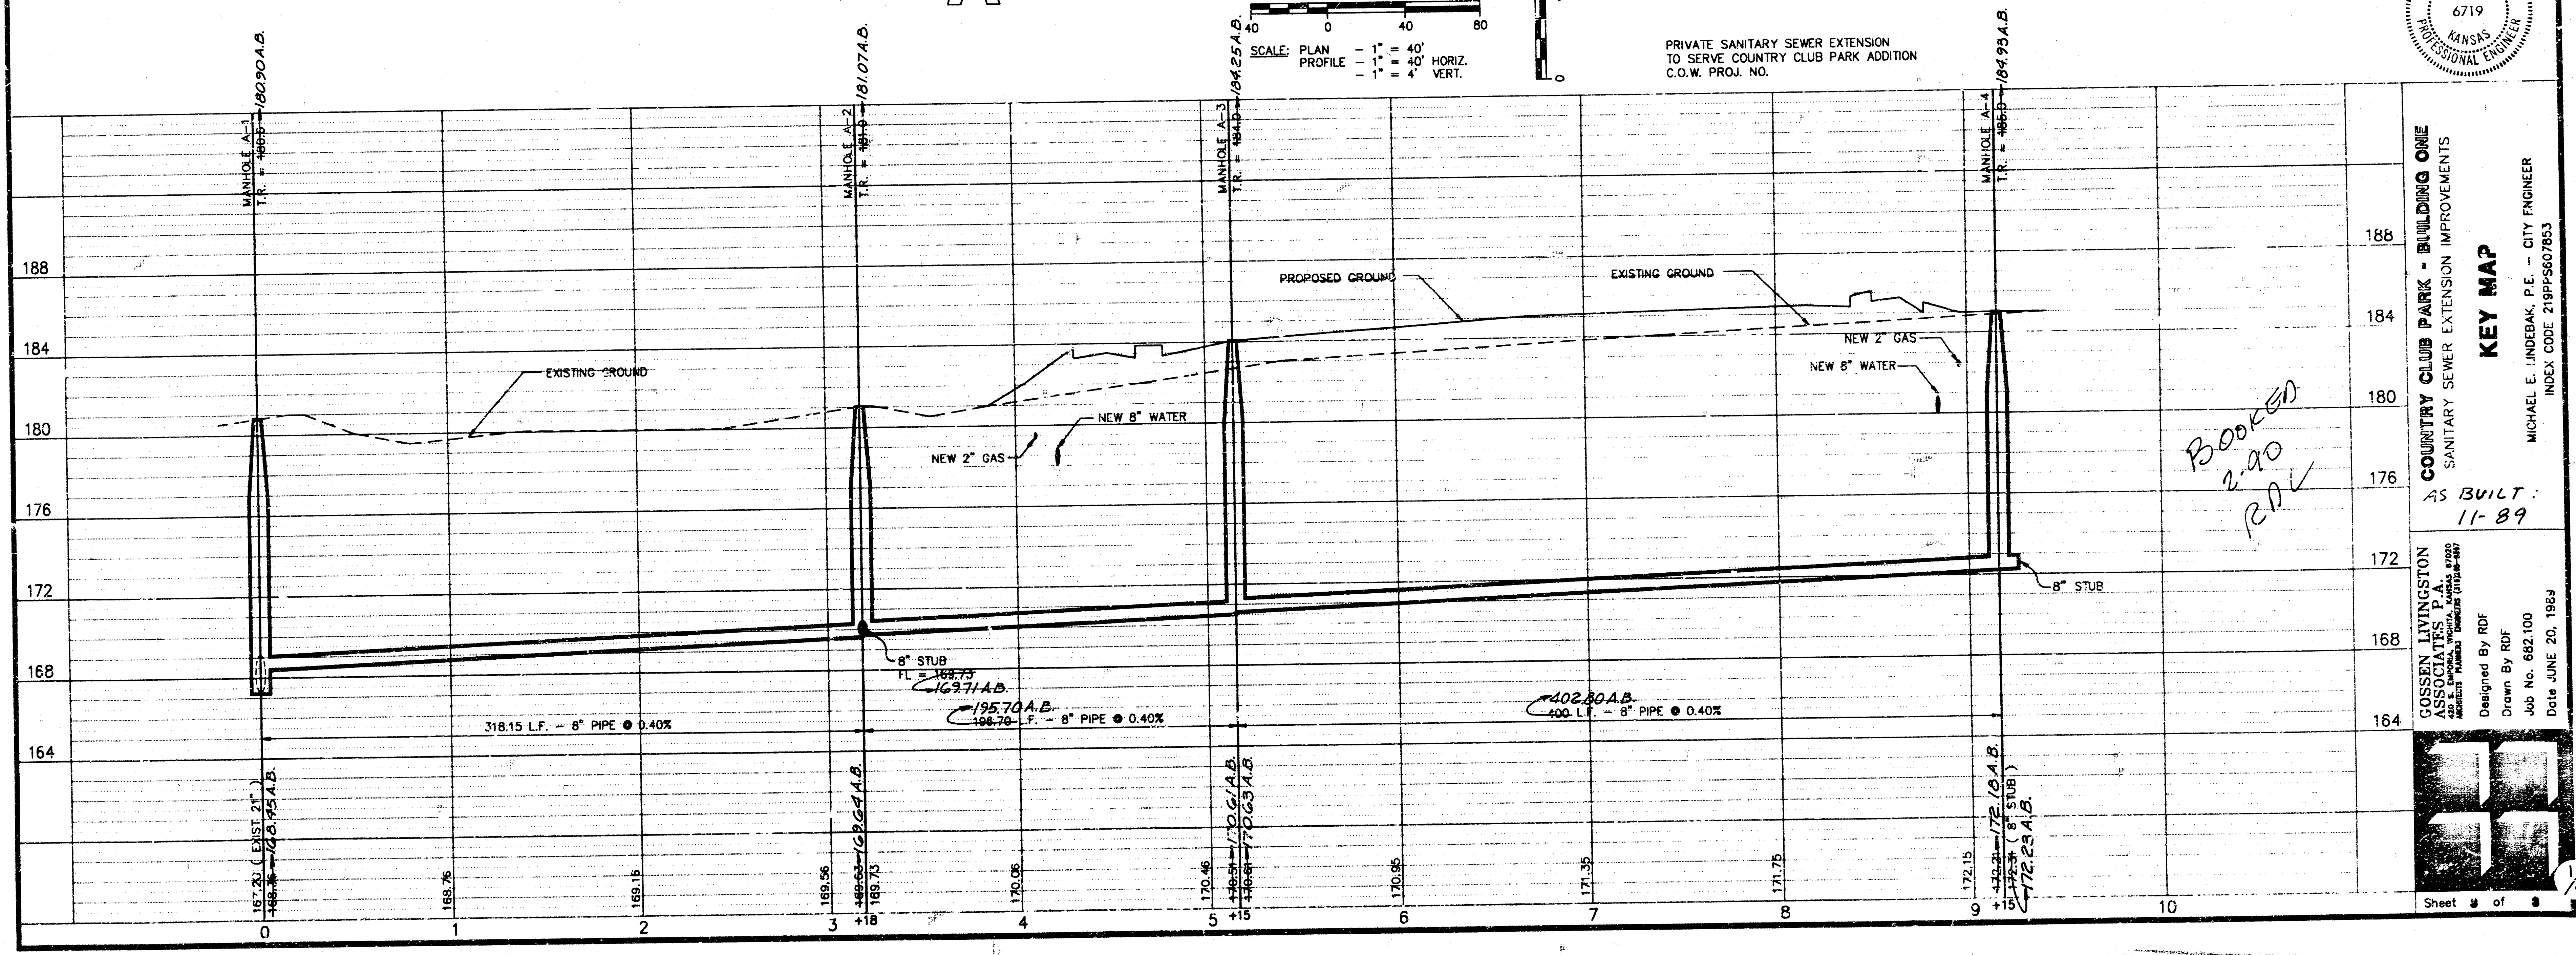

KEY MAP

COUNTRY CLUB PARK - BUILDING ONE
SANITARY SEWER EXTENSION IMPROVEMENTS
AS BUILT:
11-89

COSSEN LIVINGSTON
COSCIATTES, P.A.
230 E. WILSON, SUITE 200, LAWRENCE, KANSAS 66044
ARCHITECT: MICHAEL E. INDEBAK, P.E.


Designed By RBF
Drawn By RBF
Job No. 682.100
Date: JUNE 20, 1983

Sheet 3 of 3

CONSTRUCTION PLANS FOR SANITARY SEWER EXTENSION IMPROVEMENTS TO SERVE COUNTRY CLUB PARK ADDITION TO

THE CITY OF WICHITA,
SEDGWICK COUNTY, KANSAS
MICHAEL E. LINDEBAK, P.E. - CITY ENGINEER

APPROVED AS NOTED
By CITY ENGINEER OF WICHITA
Sanitary Sewers 2-10-89
Storm Sewers _____
Driveway Approaches _____
Water Mains _____
Paving _____

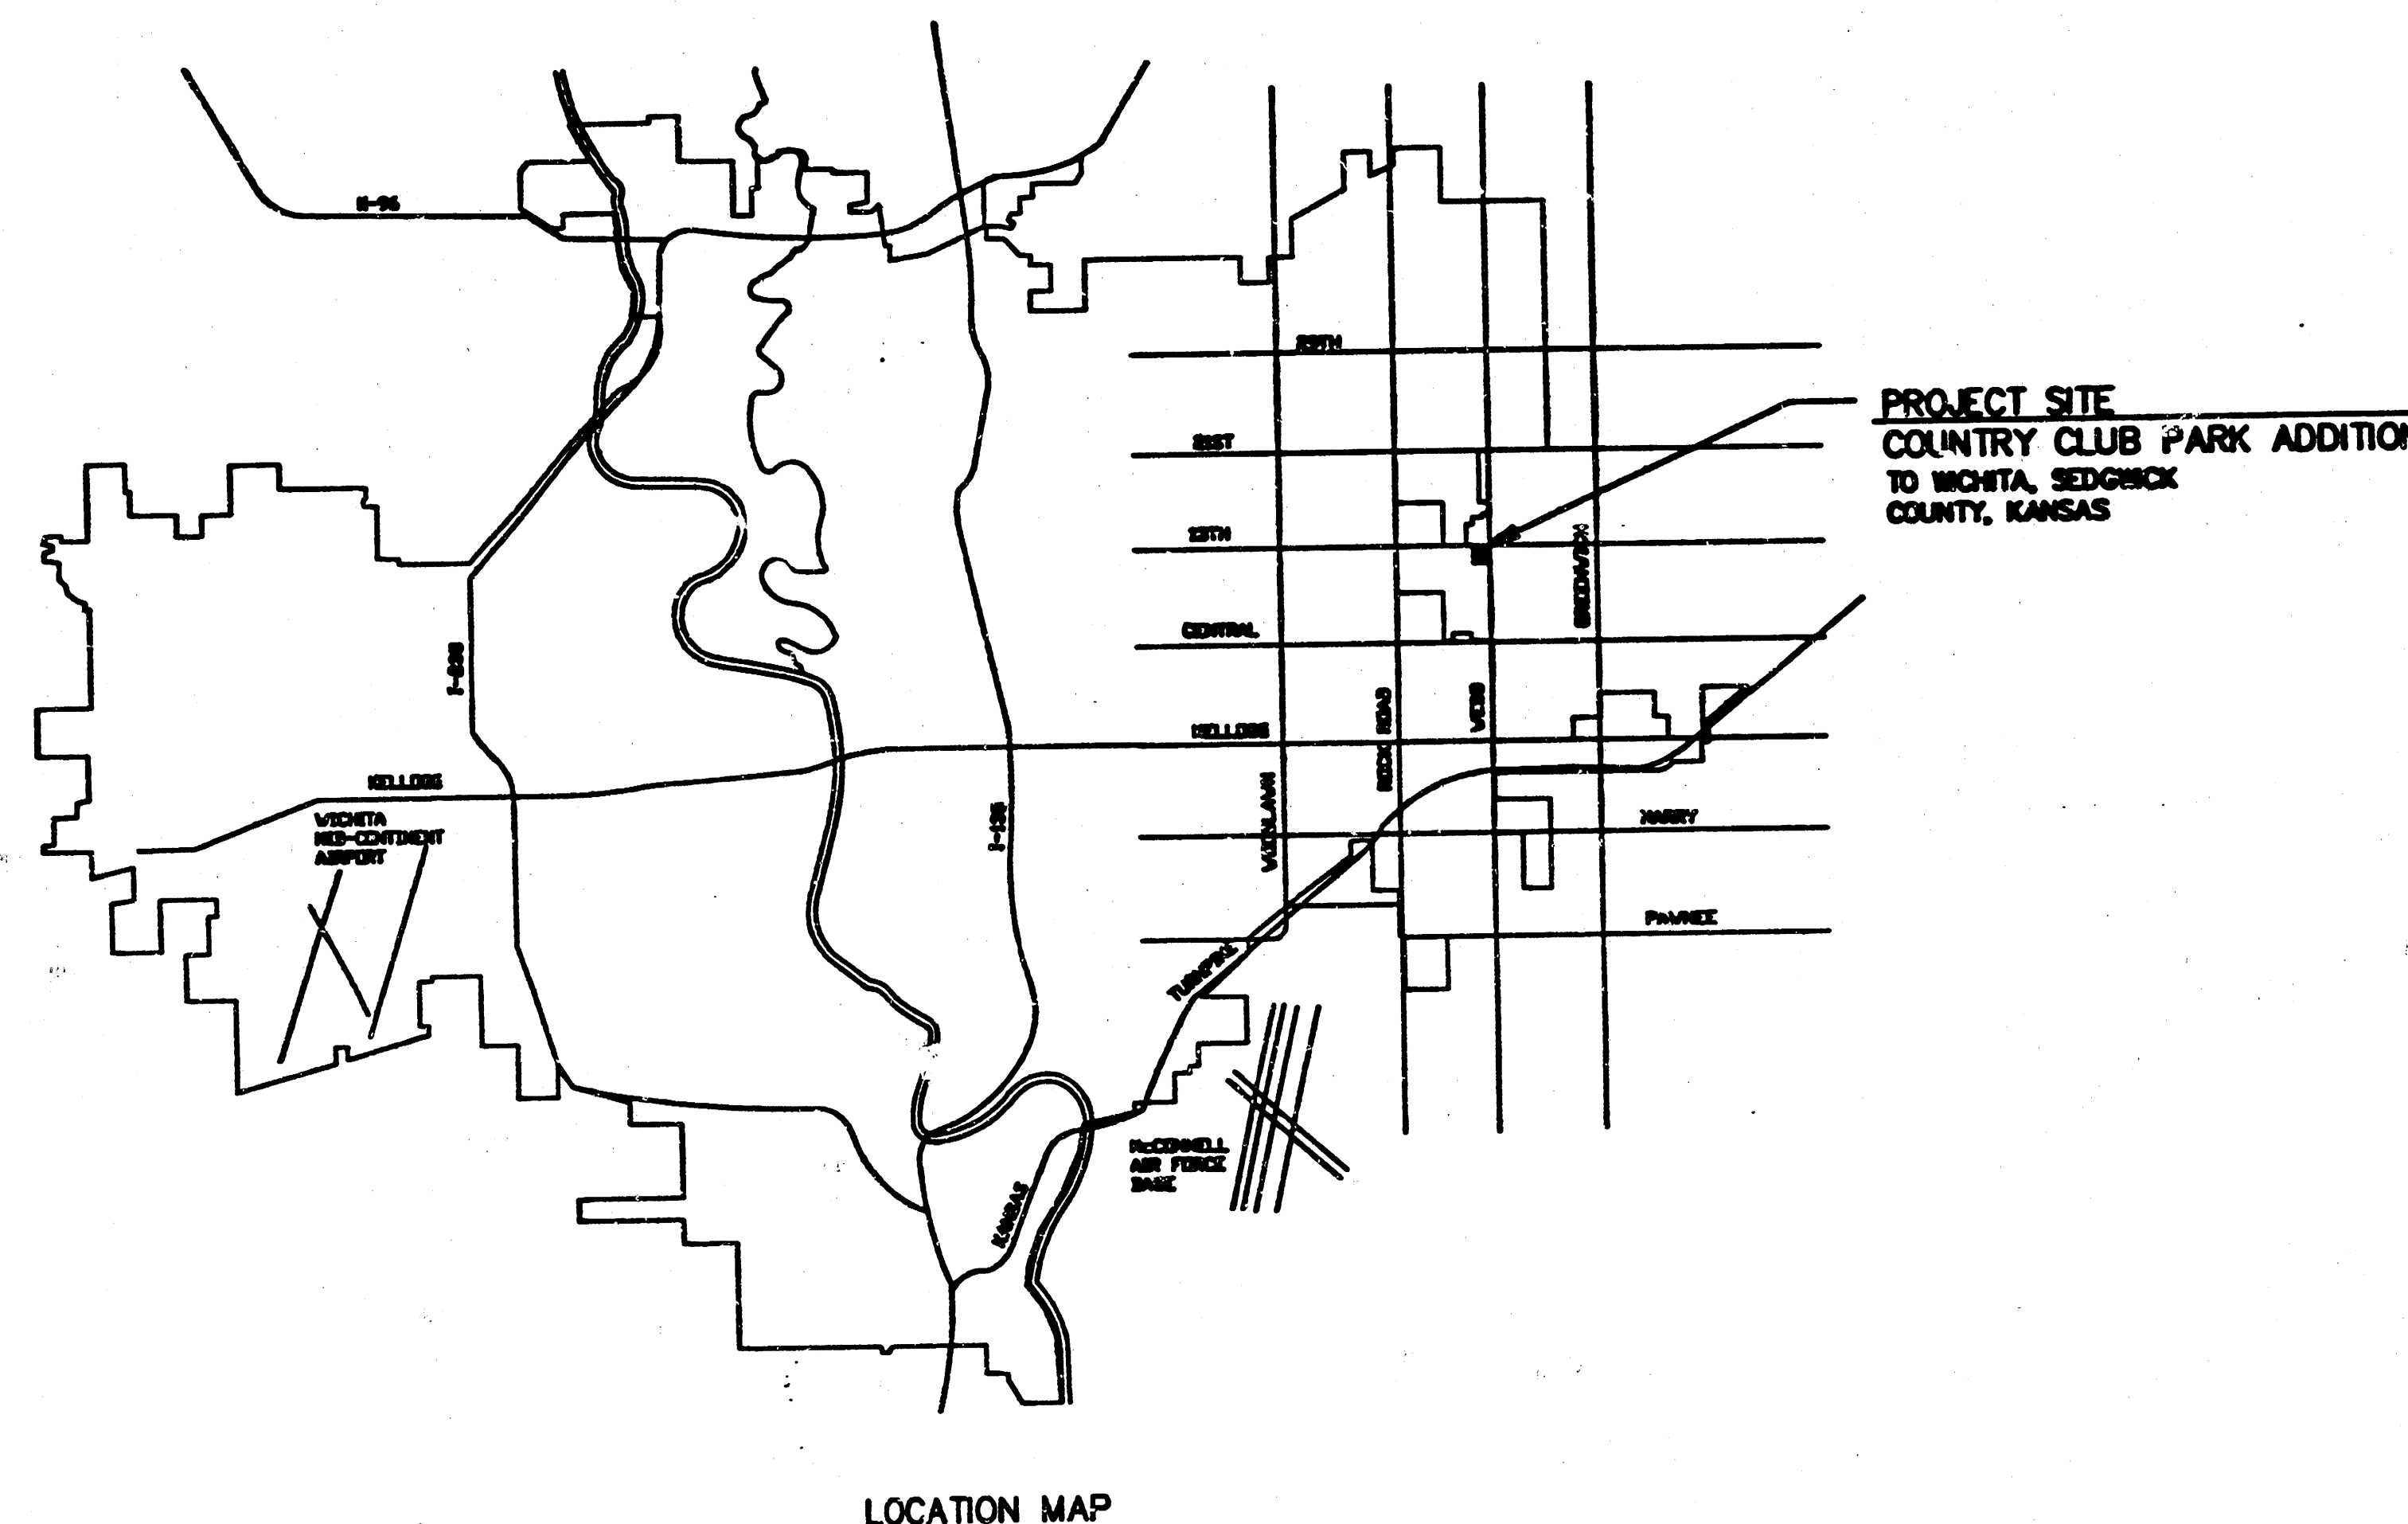

NOTE TO CONTRACTOR
INSPECTION AND TESTING FOR THIS PROJECT IS TO BE PROVIDED BY A LICENSED CONSULTING ENGINEERING FIRM UNDER CONTRACT WITH THE OWNER/DEVELOPER. SAID INSPECTION TO BE IN ACCORDANCE WITH THE CITY OF WICHITA STANDARD CONSTRUCTION ENGINEERING PRACTICES AND CERTIFIED BY A LICENSED PROFESSIONAL ENGINEER. NO WORK SHALL BE PERFORMED IN DEDICATED EASEMENTS OR THE PUBLIC RIGHT-OF-WAY BY THE CONTRACTOR WITHOUT SUCH INSPECTION NOR SHALL ANY WORK BE COMMENCED IN DEDICATED EASEMENTS OR PUBLIC RIGHT-OF-WAY WITHOUT WRITTEN AUTHORIZATION BY THE CITY ENGINEER.

INSPECTION AND TESTING FOR THIS PROJECT IS TO BE PROVIDED BY A LICENSED CONSULTING ENGINEERING FIRM CONTRACTED BY THE OWNER/DEVELOPER. SAID INSPECTION TO BE IN ACCORDANCE WITH THE CITY OF WICHITA STANDARD CONSTRUCTION ENGINEERING PRACTICES AND CERTIFIED BY A LICENSED PROFESSIONAL ENGINEER. NO WORK SHALL BE PERFORMED IN DEDICATED EASEMENTS OR THE PUBLIC RIGHT-OF-WAY BY THE CONTRACTOR WITHOUT SUCH INSPECTION NOR SHALL ANY WORK BE COMMENCED IN DEDICATED EASEMENTS OR RIGHT-OF-WAY WITHOUT WRITTEN AUTHORIZATION BY THE CITY ENGINEER.

INDEX CODE 219PPS607853⁶¹

JUNE, 1989

PLANS PREPARED BY

GOSSEN LIVINGSTON ASSOCIATES, P.A.
ARCHITECTS PLANNERS ENGINEERS (316) 265-9367
420 S. EMPORIA, WICHITA, KANSAS 67020



COUNTRY CLUB PARK - BUILDING ONE
SANITARY SEWER EXTENSION IMPROVEMENTS

KEY MAP


MICHAEL E. LINDEBAK, P.E. - CITY ENGINEER
INDEX CODE 219PPS607853

GOSSEN LIVINGSTON
ASSOCIATES, P.A.
ARCHITECTS PLANNERS ENGINEERS

Designed By RLF
Drawn By RLF

Job No. 882,100

Date JUNE 20, 1989

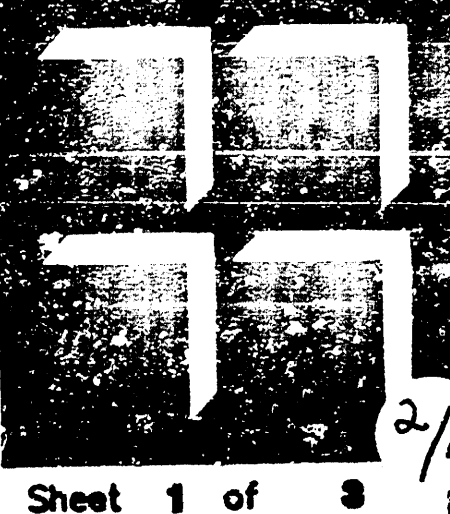

Sheet 1 of 3

WICHITA, SEDGWICK COUNTY, KANSAS



COUNTRY CLUB PARK - BUILDING ONE
SANITARY SEWER EXTENSION IMPROVEMENTS

KEY MAP

INDEX CODE 219PPS607653

**GOSSEN LIVINGSTON
ASSOCIATES P.A.**
430 S. EMPORIA, WICHITA, KANSAS 67202
ADVERTISING PLANNING SERVICES (913) 686-6897

Designed by: **Drawn By: R.D.F.**

Date JUNE 20, 1989

1

Sheet 2 of 3 ³/₄

FILMED FROM THE BEST
AVAILABLE COPY

