


PLAN
 NO. 1
 DATE 8-7-79
 BY J. S. Ramsey
 CHECKED BY J. S. Ramsey
 APPROVED BY J. S. Ramsey
 NO. 1

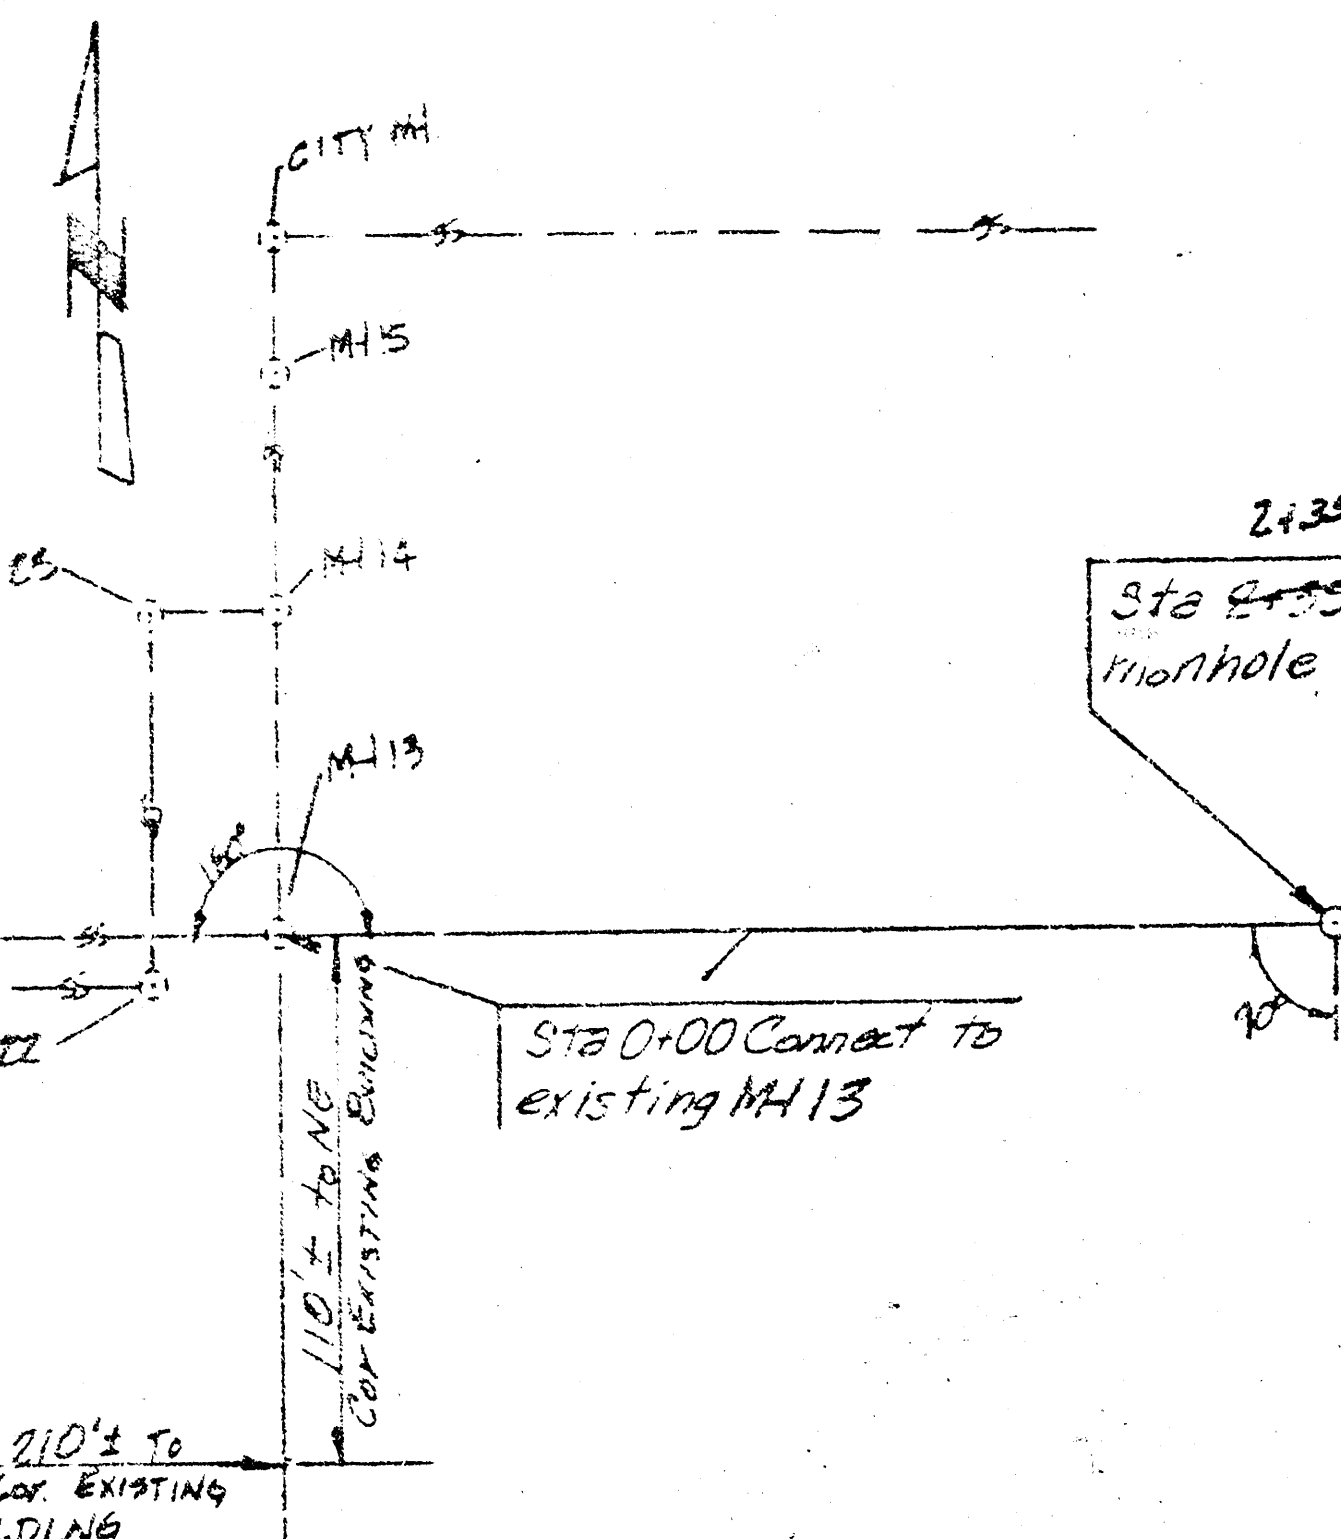

Sta 2+35 Construct Type A manhole

Notes:
 Contact Carl May Maintenance Foreman
 Davis Mfg. Co. for assistance in locating
 buried utilities. Also contact S.W. Bell and
 K.G. #2.
 Contractor shall protect existing utilities.
 Contractor shall only close one lane of
 concrete drive at any time. The trench shall
 be backfilled, compacted and rocked at the
 end of the day.

Sta 6+55 Construct Type A manhole. Install 10' x 12' V.C.P. East @ 0.20% grade E 88.97.

Sta 7+55 Construct Type A manhole

Remove and Replace Concrete Pavement. Contractor may close one side of drive.


NEW 14' x 24' 8' BLDG
 Verify location of existing 4' stub out in new building

As B.R. 8/28/79
 D.B.S. W.S.J. or

SANITARY SEWER FOR DAVIS MANUFACTURING
 3301 S. HOOVER ROAD
 468-76-245 800-606-000-000-008


SCALE
 PLAN: 1" = 50'
 PROFILE: HORIZ. 1" = 50'
 VERT. 1" = 5'

BM: Top of Ring Existing M13 ELEV. 97.92

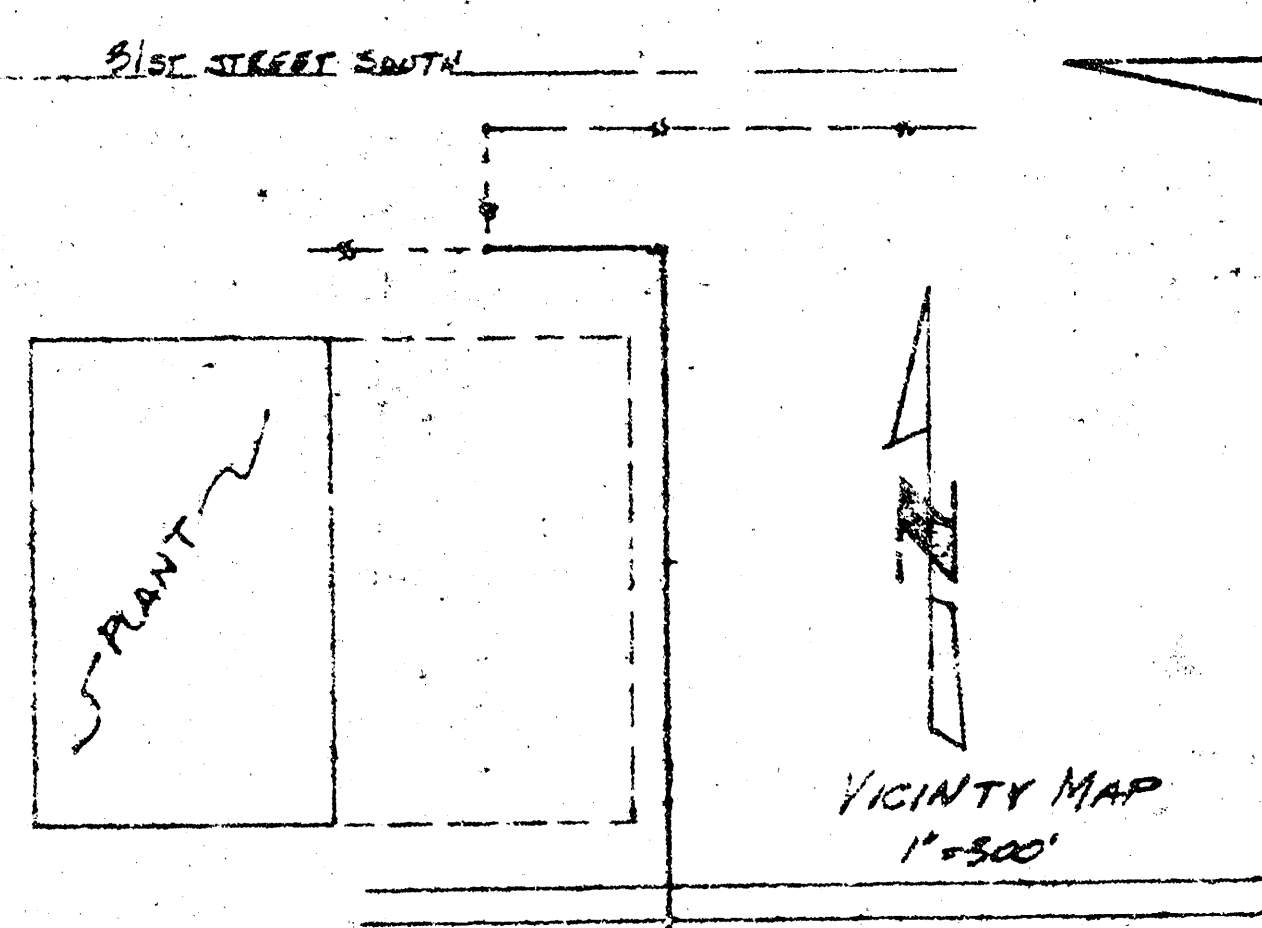

8-7-79
 APPROVED AS NOTED
 By CITY ENGINEER OF WICHITA
 Sanitary Sewers
 Storm Sewers
 Driveway Approaches

NOTE TO CONTRACTOR
 This project will be constructed under
 the supervision of the CITY ENGINEER
 and conforming to the SPECIFICATIONS
 of the CITY OF WICHITA. The CON-
 TRACTOR will reimburse the City of
 Wichita for all cost of inspection.

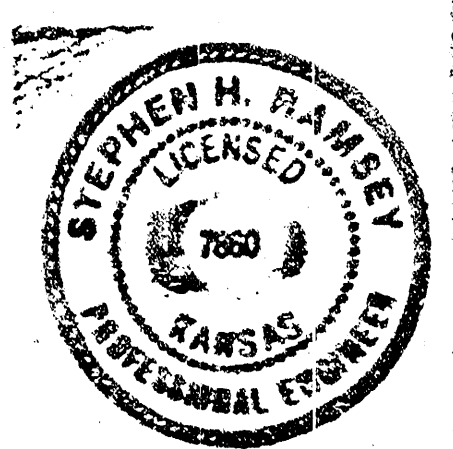

UTILITY CONTRACTORS, INC.
 100 WEST 10TH STREET - P.O. BOX 2009
 WICHITA, KANSAS 67202 - (316) 265-9128
 SPECIALTIES OF KANSAS
 SANITARY SEWER EXTENSION AT
 DAVIS MANUFACTURING, DILL LILACE
 3301 S. HOOVER ROAD, WICHITA
 JOB # D-1784 BY S. Ramsey
 DATE: JUNE 1979 SHEET 1 of 1

