
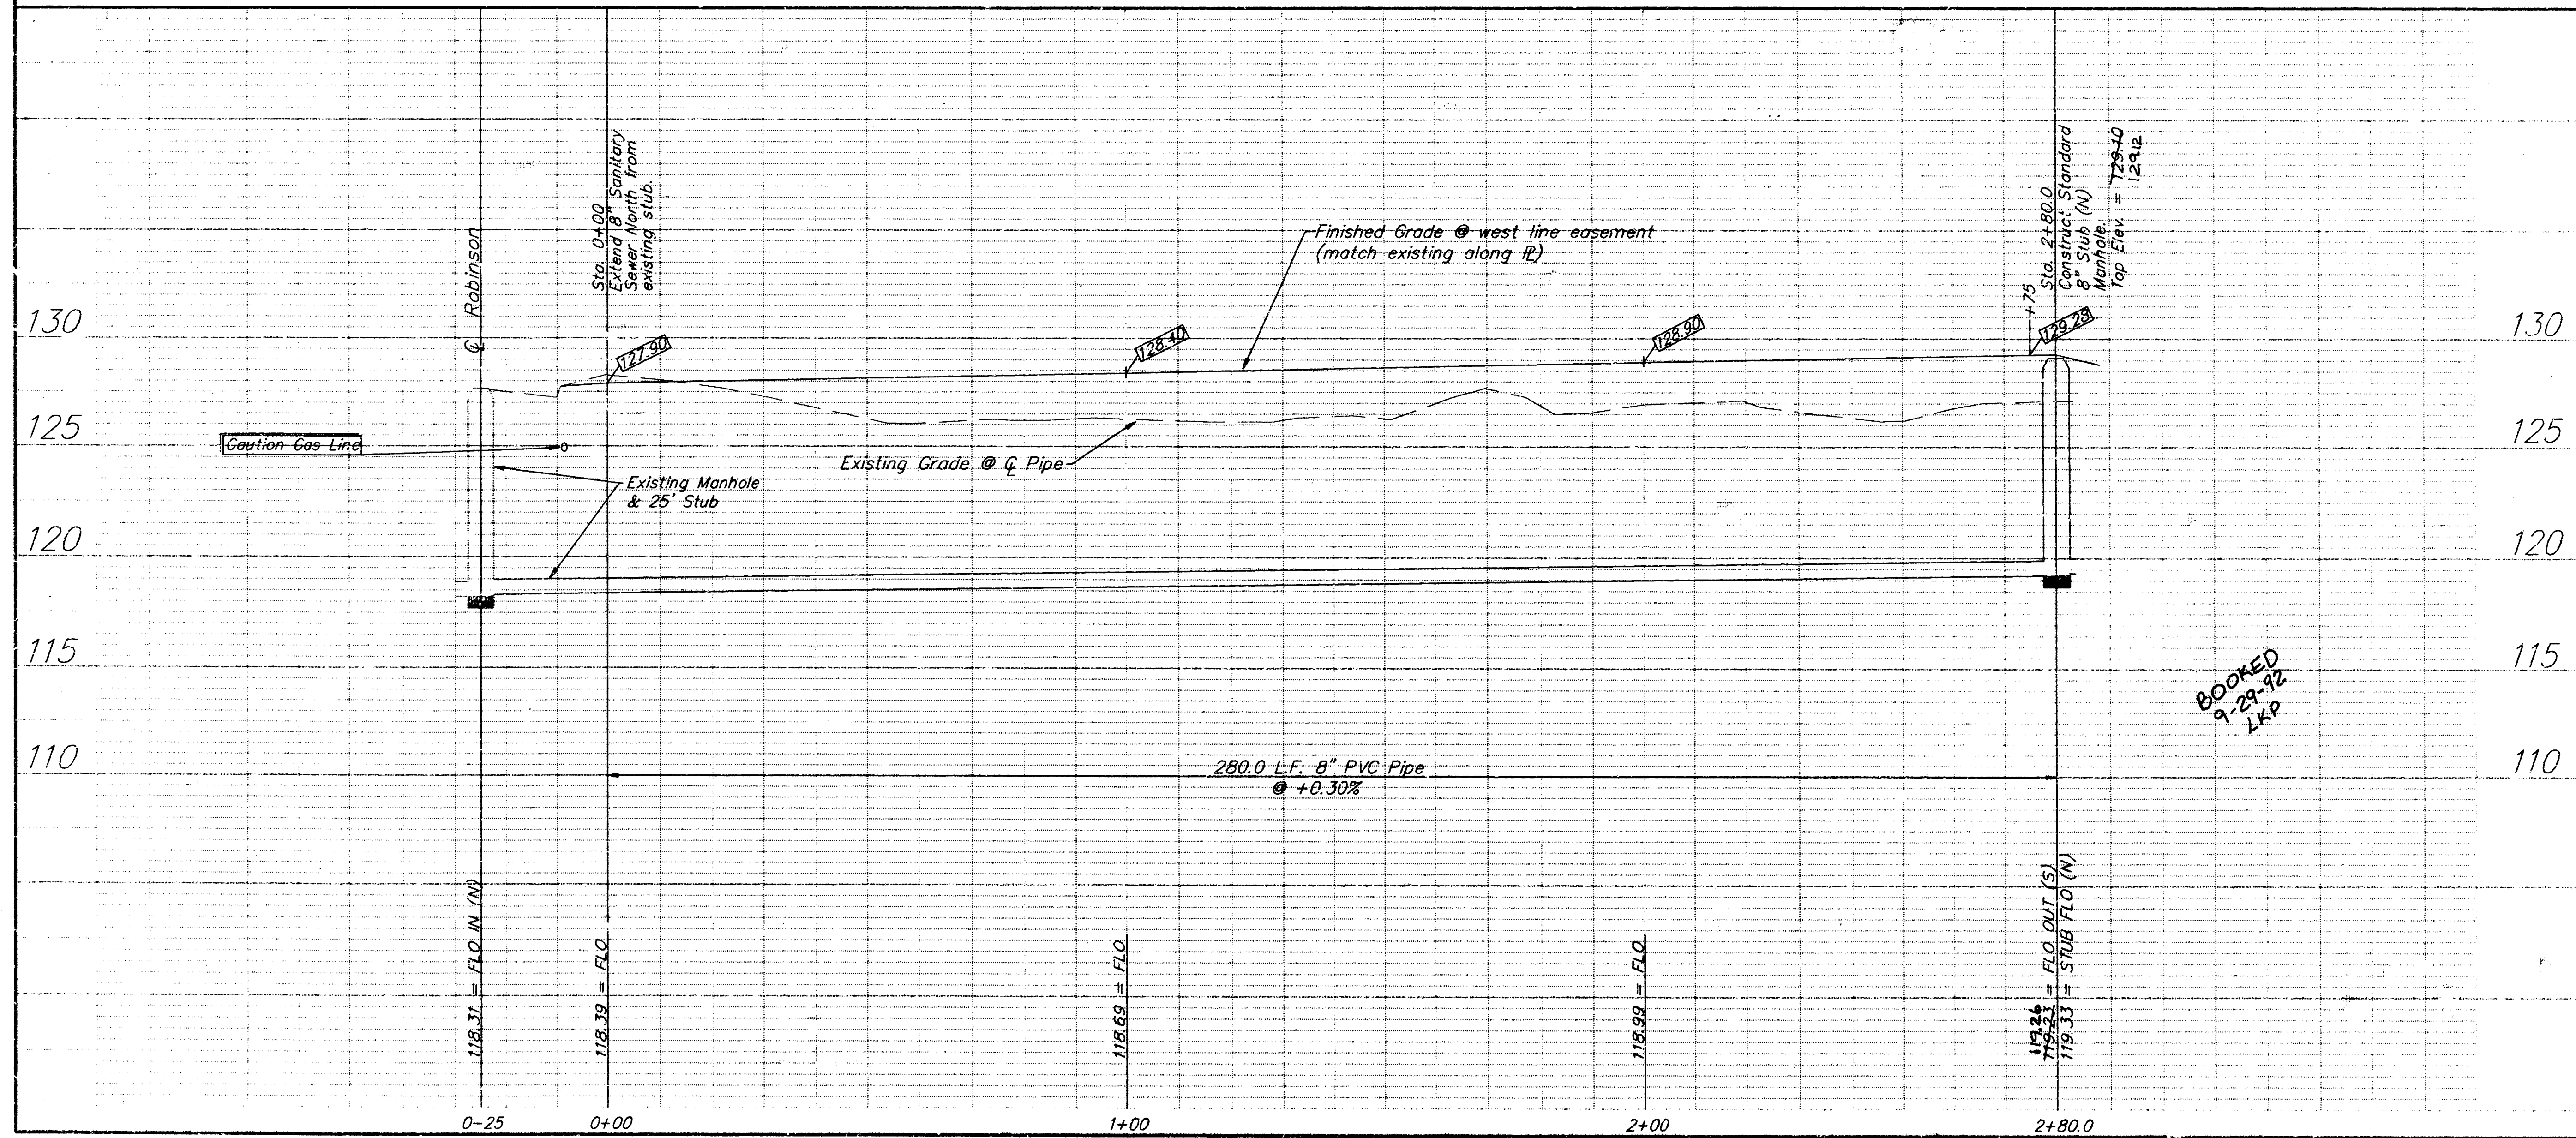
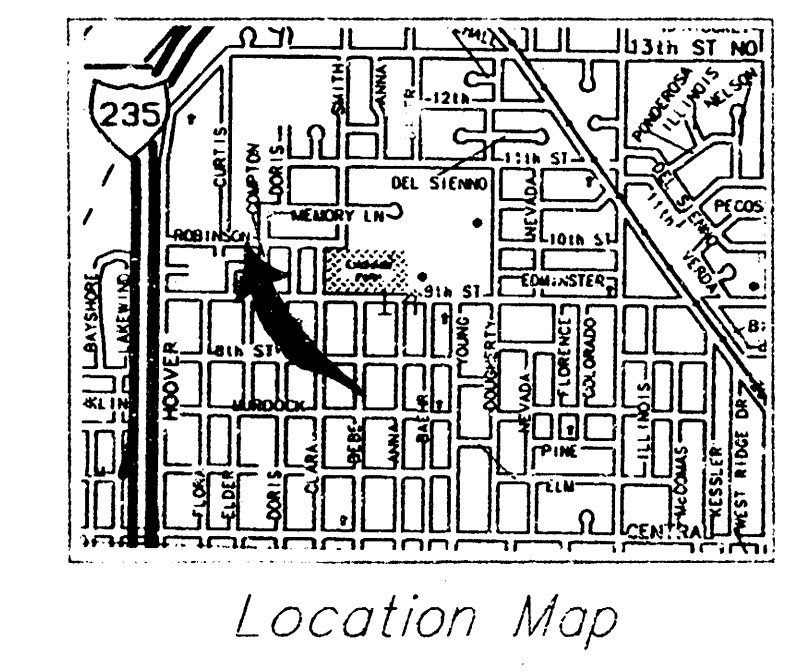


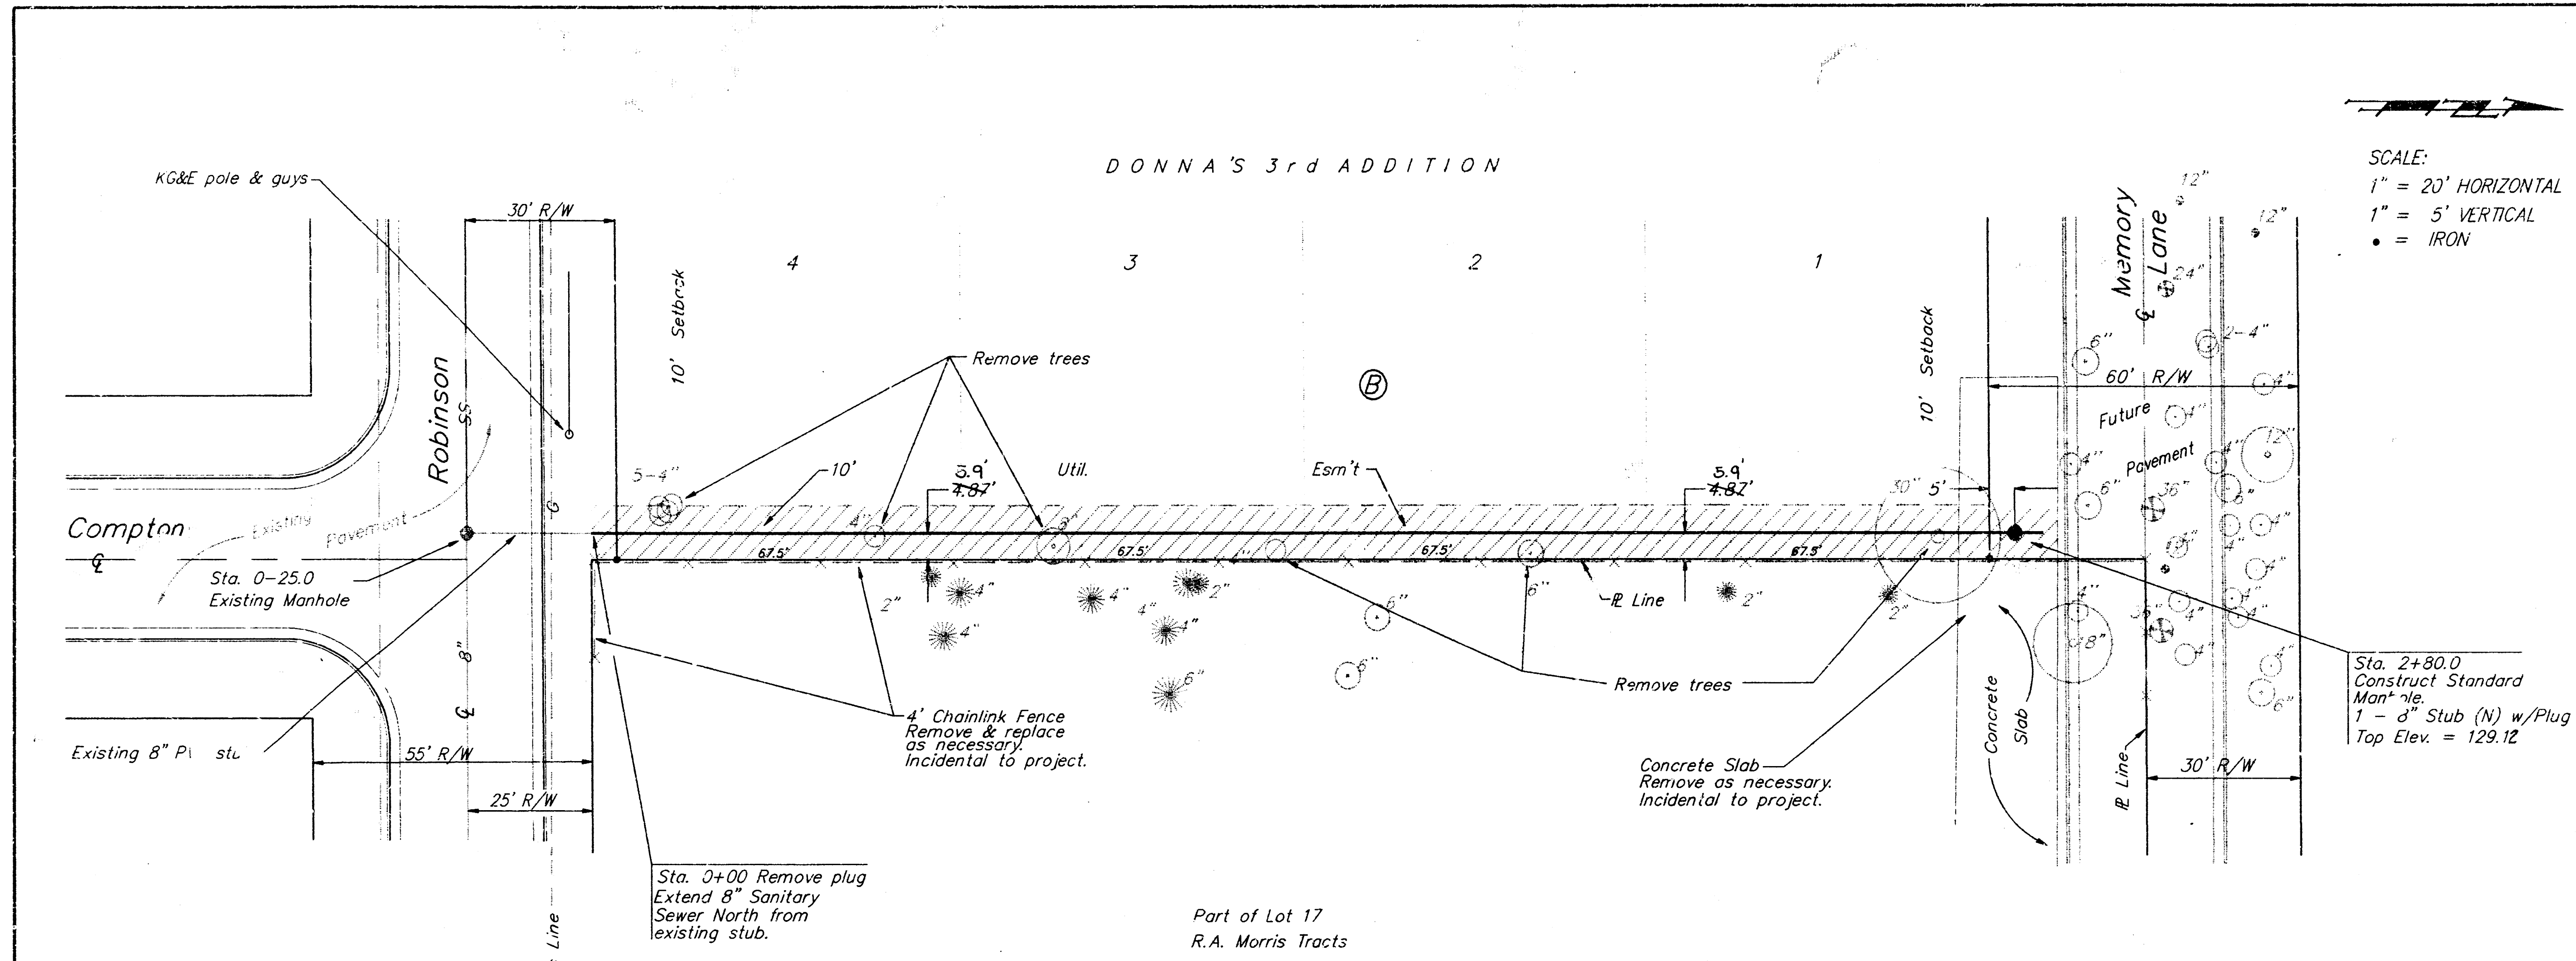

APPROVED AS NOTED
BY CITY ENGINEER OF WICHITA

Sanitary Sewers VRH 4/27/92

Storm Sewers _____


Driveway Approaches _____

Water Mains _____

Paving _____

NOTE TO CONTRACTORS

Inspection and testing for this project is to be provided by a Licensed Consulting Engineering Firm under contract with the Owner/Developer. Said inspection to be in accordance with the City of Wichita standard construction engineering practices and certified by a Licensed Professional Engineer. No work shall be performed in dedicated easements or public right-of-way by the Contractor without such inspection nor shall any work be commenced without written authorization by the City Engineer.

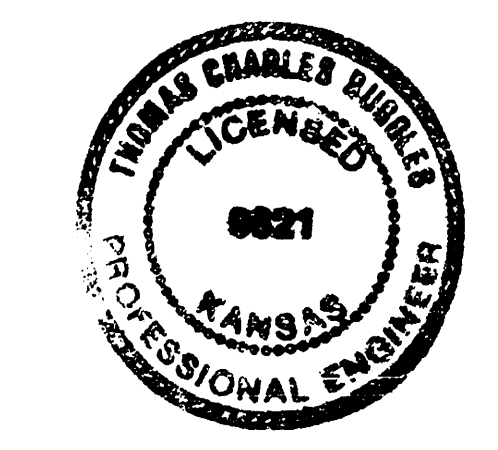

DONNA'S 3RD ADDITION
SANITARY SEWER EXTENSION
to serve lots 1 thru 4, block B

BAUGHMAN COMPANY P. A.
ENGINEERING & SURVEYING
316/262-7271 • 315 ELLIS • WICHITA, KANSAS 67211

PROJECT NUMBER
340PPS (607861)

DESIGN T.C.R./B.P.	DRAWN B.P.	UTIL. CHECKED DATE 4-23-92	SCALE NOTED
-----------------------	---------------	----------------------------------	----------------

SHEET
1
OF
2

Revised as built 6-30-92