

PLANS

SANITARY SEWER SYSTEM

CRESTVIEW COUNTRY CLUB ESTATES

EAST MEADOWS ADDITION

NORTH  
POINT

ADD.

EAST

MEADOWS

ADD.

LEGEND

1" = 100' (AS SHOWN ON MAP)


1" = 100' (AS SHOWN ON MAP)

1" = 100' (AS SHOWN ON MAP)

AS RECONSTRUCTED

SANITARY SEWER LINES

CRESTVIEW IMPROVEMENT DISTRICT

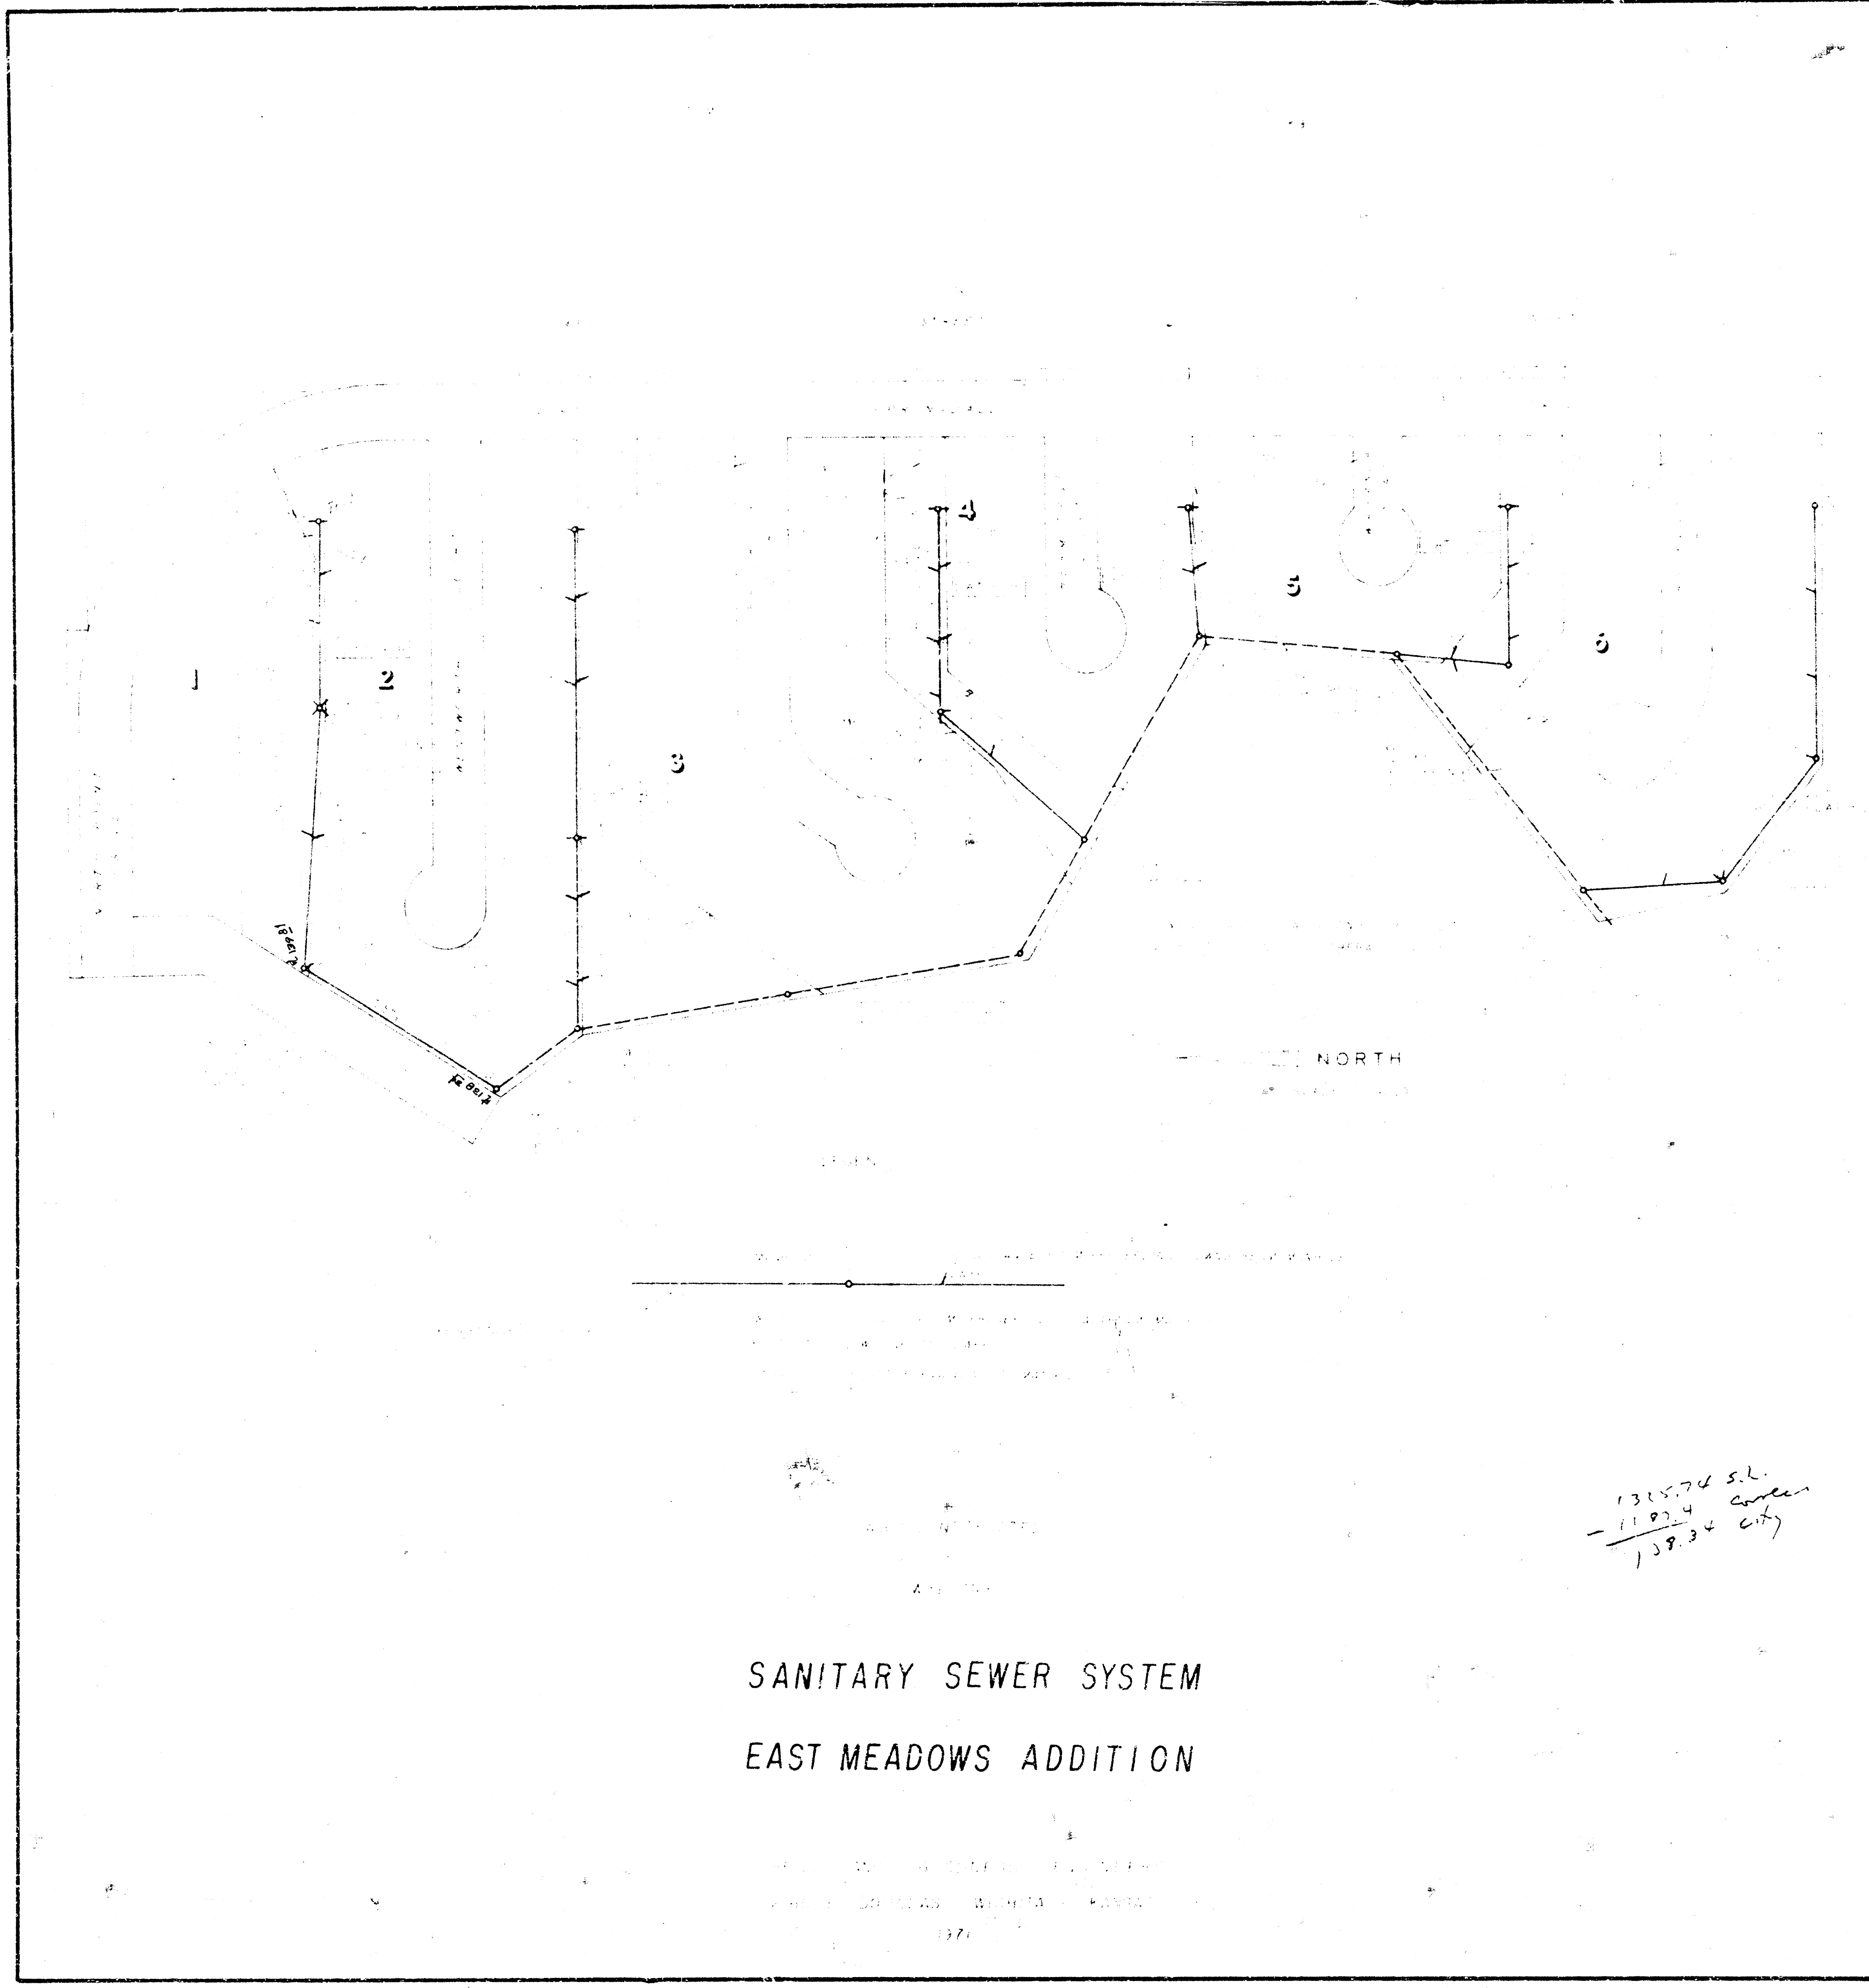

SANITARY SEWER SYSTEM  
EAST MEADOWS ADDITION



DESIGNED BY  
ENGINEER  
1971

1315.74 s.l.  
- 1127.4 cover  
118.34 city

|                |                                  |                       |            |
|----------------|----------------------------------|-----------------------|------------|
| DATE: 11-11-66 | DESIGN AND ADDRESS: ENGINEERS    | SANITARY SEWER SYSTEM | FIG. NO. 2 |
|                | PINE & BOULDER - RICHIE - PAUSAD | EAST WENDERS ADDITION | OF 5       |



|         |                       |             |              |      |          |
|---------|-----------------------|-------------|--------------|------|----------|
| DATE    | 10/10/54              | BY          | J. H. HARRIS | NO.  | 1        |
| PROJECT | WATER TREATMENT PLANT | DESIGNED BY | J. H. HARRIS | DATE | 10/10/54 |

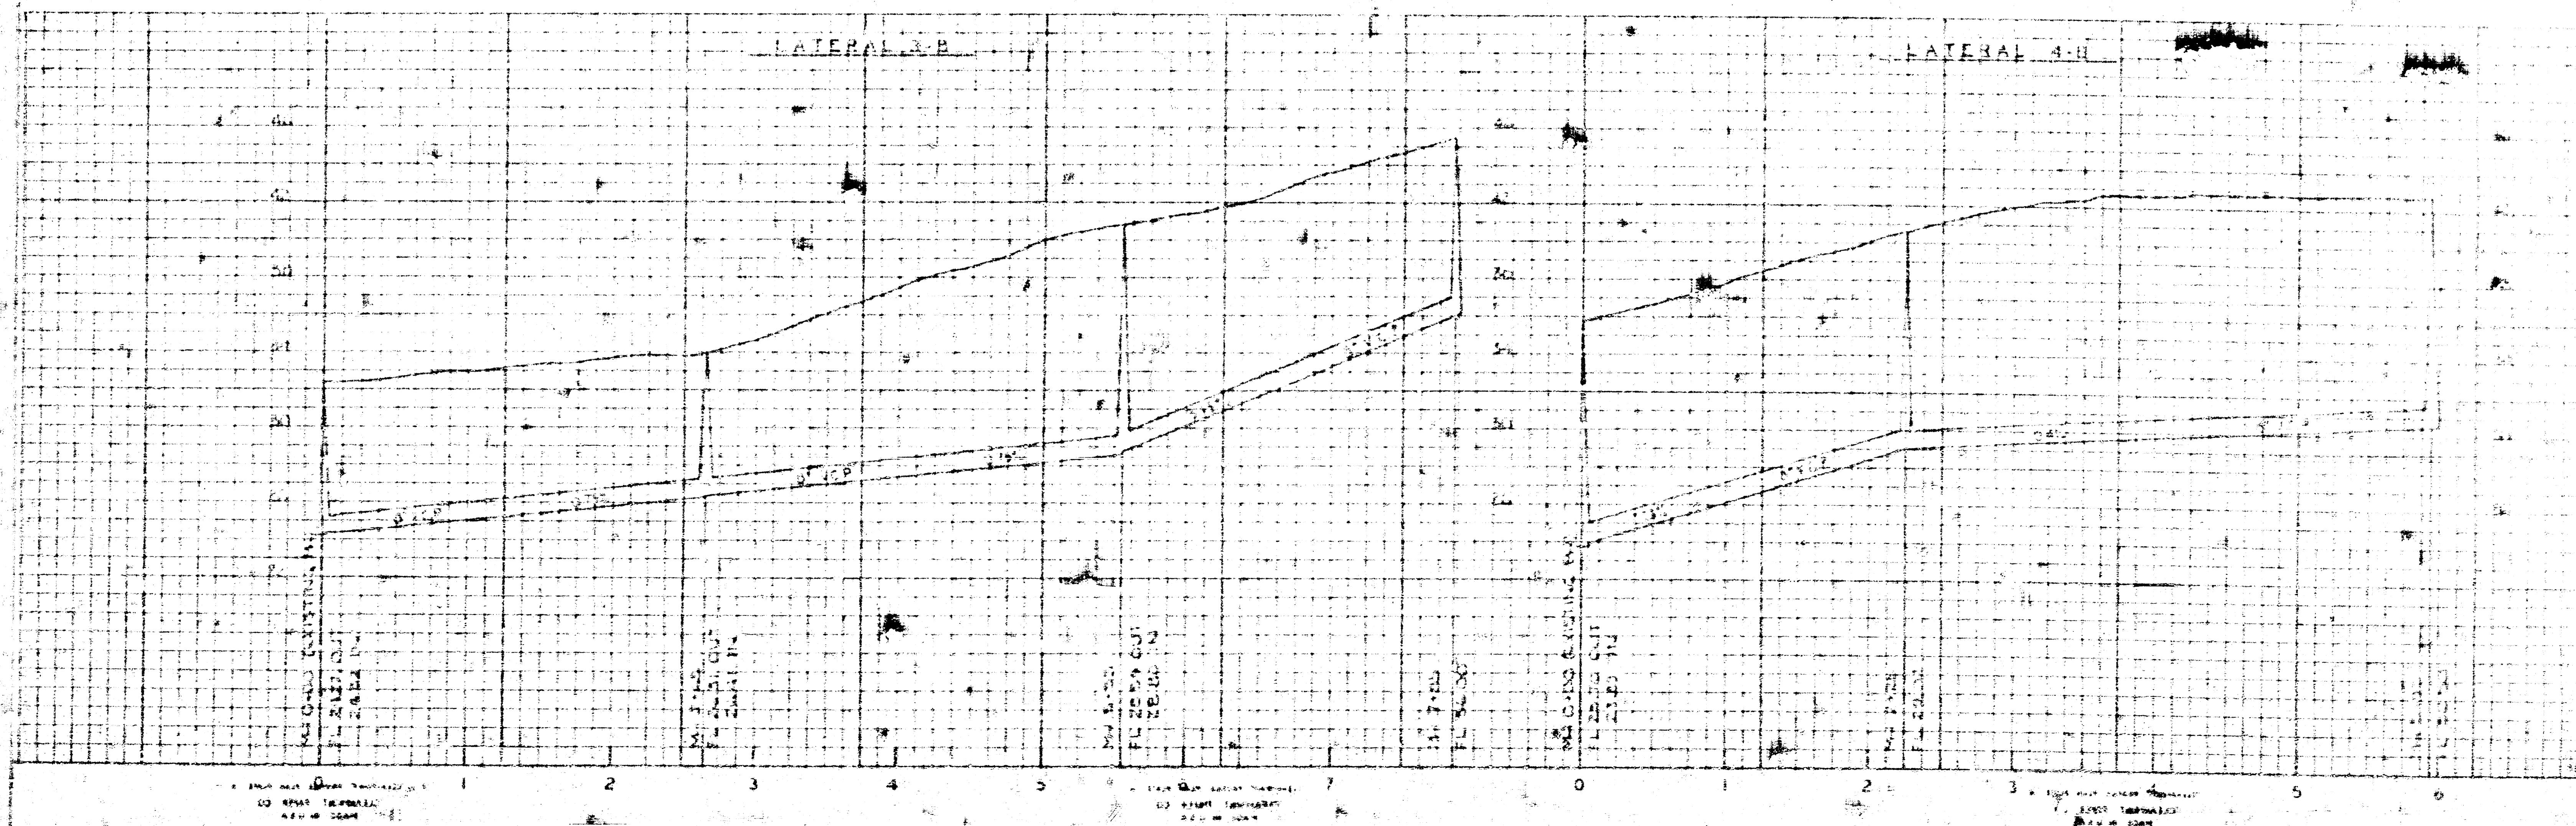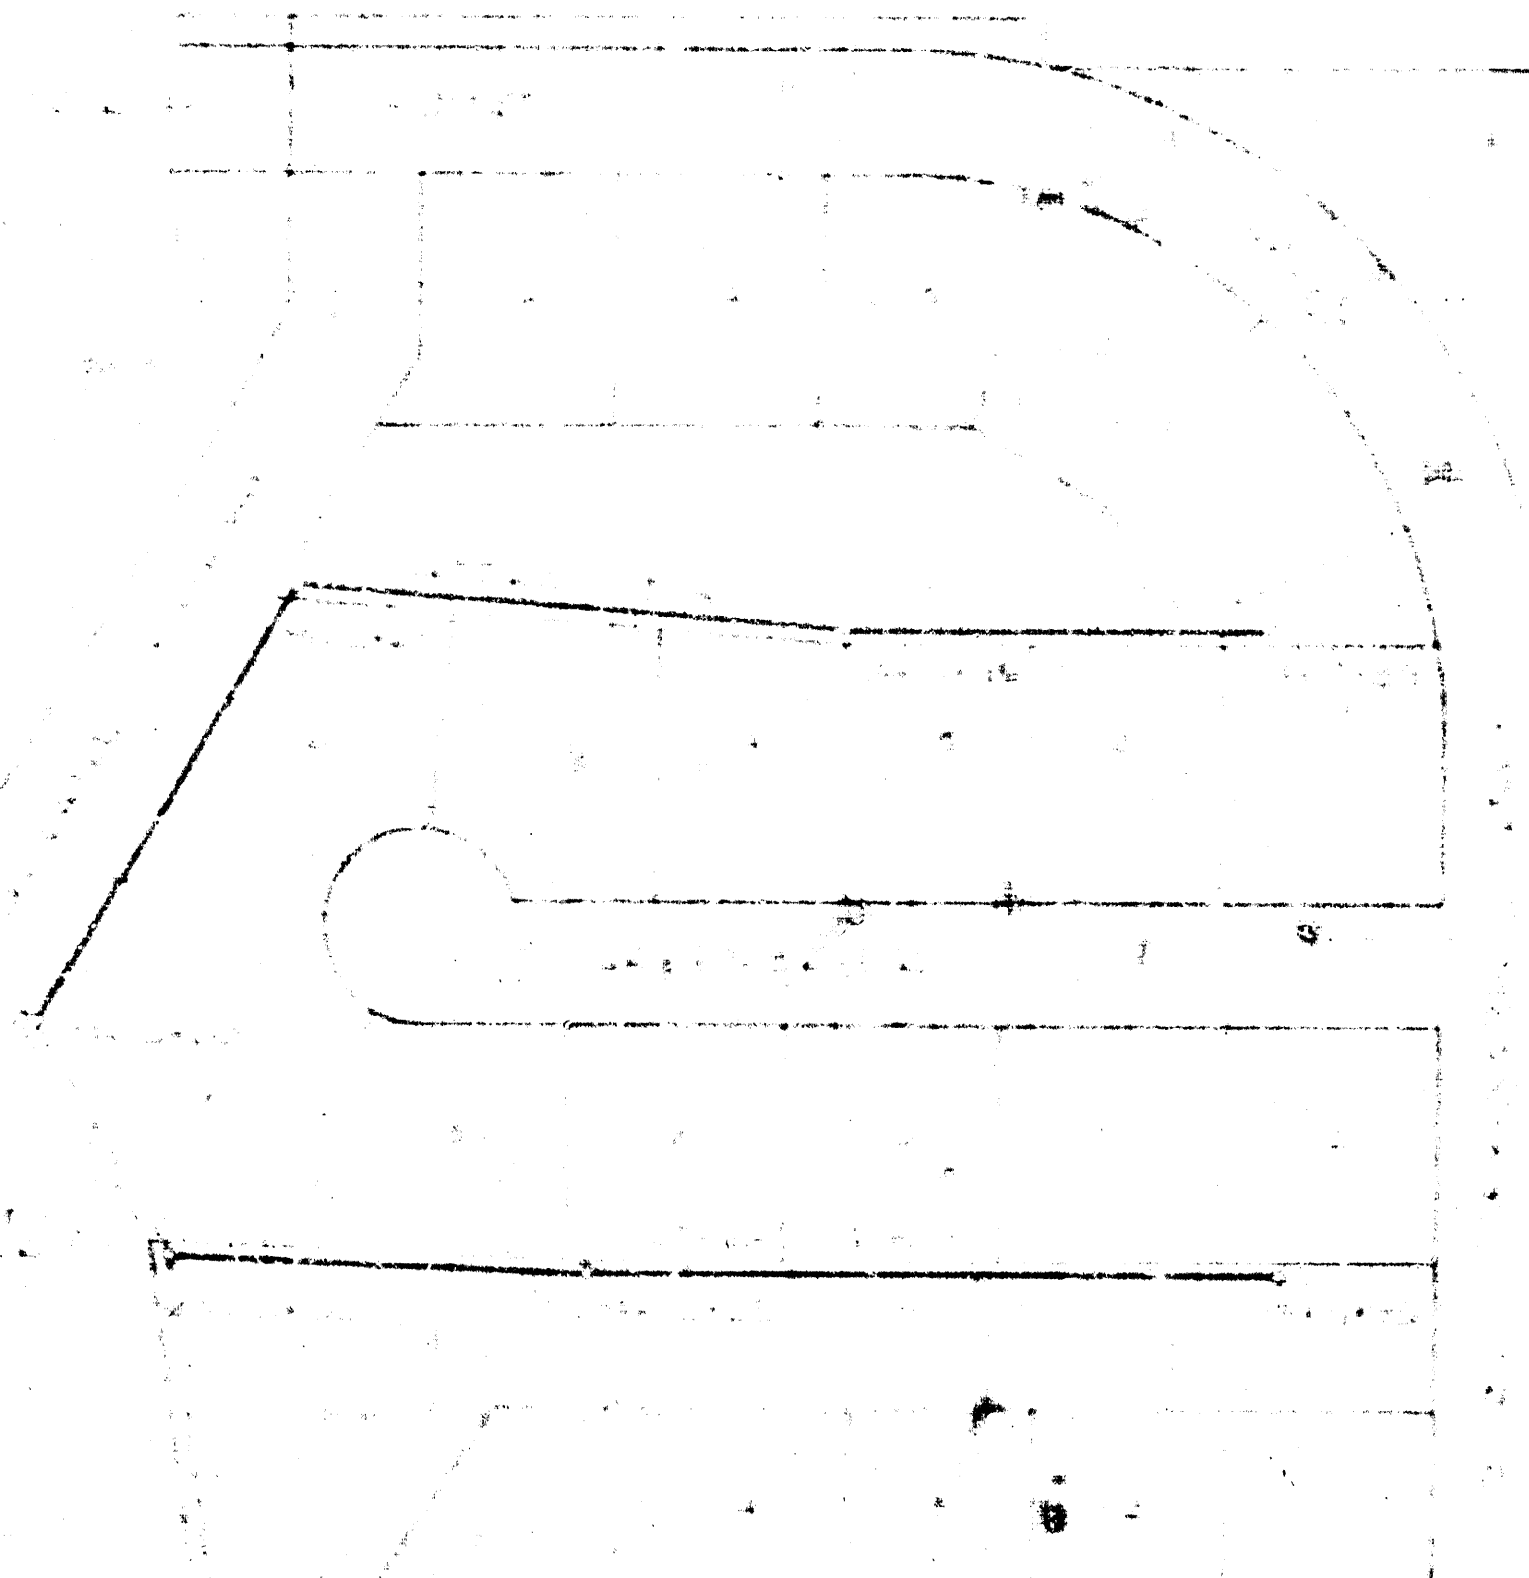

|           |                                     |                          |       |   |
|-----------|-------------------------------------|--------------------------|-------|---|
| AS 114-20 | HEAVY AND BUSINESS ENGINEERS        | ANTHONY HEAVY SYSTEM     | SHEET | 1 |
|           | 140 E. CHICAGO - CHICAGO - ILLINOIS | PORT WASHINGTON ALLIANCE | OF    | 5 |

