




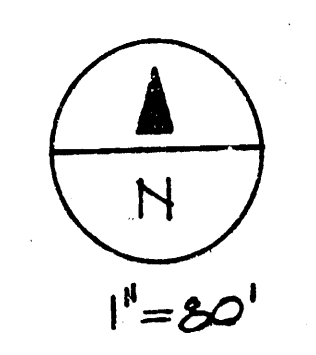


4-24-79
 APPROVED AS NOTED
 By CITY ENGINEER OF WICHITA
 Sanitary Sewers *DEB*
 Storm Sewers _____
 Driveway Approaches _____

NOTE TO CONTRACTOR
 This project will be constructed under the supervision of the CITY ENGINEER and conforming to the SPECIFICATIONS of the CITY OF WICHITA. The CONTRACTOR will reimburse the City of Wichita for all cost of ~~Engineering~~ *Inspection*.

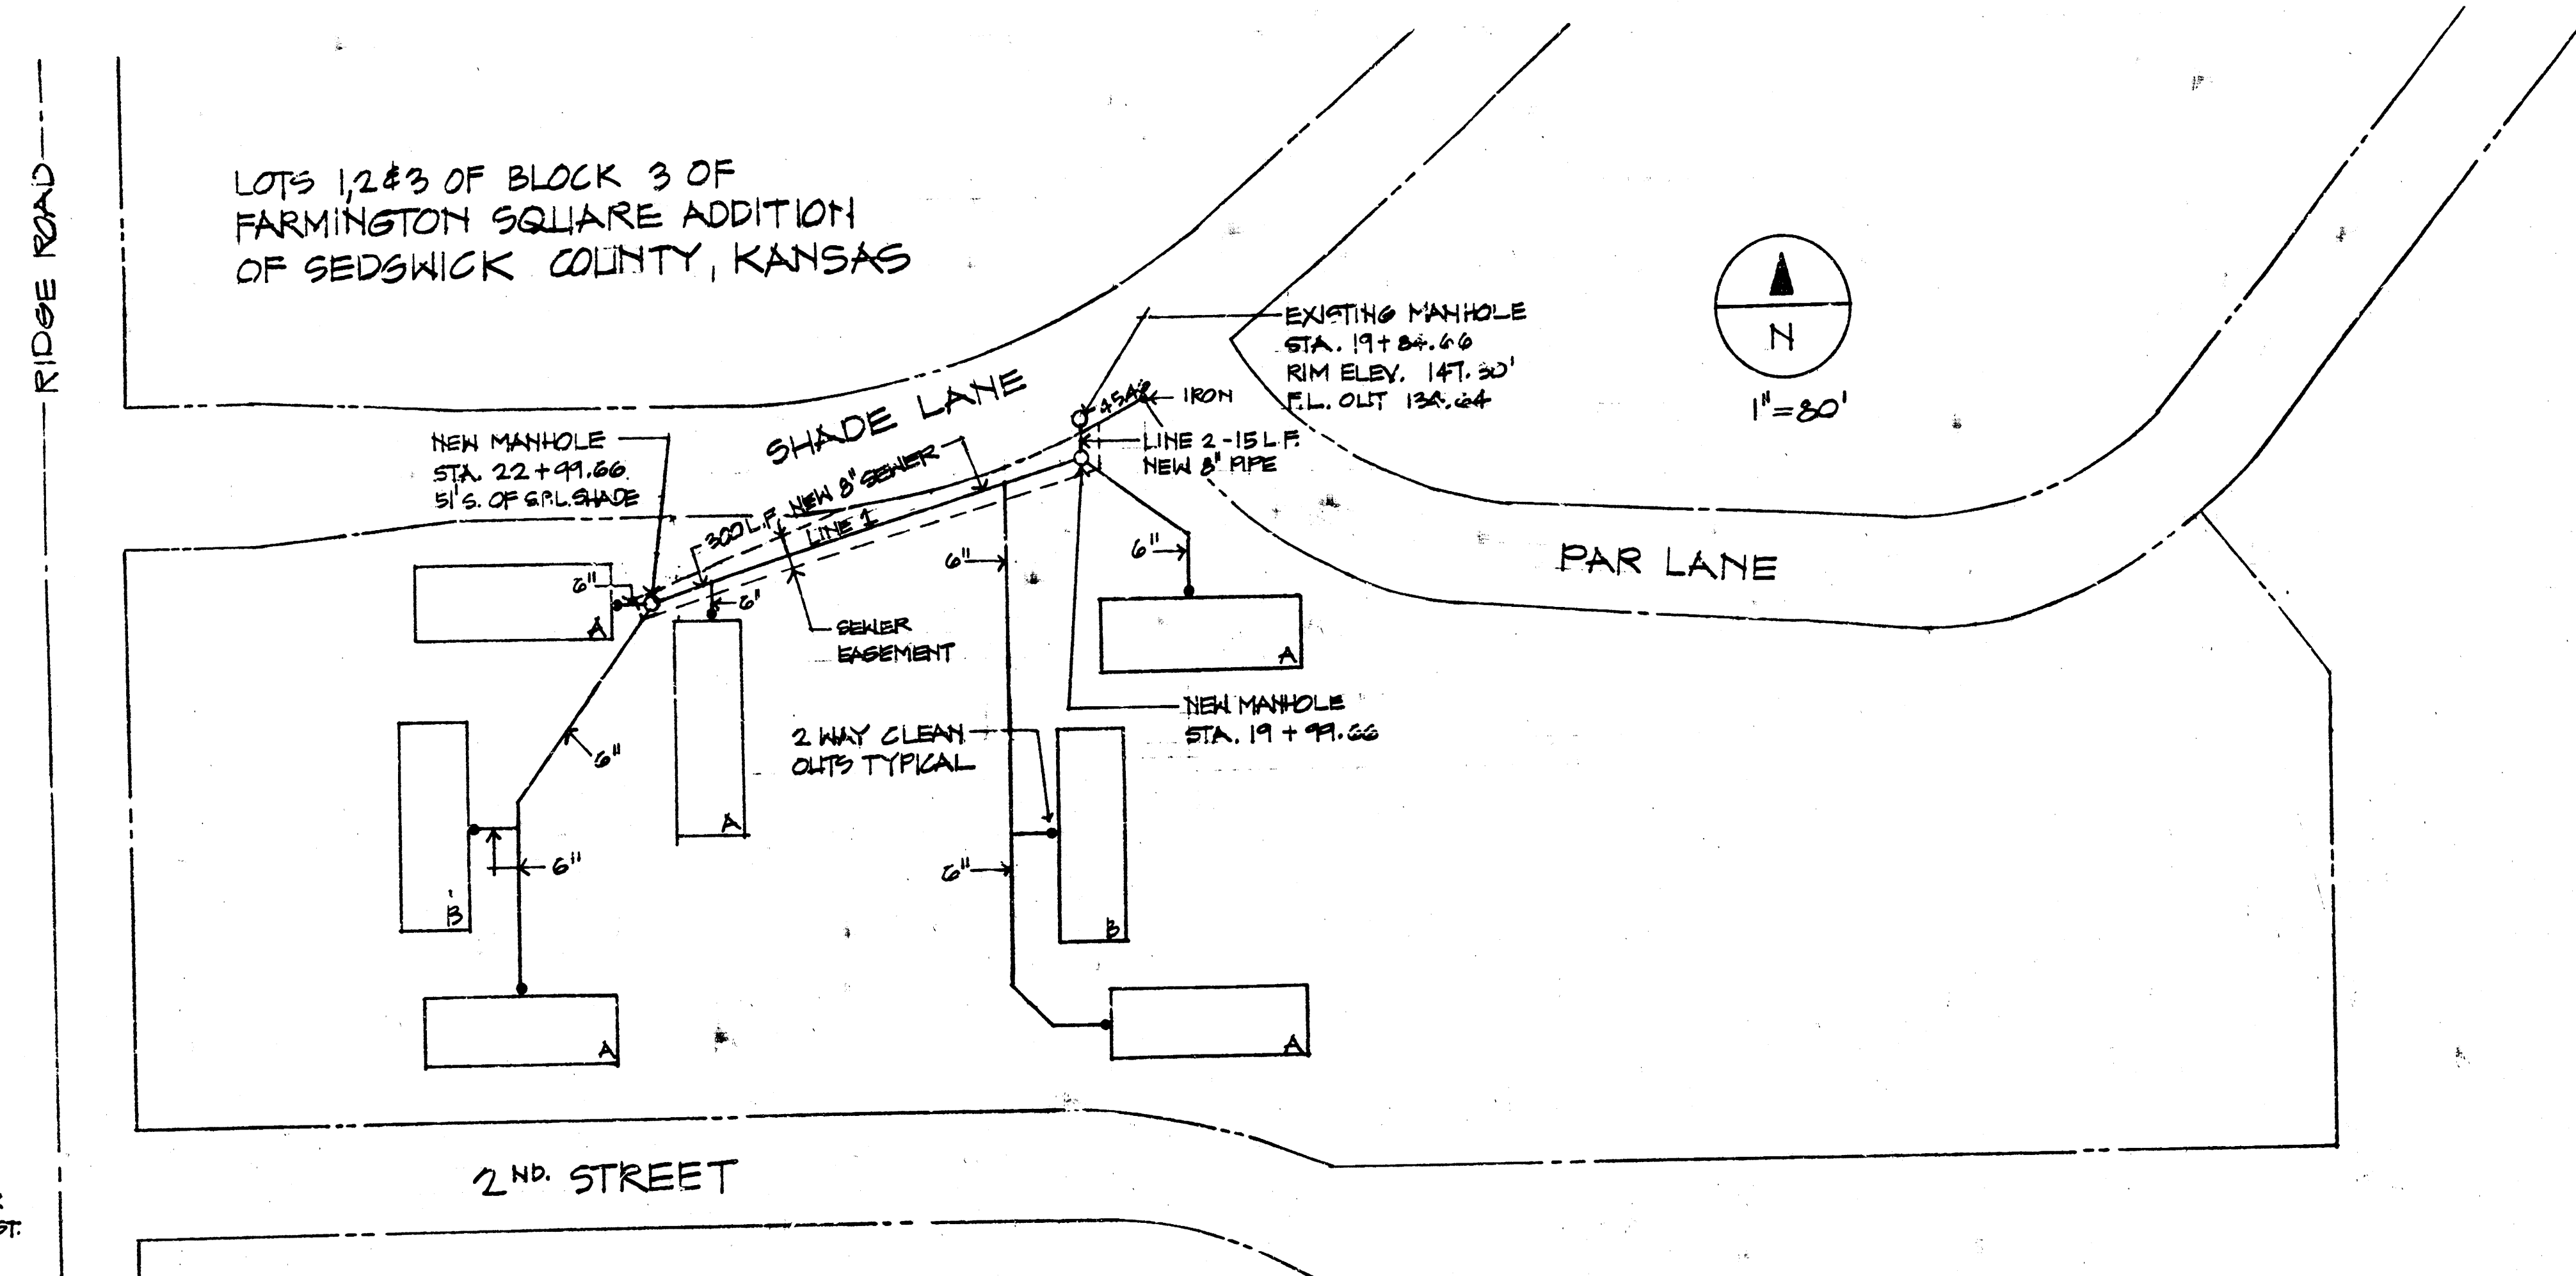

B.M. 144.96
 CITY STD. N.W. CORNER
 OF RIDGE RD. & 2ND ST.
 34.5' N & 48.0' W

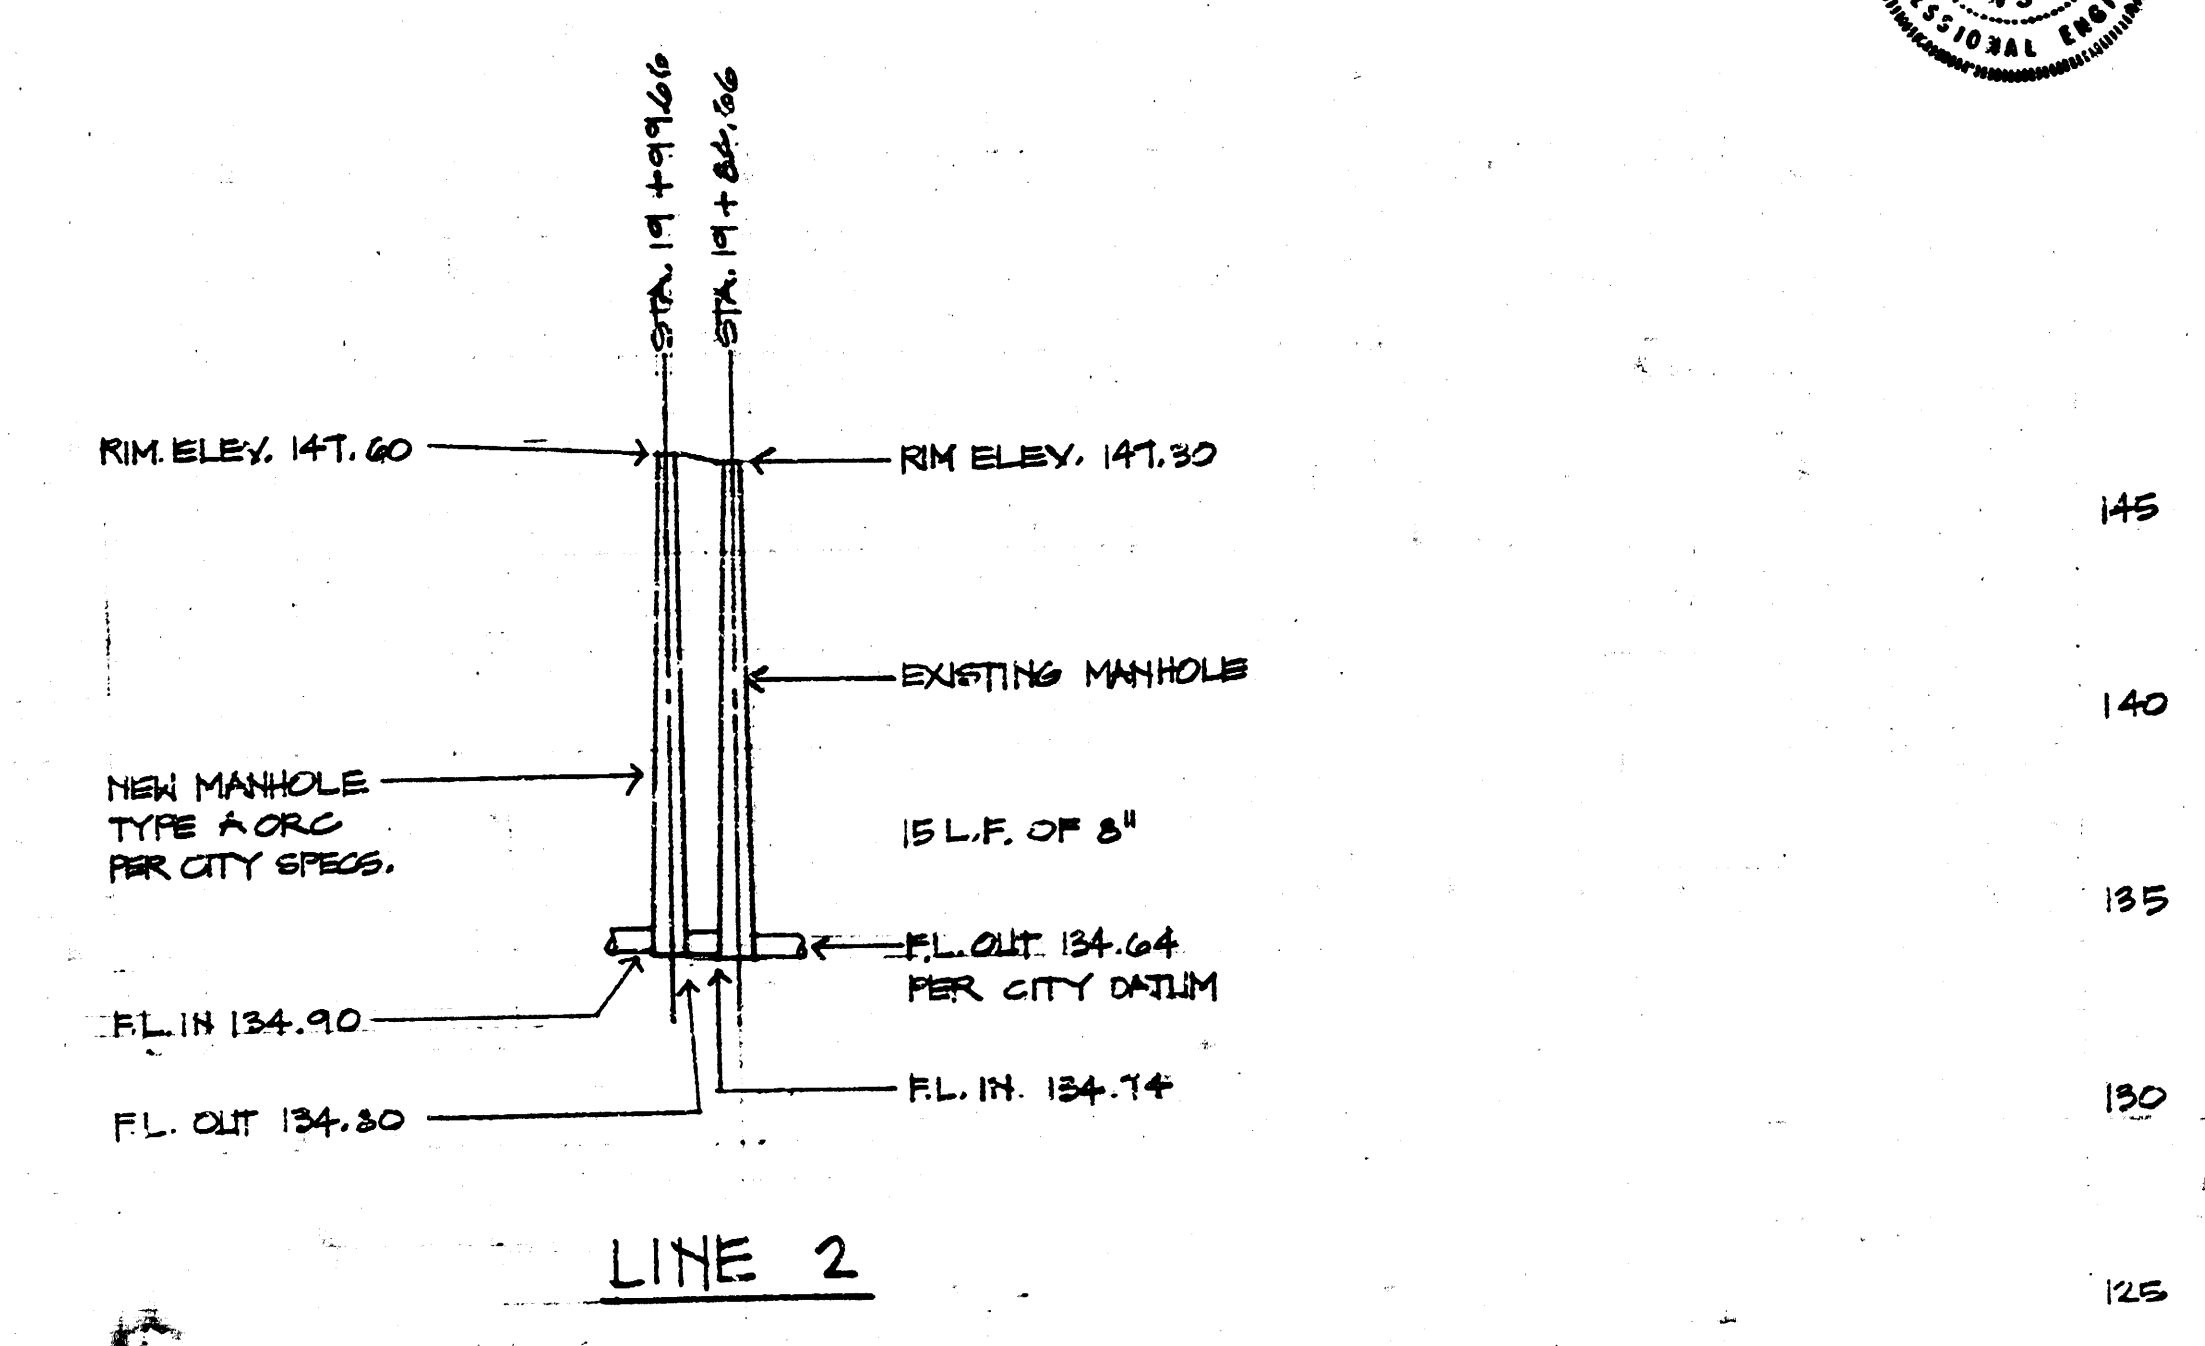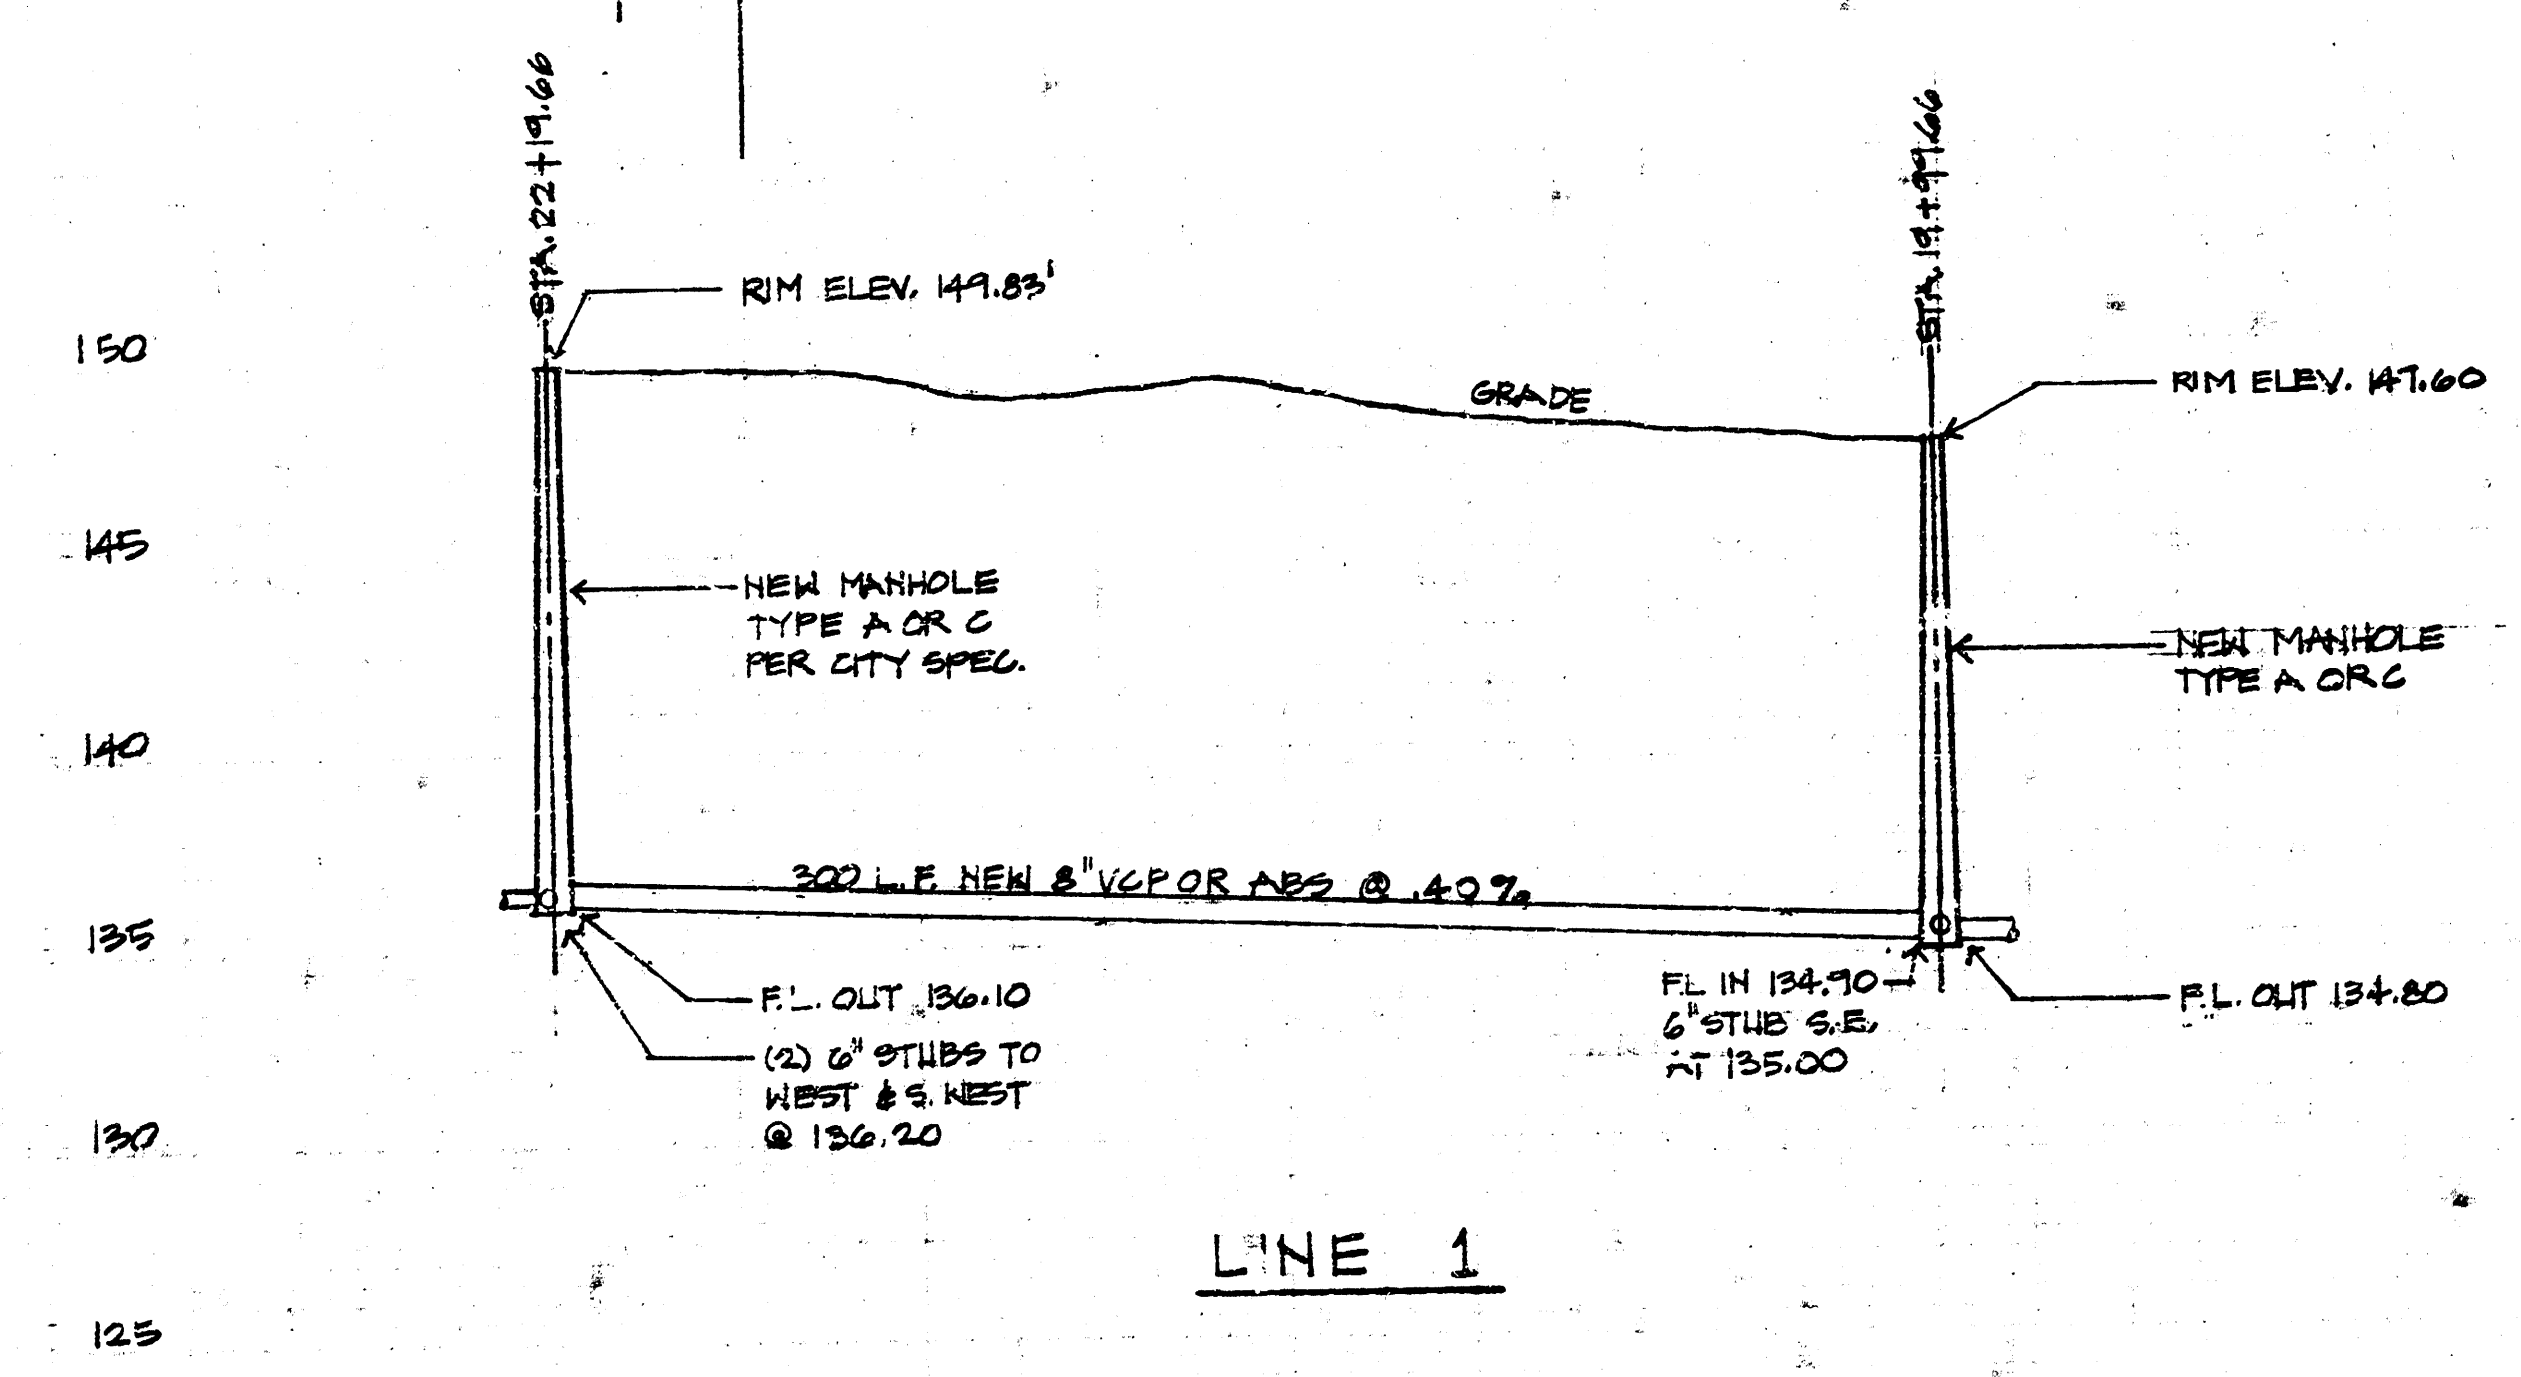

PROFILE SCALES
 VERT. - 1" = 5'
 HORIZ. - 1" = 30'

Lot 1, 2 & 3 Farmington Square Addn.
 448-76-245-80746-000-000-008

23 22 21 20 19 18 17 16 15 14 13 12