


Bench Mark: Square Cut in Top of Curb
14' North of Manhole @ Sta. 0+00
Elevation = 86.69 City Datum.

Bench Mark: Nail in Cap, located 30'
East of Manhole @ Sta. 3+85.9
Elevation = 86.69 City Datum

Scale: 1" = 20' Plan
1" = 5' Profile

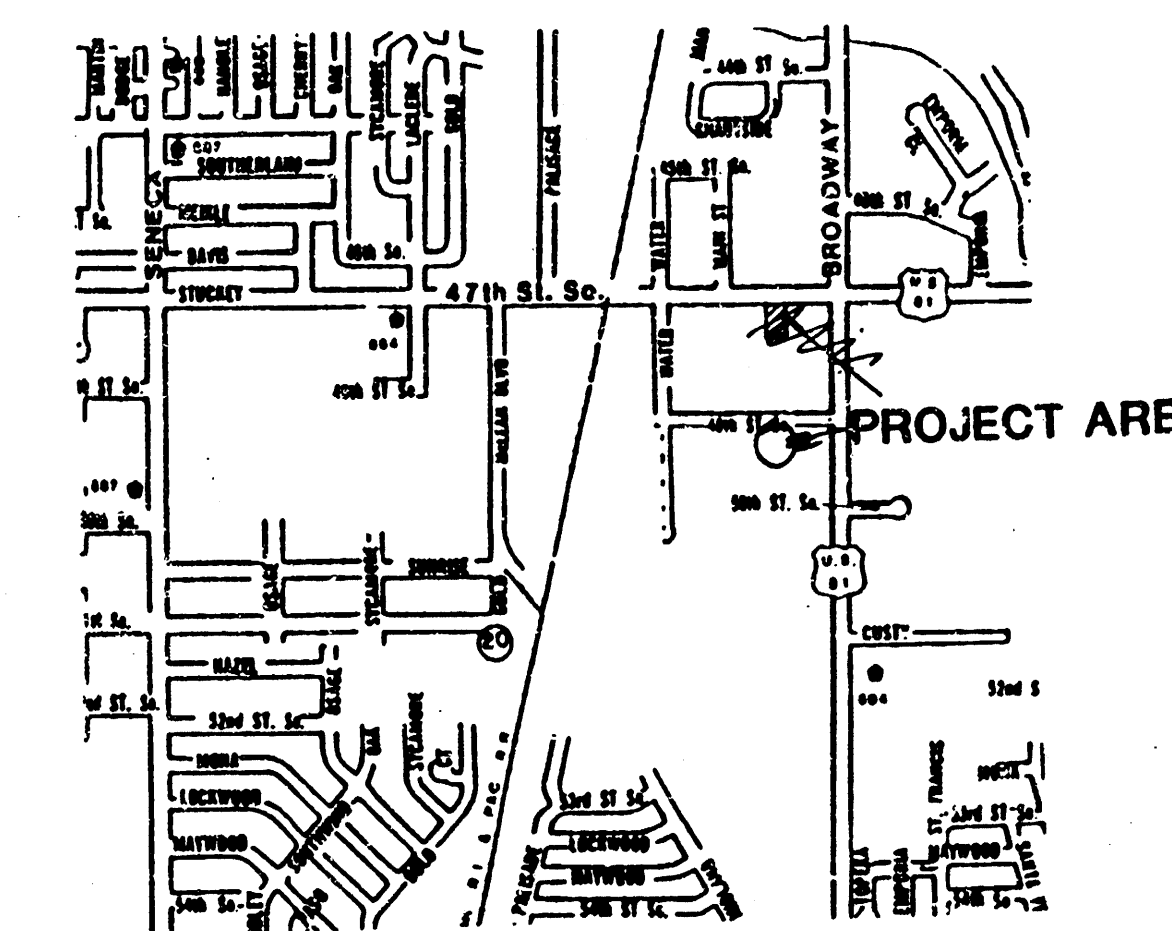

GENERAL NOTES

Existing utility lines and their location, as shown on the plans, represent the best information obtainable for design. The Contractor will be required to work around existing utilities which do not conflict with proposed construction.

The contractor shall be responsible for locating all underground utility lines prior to construction of the sanitary sewer. This includes all public and private utilities that may be present on the site.

NOTE TO CONTRACTOR

INSPECTION AND TESTING FOR THIS PROJECT IS TO BE PROVIDED BY A LICENSED CONSULTING ENGINEERING FIRM UNDER CONTRACT WITH THE OWNER/DEVELOPER. SAME INSPECTION TO BE IN ACCORDANCE WITH THE CITY OF WICHITA STANDARD CONSTRUCTION ENGINEERING PRACTICES AND PERFORMED BY A LICENSED PROFESSIONAL ENGINEER. ANY WORK SHALL BE PERFORMED WITHIN THE CITY OF WICHITA. THE CONTRACTOR SHALL HAVE THE RIGHT OF WAY BY THE CITY ENGINEER WITHOUT QUESTION. THE CONTRACTOR SHALL HAVE THE RIGHT OF WAY BY THE CITY ENGINEER WITHOUT QUESTION. THE CONTRACTOR SHALL HAVE THE RIGHT OF WAY BY THE CITY ENGINEER WITHOUT QUESTION.

APPROVED AS NOTED
By CITY ENGINEER OF WICHITA

Sanitary Sewers KRH 7/17/89
Storm Sewers
Driveway Approaches
Water Mains
Paving

REVISED AS BUILT 7-25-89

INDEX CODE 222 PPS

PRIVATE SANITARY SEWER RELOCATION
TO SERVE LOT 1, FIREBALL ADDITION
CITY OF WICHITA, KANSAS


BAUGHMAN COMPANY, P.A.
SURVEYING & ENGINEERING
3102008-7271 315 ELLIS - WICHITA, KANSAS 67211

Drawn: C. Bohm, Checked: C. Bohm, Date: 7/89, Scale: Noted

FILMED FROM THE BEST
AVAILABLE COPY....

PLAN	DATE
NOTED	
REVISION	
BY	
DATE	

PROFILE	DATE
NOTED	
REVISION	
BY	
DATE	

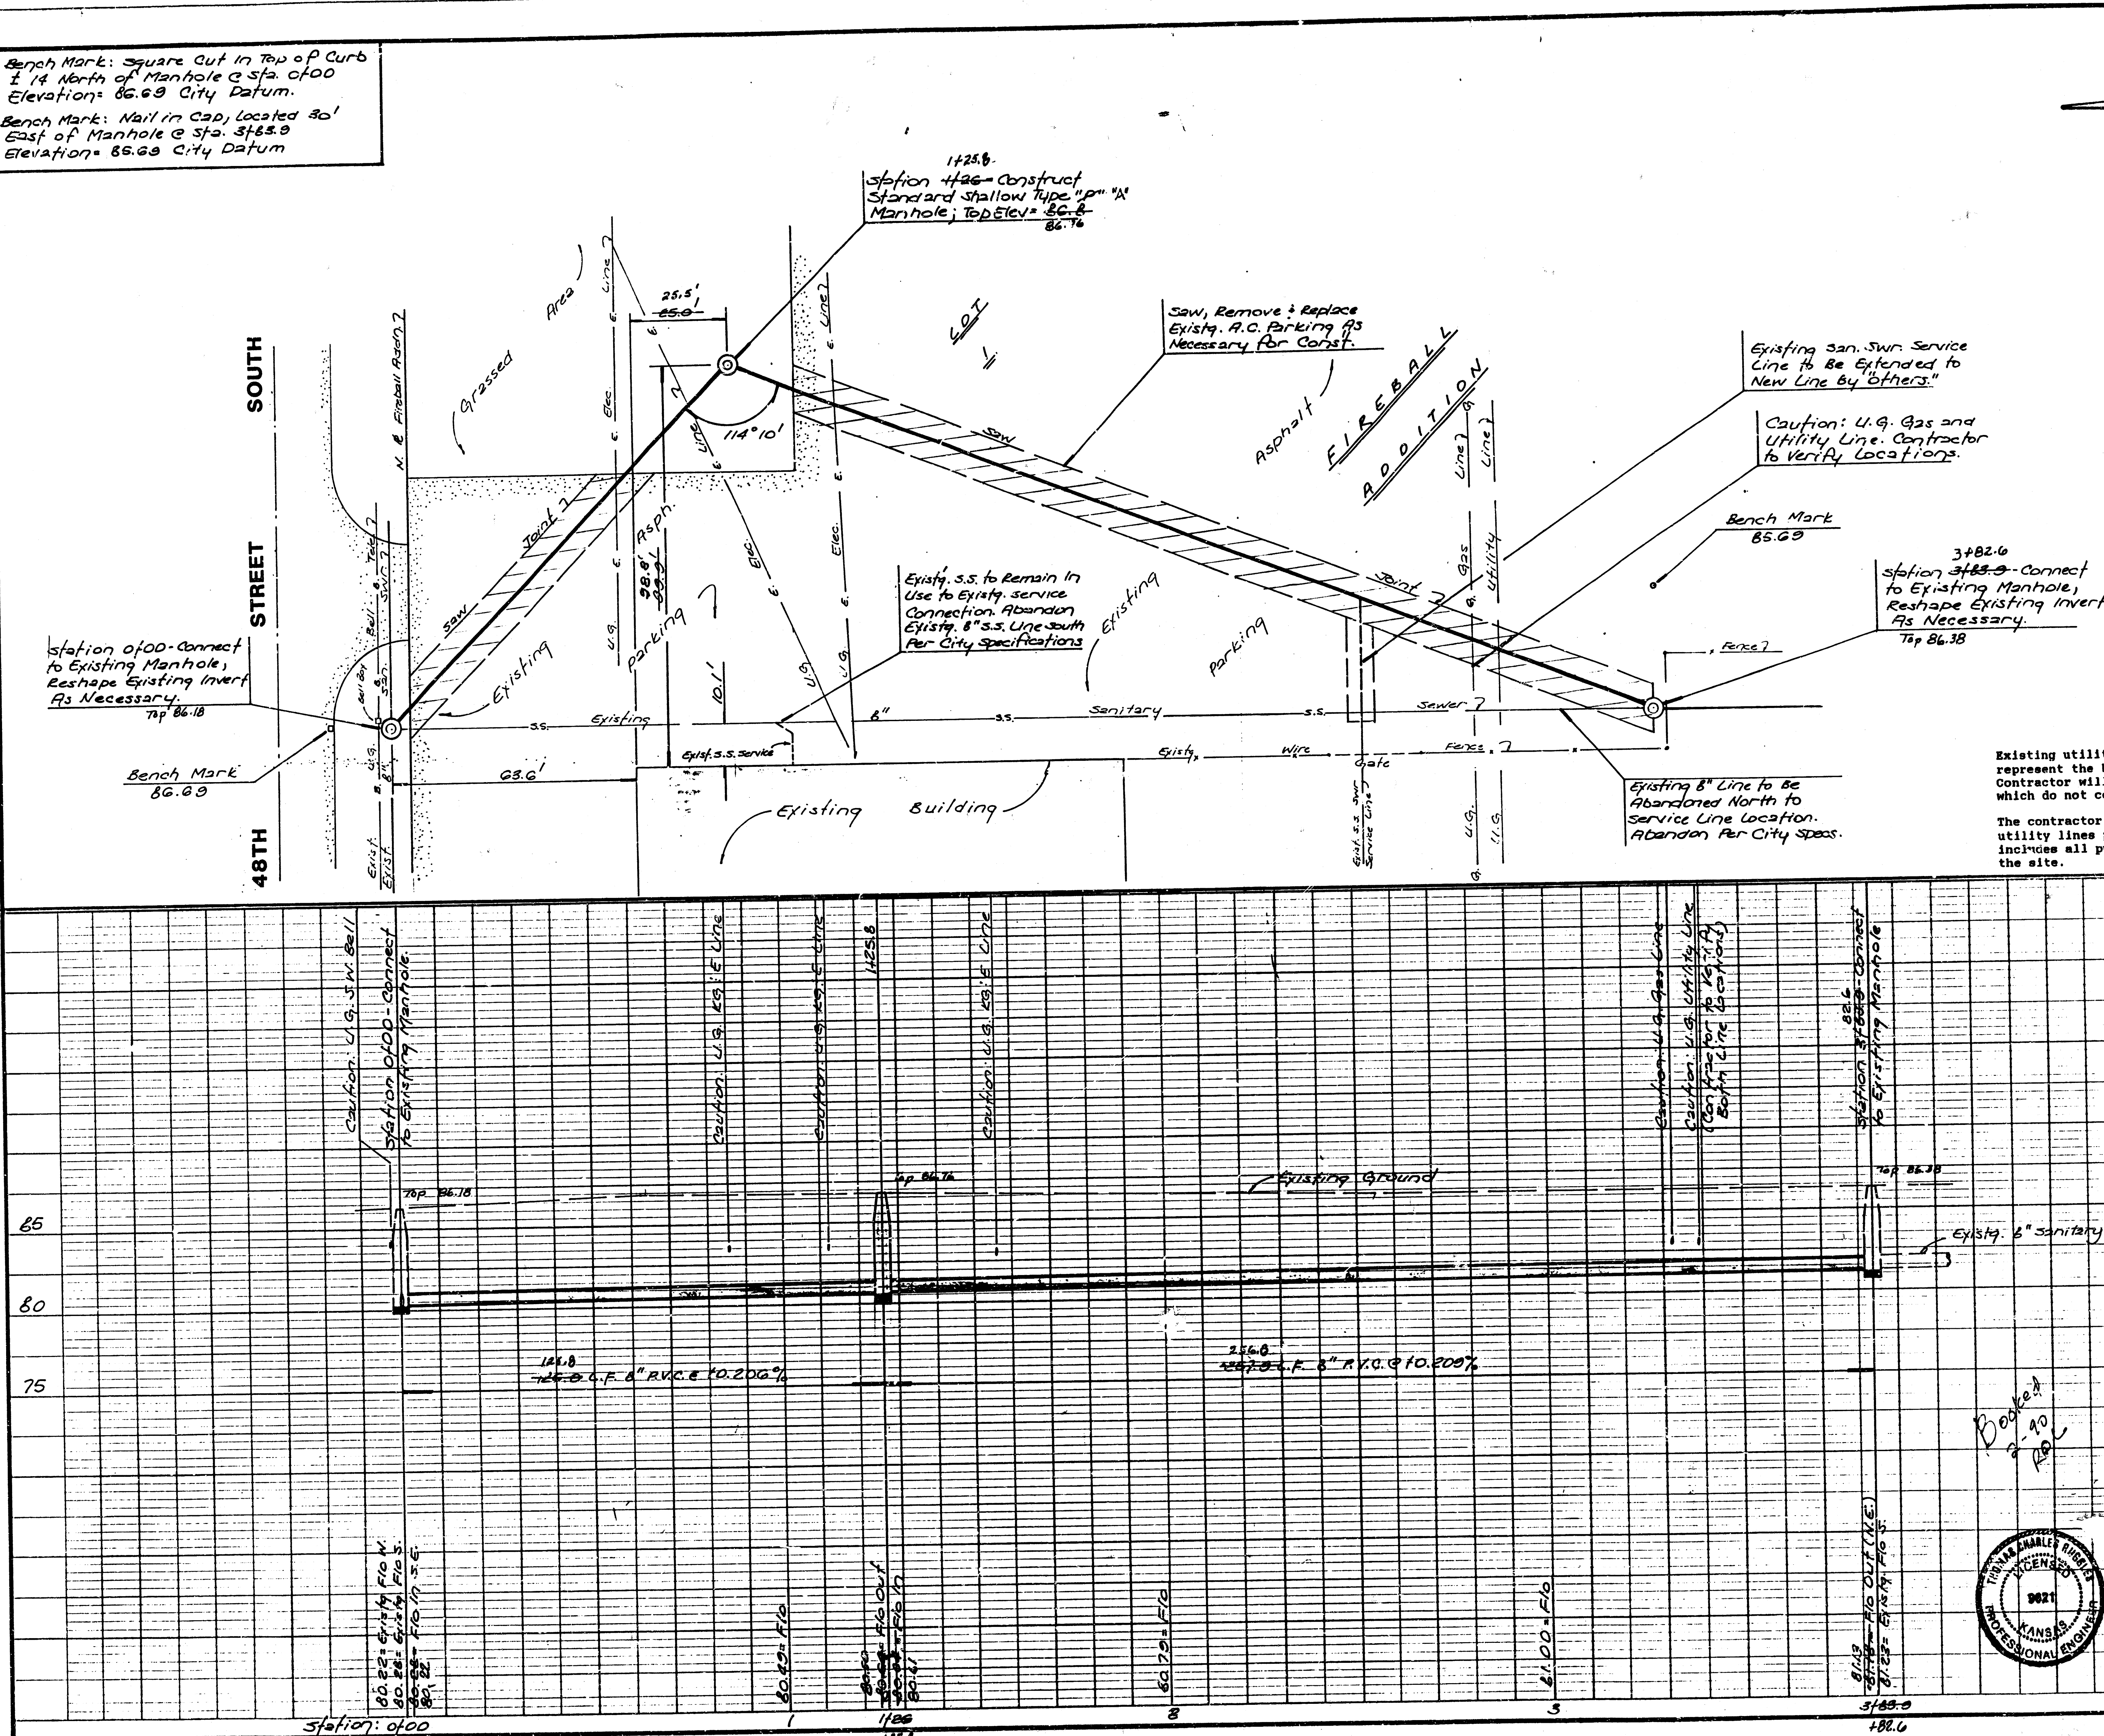

FILMED FROM THE BEST
AVAILABLE COPY.....