


GAS SERVICE CO. REPORT NO LINES
IN THIS AREA.

1" = 50' HORIZ.
1" = 5' VERT.

B.M. : ELEV. 176.92 - WEST RIM OF CITY OF WICHITA
MH 54' NORTH & 37' WEST OF
THE S.E. COR. SE 4 SEC. 20-27-2E

NOTE: ADD 0.25 TO ELEVATIONS SHOWN TO OBTAIN
CITY OF WICHITA DATUM

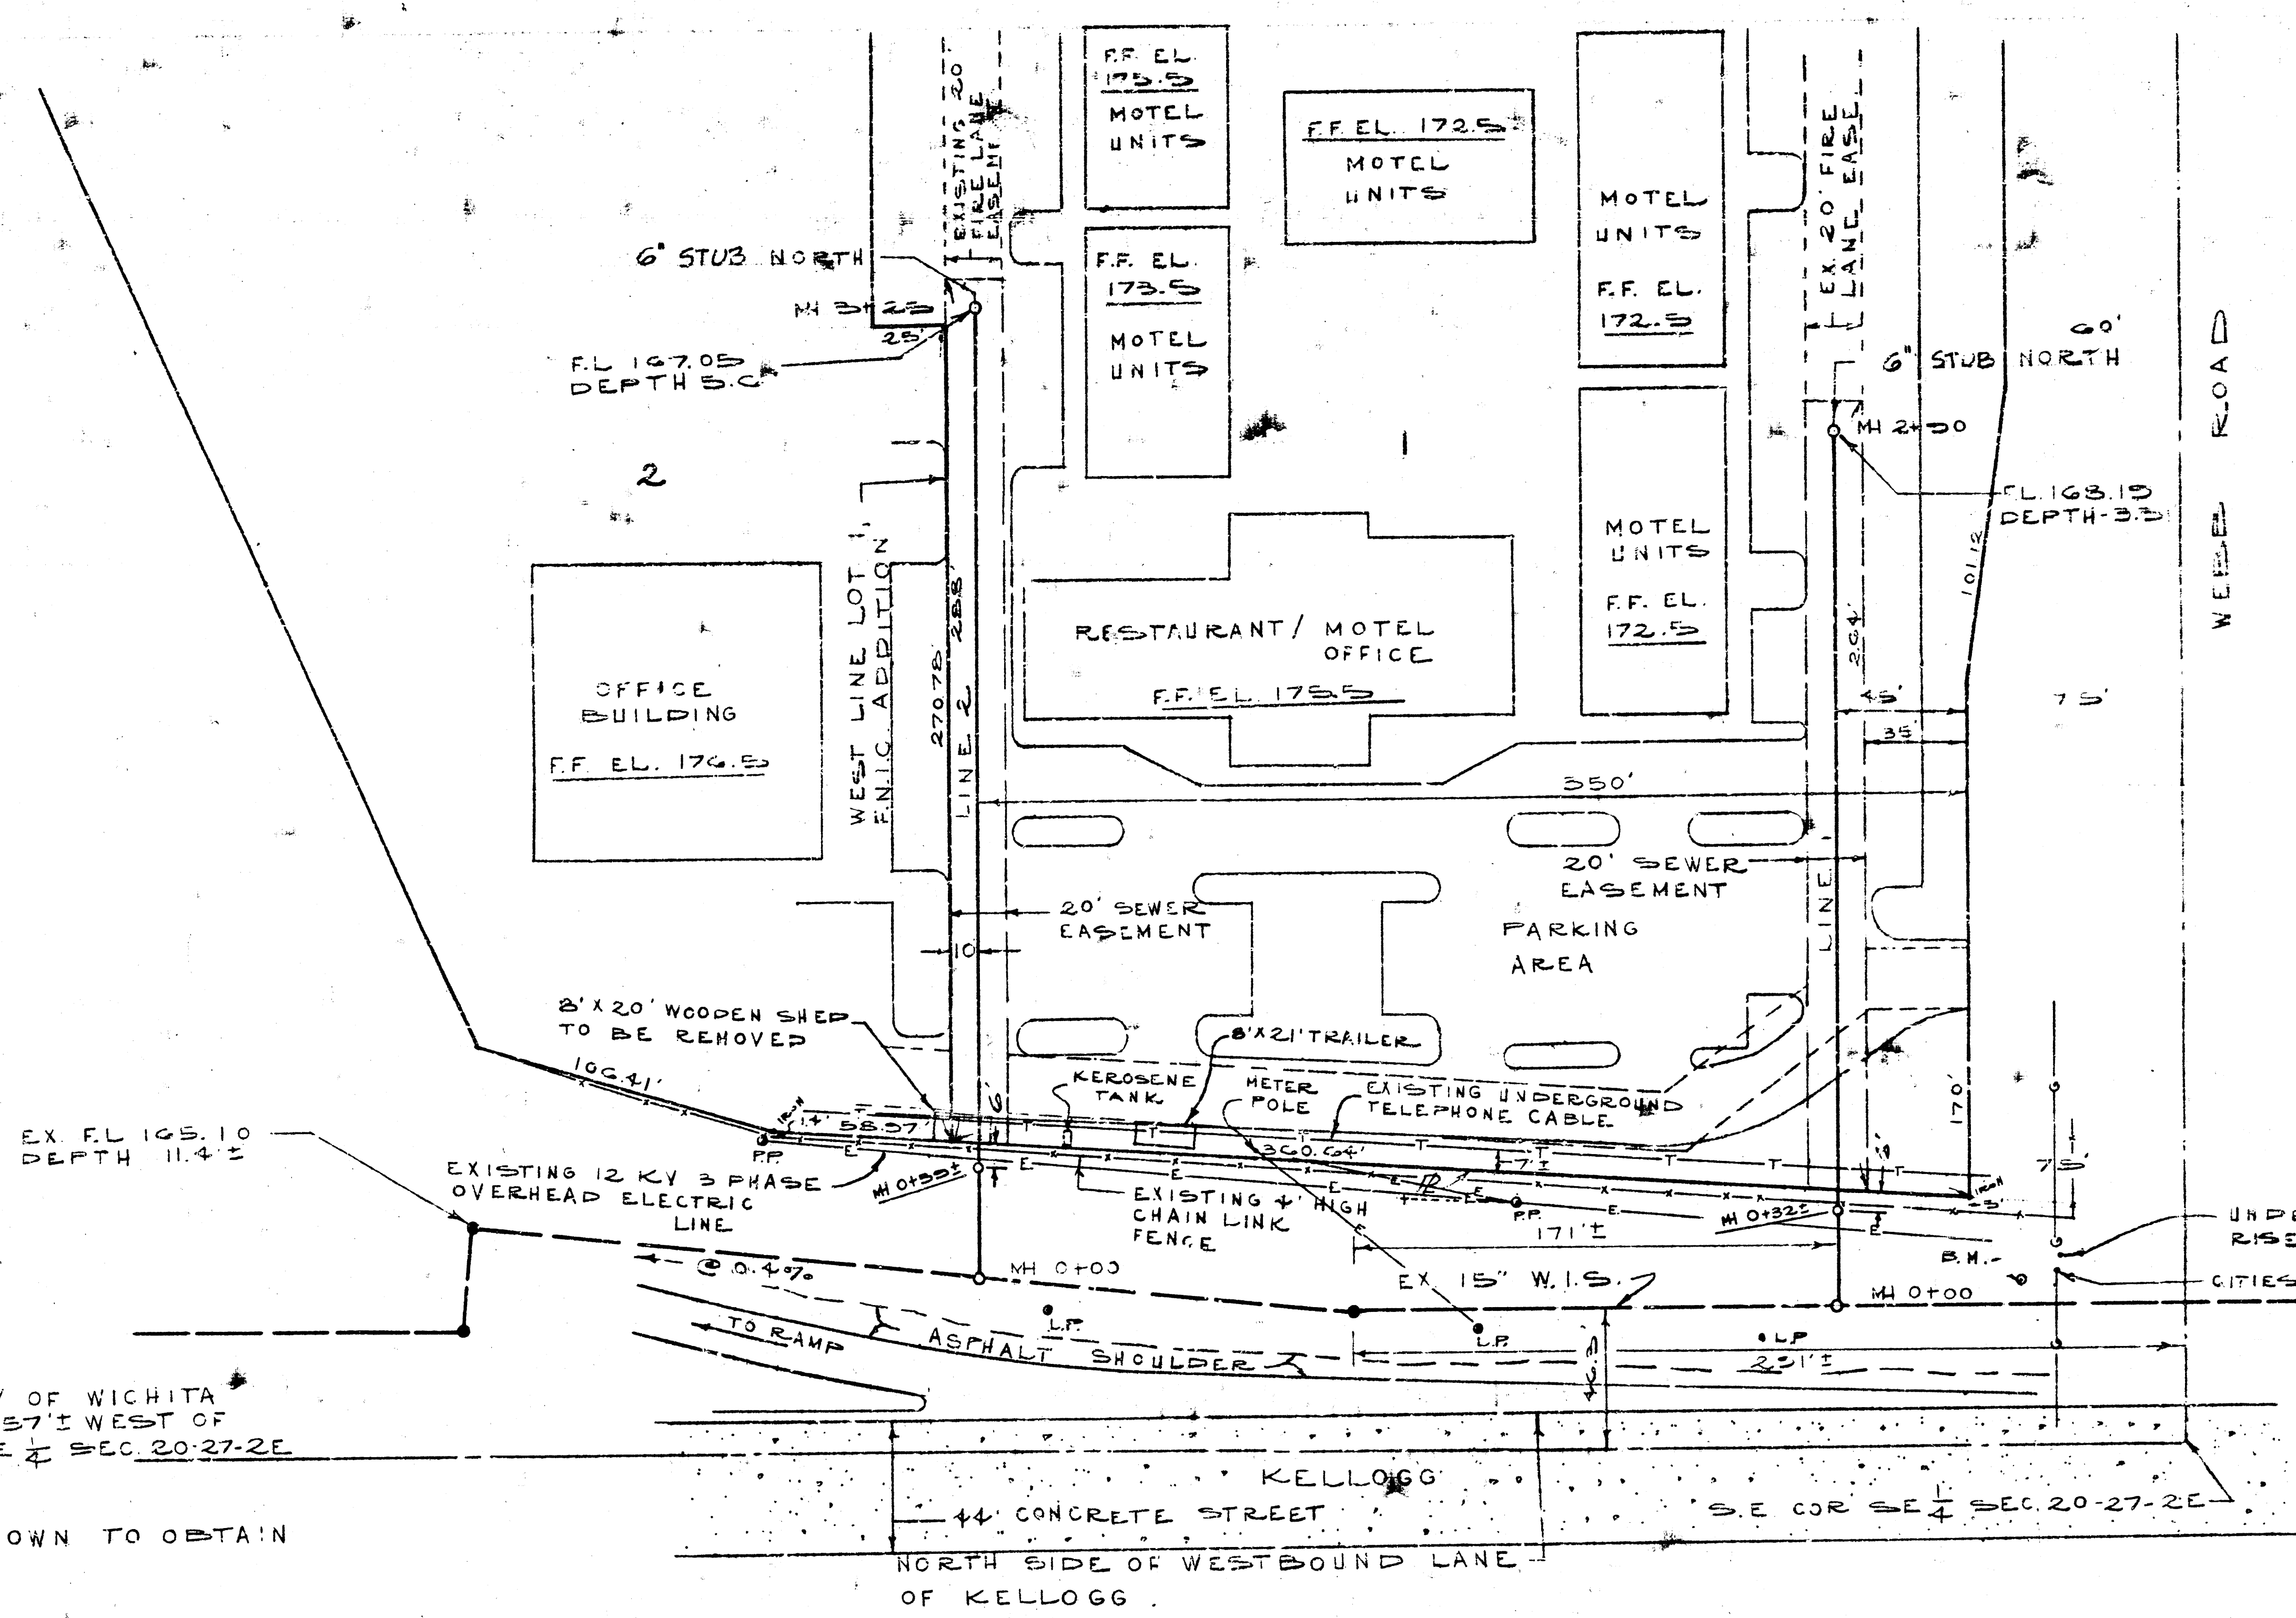

NOTE TO CONTRACTOR:
CALL GEORGE HOFSESS - CITIES SERVICE
GAS CO. PHONE 524-0491 AND SOUTHWEST
BELL TELEPHONE CO. BEFORE COMMENCING
WORK.

7-24-74
APPROVED AS NOTED
By CITY ENGINEER OF WICHITA
Sanitary Sewers 8" P.E.S.
Storm Sewers
Runway Approaches

NOTE TO CONTRACTOR
This project will be constructed under
the supervision of the CITY ENGINEER
and conforming to the SPECIFICATIONS
of the CITY OF WICHITA. The CON-
TRACTOR will reimburse the City of
Wichita for all cost of ~~inspection~~.

11-10-74 SANITARY
SEWER EXTENSION
ENIG ADDITION

K.O. TAYLOR, P.E.
DEC. 19, 1973
REVISED JAN. 22, 1974
Rev. 7-23-74



Note: Building Layout furnished by others.
Manholes - Poured concrete to City of Wichita Specs.

PROJECT: DBKW 703072

