

BENCH MARK: City Standard Disc, 44' S. of
 E. Central and 39' E. of Quarter Section
 Corner and 19' E. of center West Parkway
 Elev. = 167.28 City Datum

STATION 0+00 CONSTRUCT
 STD. TYPE 'B' MANHOLE
 OVER EXISTING LINE

SAW JOINT - REMOVE & REPLACE
 ASPHALT PAVEMENT AS NECESSARY
 SEE DETAIL SPEC'S FOR
 PAVEMENT REPLACEMENT.

CONSTRUCT TWO
 RETAINING WALLS
 SEE DETAILS

STA. 1+20 END
 PIPE CONSTRUCTION

FOREST HILLS ADDITION




NOTE TO CONTRACTOR
 This project will be constructed under
 the supervision of the CITY ENGINEER
 and conforming to the SPECIFICATIONS
 of the CITY OF WICHITA. The CON-
 TRACTOR will prepare the City of Wichita
 for all items of inspection.

10-18-84
 APPROVED AS NOTED
 By CITY ENGINEER OF WICHITA
 See notes and 10-18-84
 Sanitary Sewers
 Storm Sewers
 Driveway Approaches

NOTE NO. 1 - WORK SHOWN ON THIS PLAN HAS BEEN REVIEWED FOR LOCATION AND
 CONFORMANCE TO APPLICABLE ADOPTED CITY STANDARDS ONLY.



SCALE 1" = 40' HORIZ
 1" = 5' VERT

PLAN	DATE	BY	CHKD
DESIGNED			
DRAWN			
CHECKED			
APPROVED			

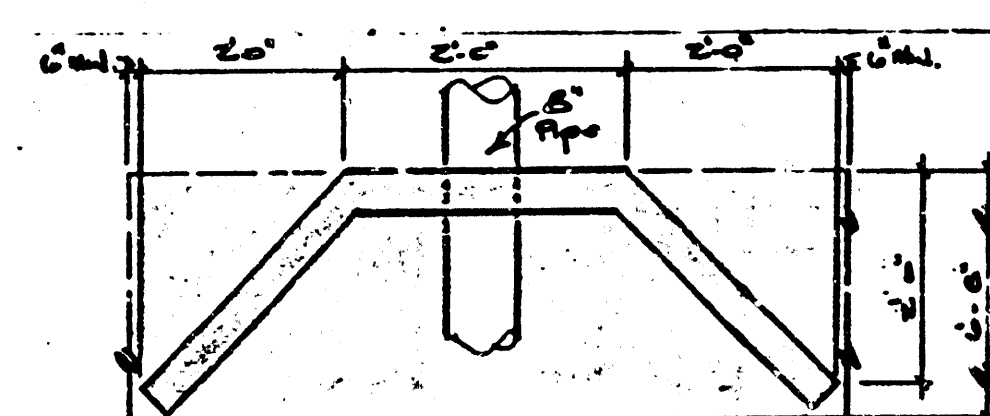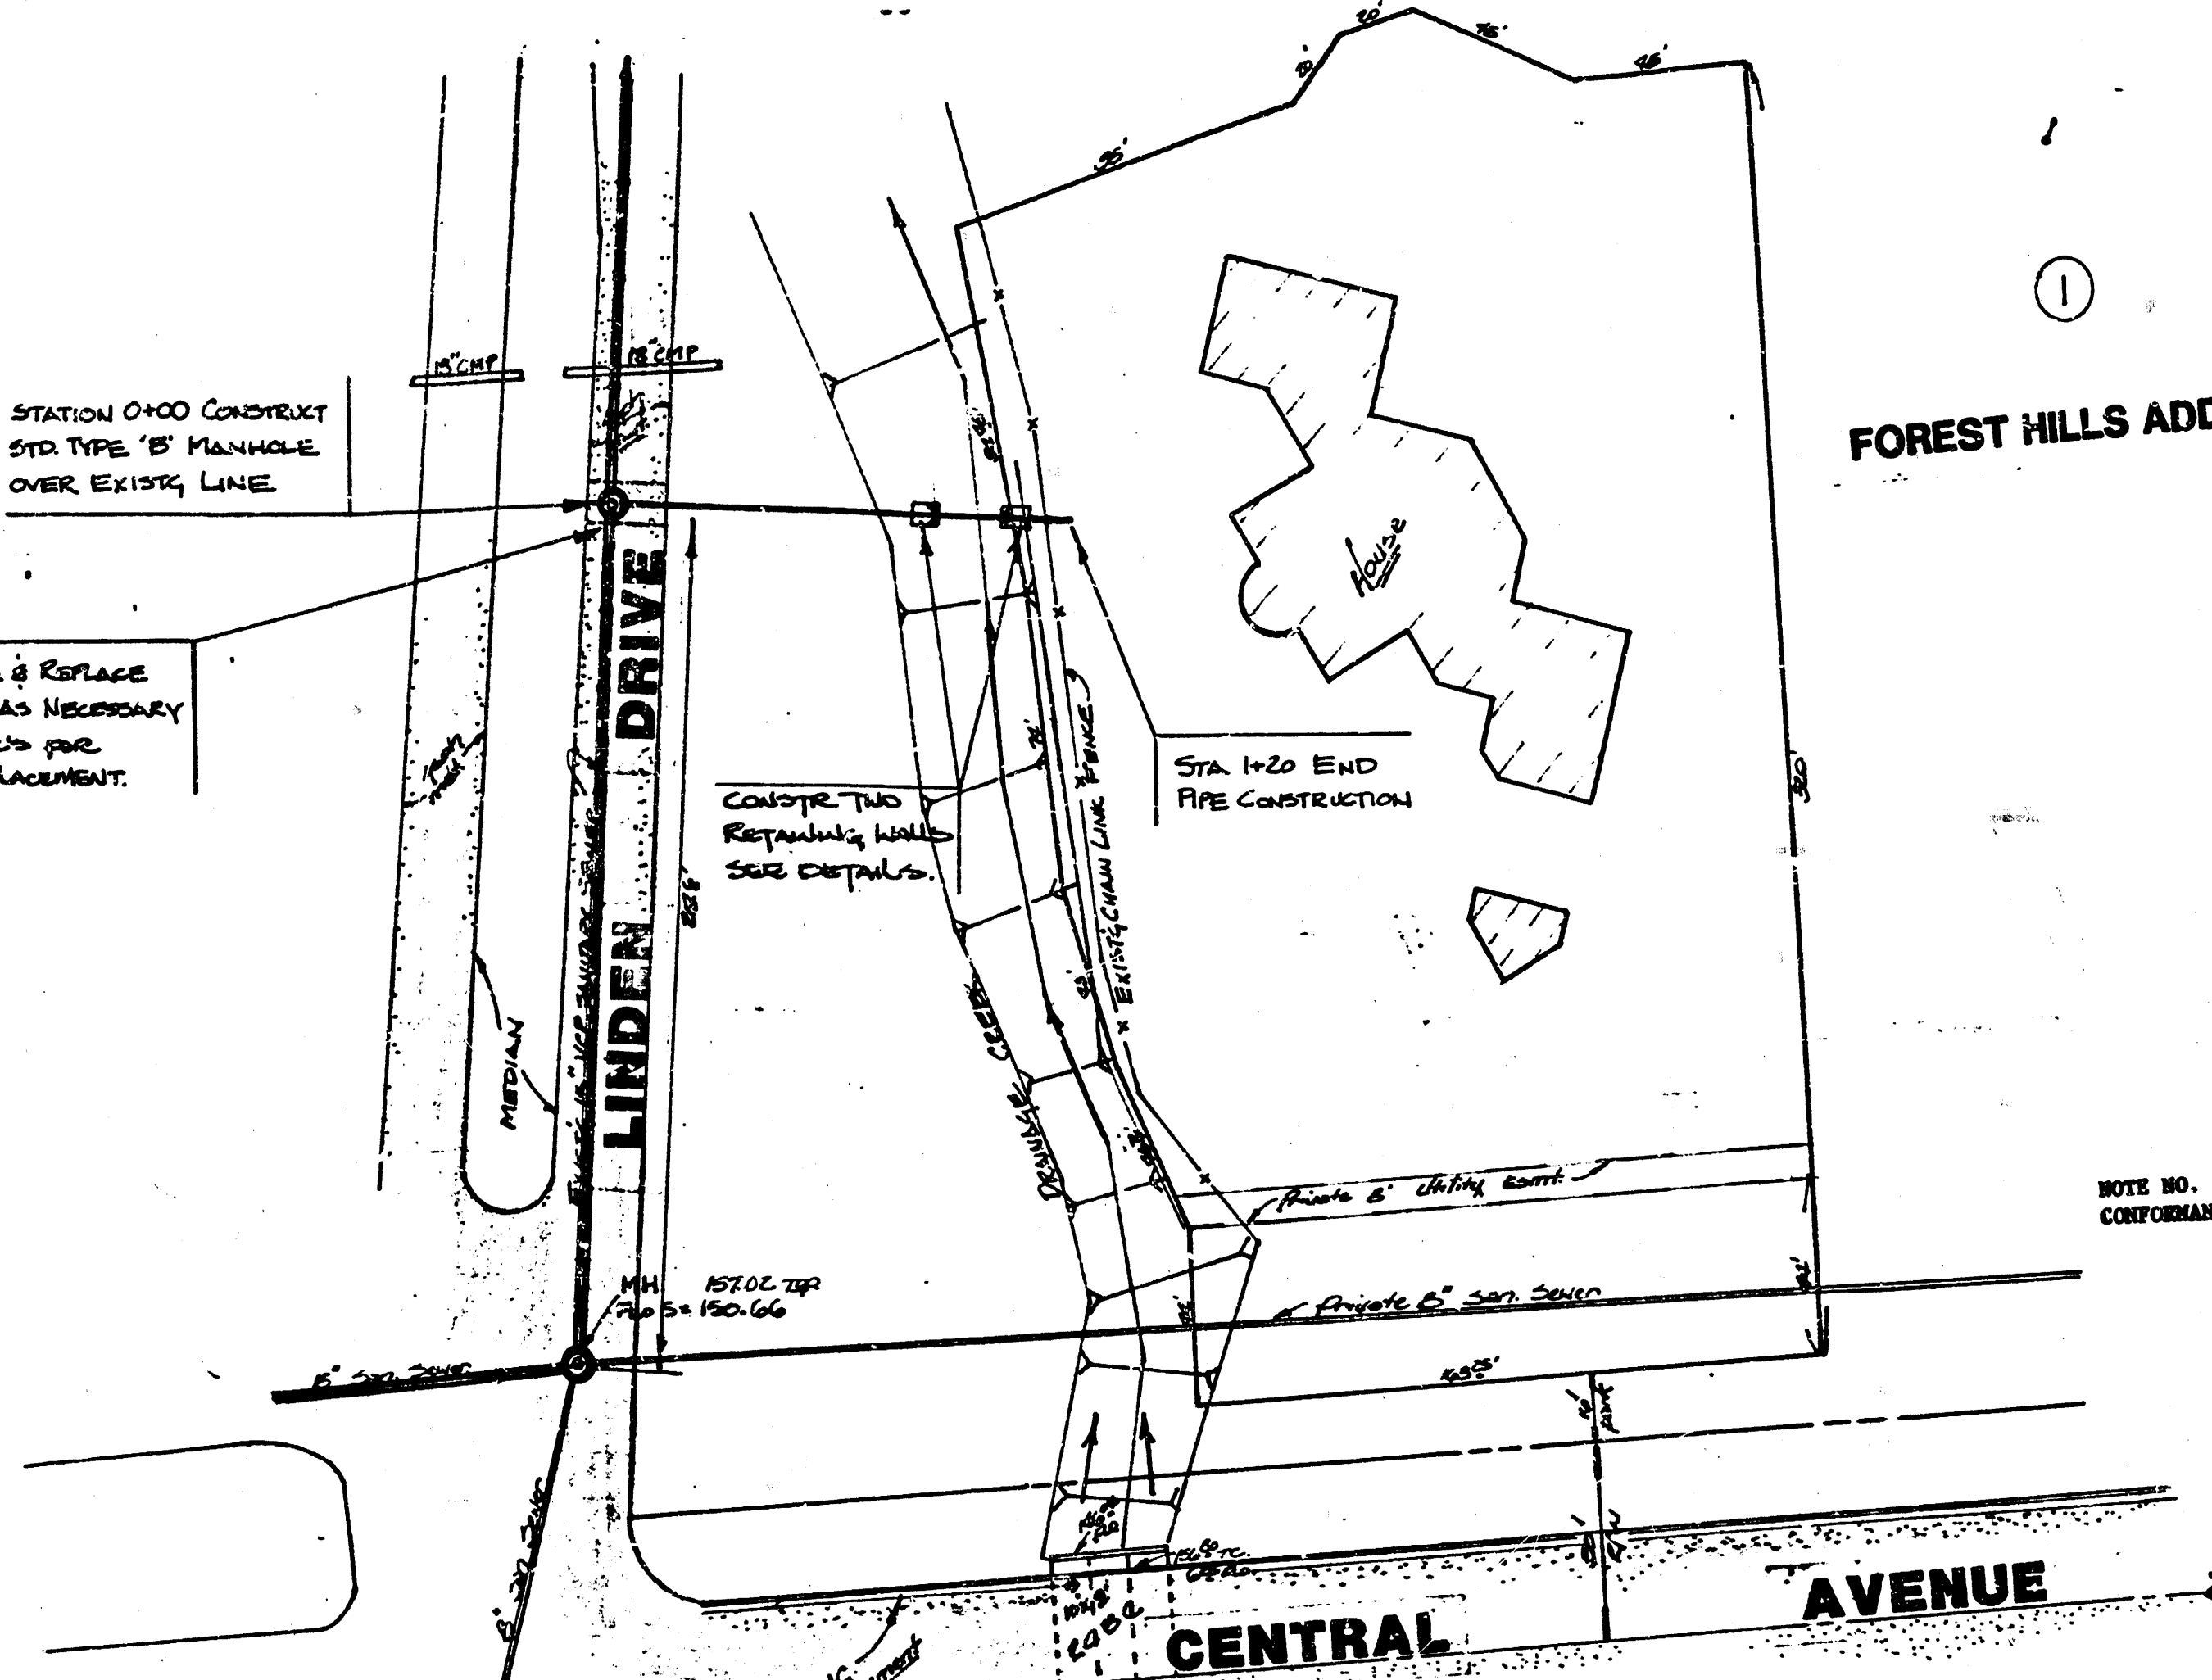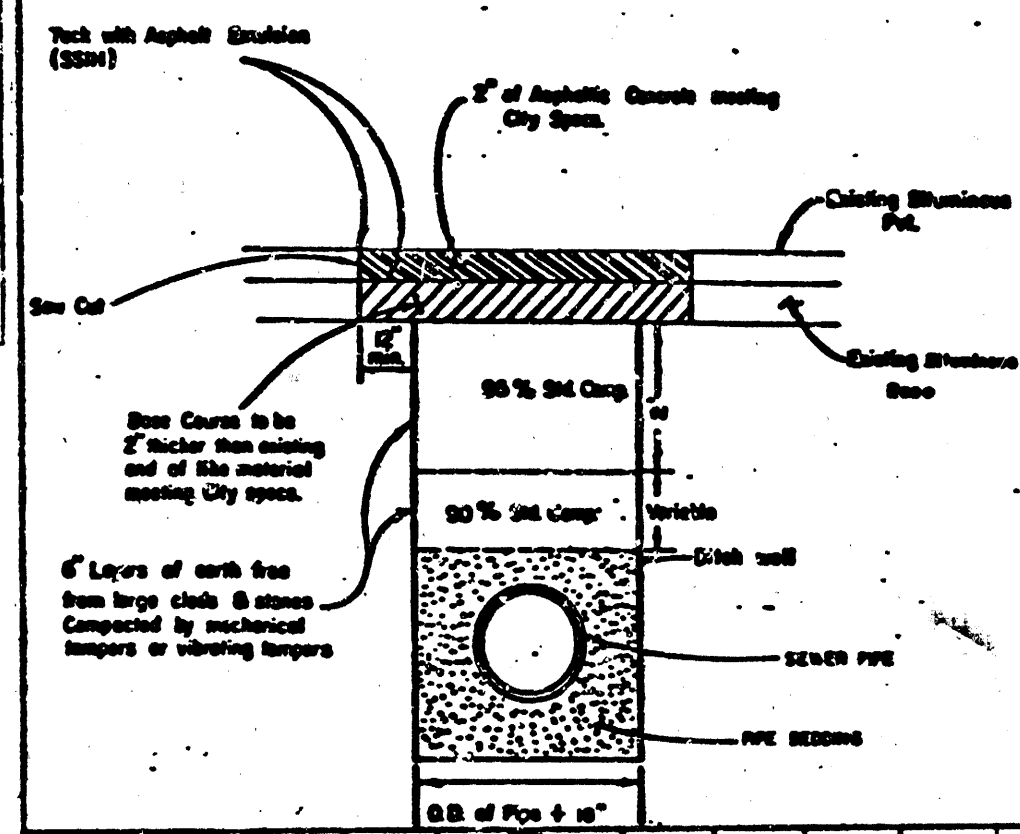

PROFILE	DATE	BY	CHKD
DESIGNED			
DRAWN			
CHECKED			
APPROVED			


PAVEMENT REPLACEMENT DETAIL

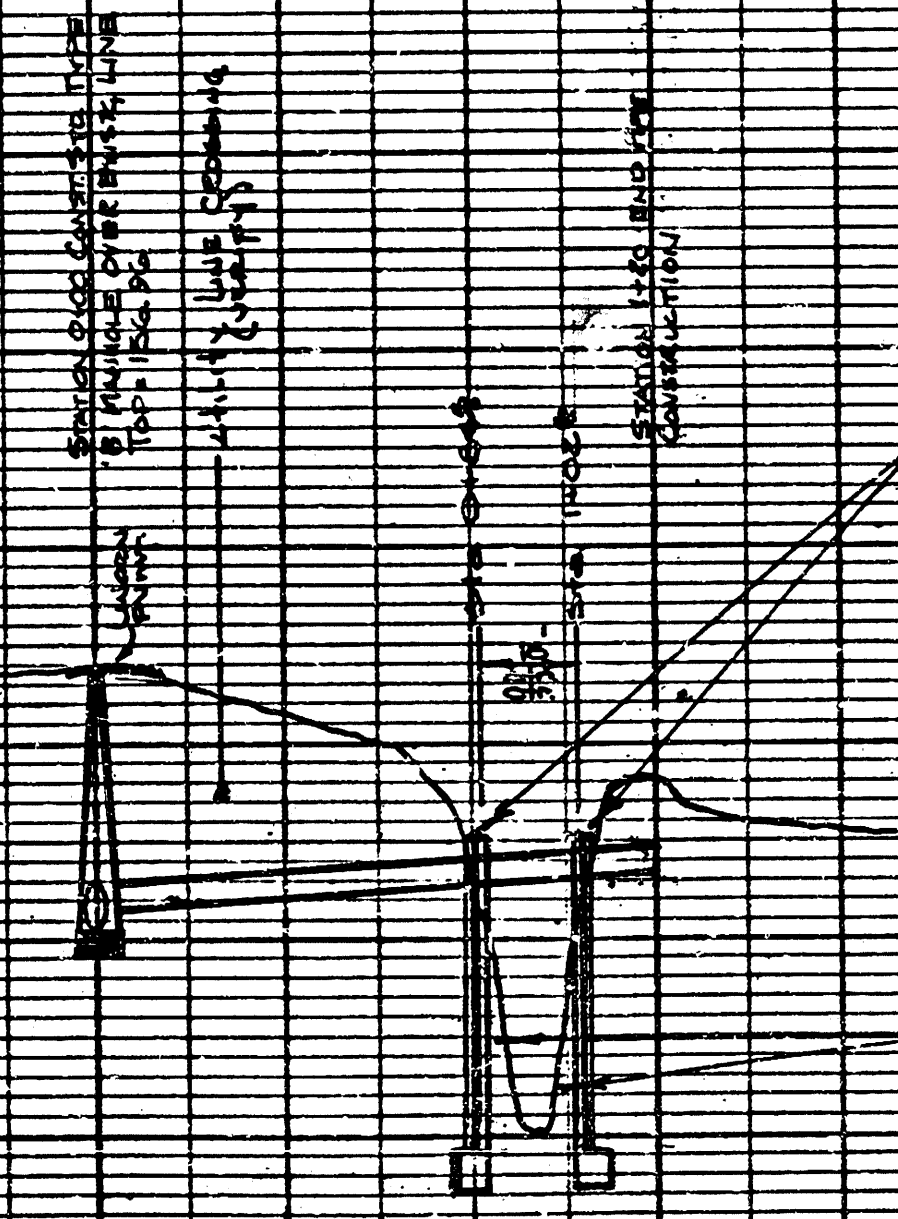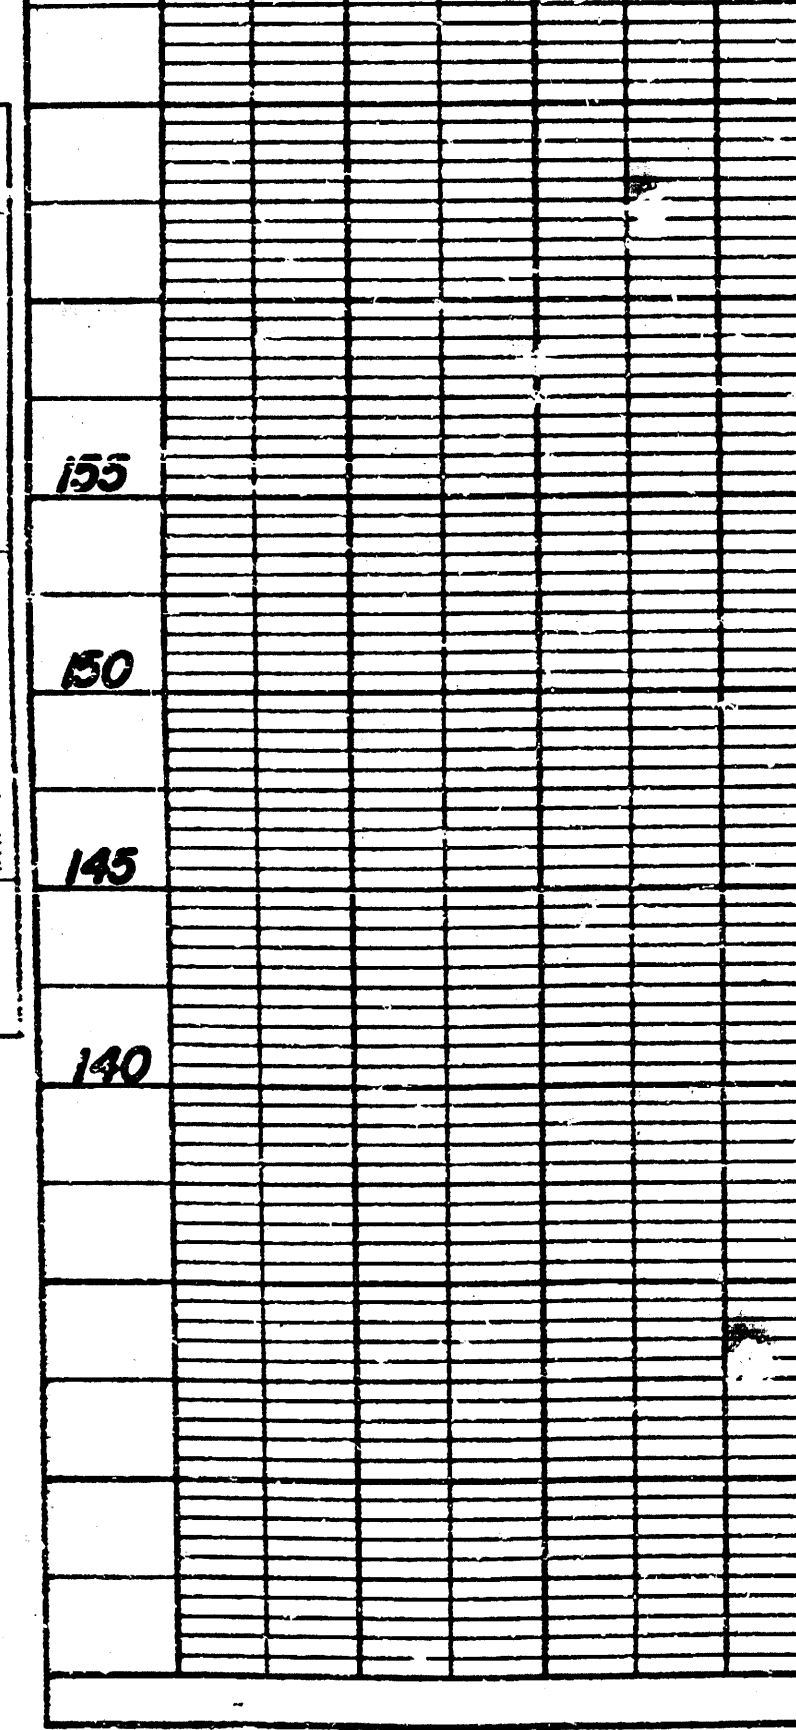

NOTE: PIPE CAPPING TO BE SUPPORTED BY
 THE RETAINING WALL STRUCTURES
 SEE DETAILS

NOTE - CONTRACTOR TO PRESERVE & PROTECT ALL
 EXISTING CREEK BANK AS MUCH AS POSSIBLE DURING
 THE CONSTRUCTION & RECONSTRUCTION OF THE RETAINING
 WALLS FOR FUTURE CITY USE.

SEE CC & Details for
 Pipe, Manhole class, etc.
 as indicated on drawings
 and as approved
 by City Engineer

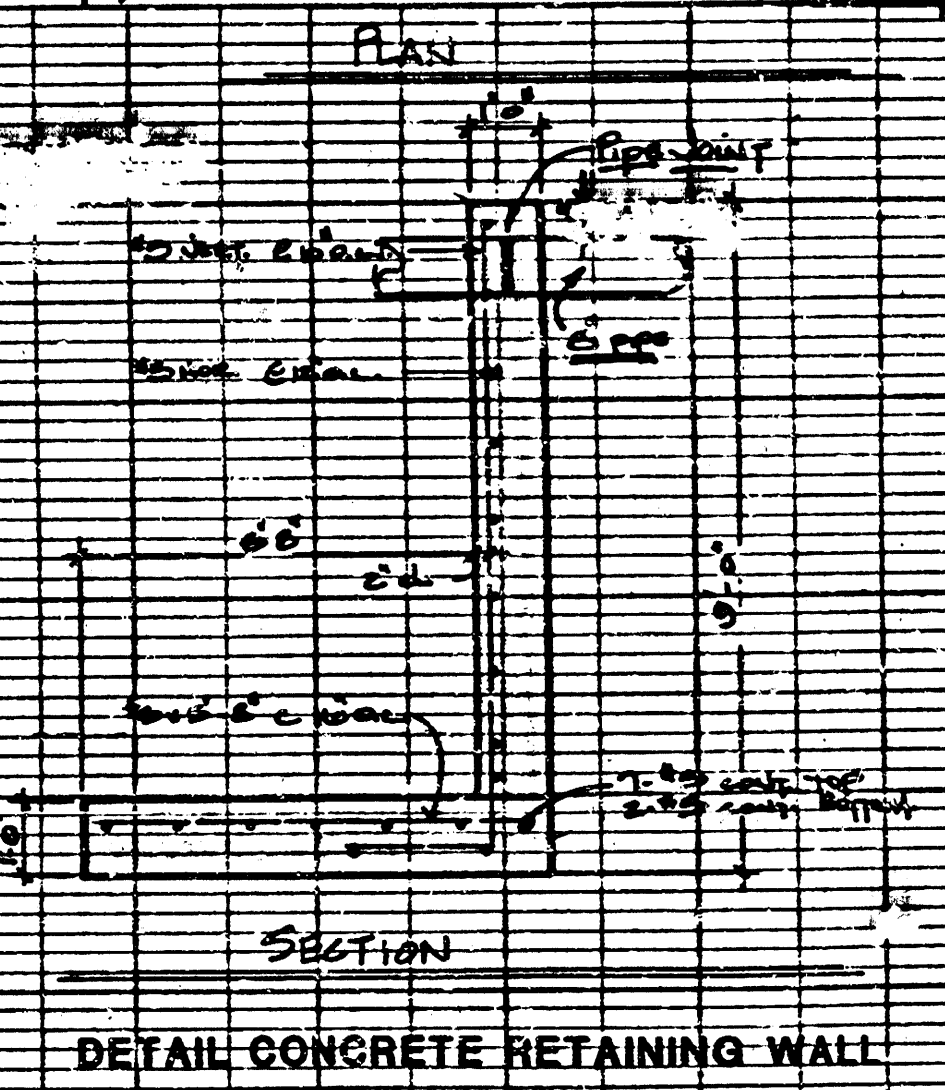

DETAIL CONCRETE RETAINING WALL

NOTE: Contractor to construct Retaining Wall structure for
 supporting existing structures which may be on the
 west side of Central Drive prior to beginning of wall
 construction of this project.
 Pipe joints shall be installed to where the wall
 falls on the west side of the retaining wall structure.
 Contractors shall construct concrete footing, etc. also
 at City of Wichita to insure verticality and supporting services
 and shall provide any construction previously.



OCTOBER 1984

PRIVATE SANITARY SEWER TO SERVE PART
 OF LOT 7, BLK 1, FOREST HILLS ADDITION

PROJECT NO. 468-78-245-80000-000-000-008

CITY OF WICHITA, KS

BAUGHMAN COMPANY, P.A.
 SURVEYING & ENGINEERING
 318/683701 • WICHITA, KANSAS 67211

PLATE 1 - PLAN - PROFILE - F.A.S.
 CLEARPRINT PAPER CO. 5.7.04.
 NO. 10061

10 8 5 1