
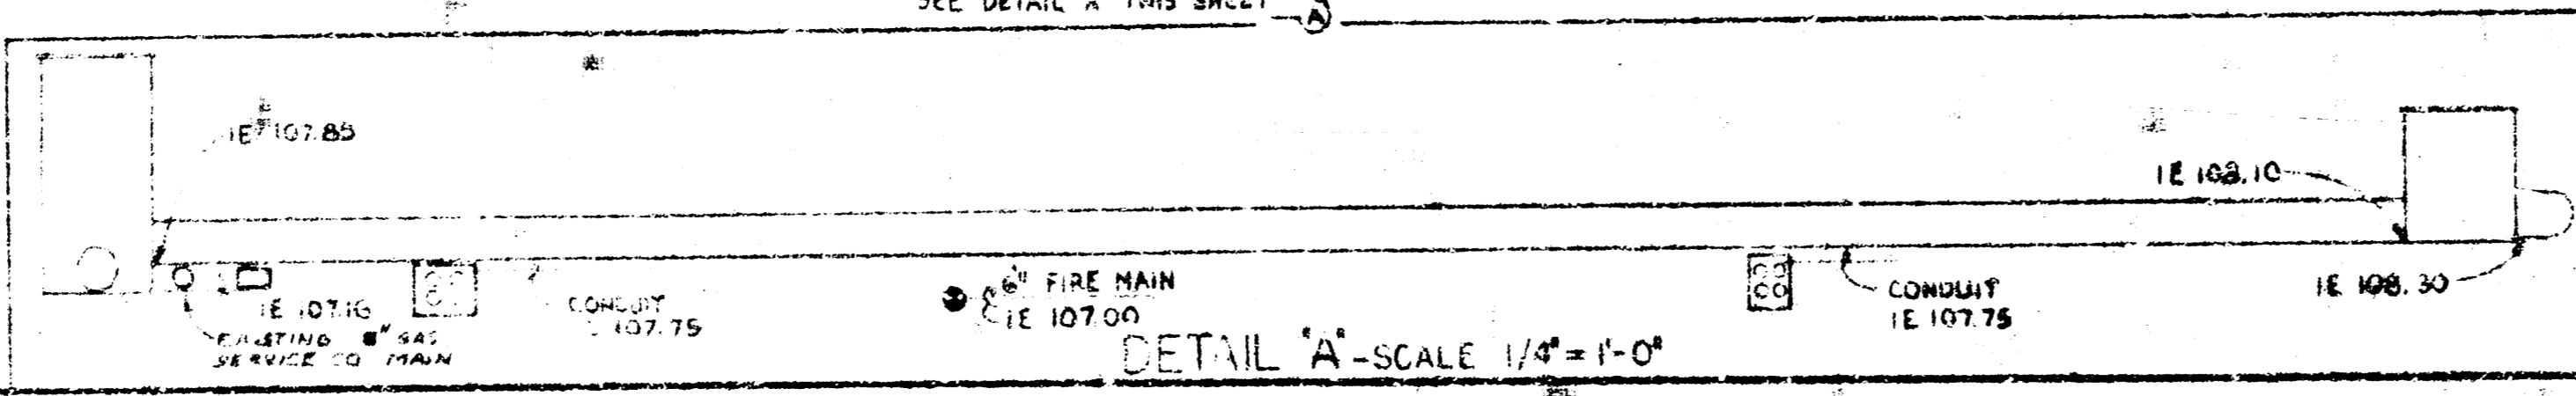


This Drawing Submitted For Approval

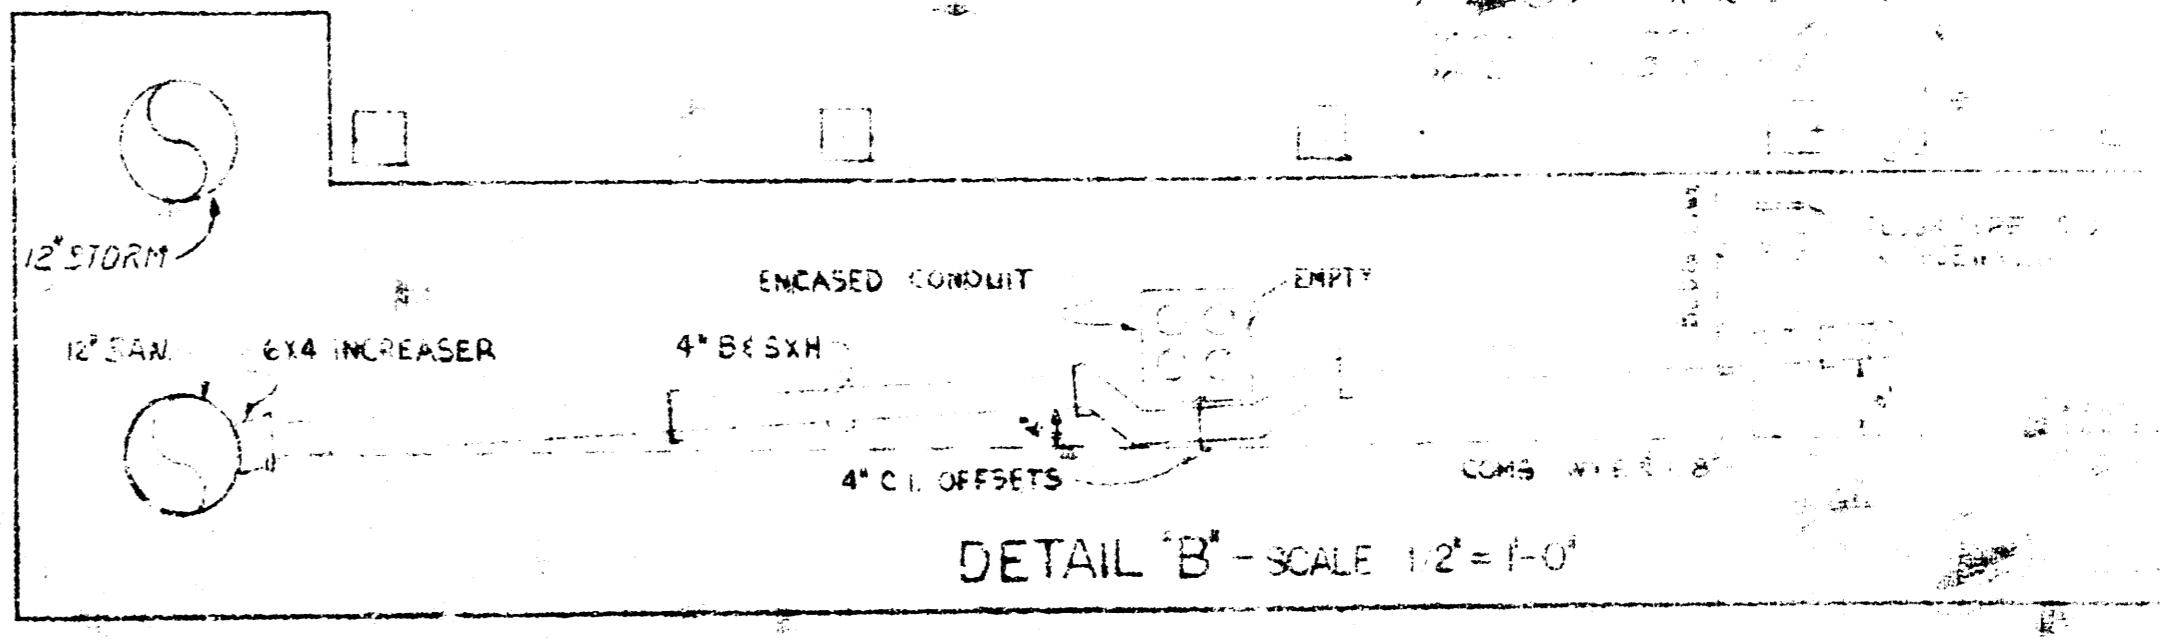

FINAL AS BUILT DRAWING

RENDALL, INC.	
PROJECT NO. 17-0110	DATE 02/02/10
BY: [Signature]	CHECKED BY: [Signature]
DESIGNED BY: [Signature]	UNDERGROUND PIPING