

CITY OF WICHITA, KANSAS

SANITARY SEWER IMPROVEMENTS TO SERVE PUBLIC SAFETY FACILITY IN HERMAN HILL PARK

INDEX:

SHEET	1	TITLE SHEET
SHEET	2	PLAN-PROFILE SHEET

GENERAL NOTES:

- UTILITY SERVICE LINES, POLES, VALVE BOXES, METERS AND ETCETERA ARE TO BE ADJUSTED AS NECESSARY BY OTHERS PRIOR TO CONSTRUCTION UNLESS THE PLANS SPECIFICALLY CALL FOR THEIR ADJUSTMENT BY THE CONTRACTOR OR UNLESS THE PLANS SPECIFICALLY IDENTIFY A UTILITY TO BE ADJUSTED BY ITS OWNER DURING CONSTRUCTION. EXISTING UTILITIES AND THEIR LOCATION AS SHOWN ON THE PLANS REPRESENT THE BEST INFORMATION OBTAINABLE FOR DESIGN. THE CONTRACTOR WILL BE REQUIRED TO WORK AROUND EXISTING UTILITIES WITHIN THE RIGHT-OF-WAY WHICH DO NOT CONFLICT WITH PROPOSED CONSTRUCTION.
- THE CONTRACTOR SHALL PROVIDE A MINIMUM OF FORTY-EIGHT (48) HOURS ADVANCE NOTICE TO ALL UTILITY OWNERS PRIOR TO WORK IN ANY AREA WHERE EXISTING UTILITIES WILL BE UNCOVERED TO ALLOW THE UTILITY OWNER TO INSPECT THE UNCOVERING OF THEIR UTILITY. ANY UTILITY CARELESSLY DAMAGED BY HIS CONSTRUCTION OPERATION SHALL BE REPAIRED OR REPLACED AT NO EXTRA COST TO THE CITY. THE CONTRACTOR SHALL COORDINATE WITH CONTRACTORS FOR UTILITY COMPANIES AND OTHER AGENCIES FOR MINIMUM INCONVENIENCE TO GENERAL PUBLIC.
- CONTRACTOR SHALL AVOID UNCOVERING THE EXISTING WATERLINES UNLESS ABSOLUTELY NECESSARY. UNCOVERING SHALL BE DONE ONLY IN THE PRESENCE OF A WATER DEPARTMENT ENGINEER.
- THE CONTRACTOR SHALL COORDINATE THE RELOCATION, TIE-BACK, PROTECTION OF POWER POLES, LIGHT POLES AND APPURTENANCES WITH KGE. TWO WEEKS NOTICE TO KGE IS REQUIRED.
- ALL ADJACENT BUILDINGS, STRUCTURES, PARKING LOTS, DRIVES, STREET PAVEMENTS, UTILITY LINES, UTILITY STRUCTURES AND APPURTENANCES OTHER THAN SHOWN FOR REPLACEMENT SHALL BE PROTECTED FROM DAMAGE DURING CONSTRUCTION OF THE PROJECT. ITEMS DAMAGED BEYOND THE LIMITS SHOWN SHOWN ON THE DRAWINGS SHALL BE REMOVED AND REPLACED BY THE CONTRACTOR AT NO ADDITIONAL COST TO THE OWNER.
- CONTRACTOR SHALL VERIFY GROUND WATER CONDITIONS BEFORE SUBMITTING HIS BID. DEWATERING AS REQUIRED TO ACCOMPLISH CONSTRUCTION WILL BE AT CONTRACTOR'S EXPENSE.
- A SAW CUT OF AT LEAST ONE-HALF THE DEPTH OF EXISTING SURFACE COURSES OR ONE-FOURTH THE DEPTH OF THE EXISTING TOTAL PAVEMENT THICKNESS SHALL BE PROVIDED AT LOCATIONS WHERE PROPOSED CONSTRUCTION ABUTS AN EXISTING SURFACE COURSE OR PAVEMENT FOR WHICH PARTIAL REMOVAL OF THAT SURFACE OR PAVEMENT IS REQUIRED. SAWED JOINTS TO FACILITATE REMOVAL WITHIN THREE (3) FEET OF EXISTING JOINT WILL NOT BE PERMITTED AND FOR SUCH INSTANCES THE LIMITS OF REMOVAL SHALL EXTEND TO EXISTING JOINT. SUCH SAW CUTS WILL NOT BE PAID FOR DIRECTLY AND THIS COST SHALL BE CONSIDERED SUBSIDIARY TO THE REMOVAL OF THE SURFACE OR PAVEMENT.
- MISCELLANEOUS STRUCTURES AND EXCAVATION WHICH IS TO BE WASTED SHALL BE DISPOSED OF ON SITES TO BE PROVIDED BY THE CONTRACTOR. THESE SITES SHALL BE APPROVED BY THE ENGINEER AS TO SUITABILITY, APPEARANCE AND SITE LOCATION. LOCATIONS THAT, IN THE OPINION OF THE ENGINEER LEAVE AN UNSIGHTLY APPEARANCE WILL NOT BE APPROVED.

ALL DISPOSAL SITES MUST BE APPROVED BY THE KANSAS DEPARTMENT OF HEALTH AND ENVIRONMENT. MATERIAL EITHER STOCKPILED OR DISPOSED OF IN A FLOOD PLAIN WOULD REQUIRE A KANSAS STATE BOARD OF AGRICULTURE PERMIT. ANY MATERIAL DUMPED IN WATERS OF THE UNITED STATES OR WETLANDS IS SUBJECT TO U.S. CORPS OF ENGINEERS PERMITTING REGULATIONS. ANY MATERIAL BURIED OR STOCKPILED BEYOND APPROVED CONSTRUCTION LIMITS WOULD REQUIRE ADDITIONAL ARCHAEOLOGICAL INVESTIGATIONS UNLESS BURIED IN A PREVIOUSLY APPROVED BORROW LOCATION.

9. TREES AND SHRUBS IN PUBLIC RIGHT-OF-WAY WHICH ARE IN STRICT CONFLICT WITH PROPOSED NEW CONSTRUCTION SHALL BE REMOVED BY THE CONTRACTOR WITH ENGINEER'S APPROVAL. TREES AND SHRUBS WHICH ARE NOT IN DIRECT CONFLICT WITH PROPOSED NEW CONSTRUCTION SHALL BE SAVED AND PROTECTED FROM DAMAGE.

10. THE CONTRACTOR SHALL BE RESPONSIBLE FOR PRESERVING PROPERTY IRONS SHOWN ON THE PLANS. THE CONTRACTOR WILL BE REQUIRED TO RE-ESTABLISH ANY SHOWN PROPERTY IRONS WHICH ARE DAMAGED OR DESTROYED BY HIS CONSTRUCTION OPERATIONS. SUCH IRONS SHALL BE RE-ESTABLISHED BY A LICENSED LAND SURVEYOR IN ACCORDANCE WITH STATE LAW. THIS WORK SHALL BE SUBSIDIARY TO OTHER ITEMS IN CONTRACT.

11. ALL SALVAGEABLE DRAINAGE PIPES, HATCH RINGS AND COVERS AND INLET GRATES SHALL BE CAREFULLY REMOVED AND STOCKPILED AT LOCATIONS WITHIN THE RIGHT-OF-WAY, AS DIRECTED BY THE ENGINEER FOR REMOVAL BY CITY PERSONNEL.

12. THE CONTRACTOR WILL BE REQUIRED TO PROVIDE A MINIMUM ADVANCE NOTICE OF FORTY-EIGHT (48) HOURS TO EACH OF THE FOLLOWING UTILITIES PRIOR TO THE BEGINNING OF CONSTRUCTION AND REQUEST THAT ANY EXISTING LINES BE FLAGGED:

ARKLA GAS CO.
1630 S. BACHR
WICHITA, KANSAS 67209
JERRY VATTINS
316-942-8350

KANSAS GAS & ELECTRIC CO.
808 208
WICHITA, KANSAS 67201
DON MORGAN
316-261-6285

WICHITA WATER DEPARTMENT
8TH FLOOR - CITY HALL
455 N. MAIN STREET
WICHITA, KANSAS 67202
CHUCK STEVENS
316-268-4552

KANSAS ONE CALL
1-800-344-4210


SOUTHWESTERN BELL TELEPHONE CO.
154 N. BROADWAY
WICHITA, KANSAS 67202
GREG SHARP
316-268-2245

WICHITA SEWER MAINTENANCE DIVISION
WATER & WASTE POLLUTION CONTROL DEPT.
8TH FLOOR-CITY HALL
455 N. MAIN STREET
WICHITA, KANSAS 67202
SUSAN TURNER
316-268-4210

MULTIMEDIA CABLEVISION
701 EAST DOUGLAS
WICHITA, KANSAS 67202
DON SHUE
262-4270

DIG SAFE
687-2470

13. CONTRACTOR SHALL MAINTAIN TRAFFIC ON PANNEE AT ALL TIMES DURING CONSTRUCTION IN ACCORDANCE WITH CITY OF WICHITA REQUIREMENTS.

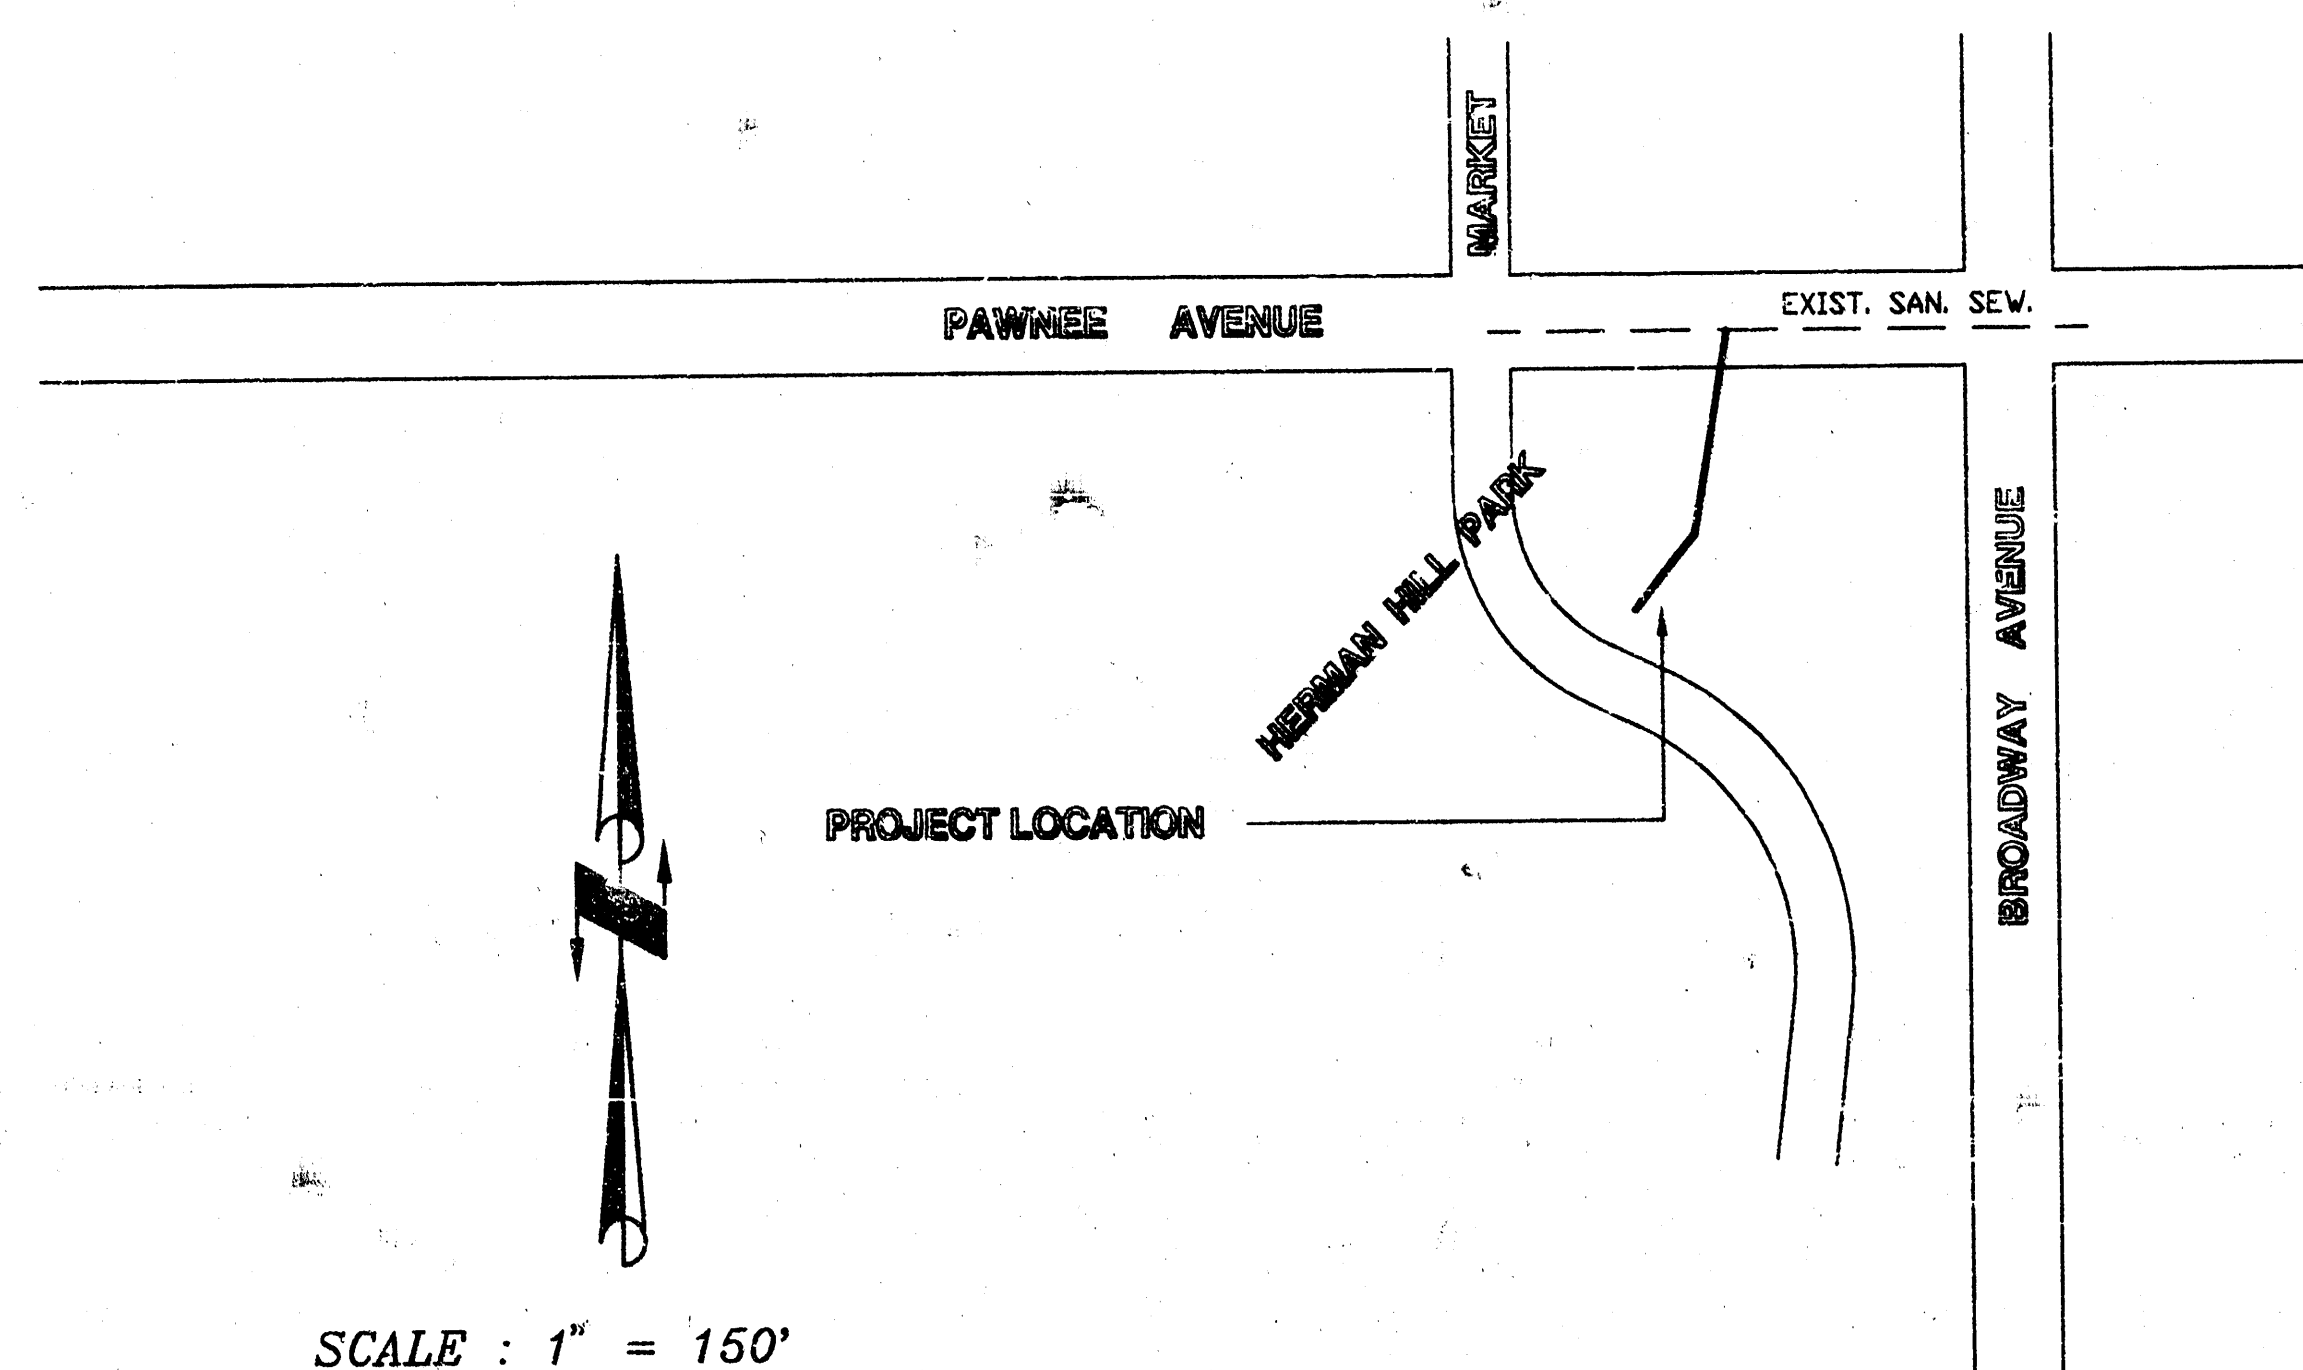

PRIVATE PROJECT NO.: PPS 459

LOCATION MAP

MICHAEL E. LINDEBAK, P.E., CITY ENGINEER

ALL WORK SHALL BE COMPLETED IN ACCORDANCE WITH CITY OF WICHITA, KANSAS STANDARD SPECIFICATIONS.

APPROVED AS NOTED
By CITY ENGINEER OF WICHITA
Sanitary Sewers AKB 4/25/94
Storm Sewers _____
Driveway Approaches _____
Water Mains _____

NOTE TO CONTRACTOR


INSPECTION AND TESTING FOR THIS PROJECT IS TO BE PROVIDED BY A LICENSED CONSULTING ENGINEERING FIRM UNDER CONTRACT TO THE OWNER/DEVELOPER. SAID INSPECTION TO BE IN ACCORDANCE WITH THE CITY OF WICHITA STANDARD SPECIFICATIONS. INSPECTION AND TESTING TO BE CERTIFIED BY A LICENSED PROFESSIONAL ENGINEER. NO WORK SHALL BE CONSIDERED COMPLETE UNTIL THE PUBLIC RIGHT-OF-WAY HAS BEEN RESTORED TO ITS ORIGINAL CONDITION. ALL ANY VEHICLES OR EQUIPMENT IN DESIGNATED EASEMENTS SHALL BE REMOVED FROM THE PUBLIC RIGHT-OF-WAY WITHOUT WRITTEN AUTHORIZATION BY THE CITY ENGINEER.

Booked 1-12-95
AKB
From As Boilts

BENCH MARKS:


PROJECT CONTROL:
TOP OF MANHOLE @ STA. 0+00, ELEV. = 97.17

AS-BUILT 8-29-94

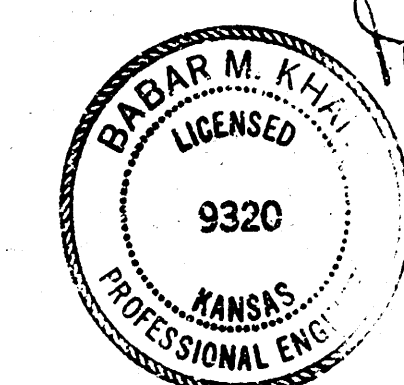


TITLE SHEET		
SCALE:	APPROVED:	DRAWN BY: F.A.
DATE:		CHECKED: B.K.
PROJECT NO.:		SHEET NO. 1 OF 2
MUNICIPAL ENGINEERS 254-LAURA, SUITE 201 WICHITA, KANSAS 67211 316-262-3842		

SCALE:
 PLAN : 1" = 20'
 PROFILE : 1" = 20' (H)
 1" = 5' (V)

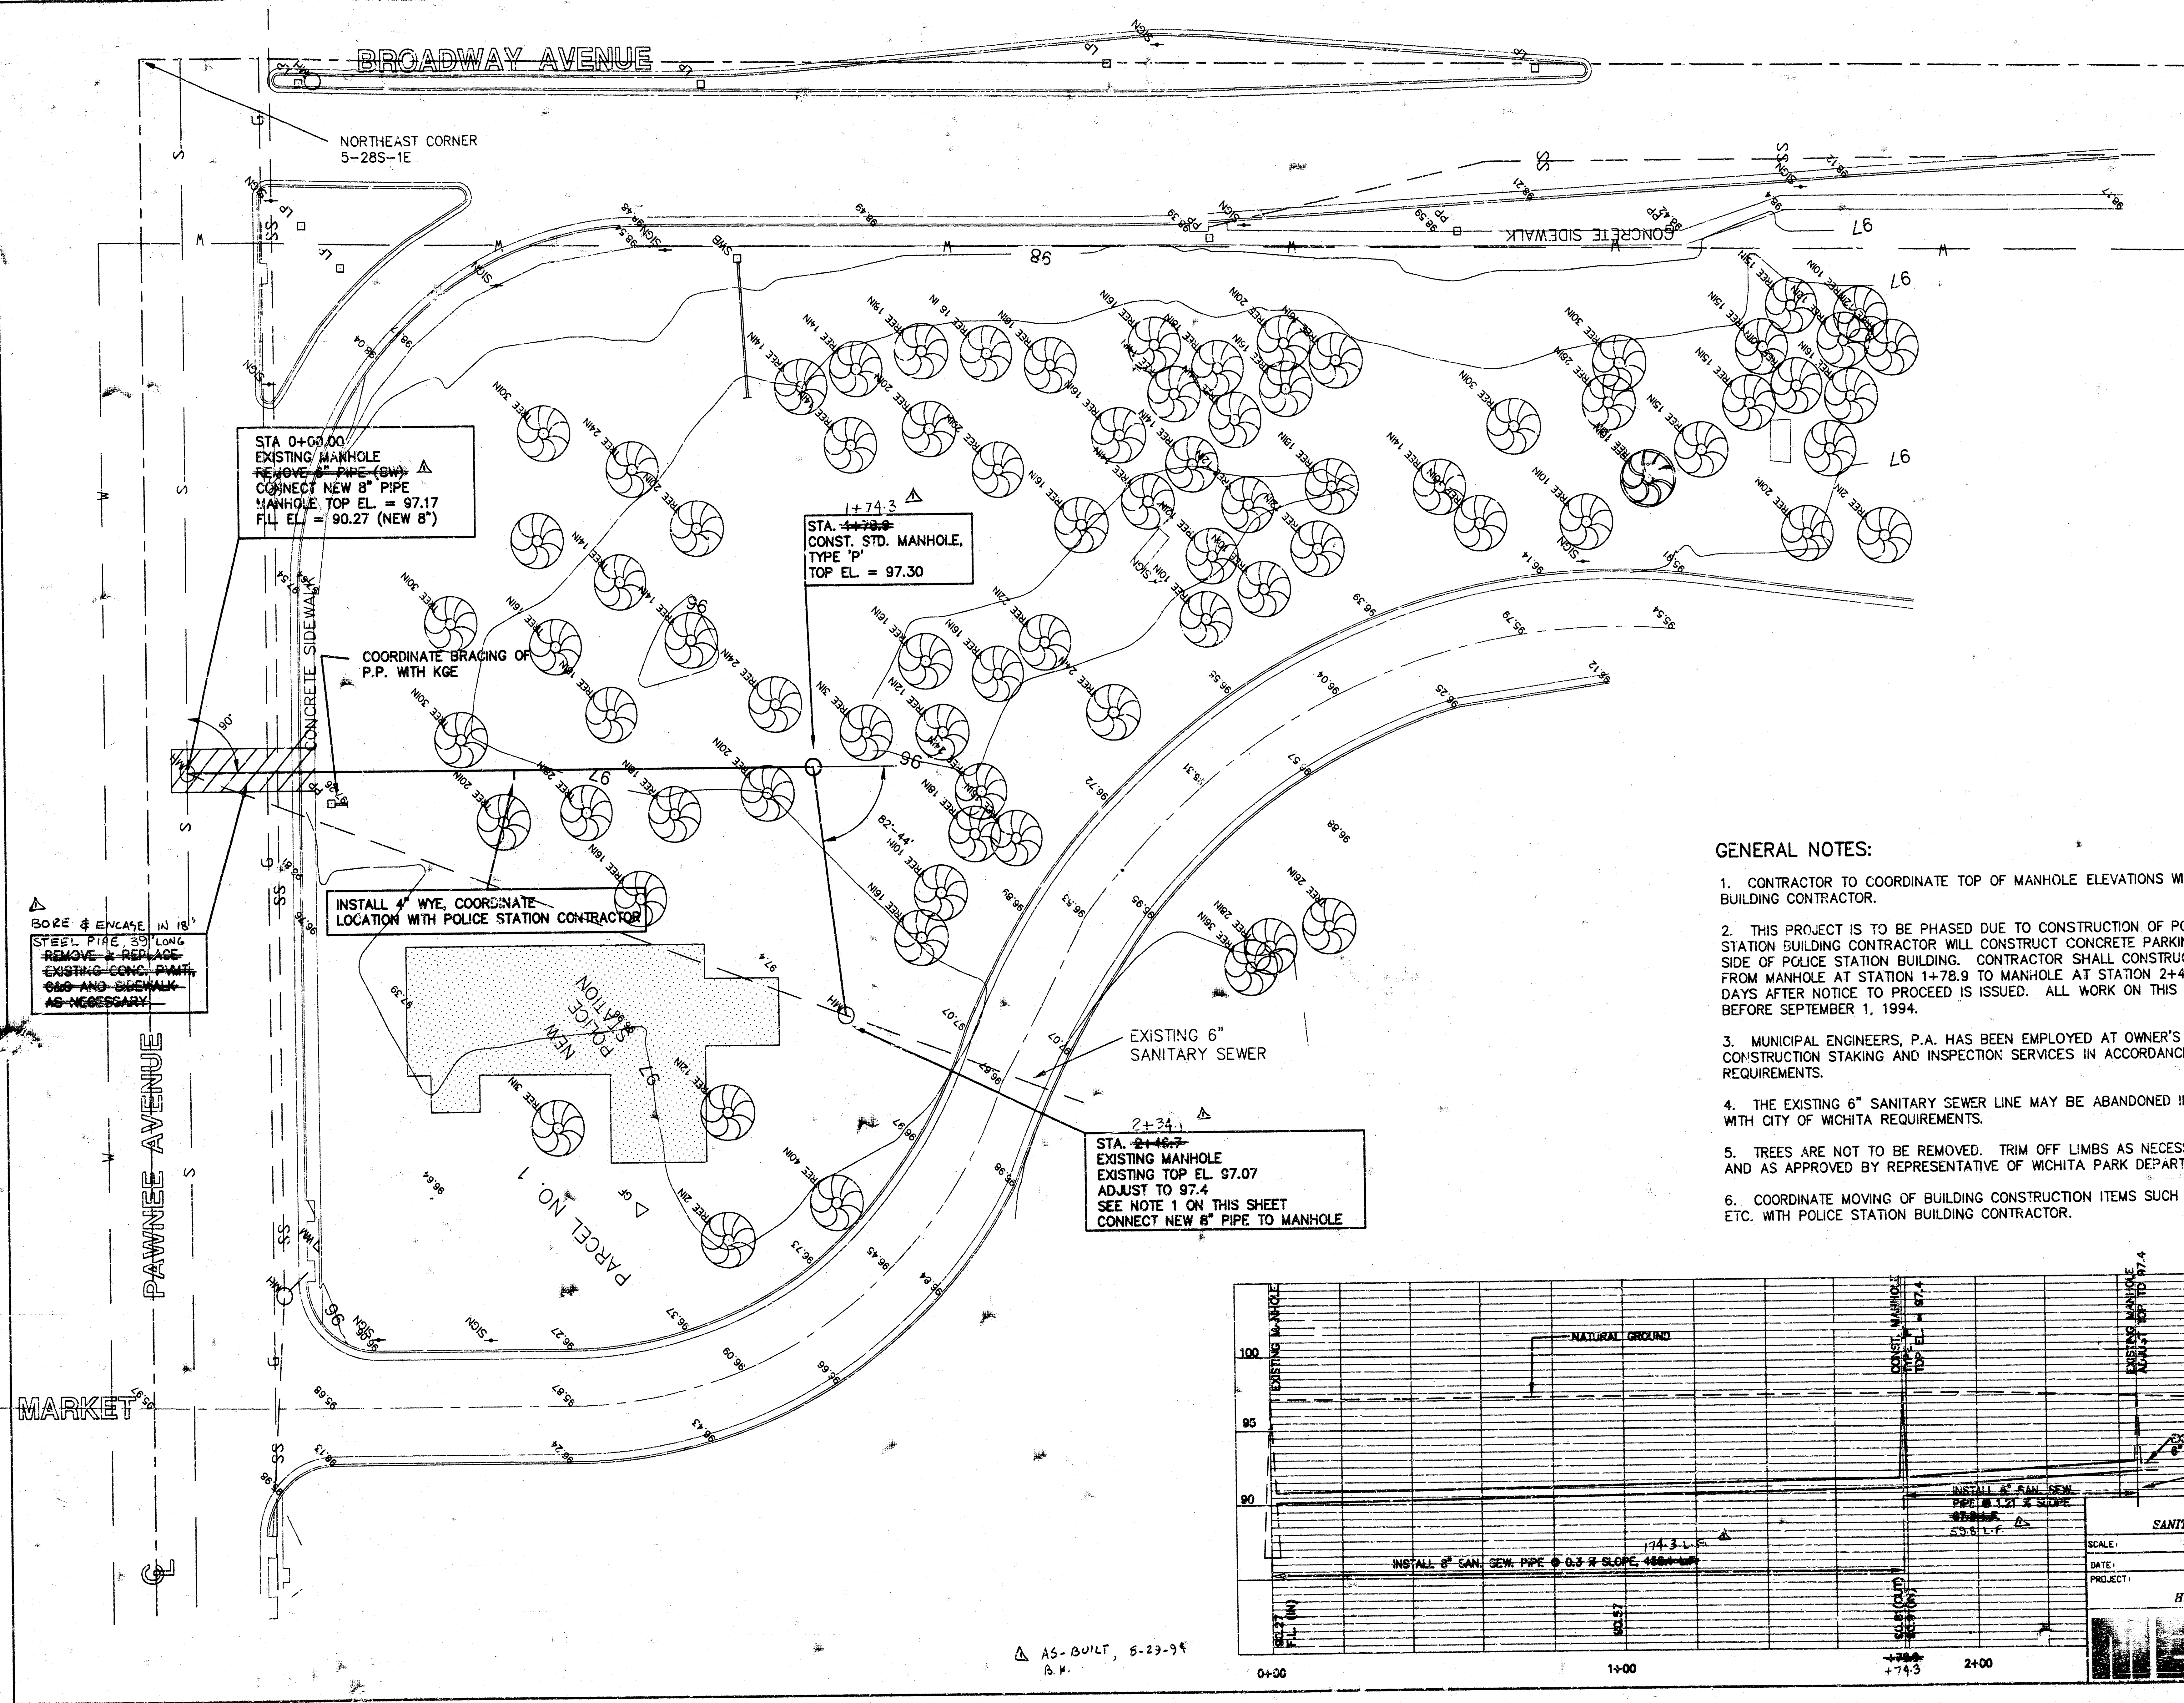

GENERAL NOTES:

1. CONTRACTOR TO COORDINATE TOP OF MANHOLE ELEVATIONS WITH POLICE STATION BUILDING CONTRACTOR.
2. THIS PROJECT IS TO BE PHASED DUE TO CONSTRUCTION OF POLICE STATION. POLICE STATION BUILDING CONTRACTOR WILL CONSTRUCT CONCRETE PARKING ALONG THE SOUTH SIDE OF POLICE STATION BUILDING. CONTRACTOR SHALL CONSTRUCT SANITARY SEWER FROM MANHOLE AT STATION 1+78.9 TO MANHOLE AT STATION 2+46.7 WITHIN 15 CALENDAR DAYS AFTER NOTICE TO PROCEED IS ISSUED. ALL WORK ON THIS PROJECT IS TO BE COMPLETED BEFORE SEPTEMBER 1, 1994.
3. MUNICIPAL ENGINEERS, P.A. HAS BEEN EMPLOYED AT OWNER'S EXPENSE TO PROVIDE CONSTRUCTION STAKING AND INSPECTION SERVICES IN ACCORDANCE WITH CITY OF WICHITA REQUIREMENTS.
4. THE EXISTING 6" SANITARY SEWER LINE MAY BE ABANDONED IN PLACE IN ACCORDANCE WITH CITY OF WICHITA REQUIREMENTS.
5. TREES ARE NOT TO BE REMOVED. TRIM OFF LIMBS AS NECESSARY FOR CONSTRUCTION AND AS APPROVED BY REPRESENTATIVE OF WICHITA PARK DEPARTMENT.
6. COORDINATE MOVING OF BUILDING CONSTRUCTION ITEMS SUCH AS DIRT PILES, TRAILERS, ETC. WITH POLICE STATION BUILDING CONTRACTOR.

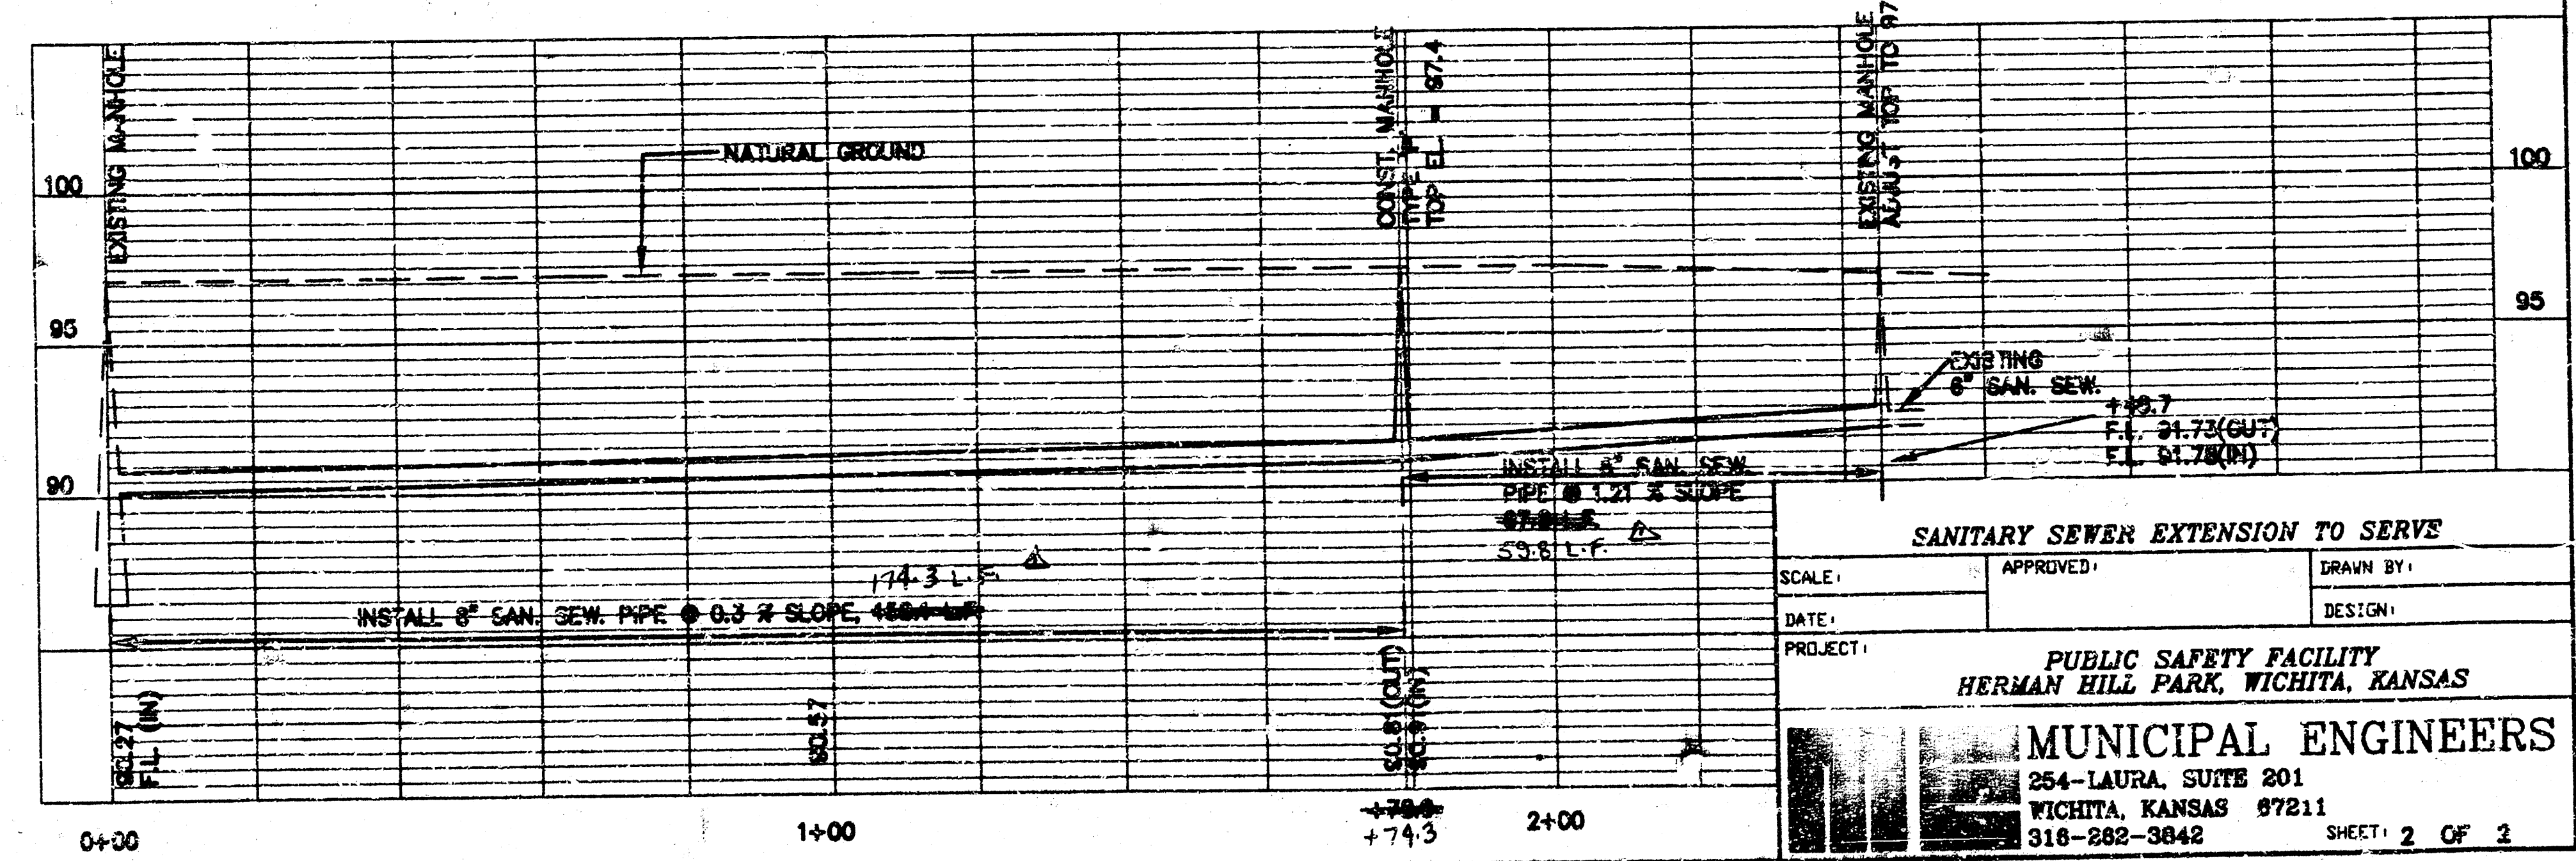

AS-BUILT, 5-29-94
 P.M.

SCALE:		APPROVED:		DRAWN BY:	
DATE:				DESIGN:	
PROJECT:		PUBLIC SAFETY FACILITY HERMAN HILL PARK, WICHITA, KANSAS			
		MUNICIPAL ENGINEERS			
		254-LAURA, SUITE 201 WICHITA, KANSAS 67211 316-282-3842			
		SHEET 2 OF 2			