


BENCH MARK: Top of Iron at S.E. corner of Lot 1, Block A, Hillside Heights; Elev. 99.78 City Datum

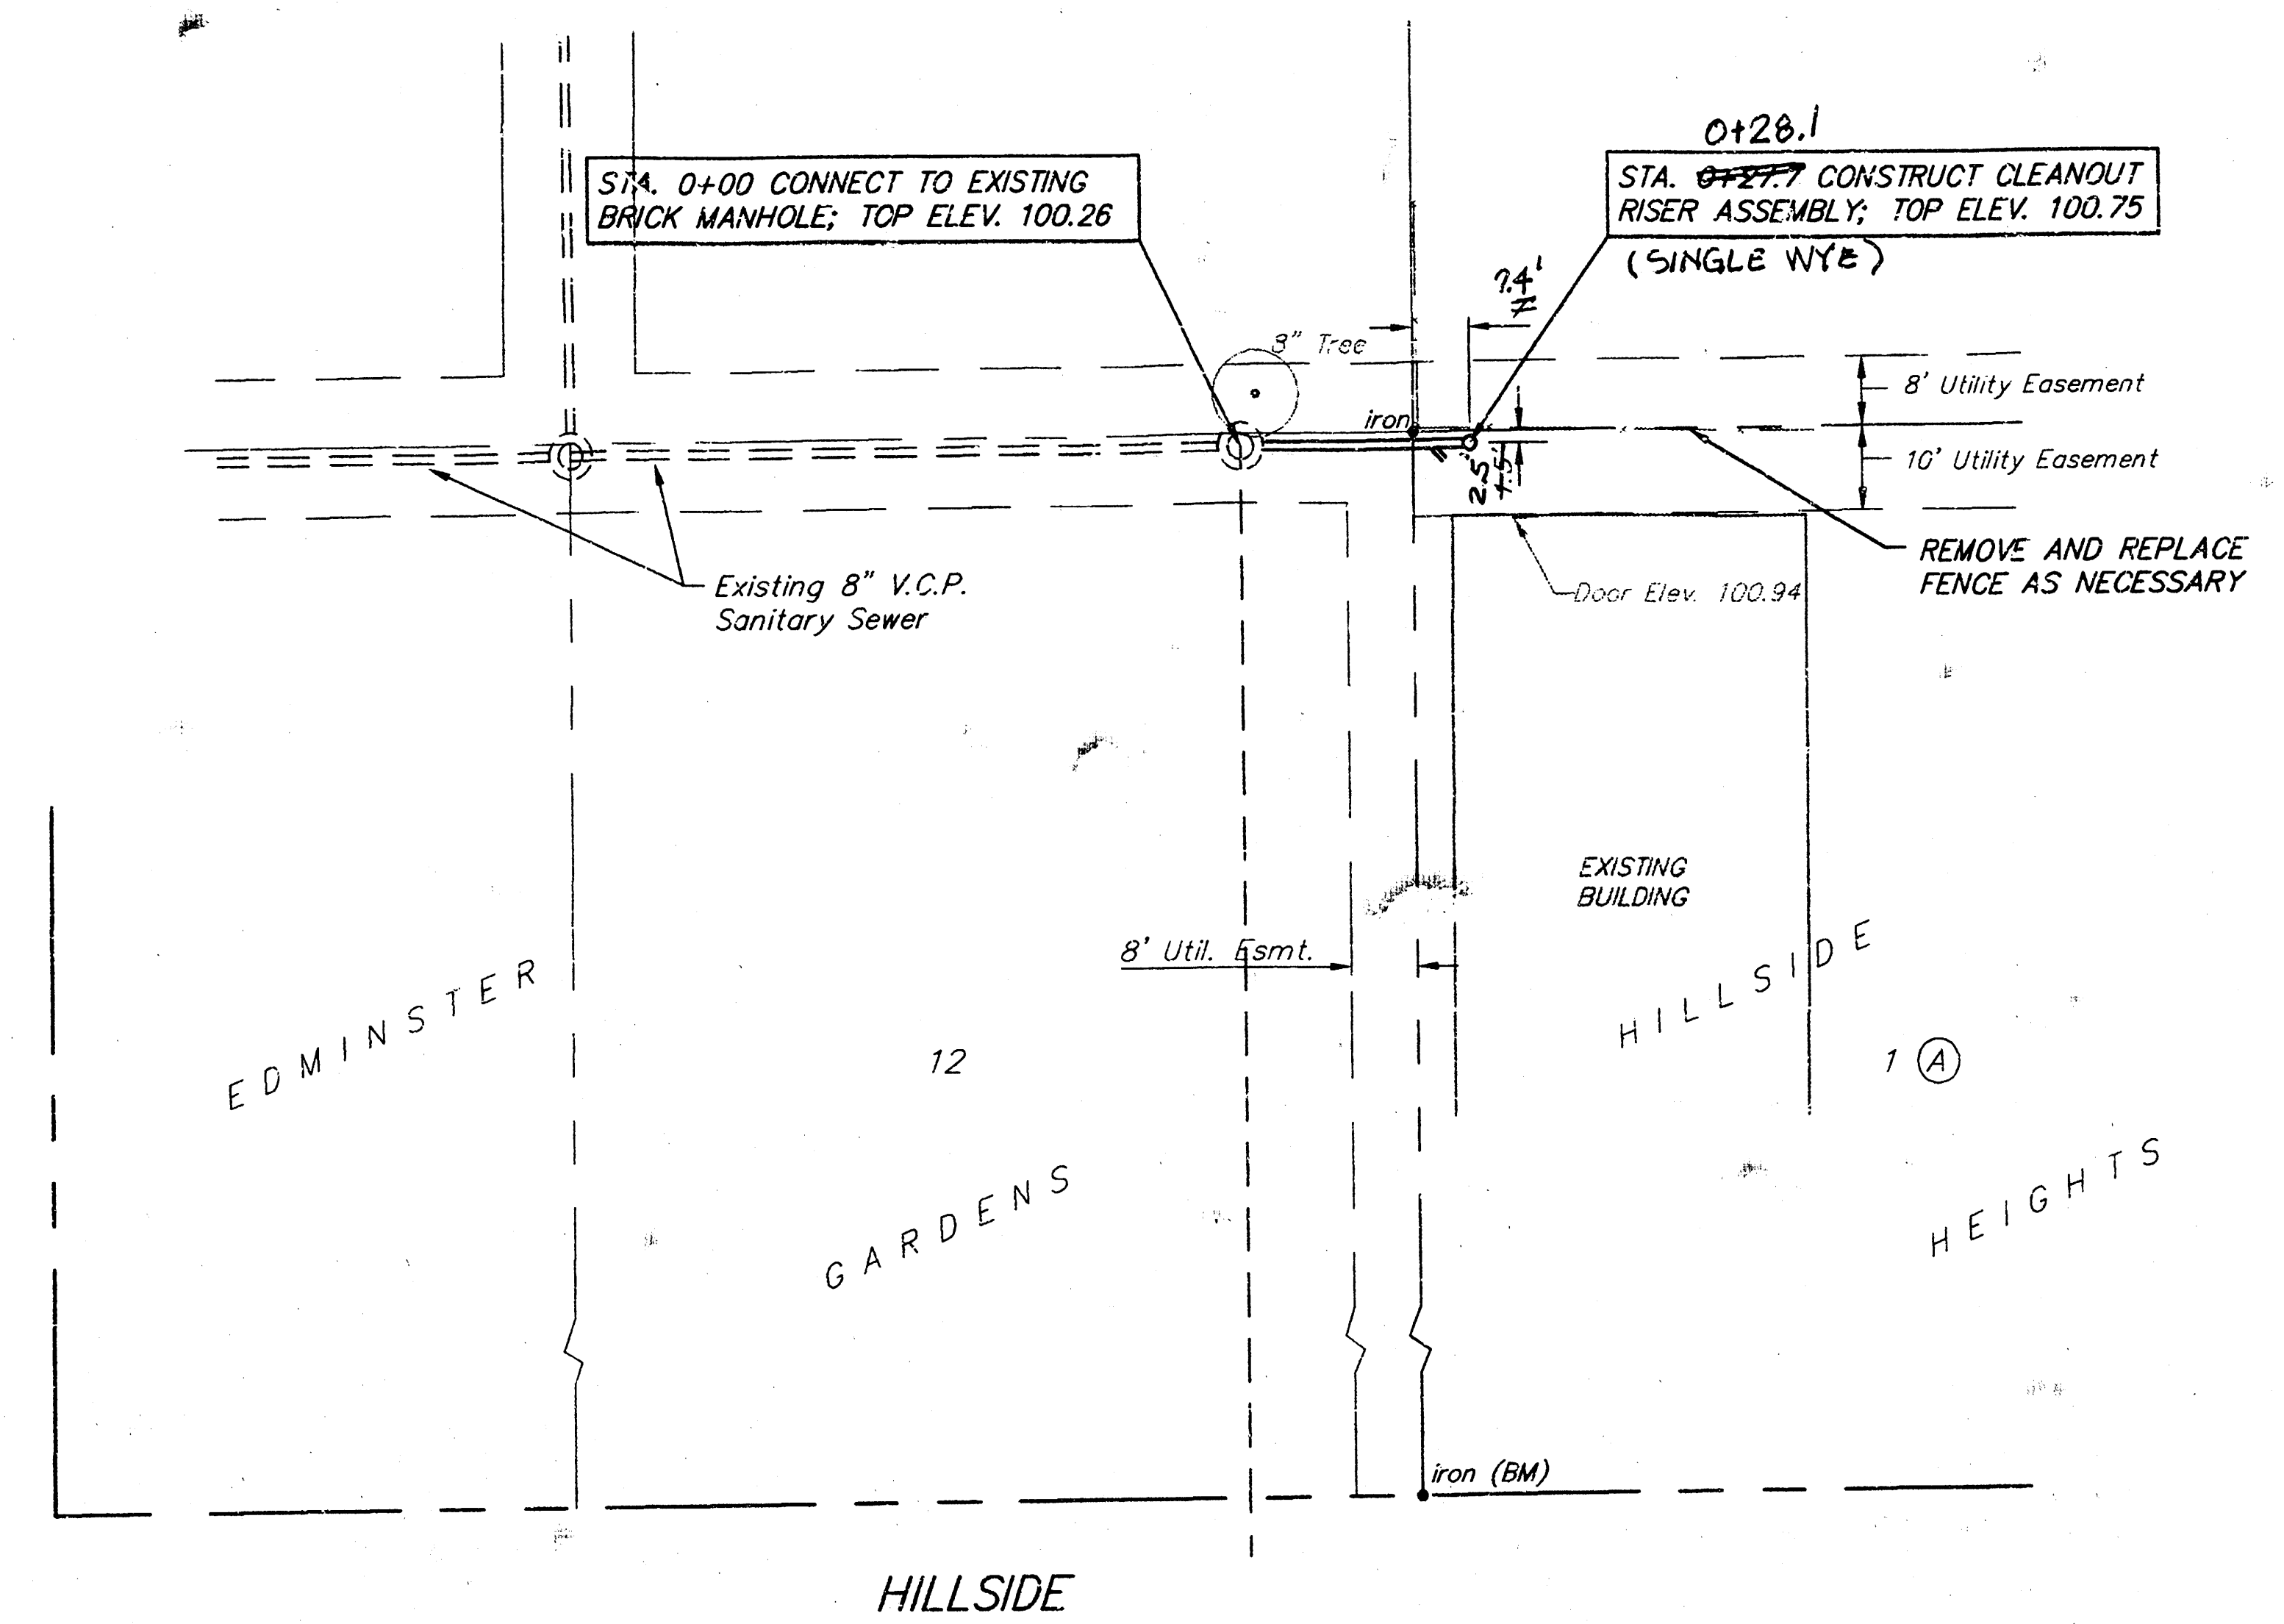

1" = 20"

APPROVED AS NOTED
BY CITY ENGINEER OF WICHITA

Sanitary Sewers 1/14/94 URH

Storm Sewers _____

Driveway Approaches _____

Water Mains _____

Paving _____

NOTE TO CONTRACTOR

Inspection and testing for this project are to be provided by a Licensed Consulting Engineering Firm under contract with the Owner/Developer. Said Inspection to be in accordance with the City of Wichita standard construction engineering practices and certified by a Licensed Professional Engineer. No work shall be performed in dedicated easements or public right-of-way by the Contractor without such inspection, nor shall any work be commenced without written authorization by the City Engineer.

