


PLANS
FOR
SANITARY SEWER EXTENSIONS
KAPPELMAN'S BEL AIRE HEIGHTS

PHASE III

PROJECT NO. 468-76-245-80001-000-000-196

1988

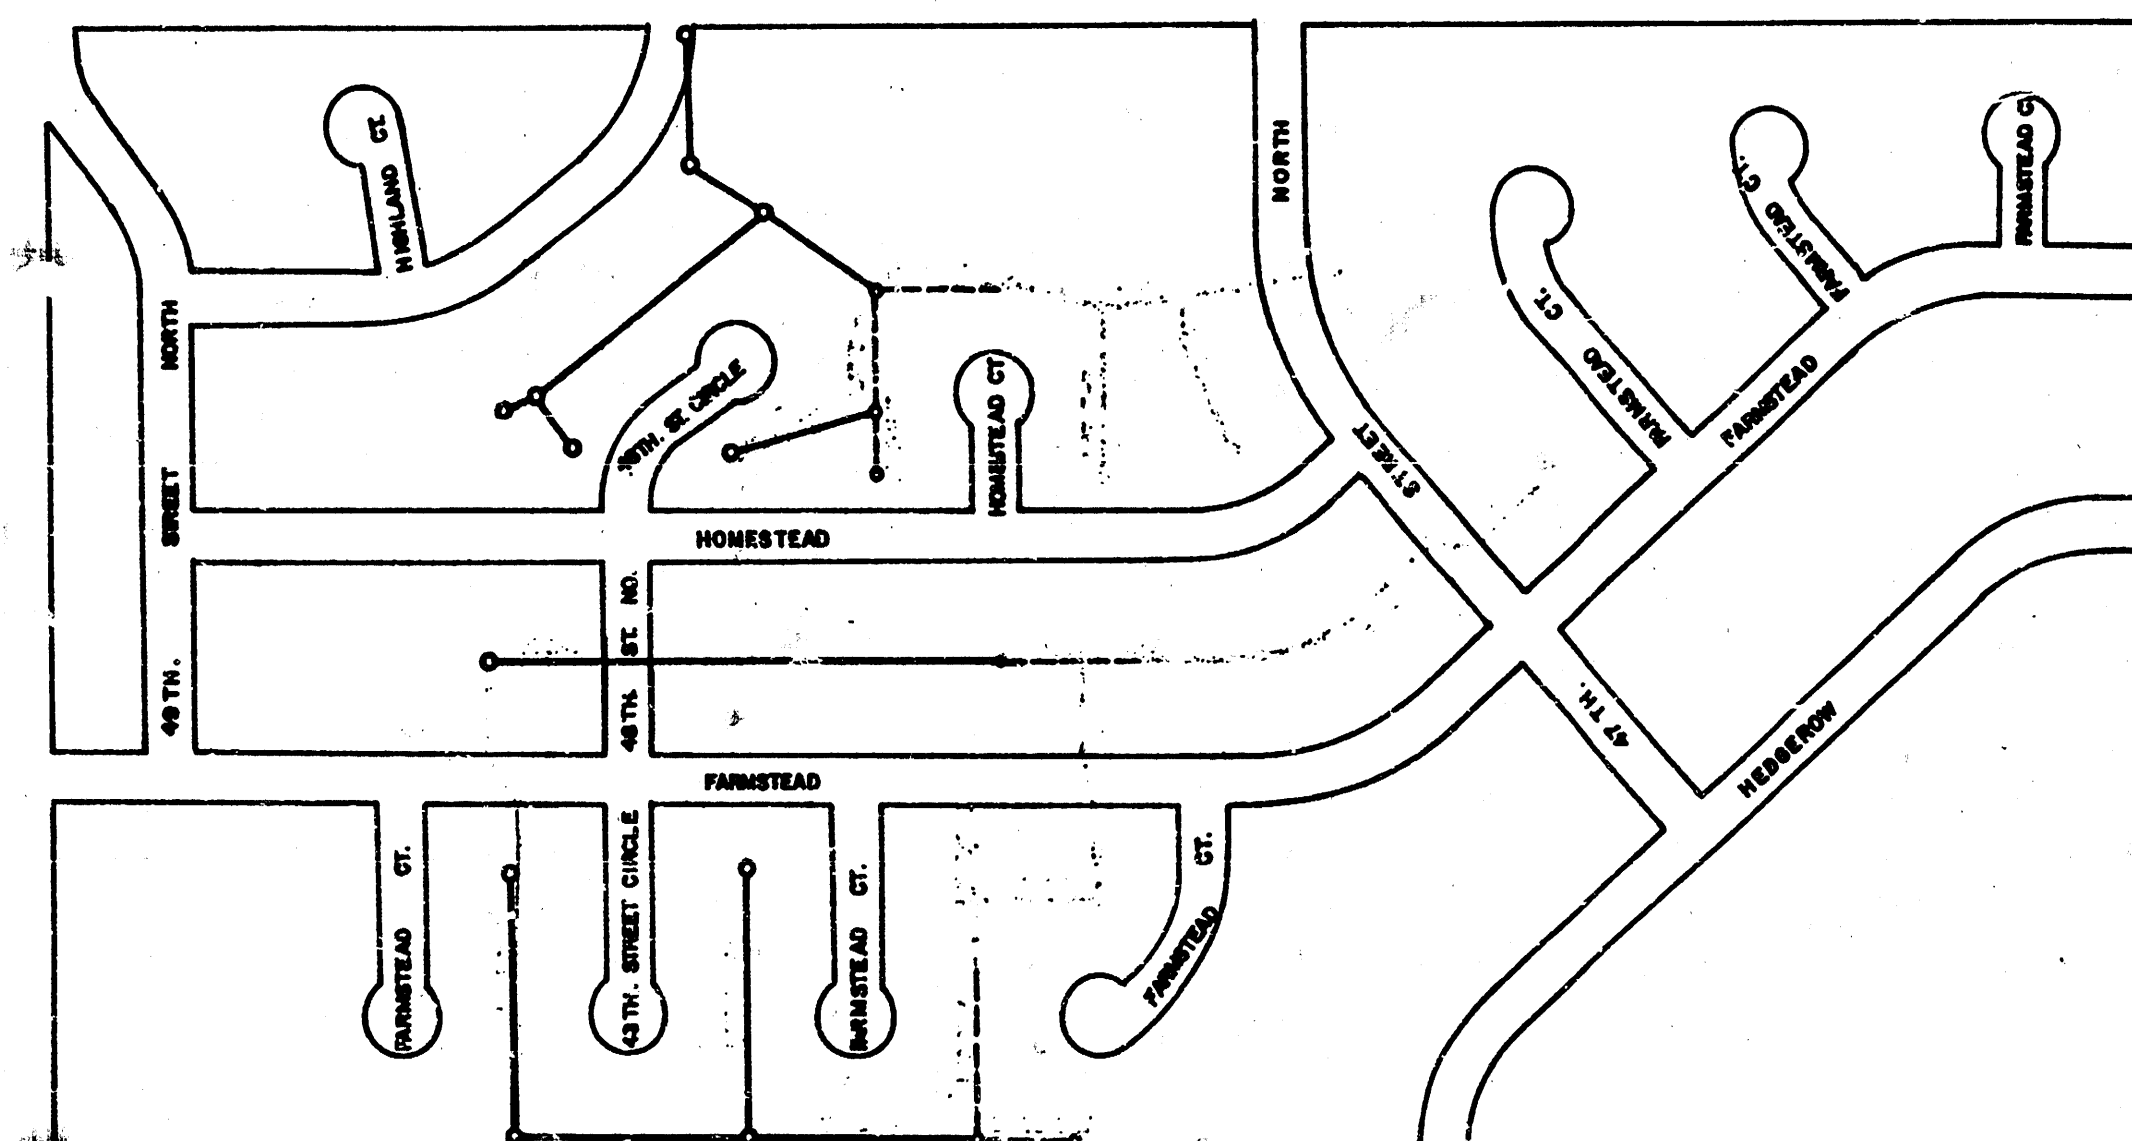

AS CONSTRUCTED

*All Pipe is PVC, SDR 35, All Manholes
are Type P Standard, Except where noted
on the Profiles.*

APPROVED AS NOTED
By CITY ENGINEER OF WICHITA

Sanitary Sewers _____
Storm Sewers _____
Driveway Approaches _____
Water Mains _____
Paving _____

NOTE TO CONTRACTOR


This project will be constructed under the supervision of the CITY ENGINEER and conforming to the SPECIFICATIONS of the CITY OF WICHITA. The CONTRACTOR will pay the City of Wichita for all costs of plan review, inspection and booking per contract.



REISS & GOODNESS ENGINEERS
2100 WEST 21ST STREET
WICHITA, KANSAS 67205
(316) 432-0205

10-5-88 SE 1188 SHEET 1 OF 10




**FILED FROM THE BEST
AVAILABLE COPY**

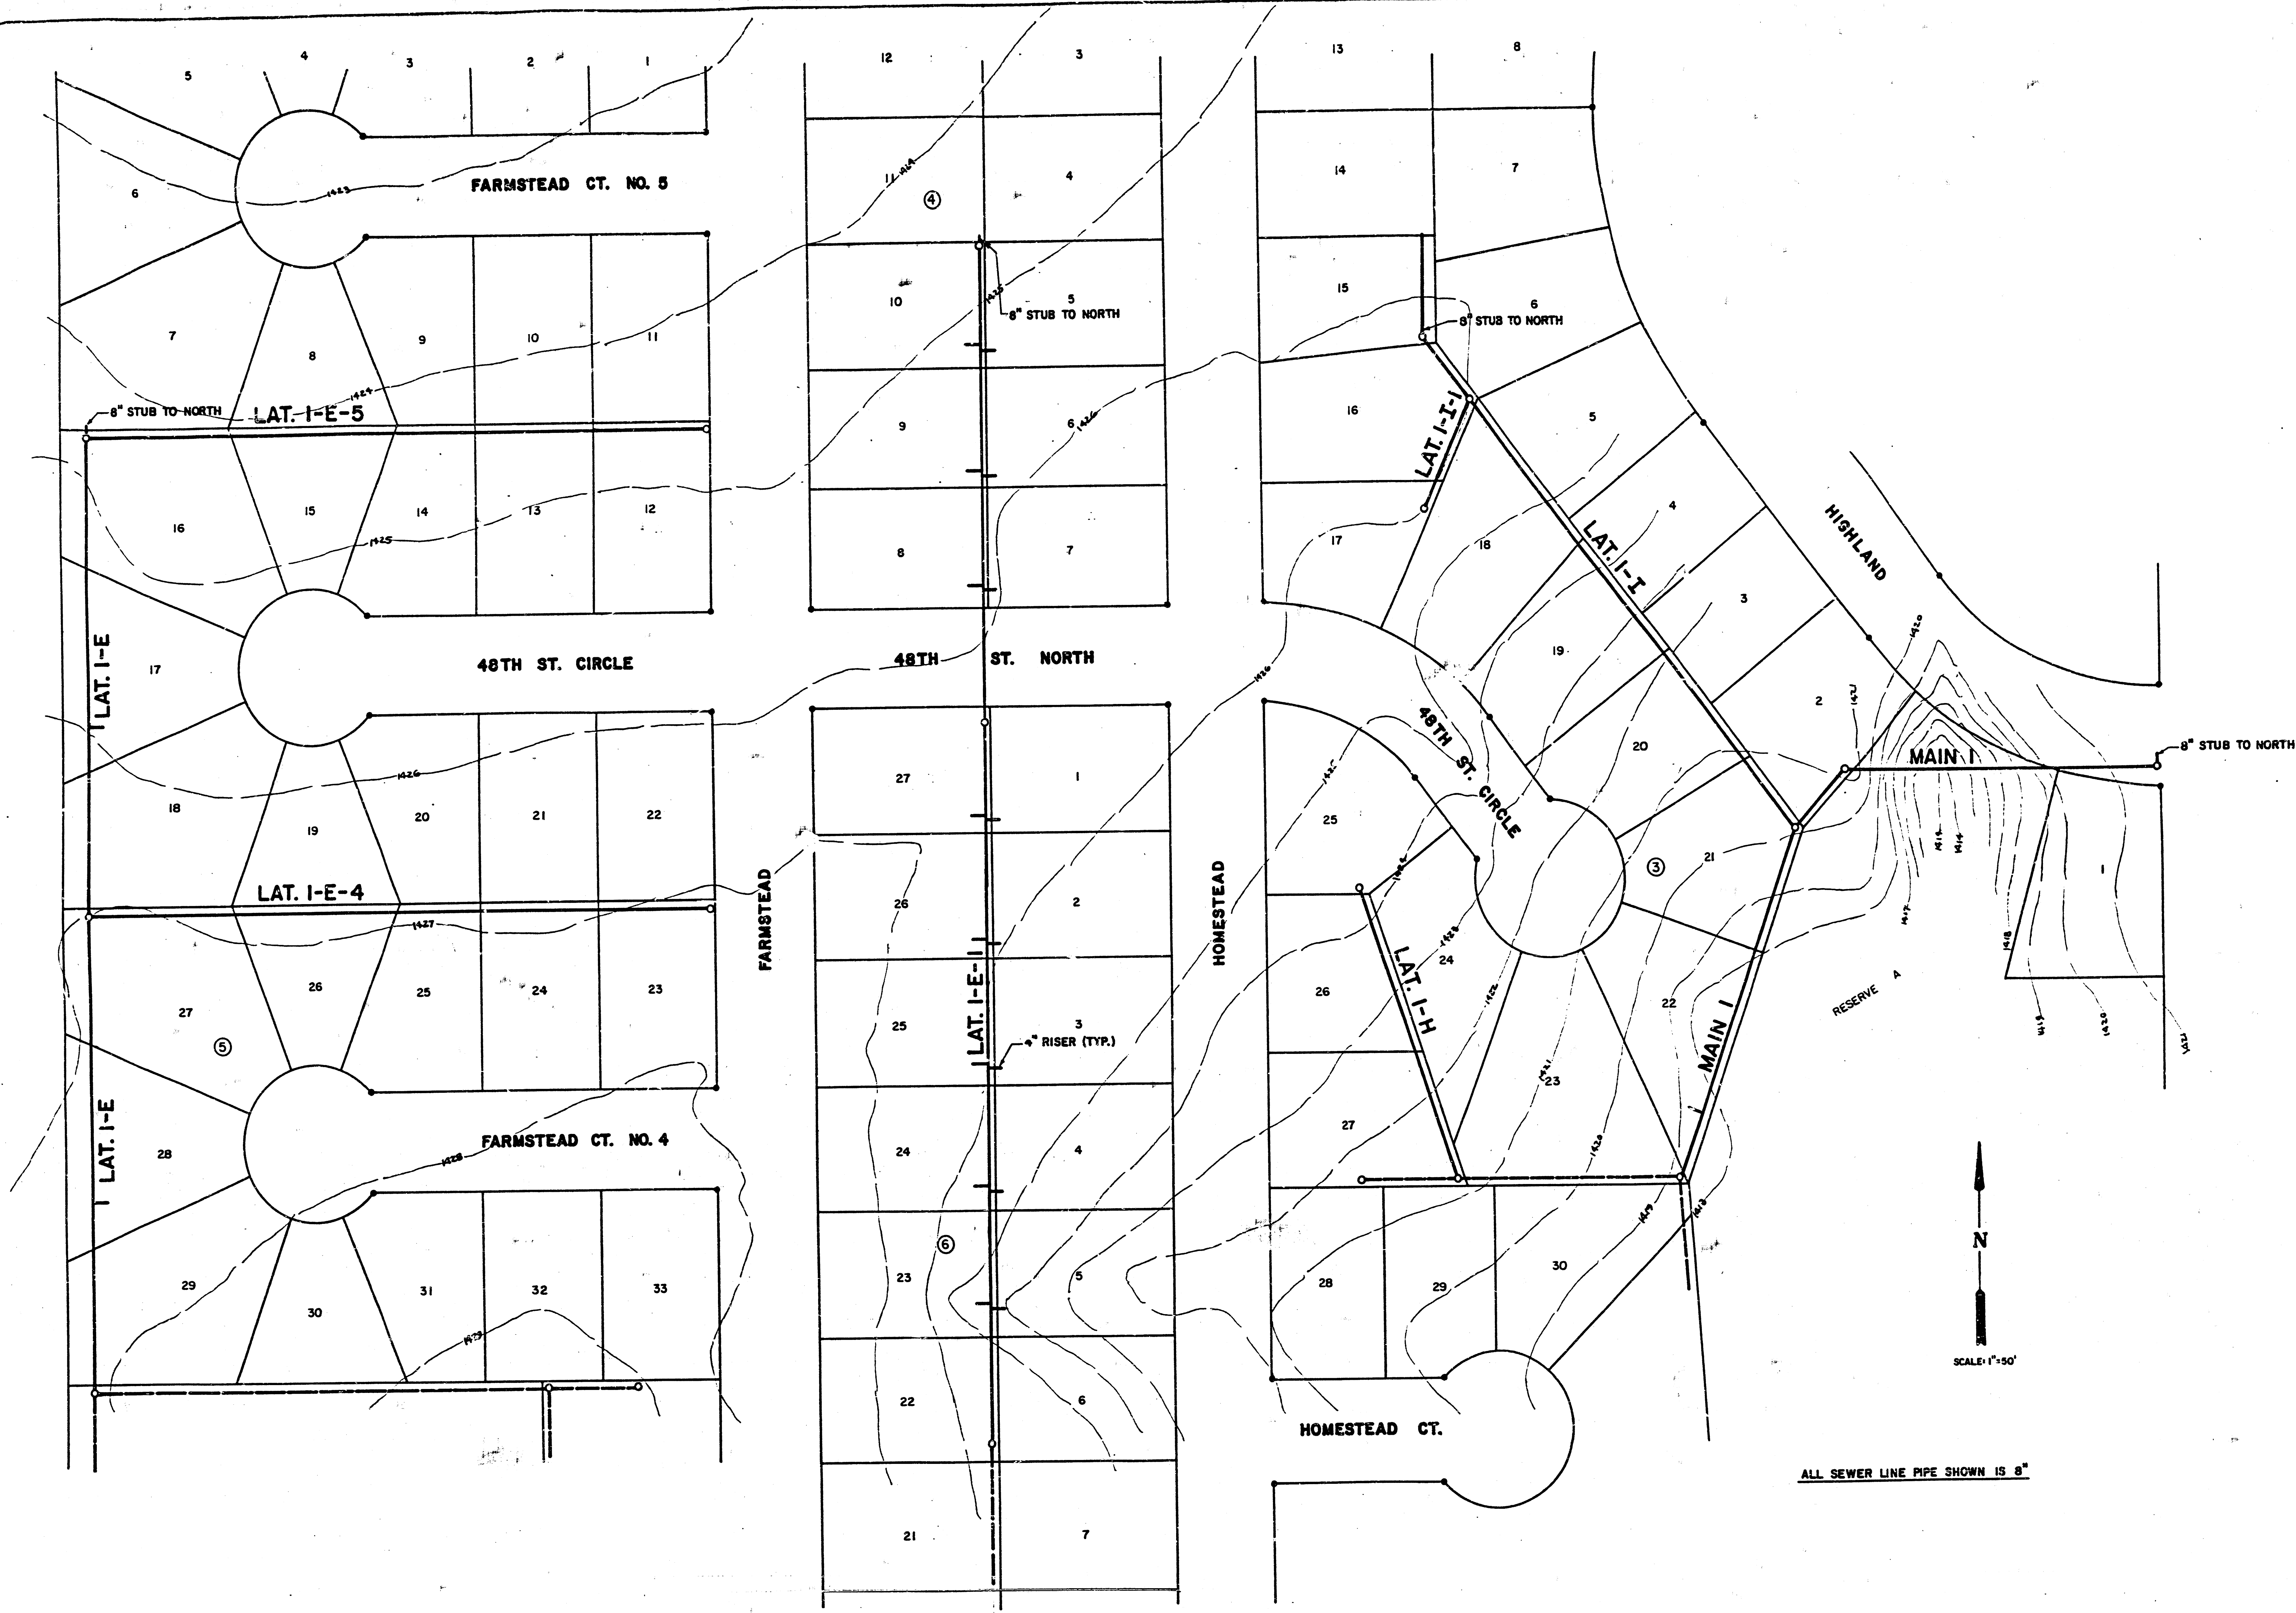

DEISS & GOODNESS ENGINEERS
 2180 WEST 21ST STREET
 WICHITA, KANSAS 67203
 (913) 632-0223

REVISION	DRAWN BY DEJ	CHECKED BY	DESIGNED BY CS	PROJECT SANITARY SEWER EXTENSIONS-PHASE III	CITY/OWNER KAPPELMAN'S BEL AIRE HEIGHTS	SCALE 1" = 50'	PROJECT NO. 3	SHEET NO. 3 OF 10
----------	-----------------	------------	-------------------	---	---	-------------------	------------------	----------------------


FILMED FROM THE BEST
 AVAILABLE COPY

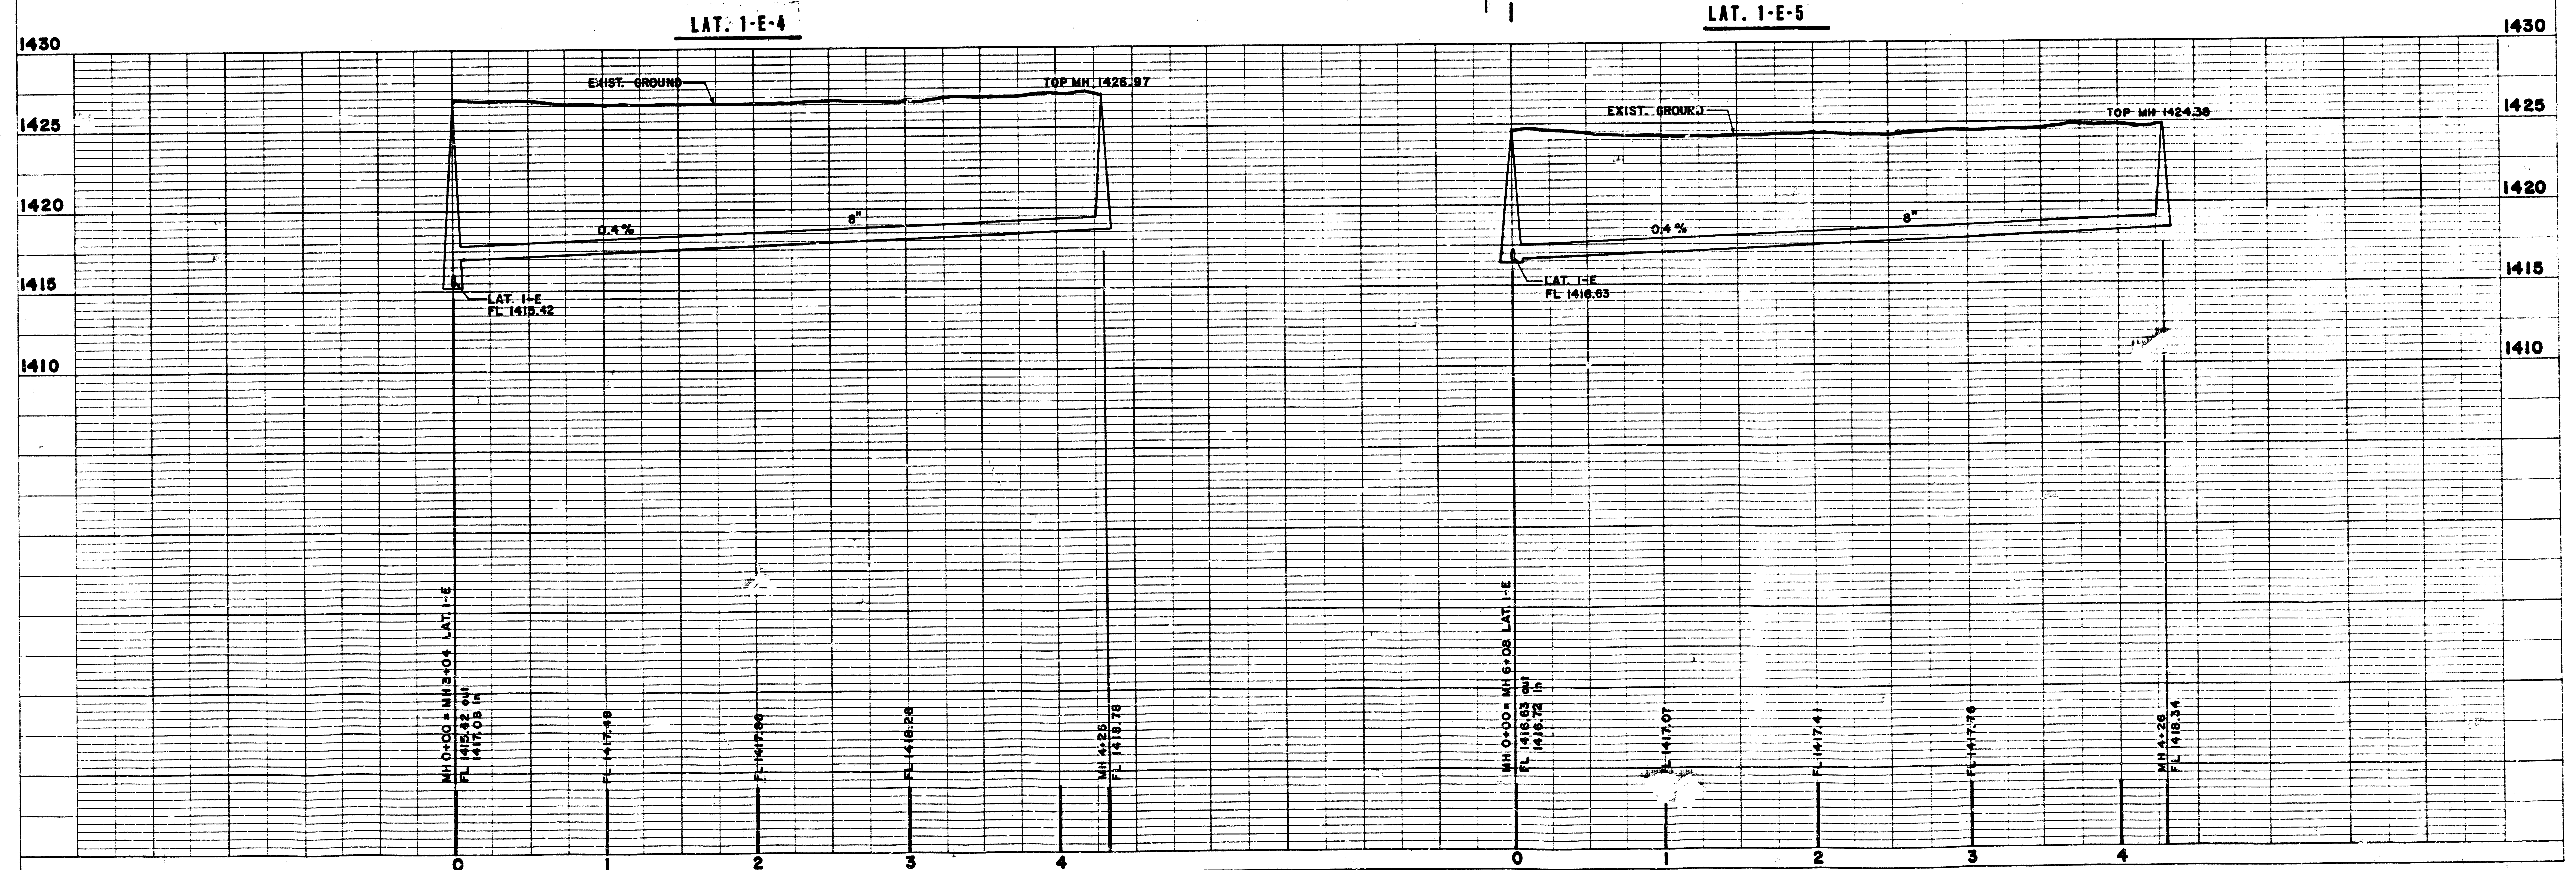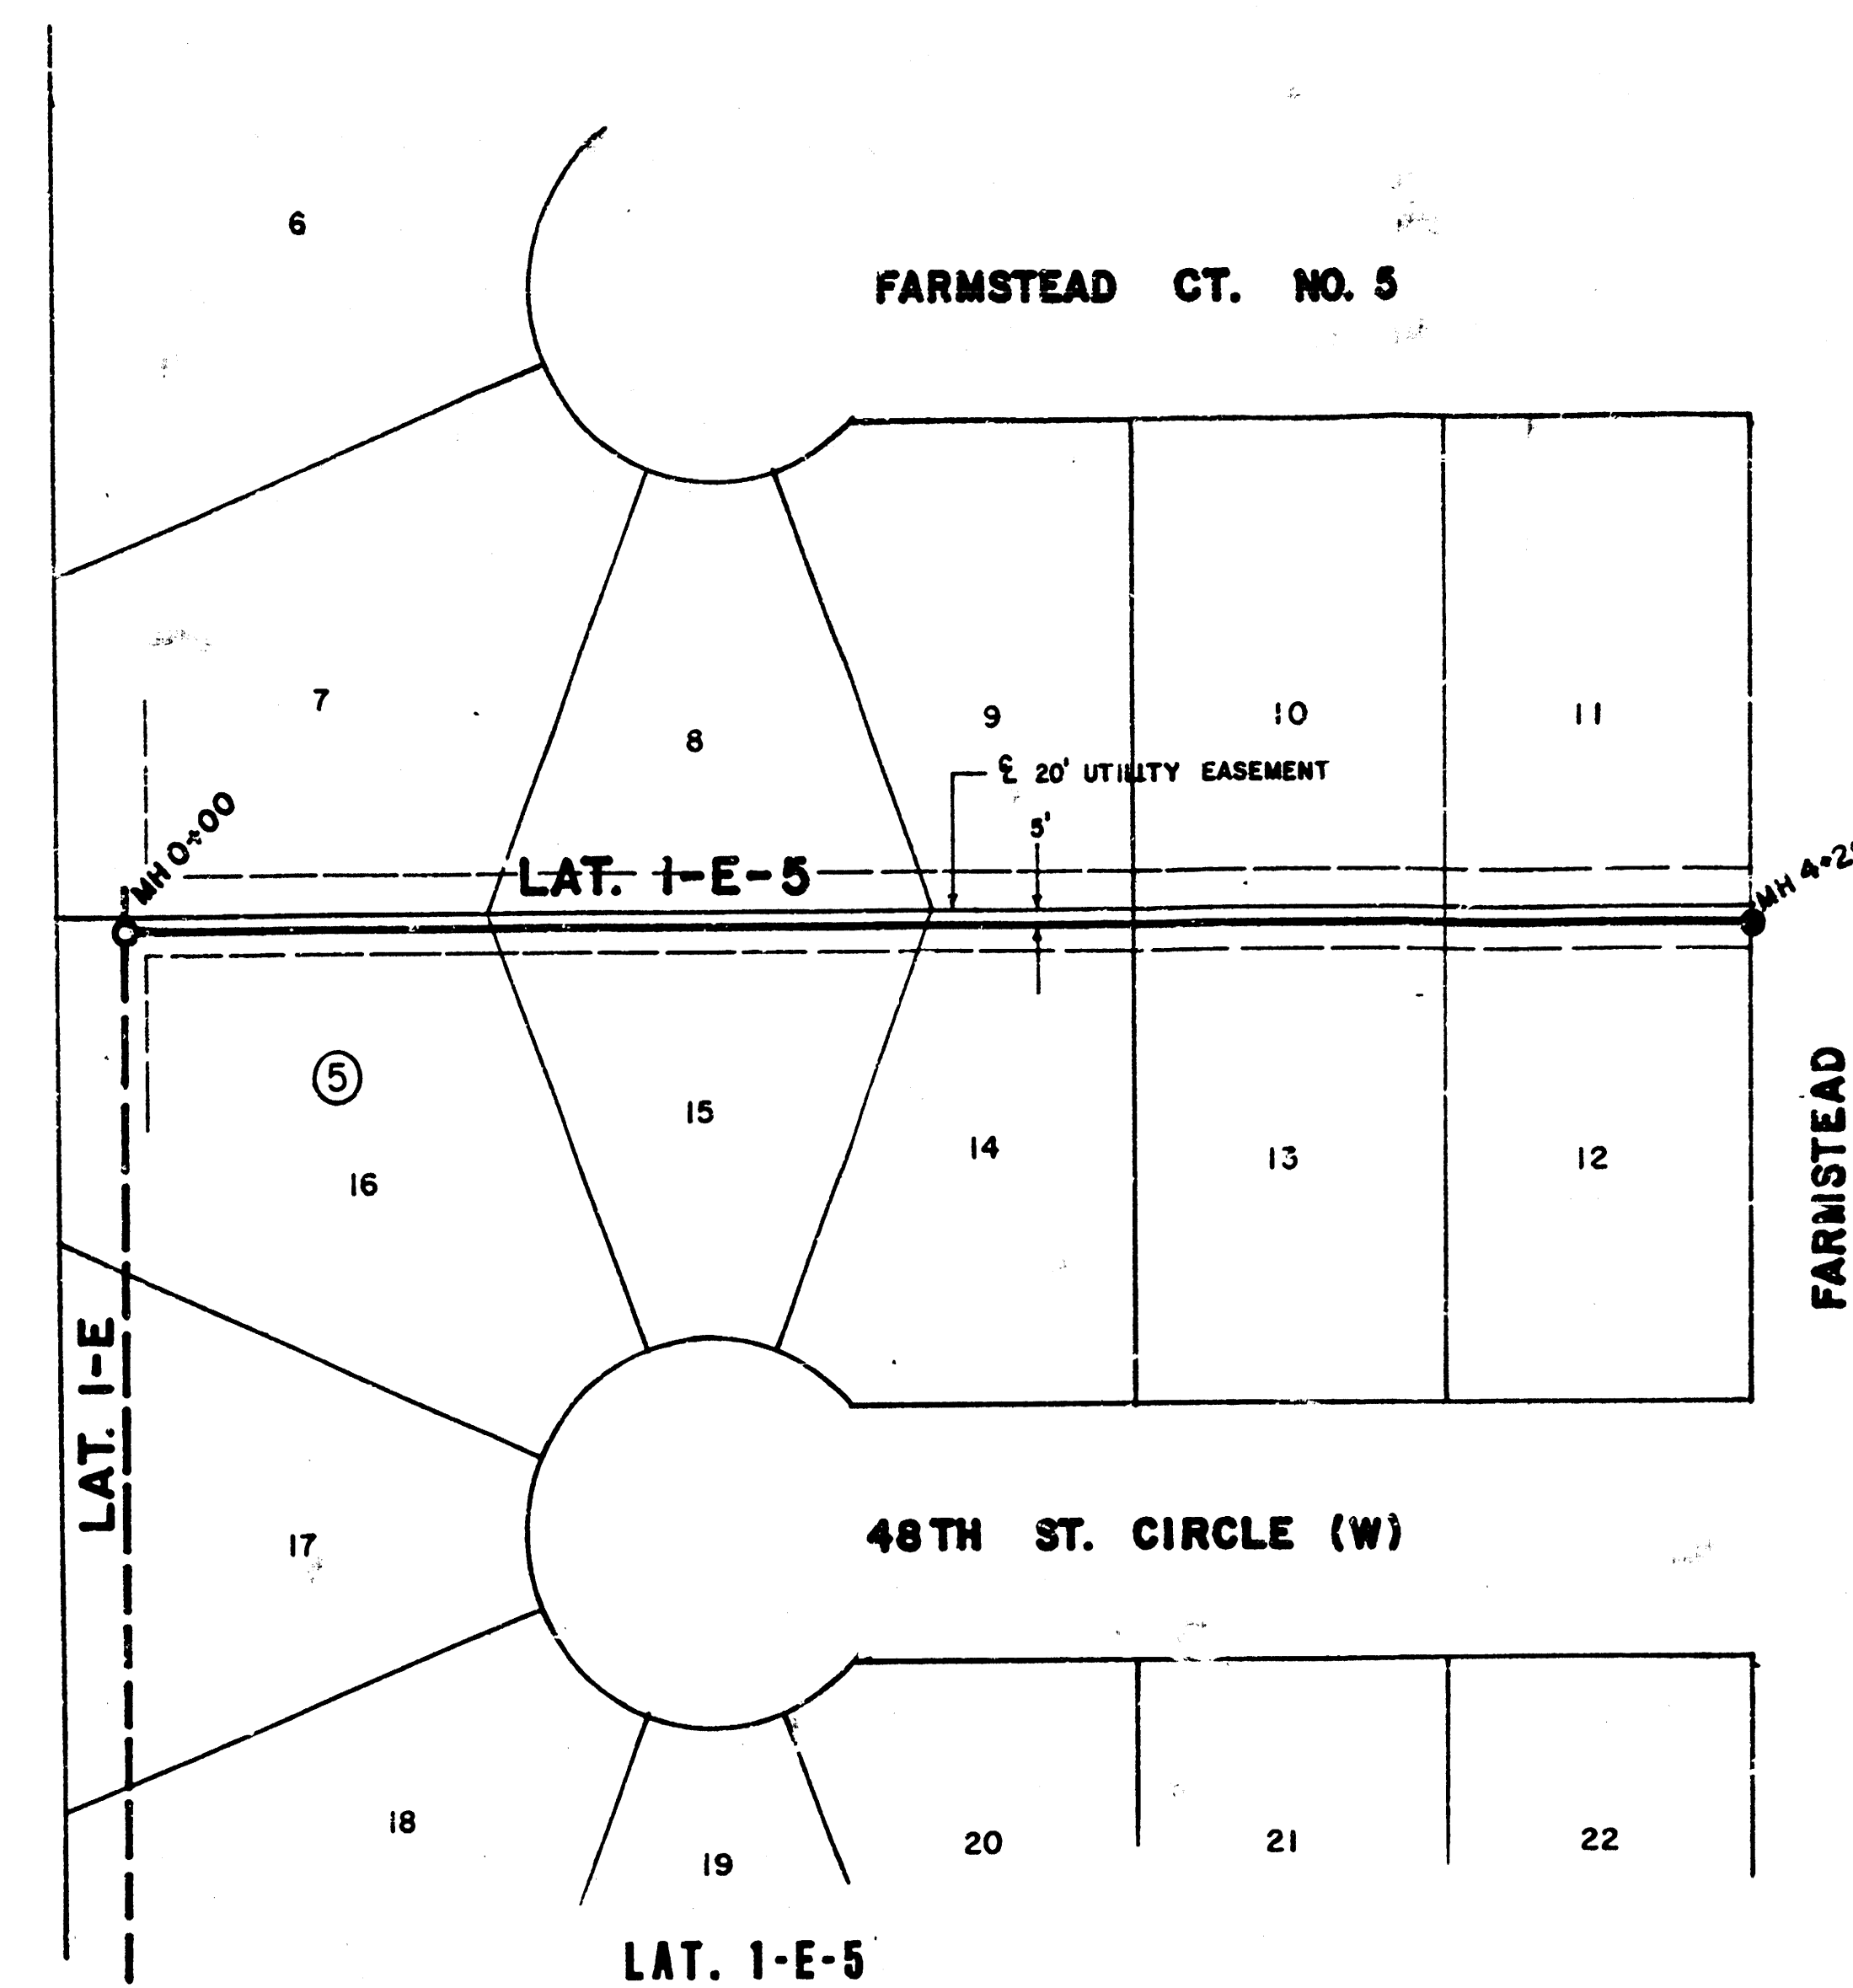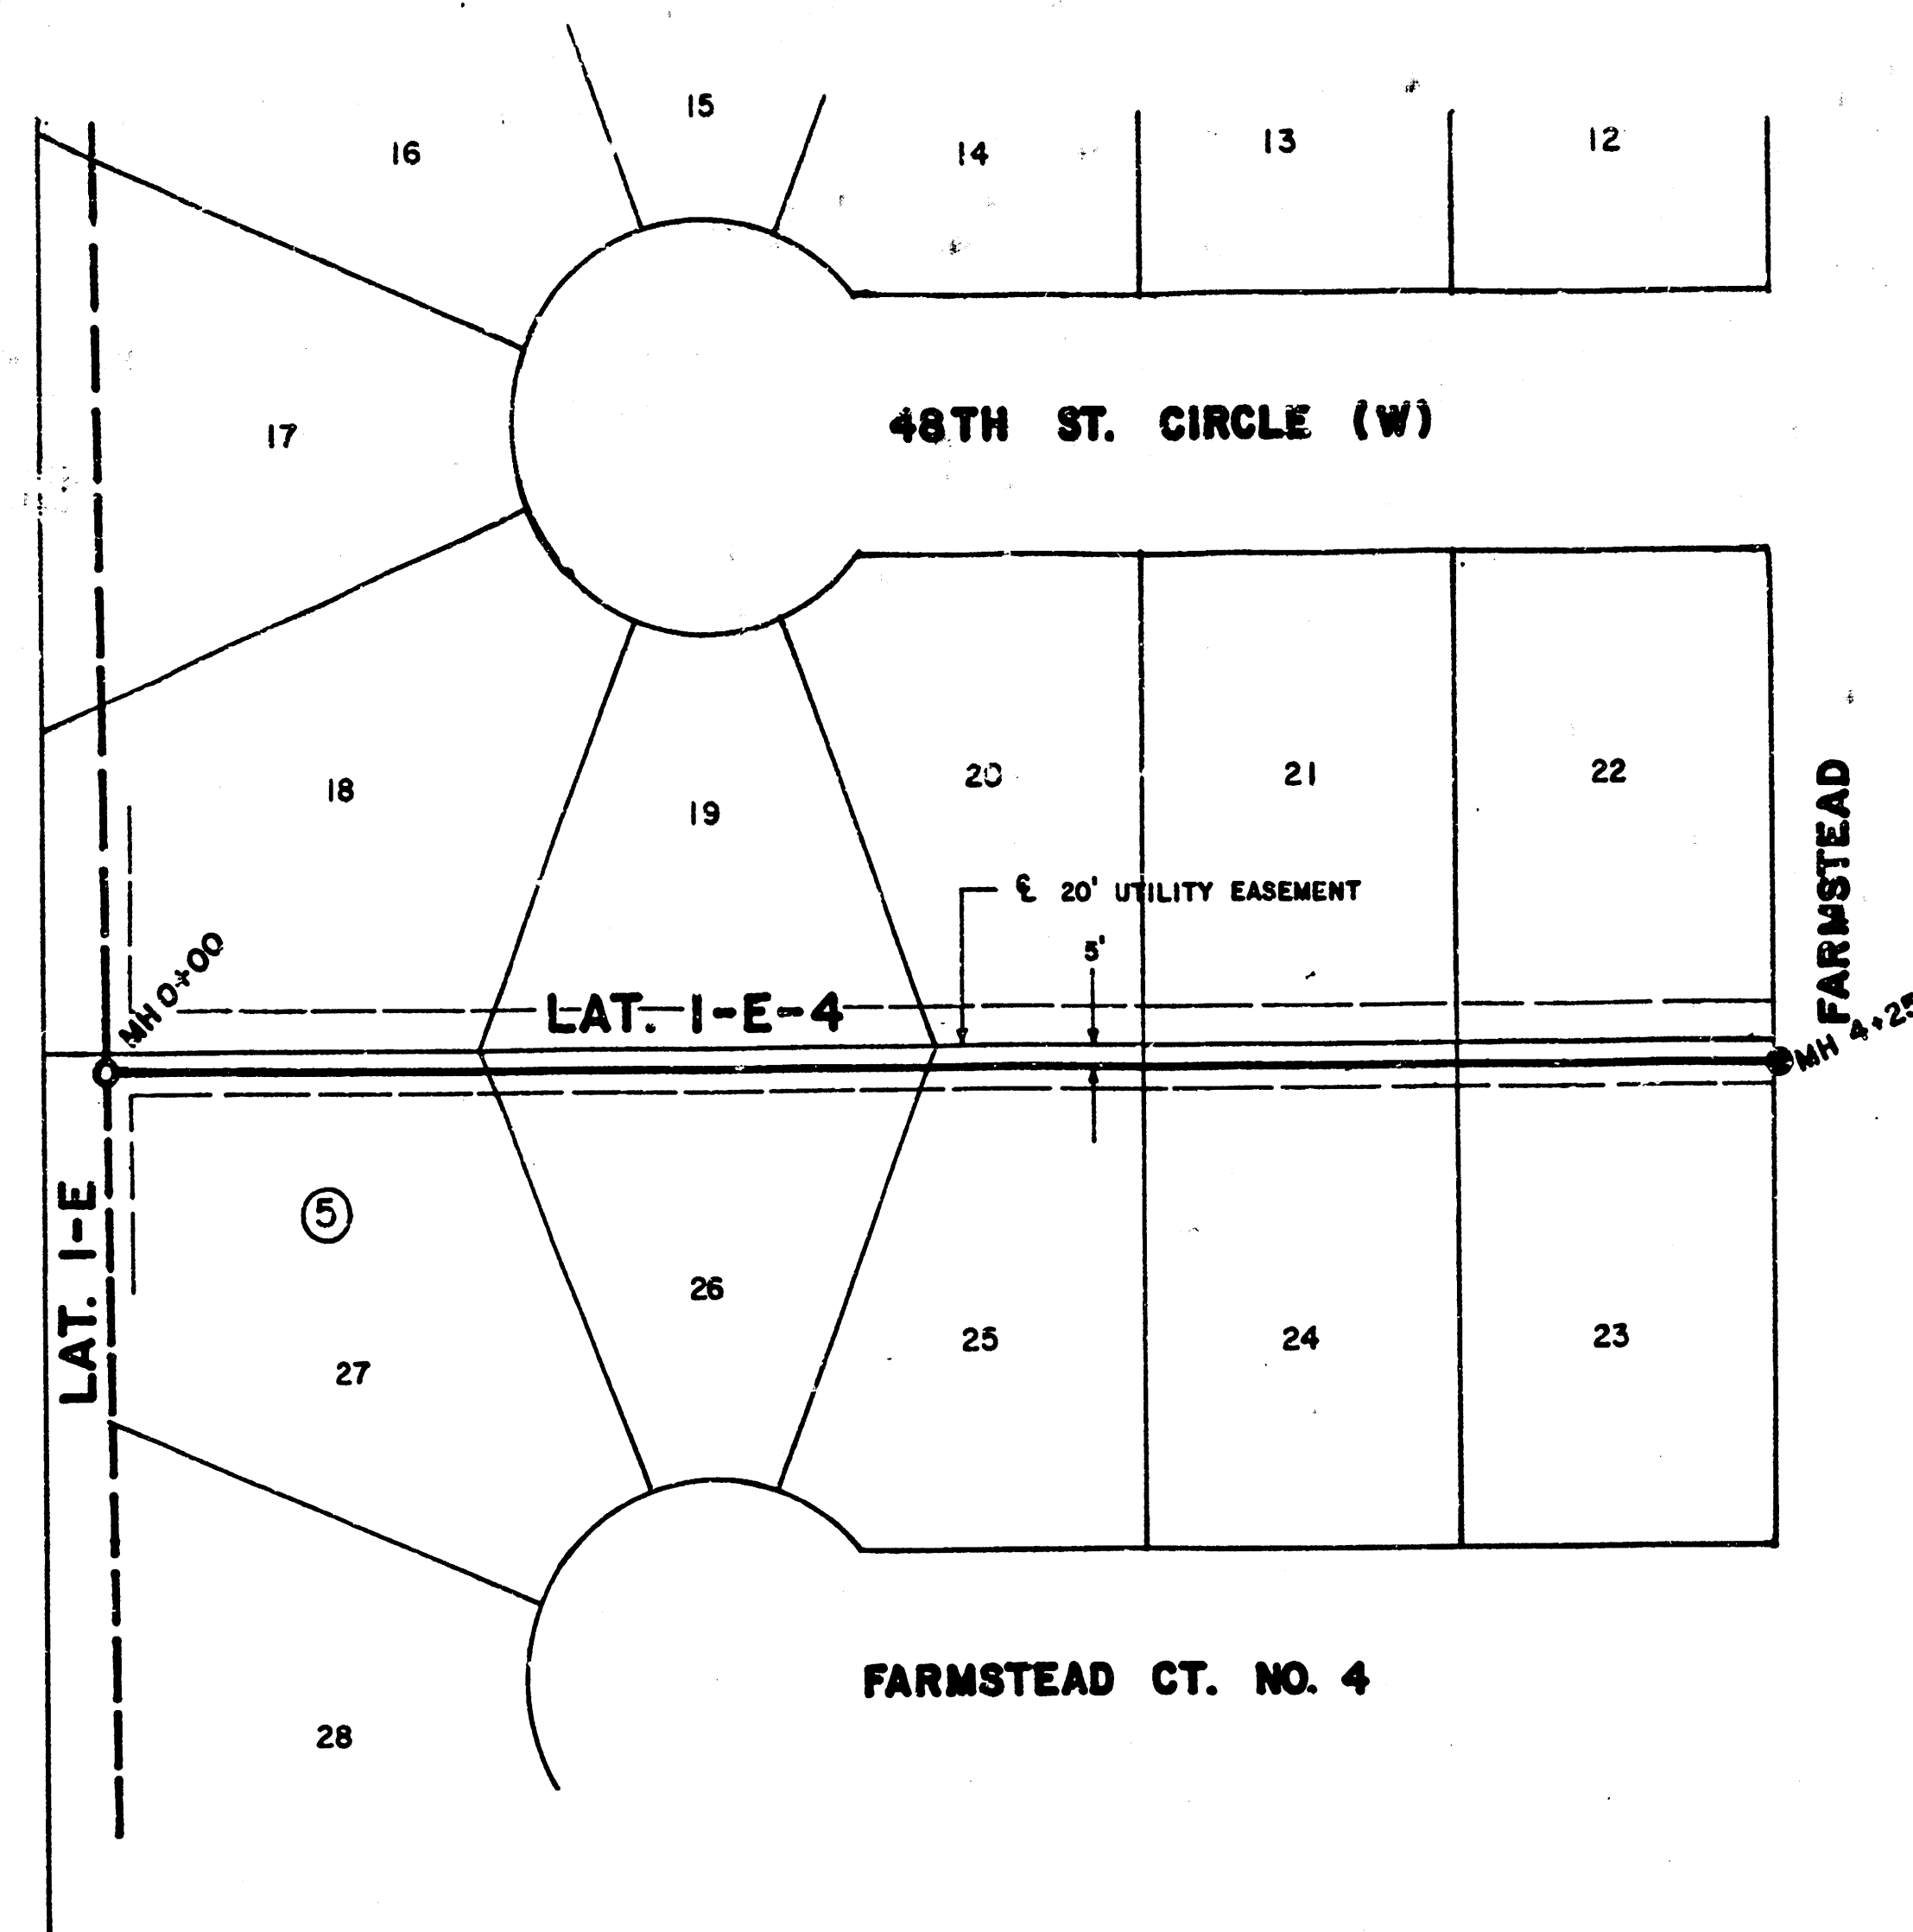



DEISS & GOODNESS ENGINEERS
2100 WEST 21ST STREET
WICHITA, KANSAS 67203
(316) 832-0253

REVISION	DRAWN BY	CHECKED BY	DESIGNED BY	PROJECT	CUSTOMER	SCALE	NOTED	PROJECT NO.
	CS		CS	SANITARY SEWER EXTENSIONS-PHASE III	KAPPELMAN'S BEL AIRE HEIGHTS	10-5-88	5/6	SE1188
	DEJ							

FILMED FROM THE BEST
AVAILABLE COPY

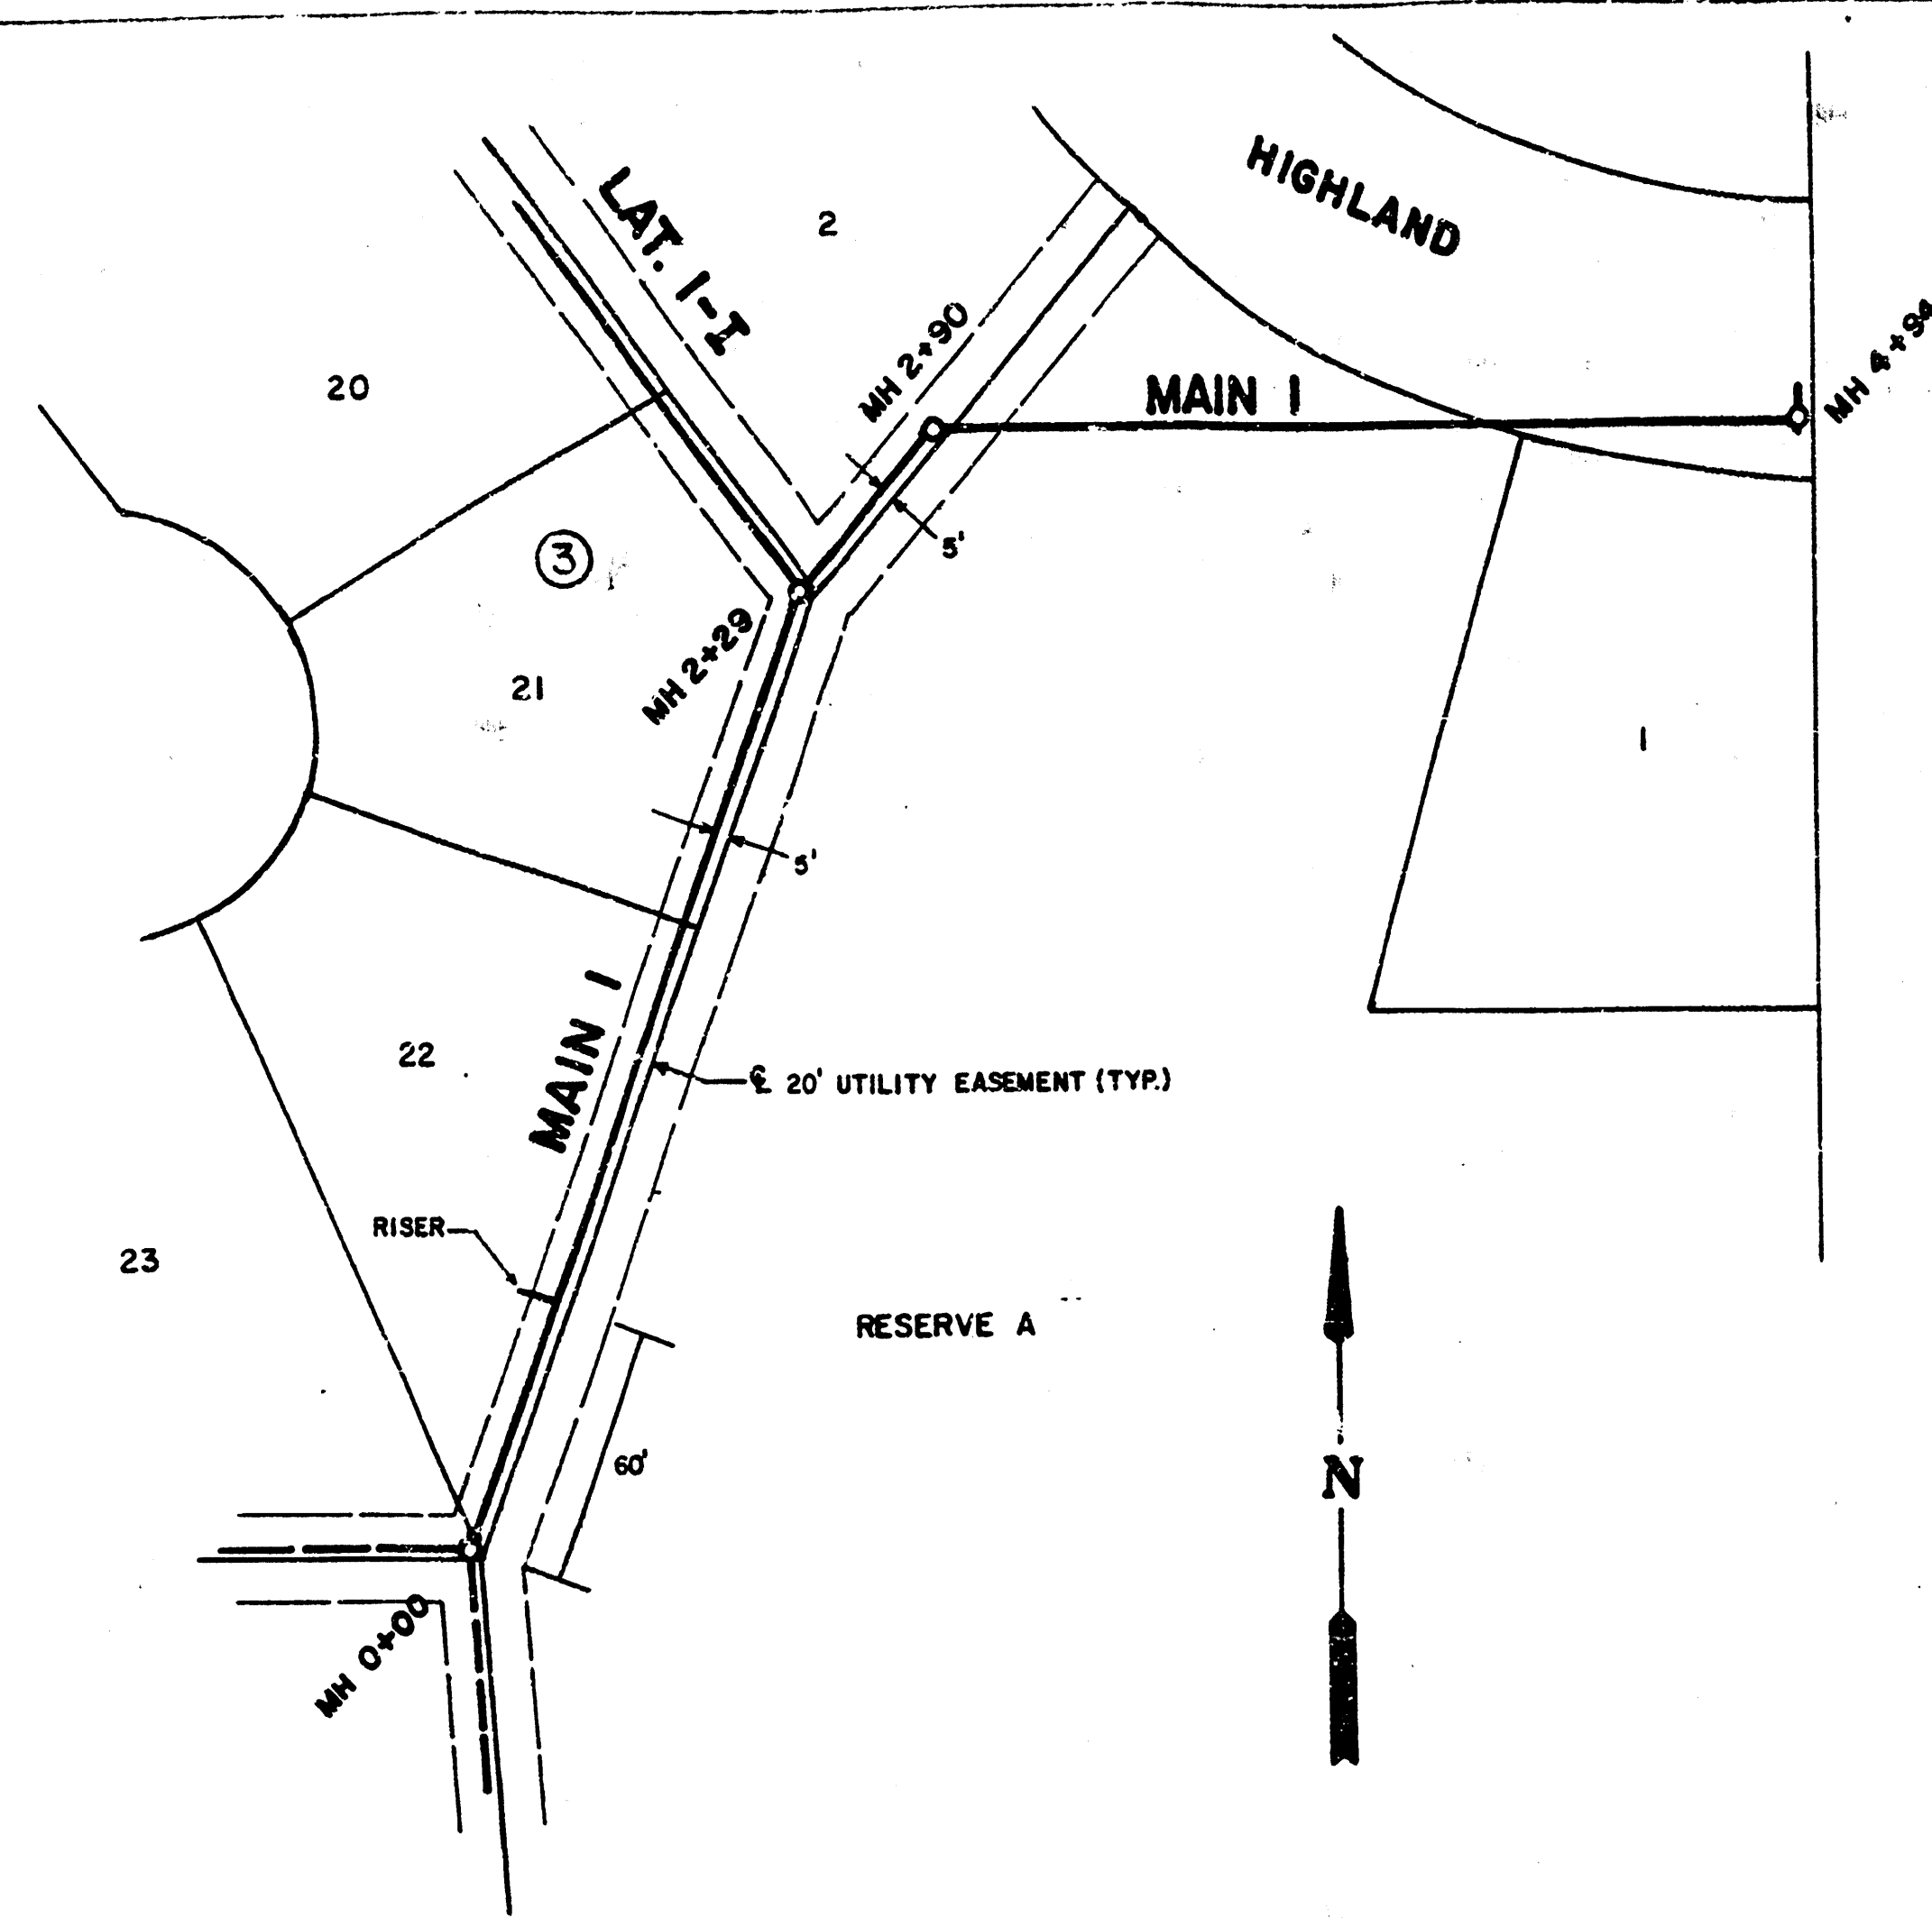

SCALE
PLAN: 1" = 50'
PROFILE: VERT. - 1" = 5'
HORZ. - 1" = 50'

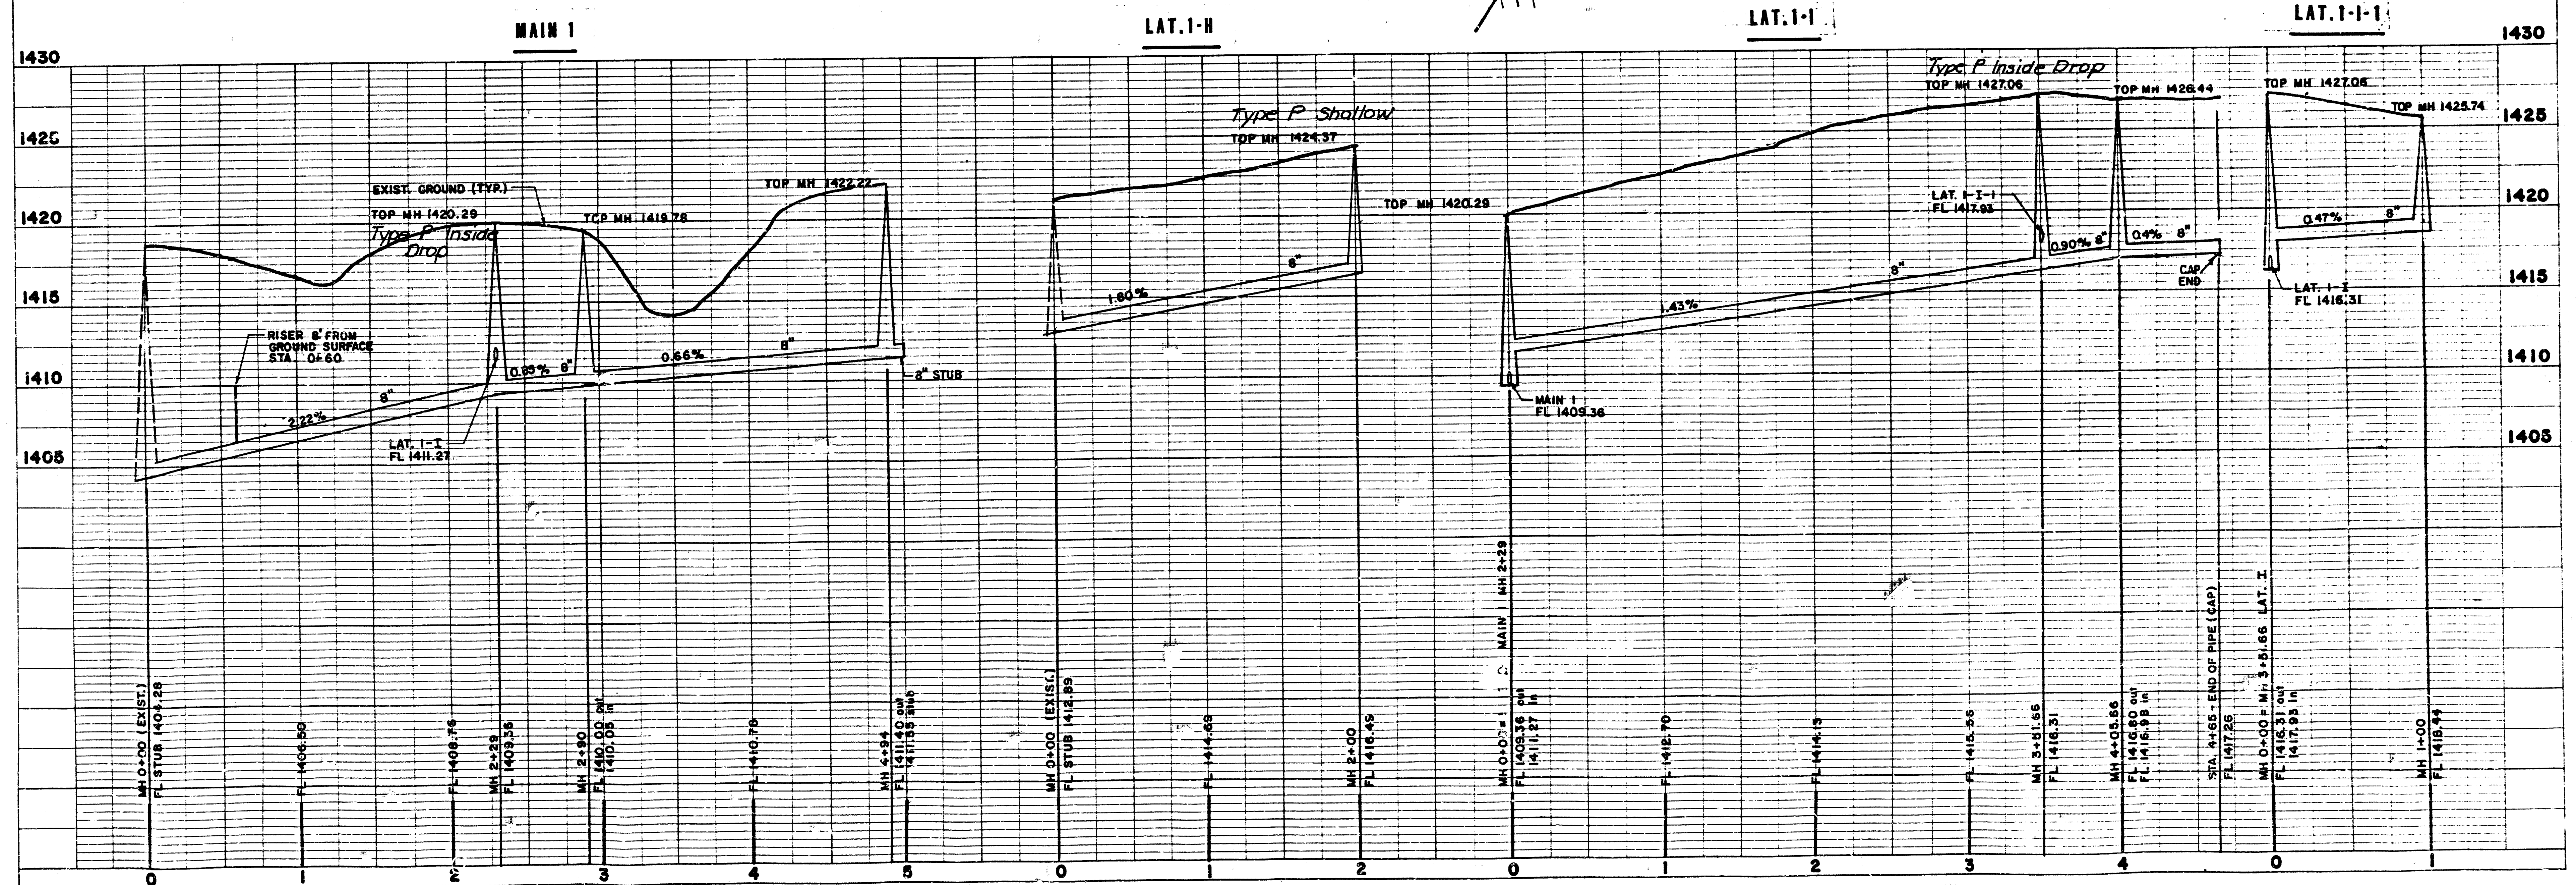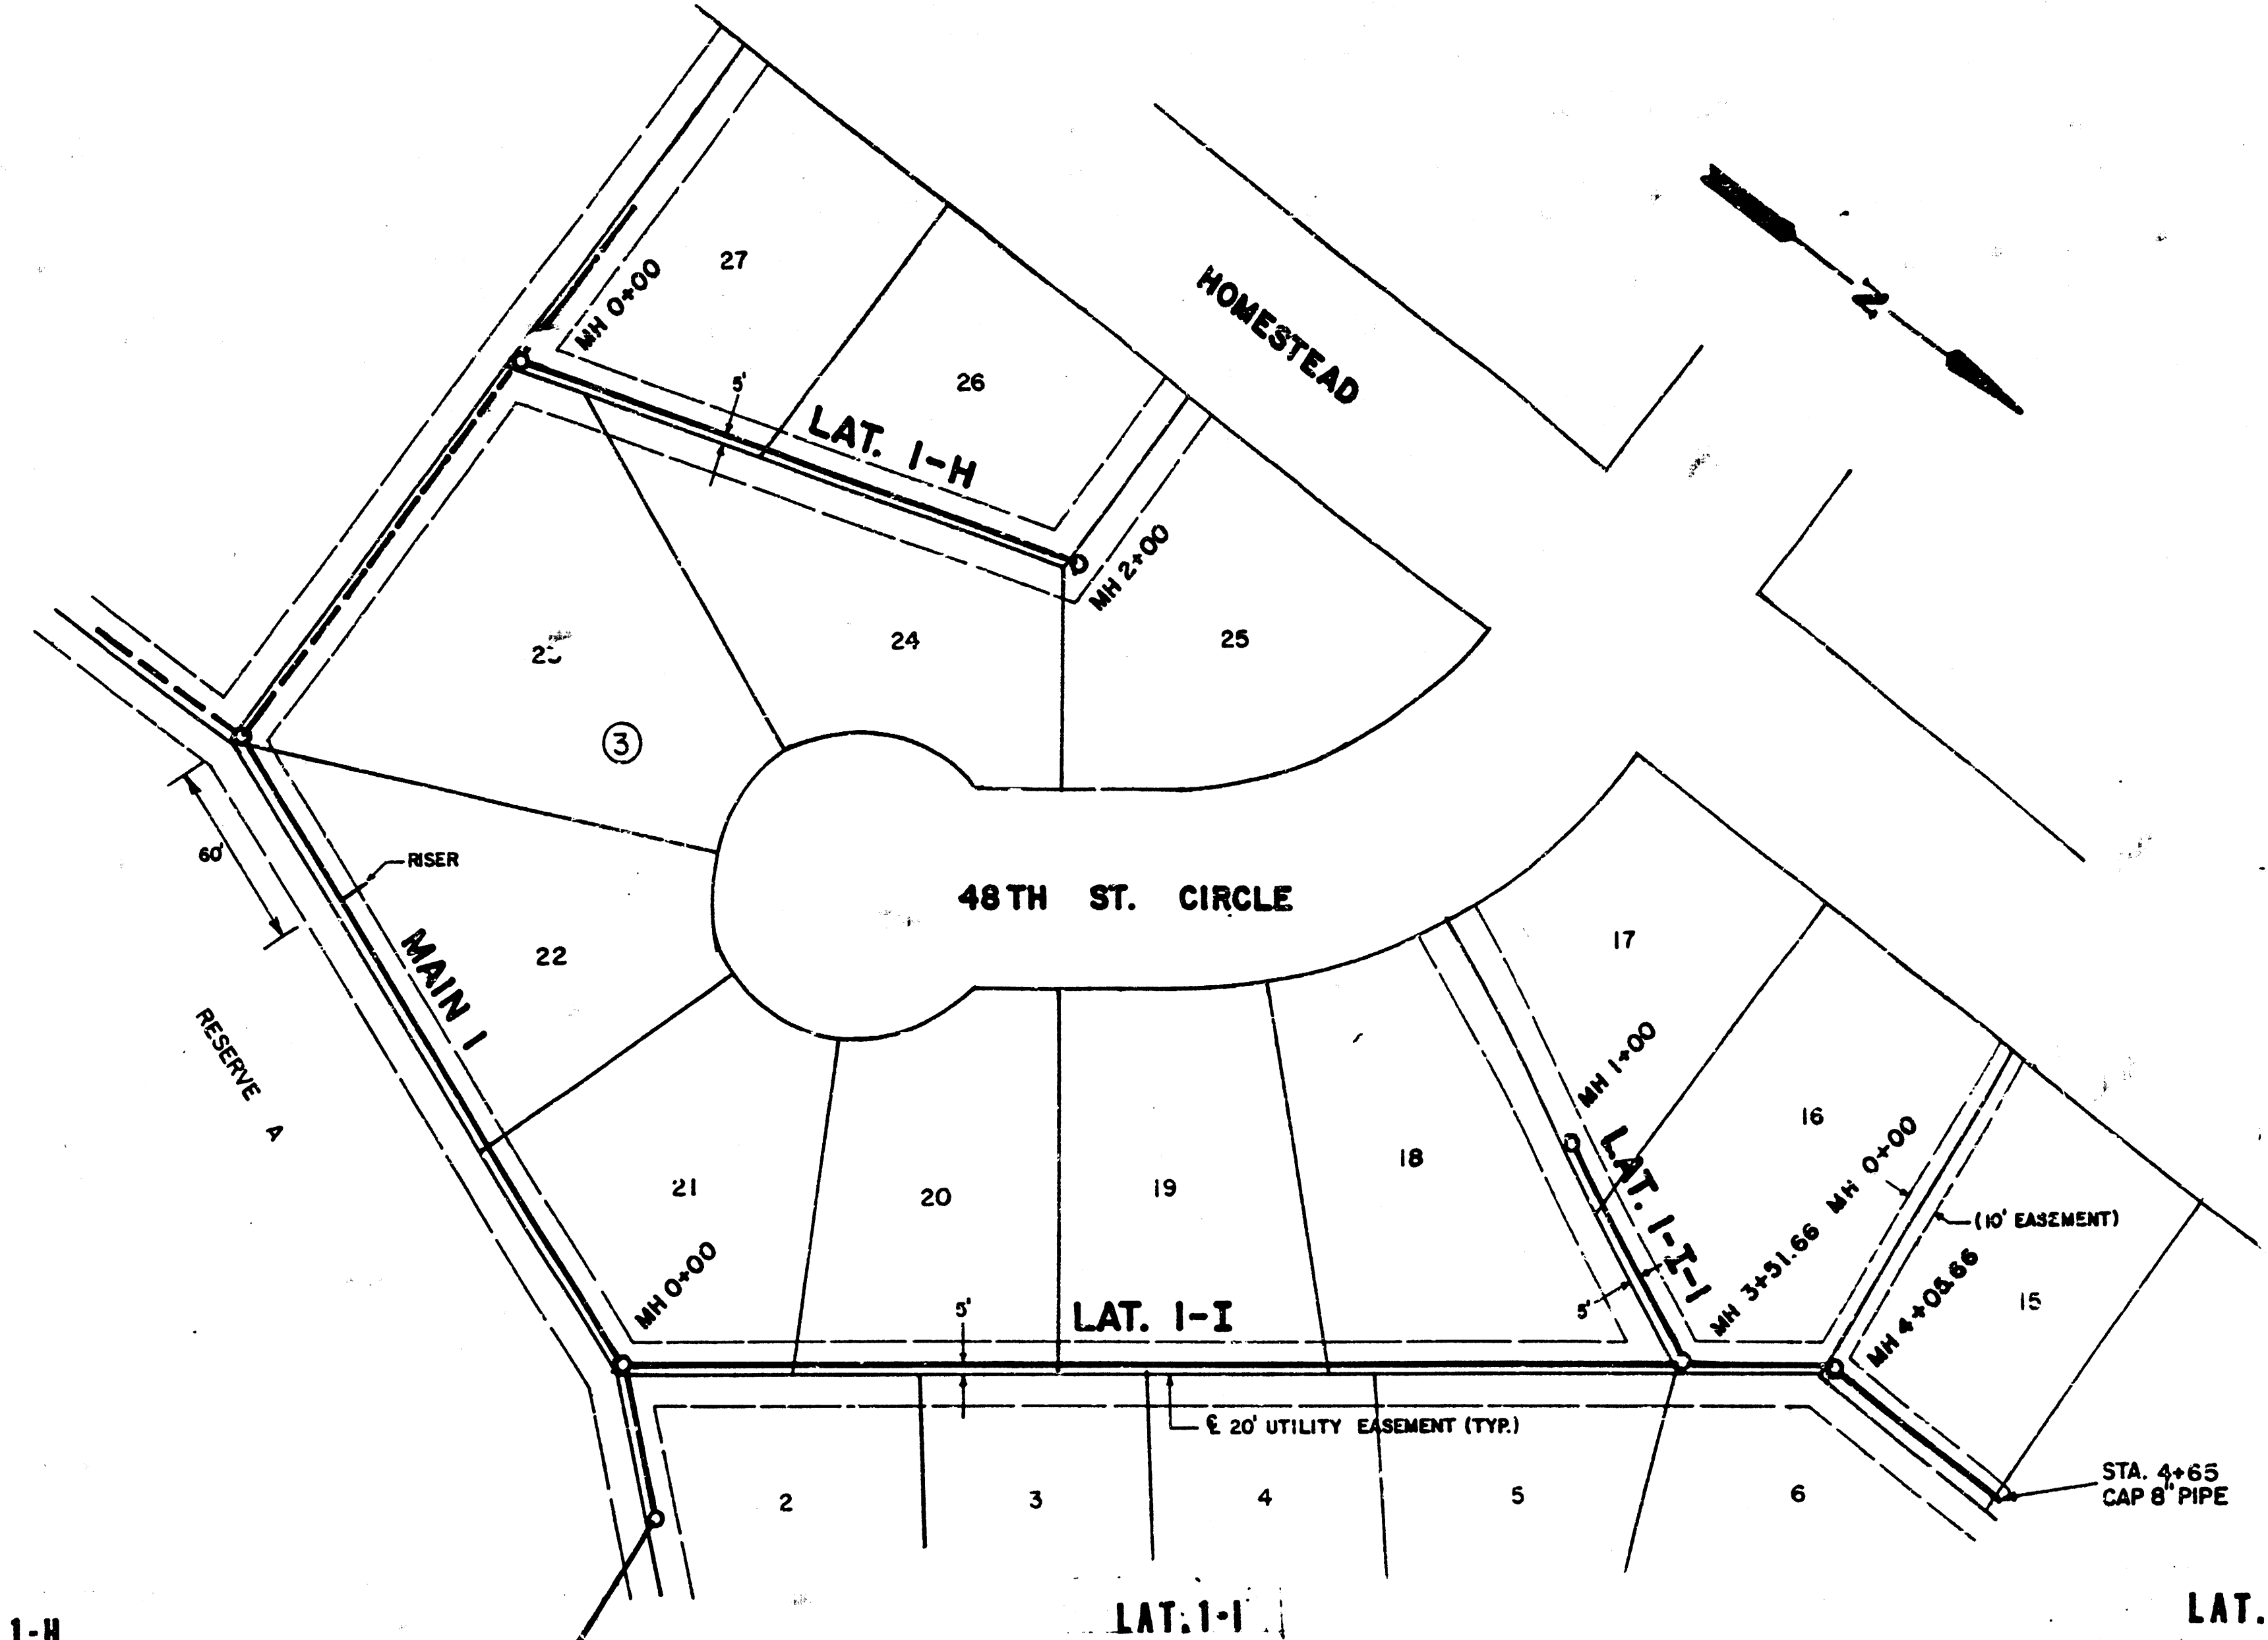

DEISS & GOODNESS ENGINEERS
2160 WEST 21ST STREET
WICHITA, KANSAS 67203
(316) 832-0203

REVISION	DRAWN BY	CHECKED BY	DESIGNED BY	PROJECT	CUSTOMER	SCALE	NOTED	PROJECT NO.
	CG		CG	SANITARY SEWER EXTENSIONS-PHASE III	KAPPLEMAN'S BEL AIRE HEIGHTS	10-5-88		6148
	DEJ							SHEET 6 OF 10

FILMED FROM THE BEST
AVAILABLE COPY