



PLAN	SURVEYED	DATE
	NOTED	BY
NOTE BOOK	NO.	

PROFILE	SURVEYED	DATE
	NOTED	BY
NOTE BOOK	NO.	

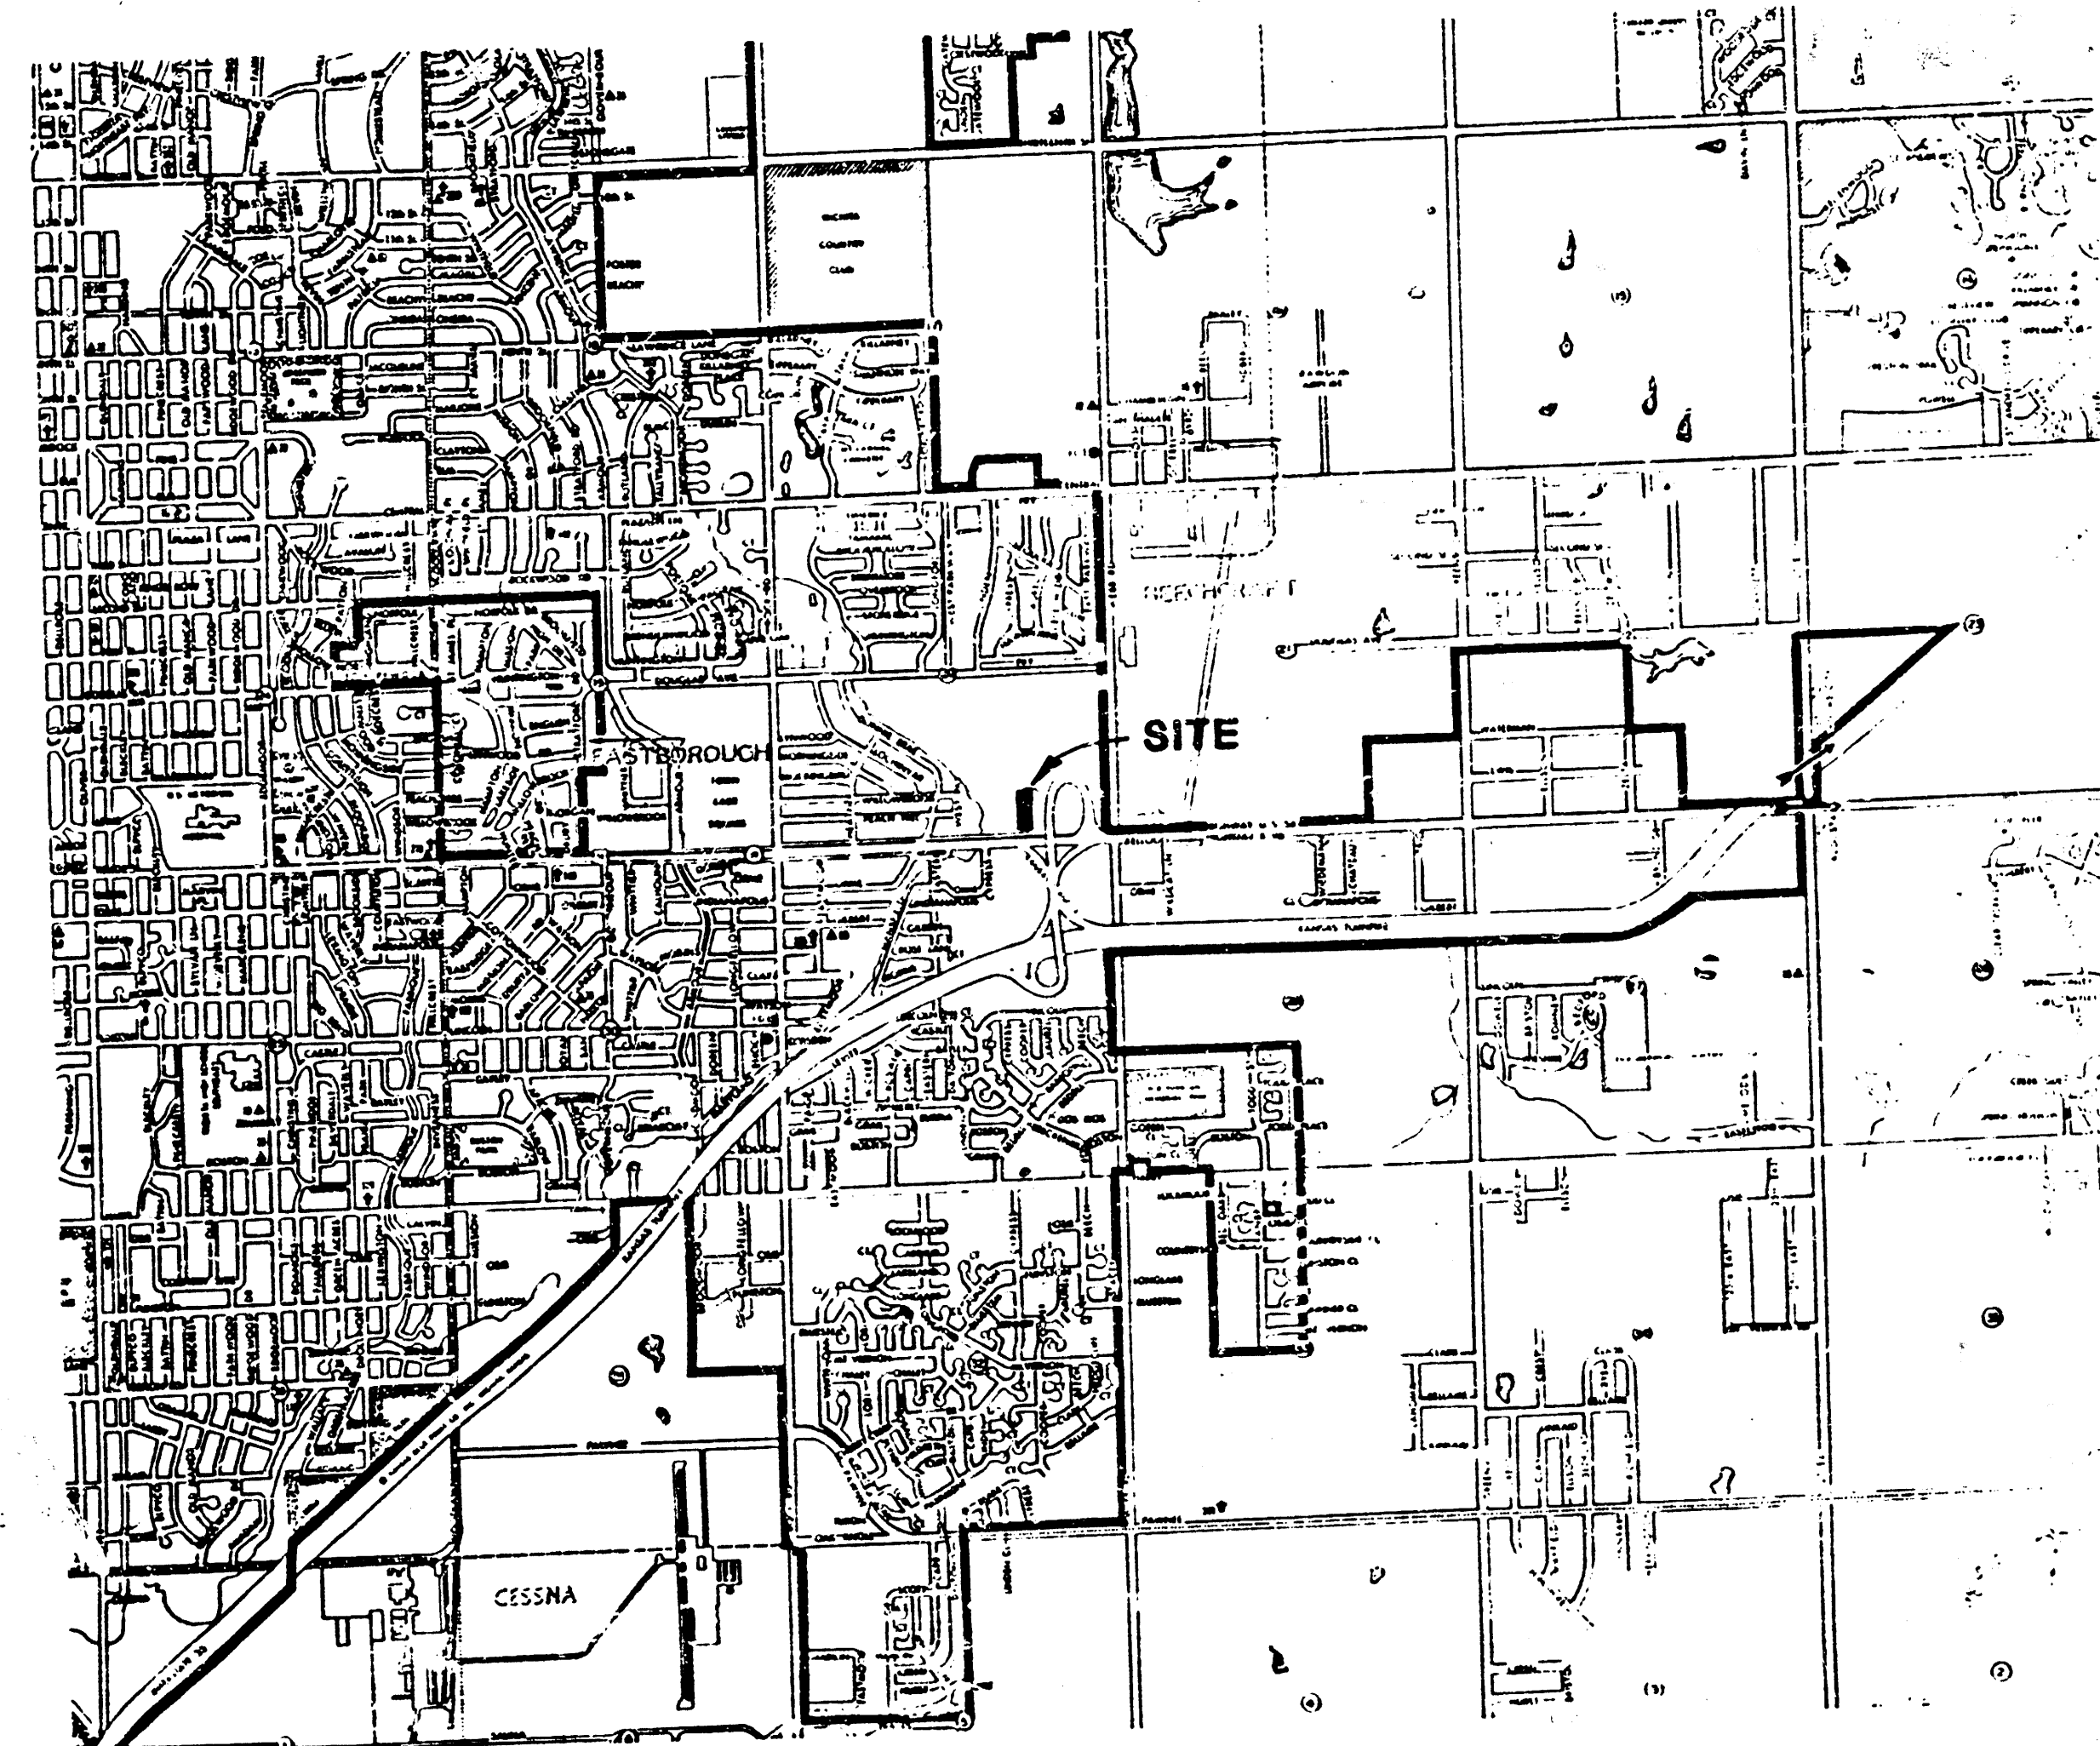

VICINITY MAP

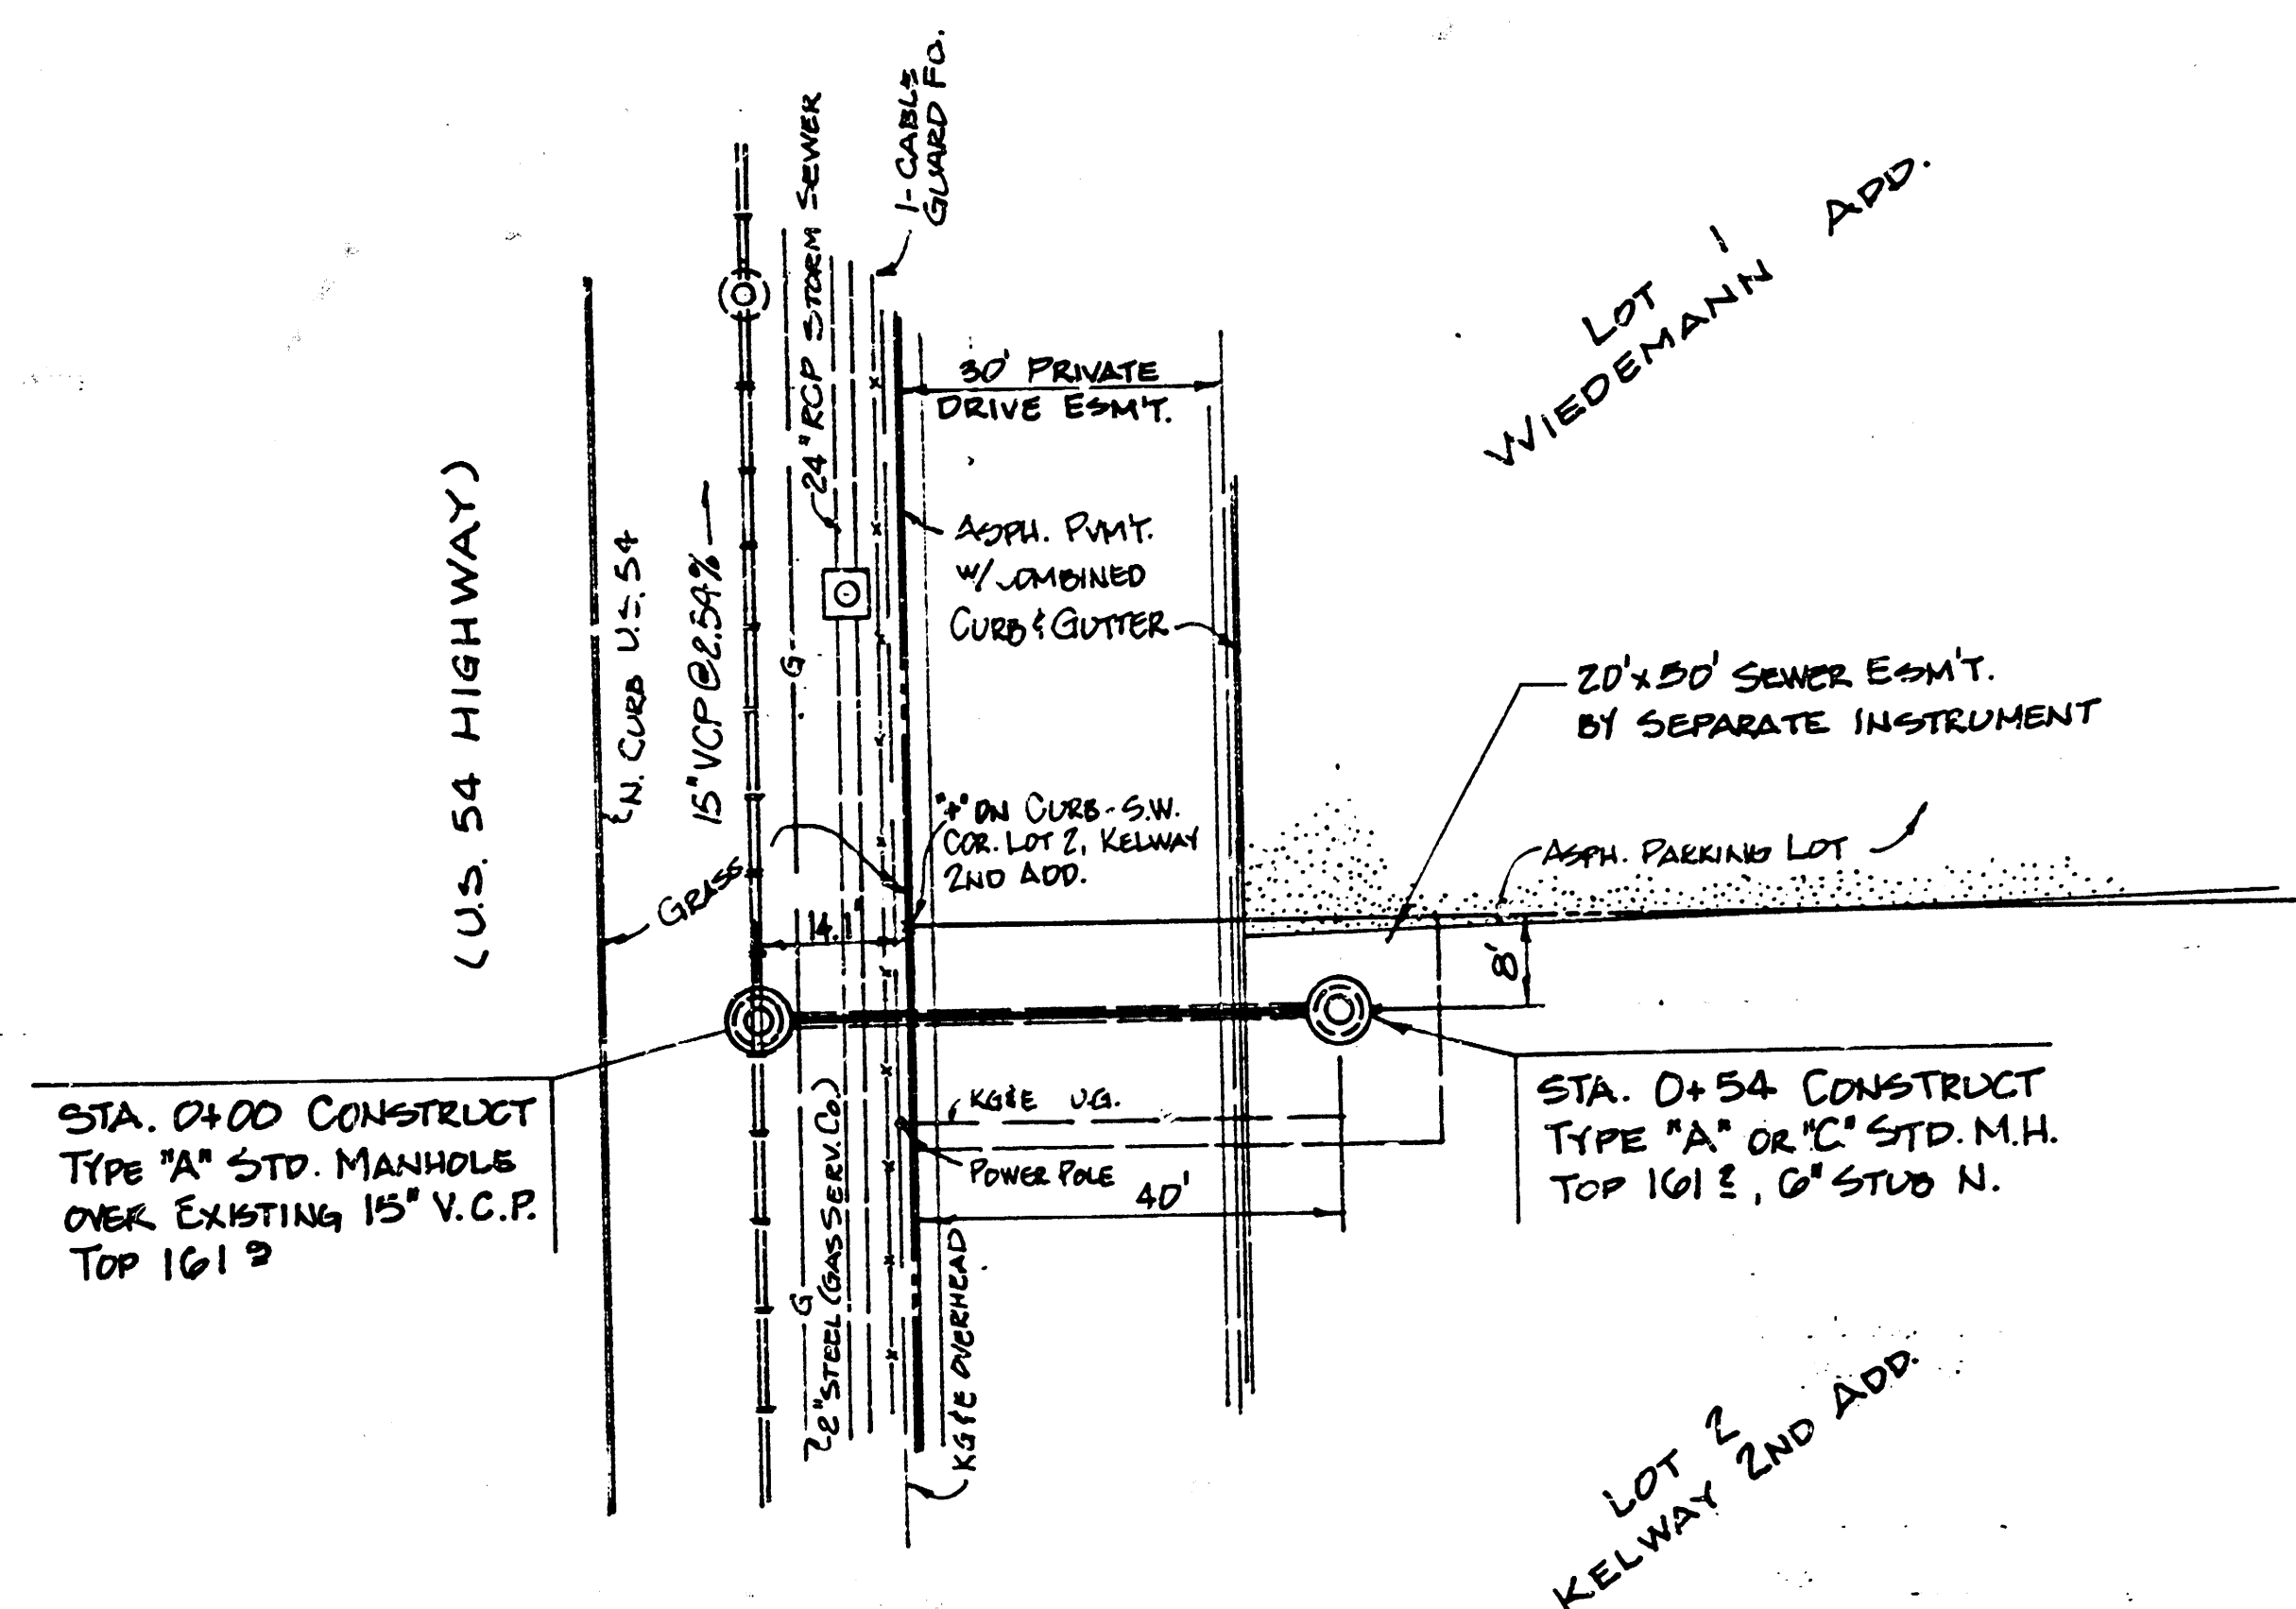



BENCH MARK - "I" ON TOP OF CURB @ S.W. COR. LOT 2, KELWAY 2ND ADD., ELEV. 161.47

N
1" = 20'

APPROVED AS NOTED
By CITY ENGINEER OF WICHITA
Sanitary Sewers, DOB 12/6/84
Storm Sewers _____
Driveway Approaches _____

NOTE TO CONTRACTOR
This project will be constructed under the supervision of the CITY ENGINEER and conforming to the SPECIFICATIONS of the CITY OF WICHITA. The CONTRACTOR will prepay the City of Wichita for all costs of Inspection.

PROFILE SCALE
1" = 20' HORIZ.
1" = 5' VERT.

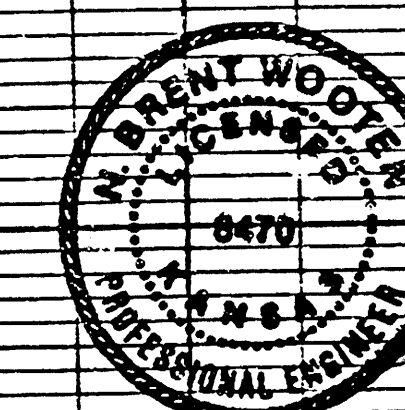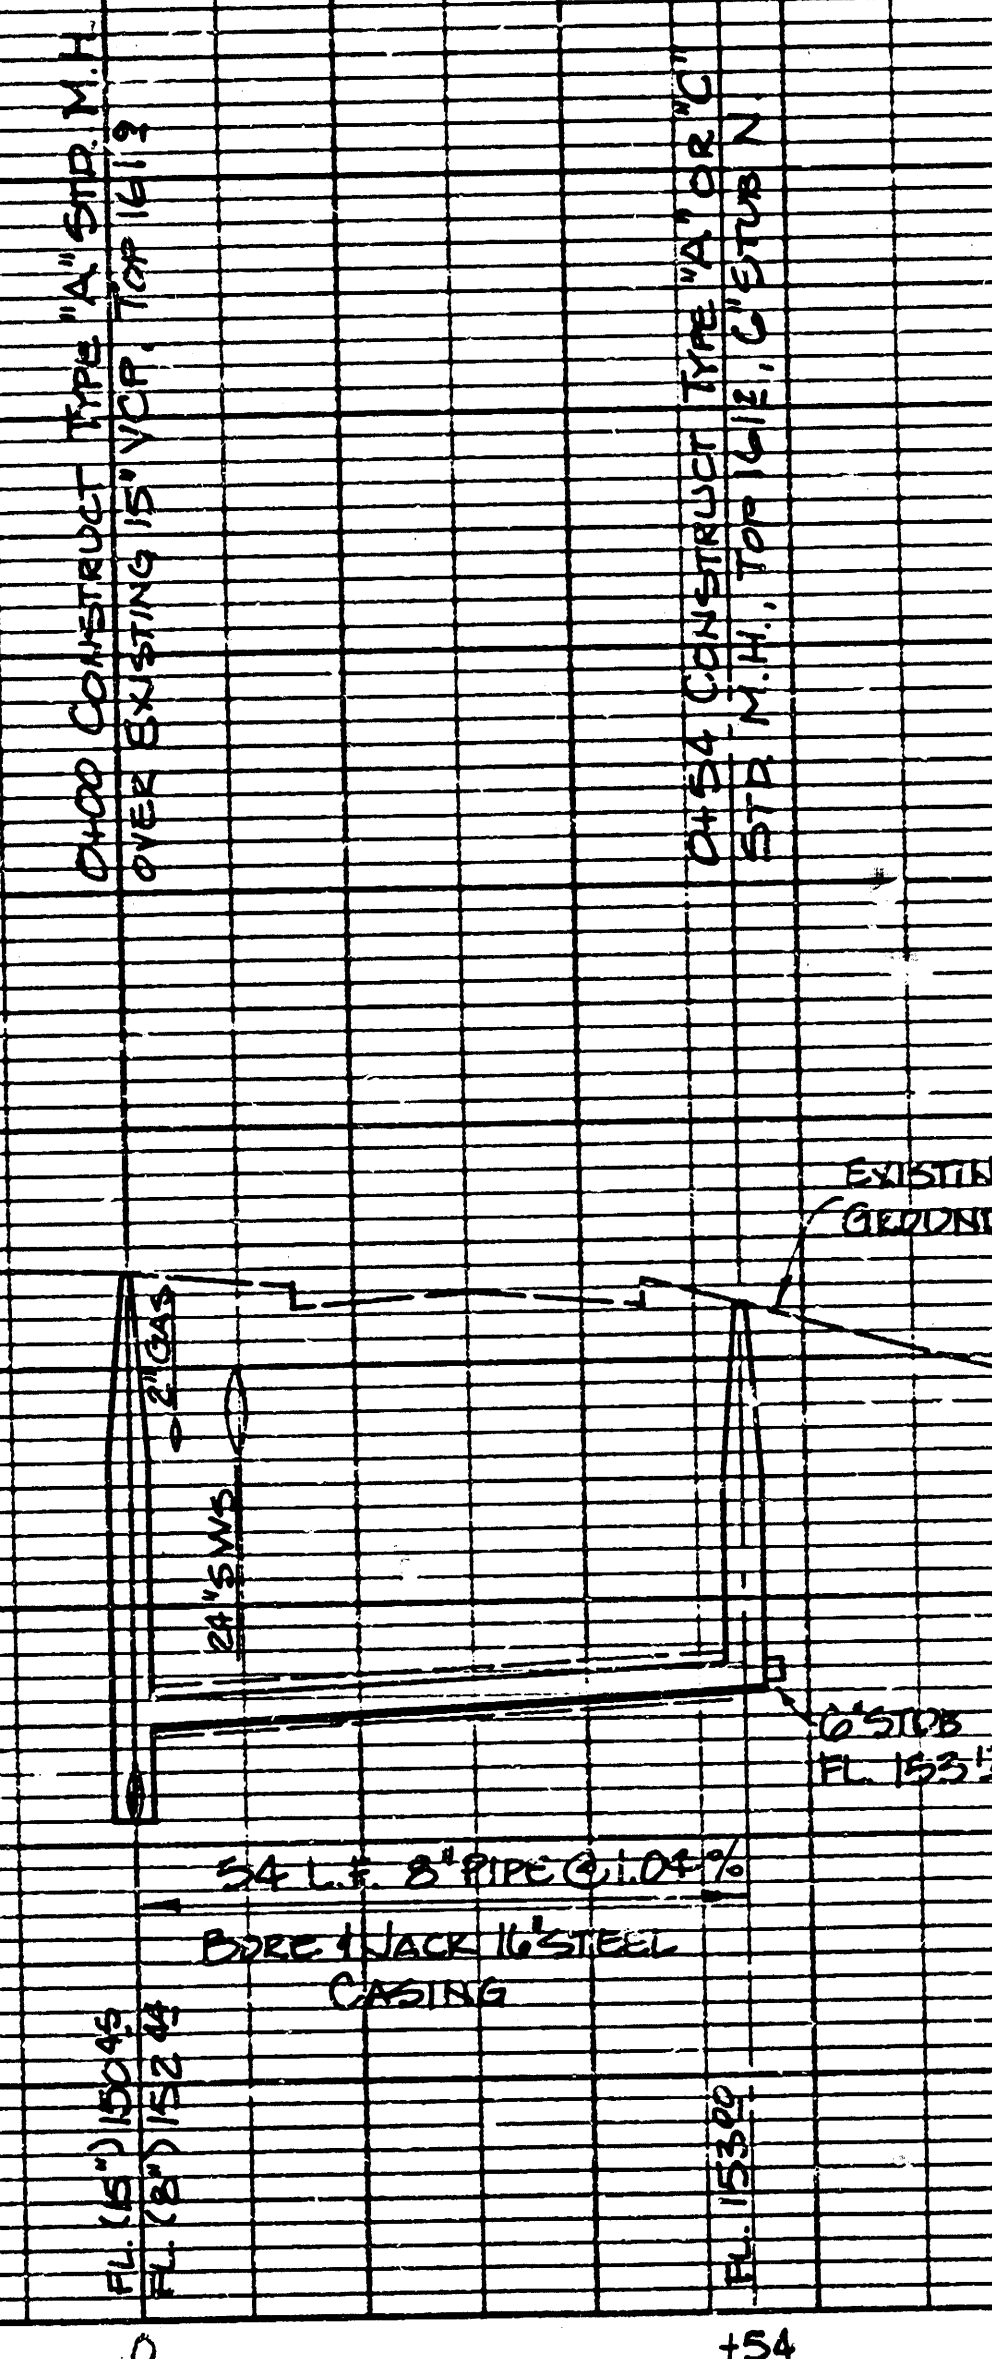

DECEMBER 1984

PRIVATE SANITARY SEWER
TO SERVE LOT 2, KELWAY 2nd ADDITION

CITY OF WICHITA, KANSAS
Project no. 488-76-245-80000-000-000-008

BAUGHMAN COMPANY, P.A.
SURVEYING & ENGINEERING
316/232-7271 334 LAUREA • WICHITA, KANSAS 67211