





Langland Addn.

7-15-76
 APPROVED AS NOTED
 By CITY ENGINEER OF WICHITA
 Sanitary Sewers _____
 Storm Sewers D.E.S.
 Driveway Approaches _____

INCORPORATED
 KANSAS TURNPIKE AUTHORITY

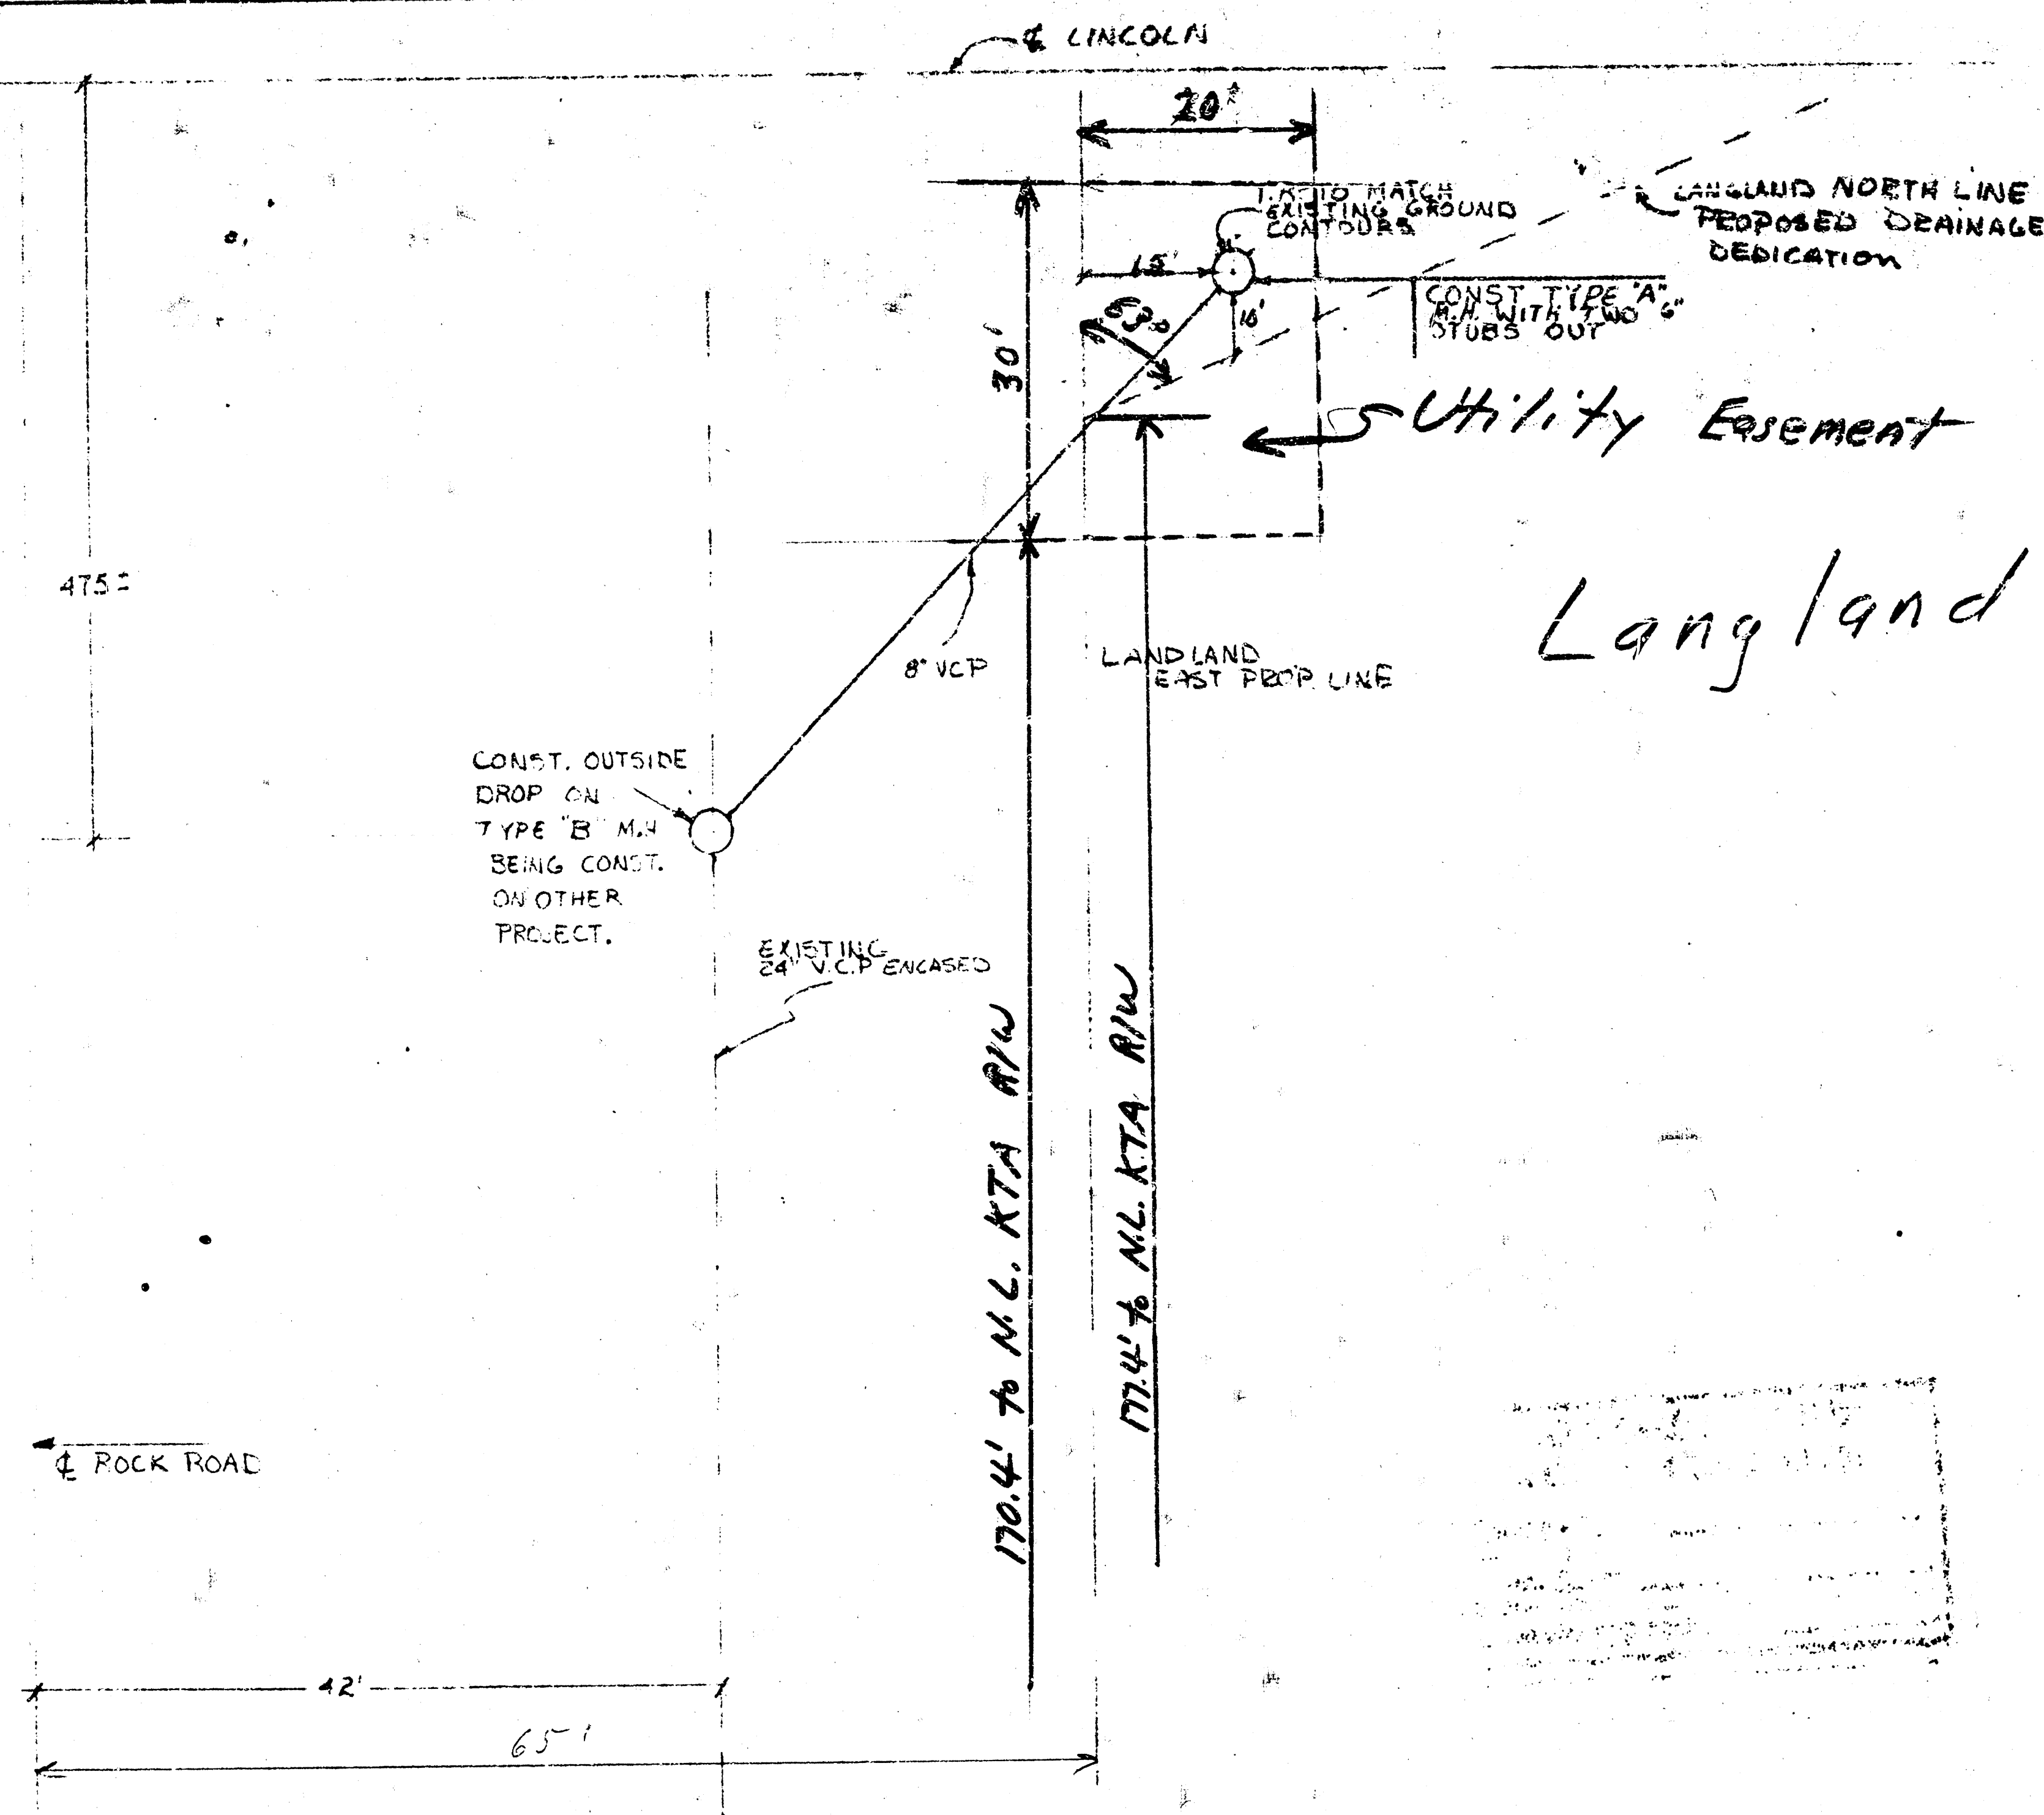

SCALE 1"=10'

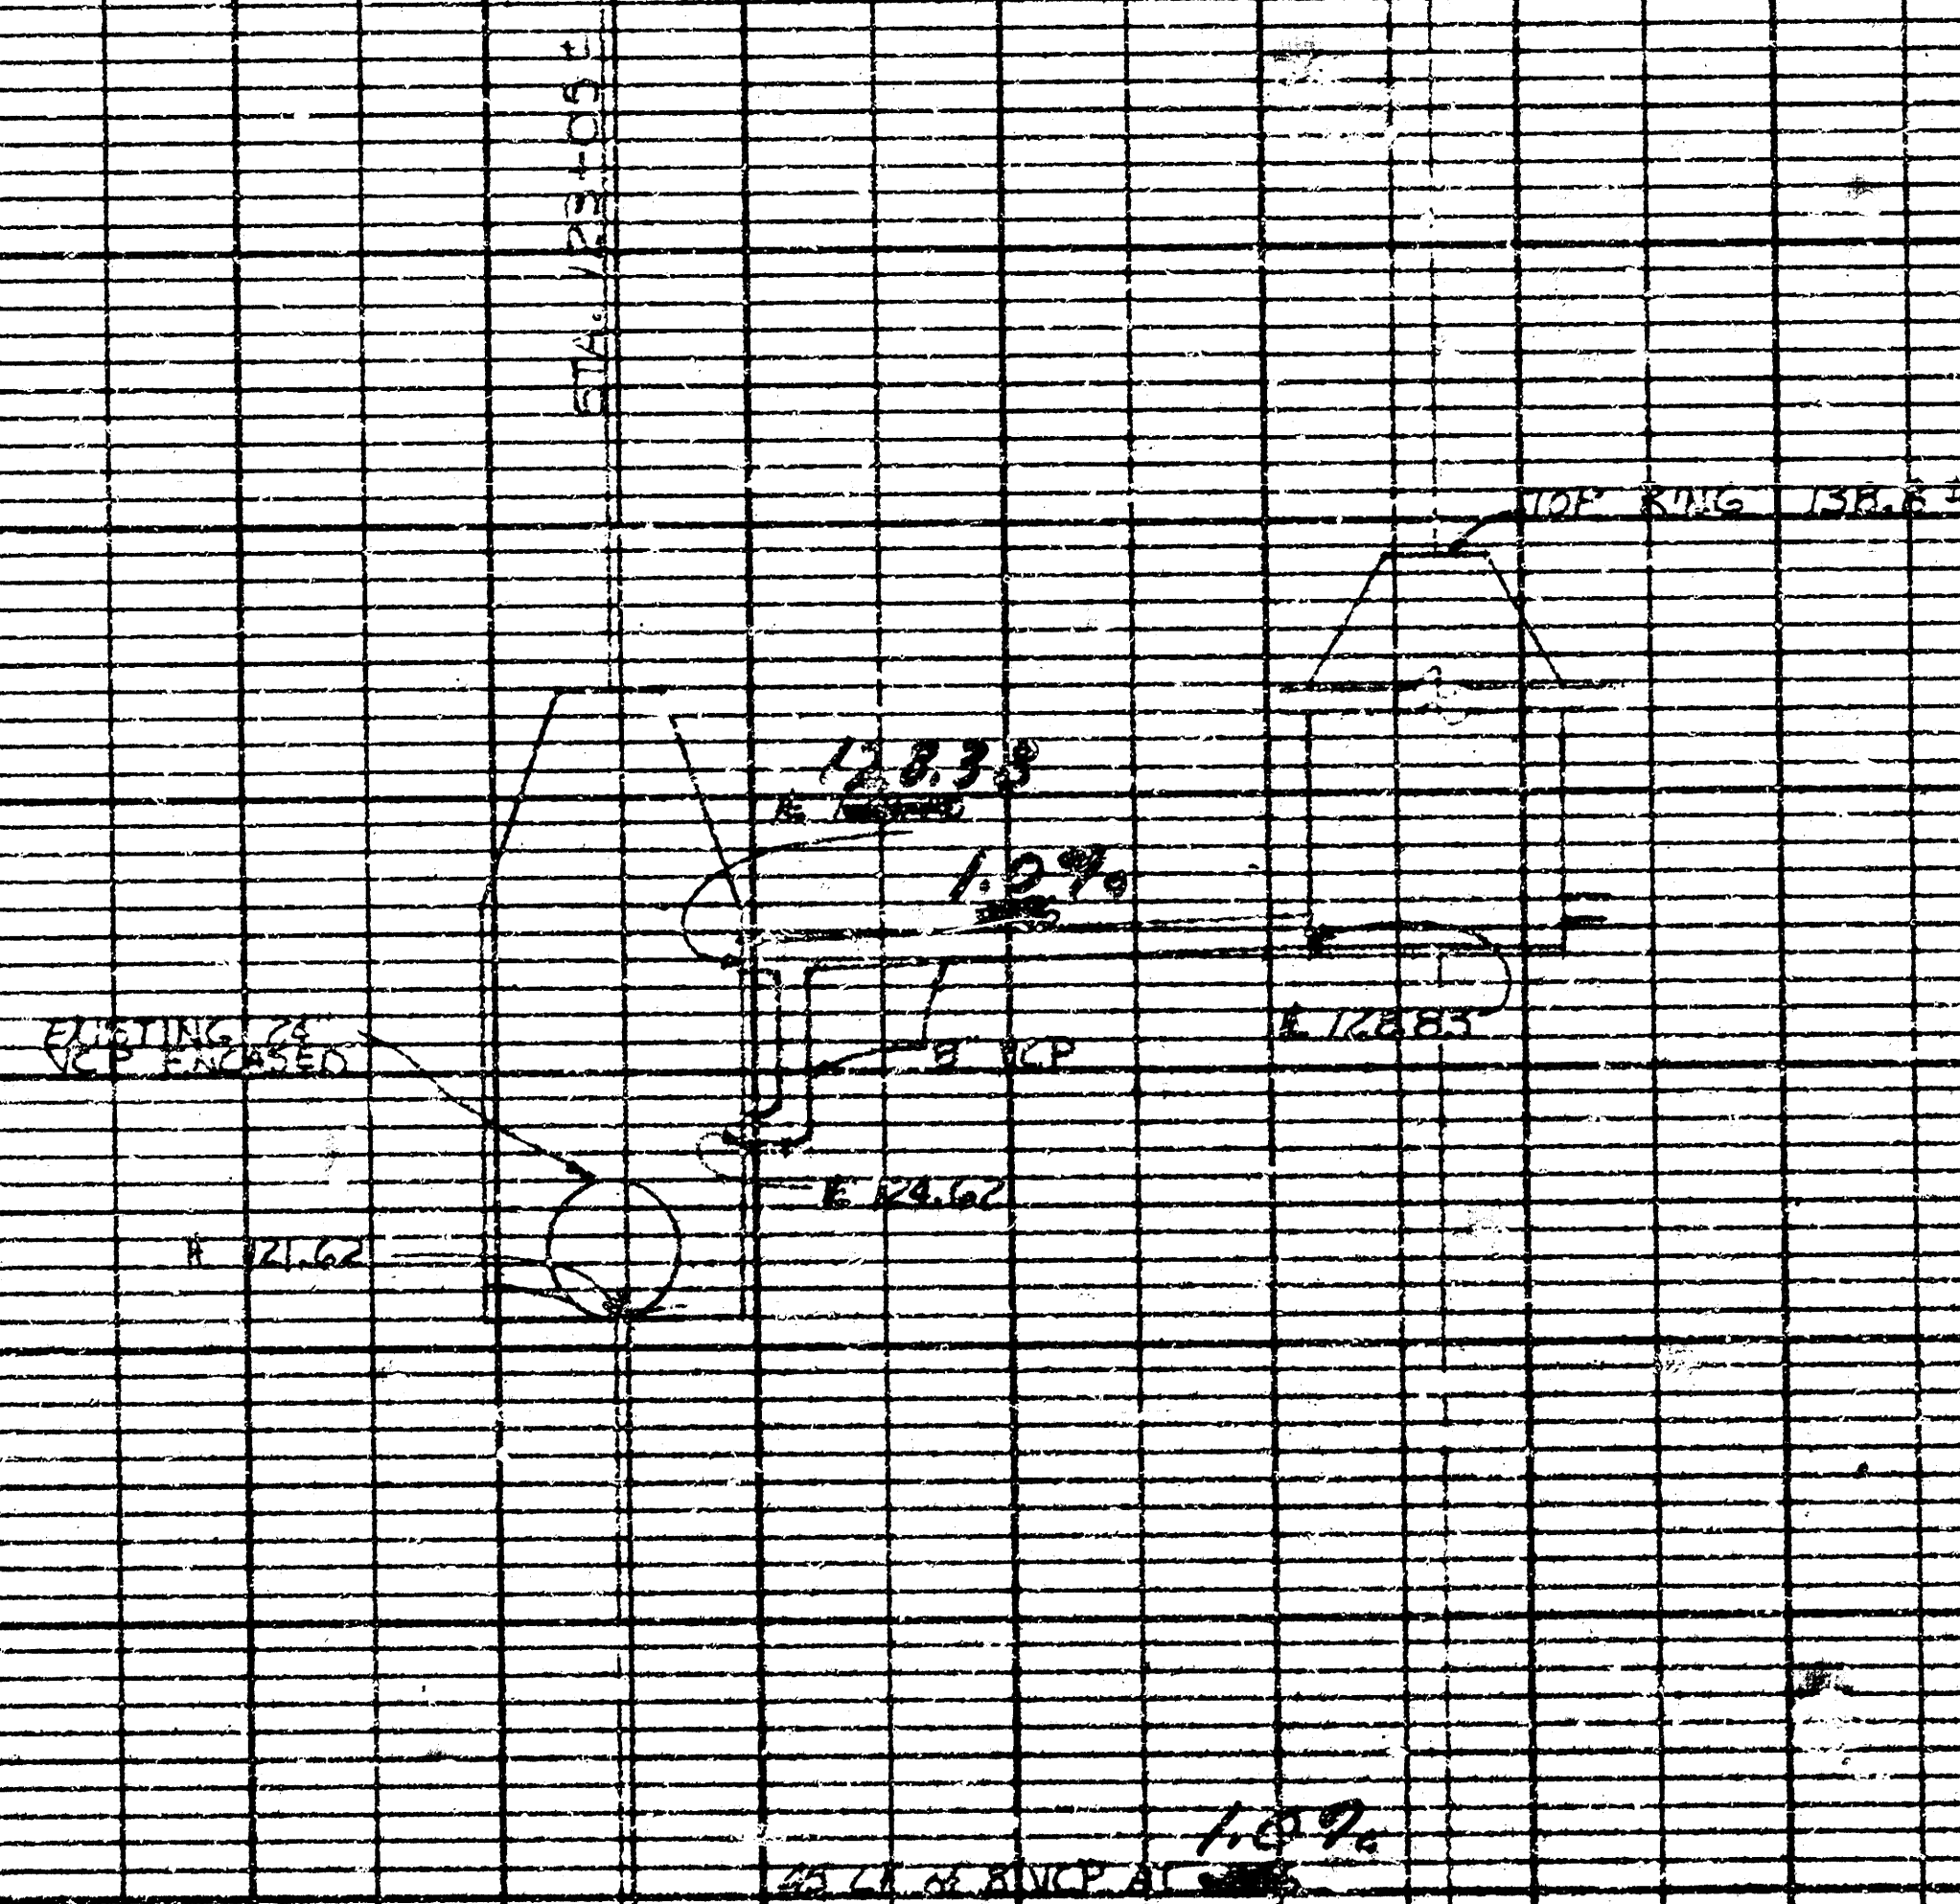

Langland Addn. San. Sewer
 FLOYD LANGLAND
 SANITARY SEWER
 24\"/>

PROJ. NO. DSKW706142