


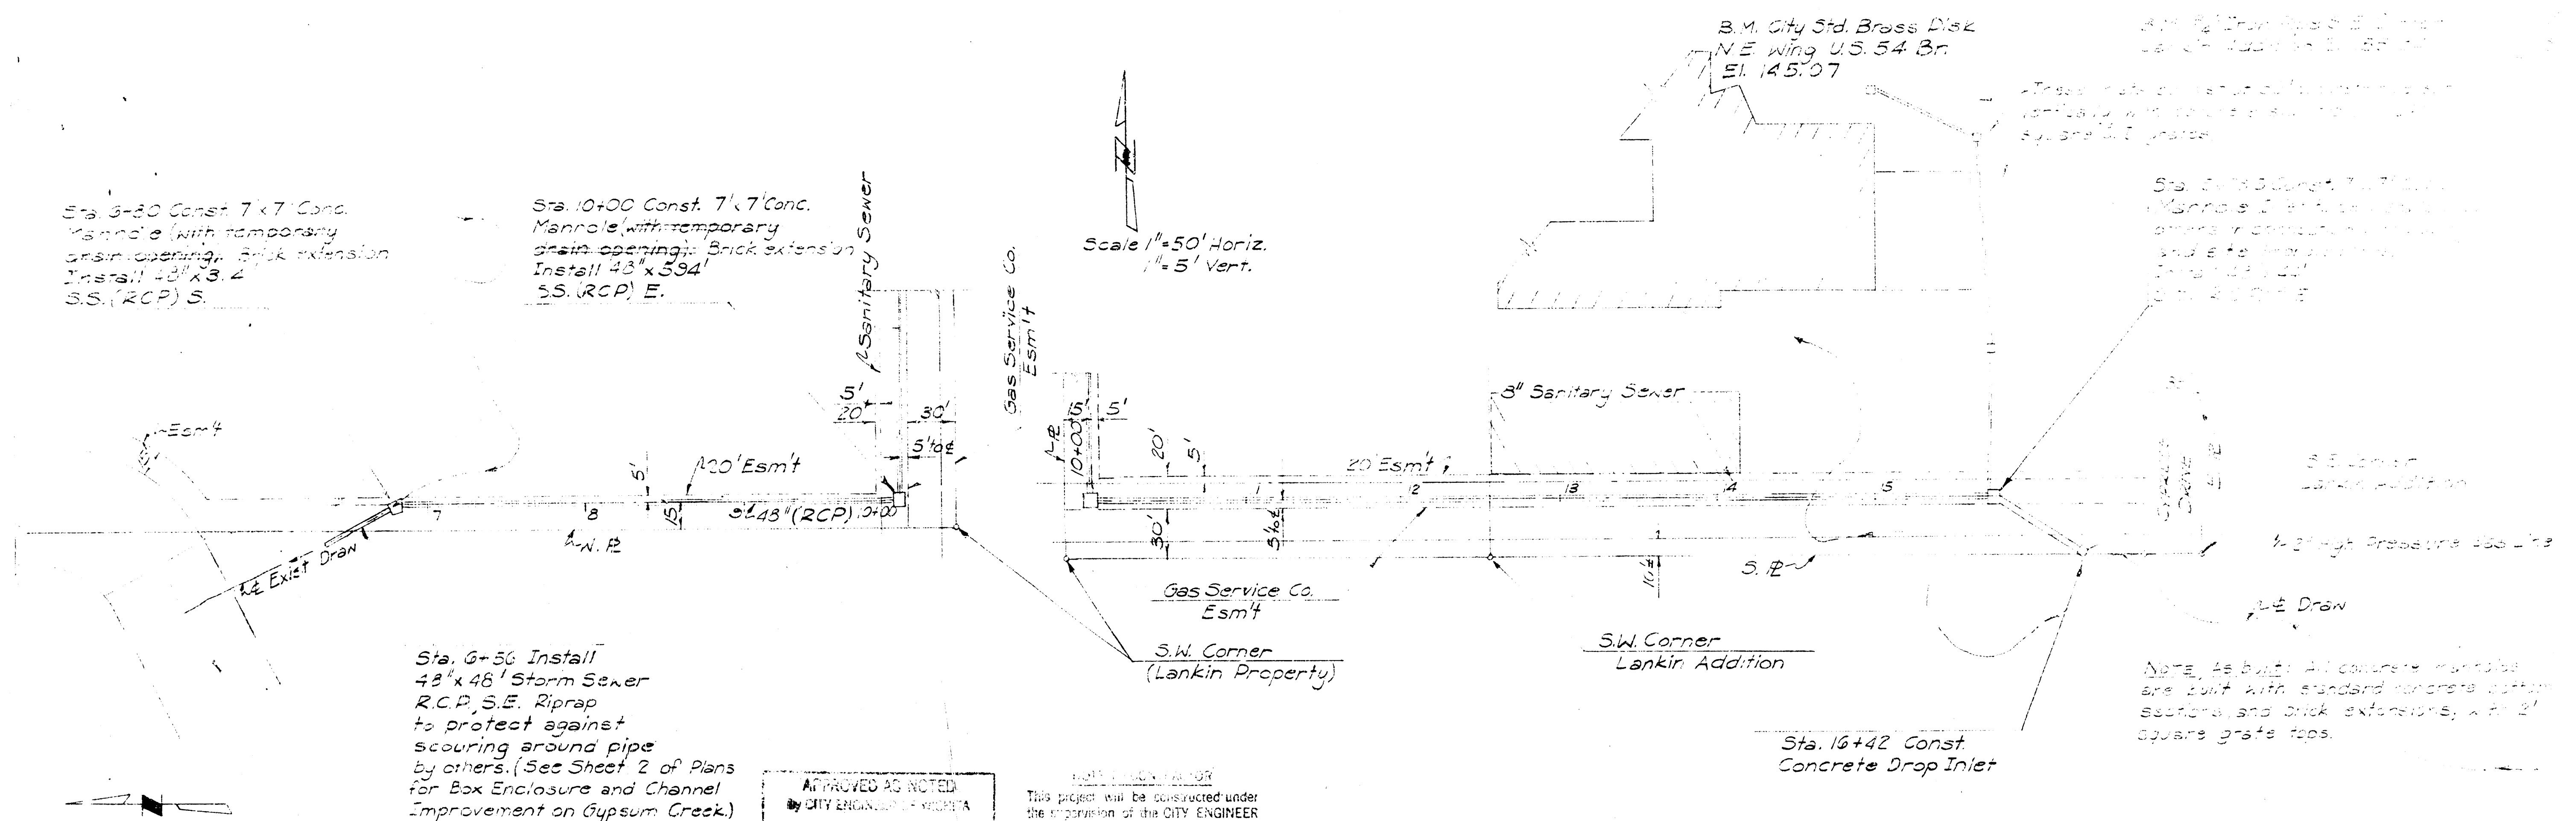


Sta. 6+50 Install 48" x 48" Storm Sewer R.C.P. S.E. Riprap to protect against scouring around pipe by others. (See Sheet 2 of Plans for Box Enclosure and Channel Improvement on Gypsum Creek.)

APPROVED AS NOTED
CITY ENGINEER
Sanitary Sewer
Date: 6/14/69
Signature: [Signature]

NOTED
This project was constructed under the supervision of the CITY ENGINEER and in accordance with the SPECIFICATIONS for Sanitary Sewerage of the City of Wichita, Kansas.


NOTE: Construction to be in accordance with City of Wichita current standard specifications for sewer construction. See Sheet 2 for Standard Manhole Details. See Sheet 3 for details of Special Inlet and temporary openings.

48" STORM SEWER LAYOUT
LANKIN ADDITION
May, 1969
R.S. DELAMATER
CONSULTING ENGINEER
WICHITA, KANSAS

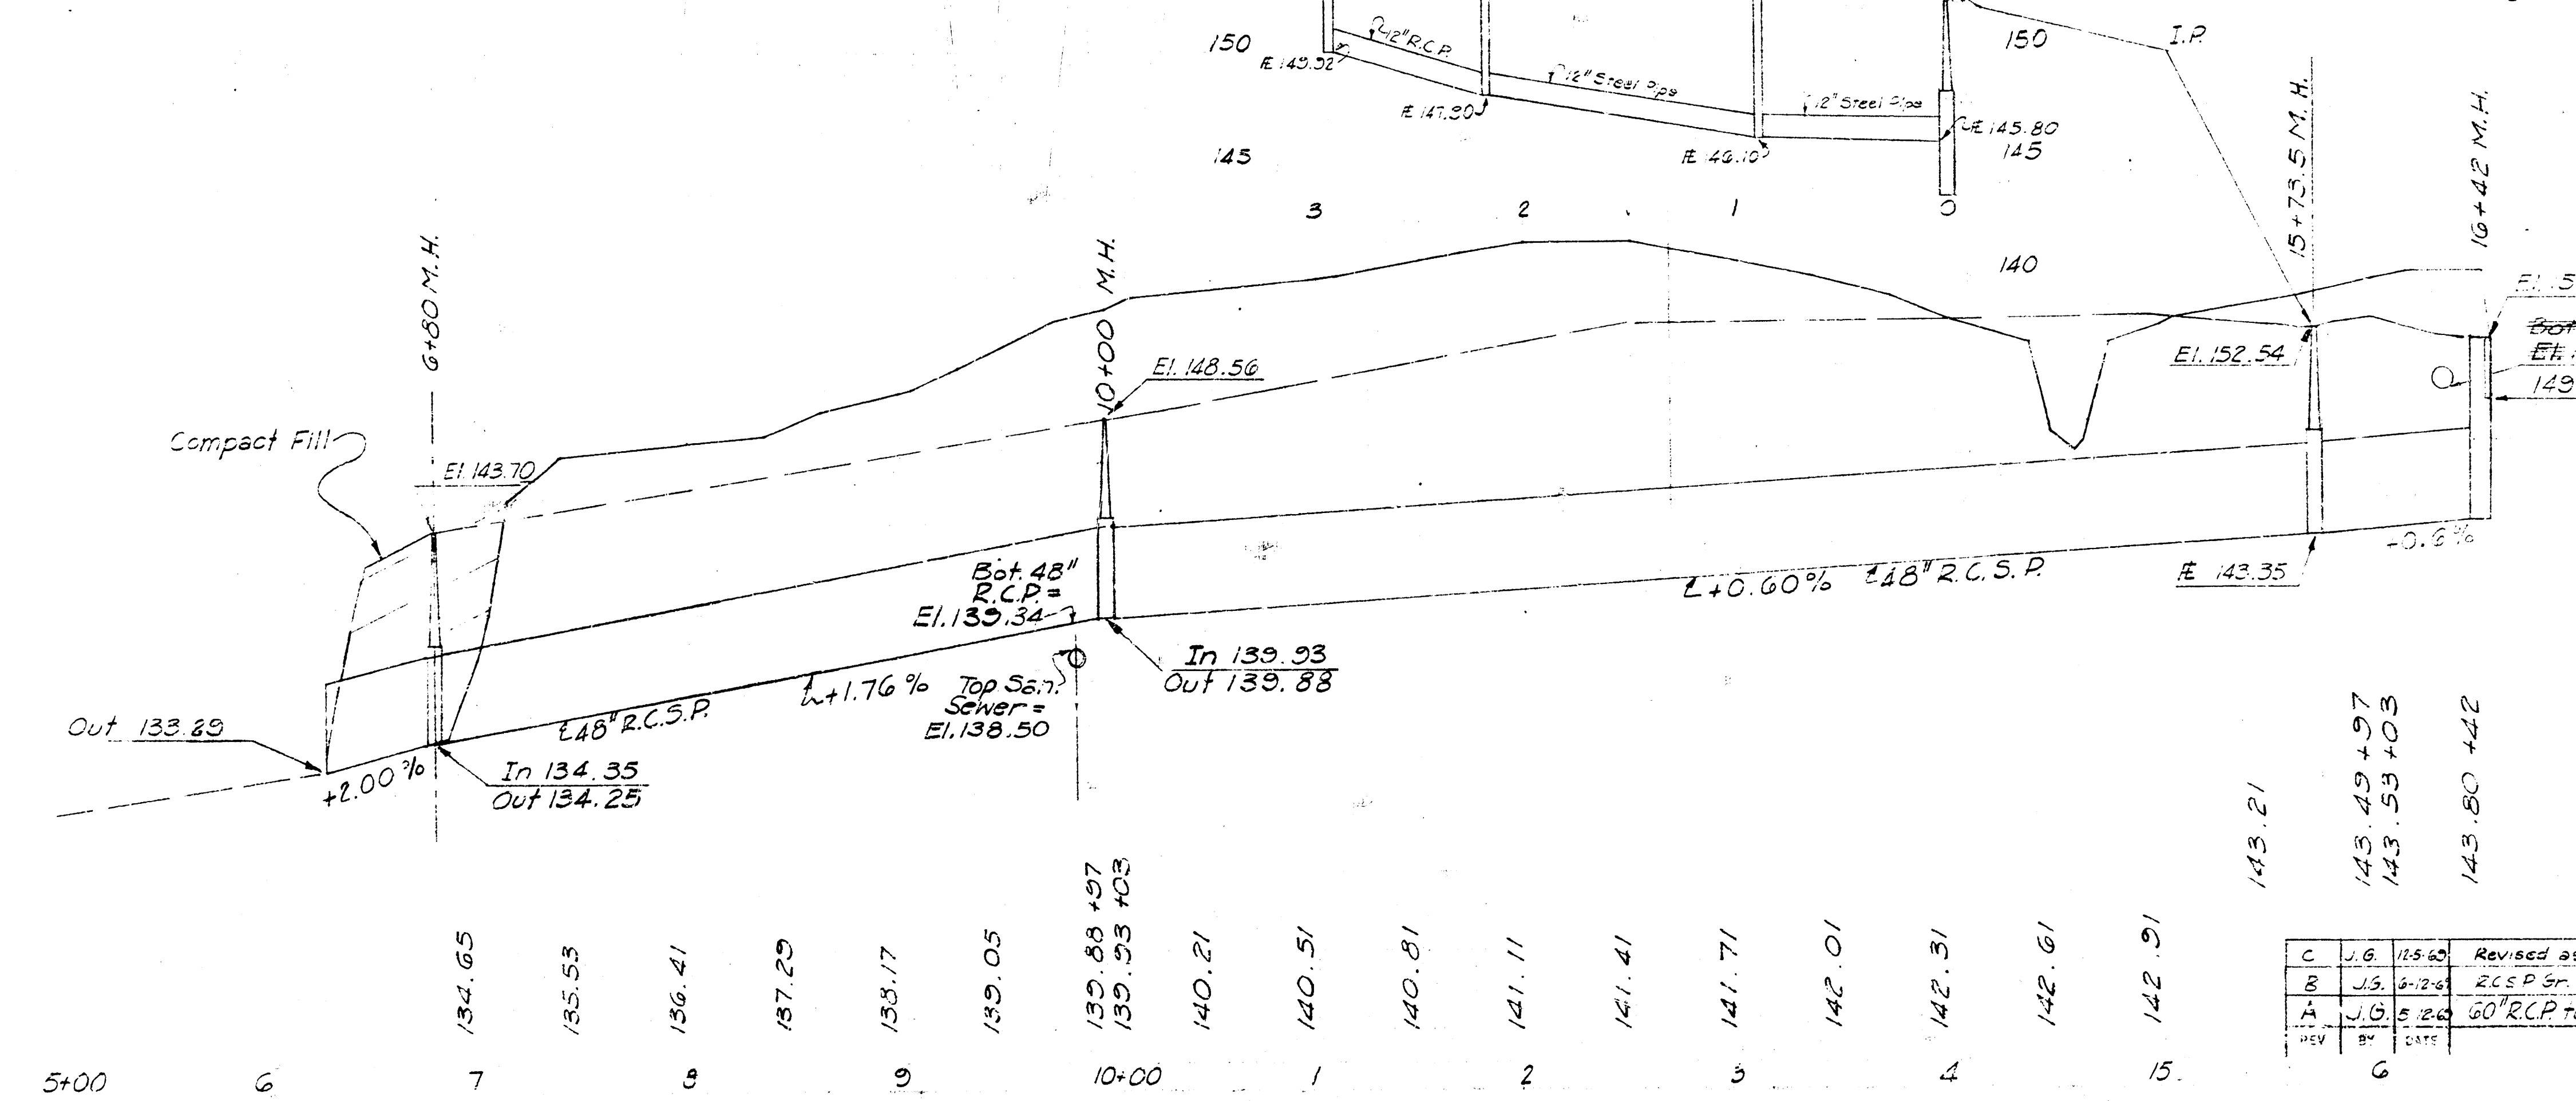

NOTE: As built revisions 12.5-162 are to show changes in the field by others, and do not reflect changes in the plans by the consultant.

REV	DATE	DESCRIPTION
1	6/15/69	Revised as Built
2	6/15/69	20' RCP to 48" Add Inlet
3	6/15/69	48" RCP to 48" Add Inlet
4	6/15/69	48" RCP to 48" Add Inlet
5	6/15/69	48" RCP to 48" Add Inlet
6	6/15/69	48" RCP to 48" Add Inlet

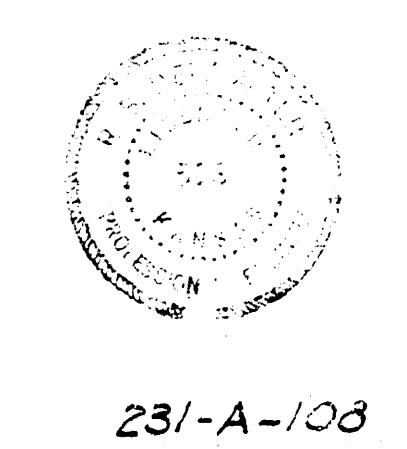

231-A-108

