





Langland Addn.

7-15-76
 APPROVED AS NOTED
 By CITY ENGINEER OF WICHITA
 Sanitary Sewers _____
 Storm Sewers D.E.S.
 Driveway Approaches _____

REGISTERED
 PROFESSIONAL
 ENGINEER
 KANSAS EXERCISE AUTHORITY

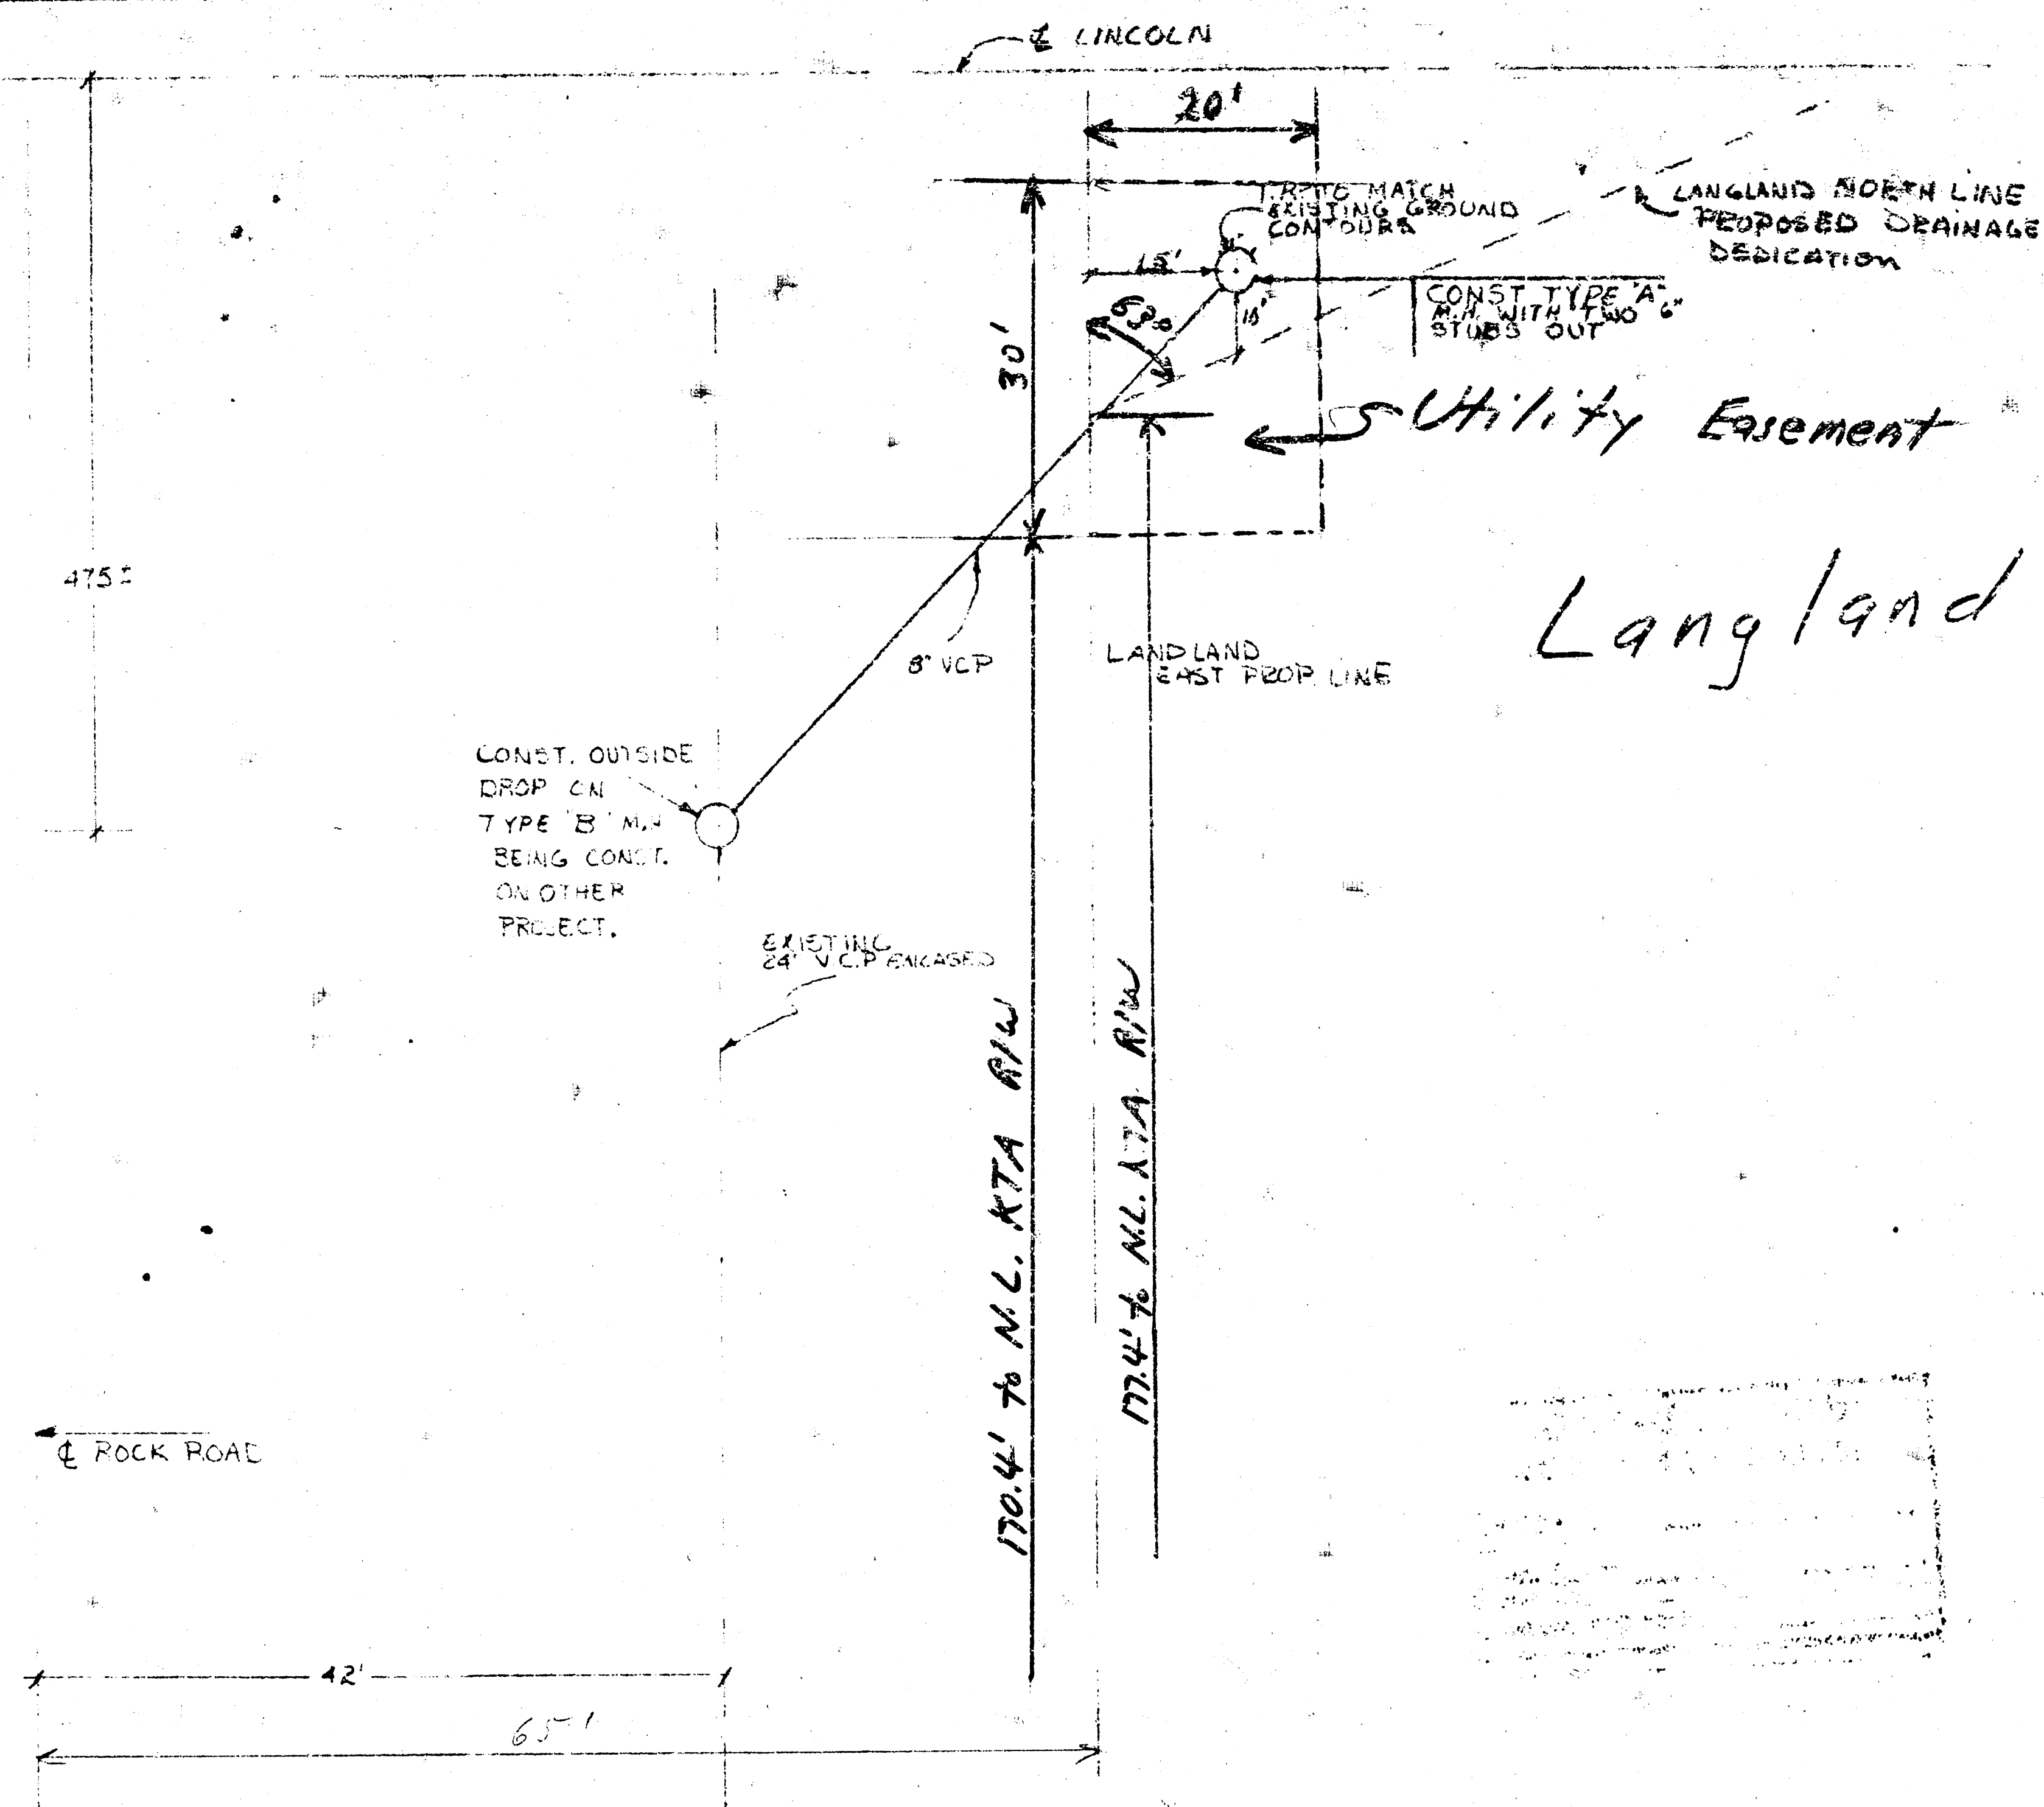

SCALE 1"=40'

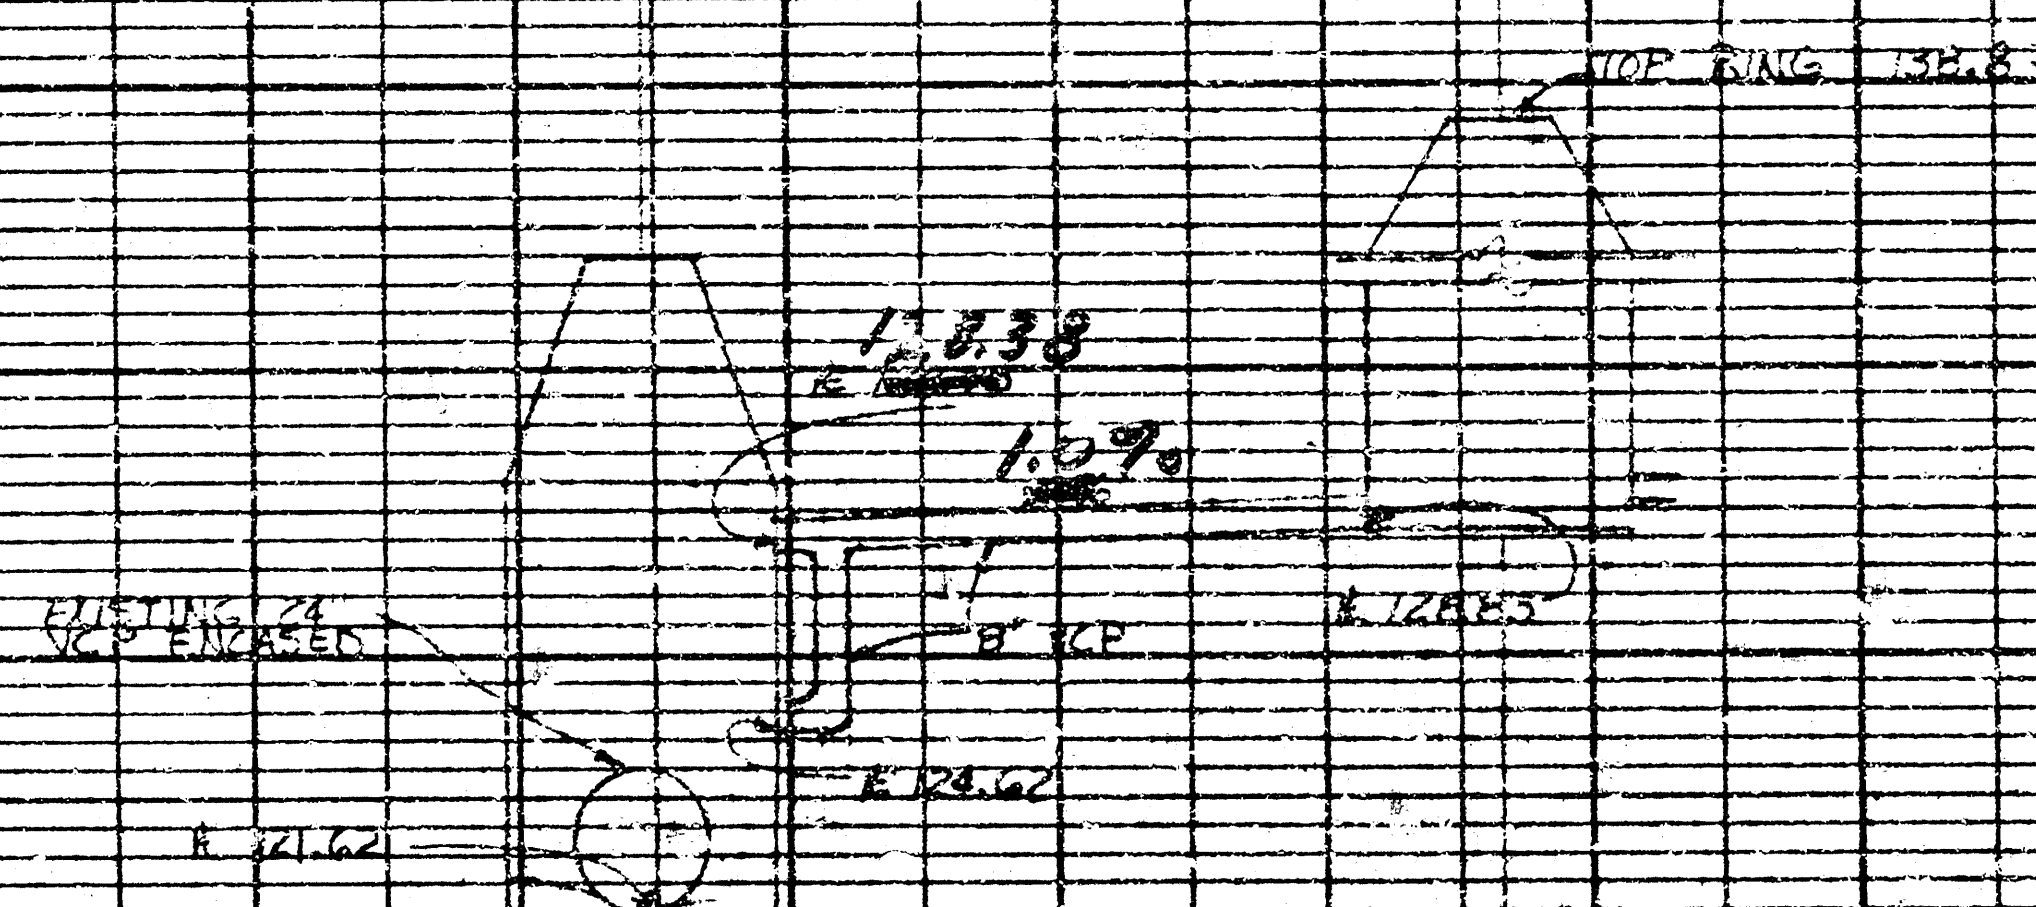

Langland Addn. San. Sewer
 CLOYD LANGLAND
 SANITARY ENGINEER
 300 N. GENESEE ST.
 WICHITA, KANSAS 67201
 PROJECT NO. DSKN 006043