


5'x8' R-280 Const. MH-B
5'x8' R-280 Const. MH-C
5'x8' R-280 Const. MH-D

NOTES
 1. Manholes to be City of Wichita Standard Manhole Type 18" R-280
 2. Manholes and Sewer Lines to be constructed in accordance with City of Wichita Sewer Standards for these items.

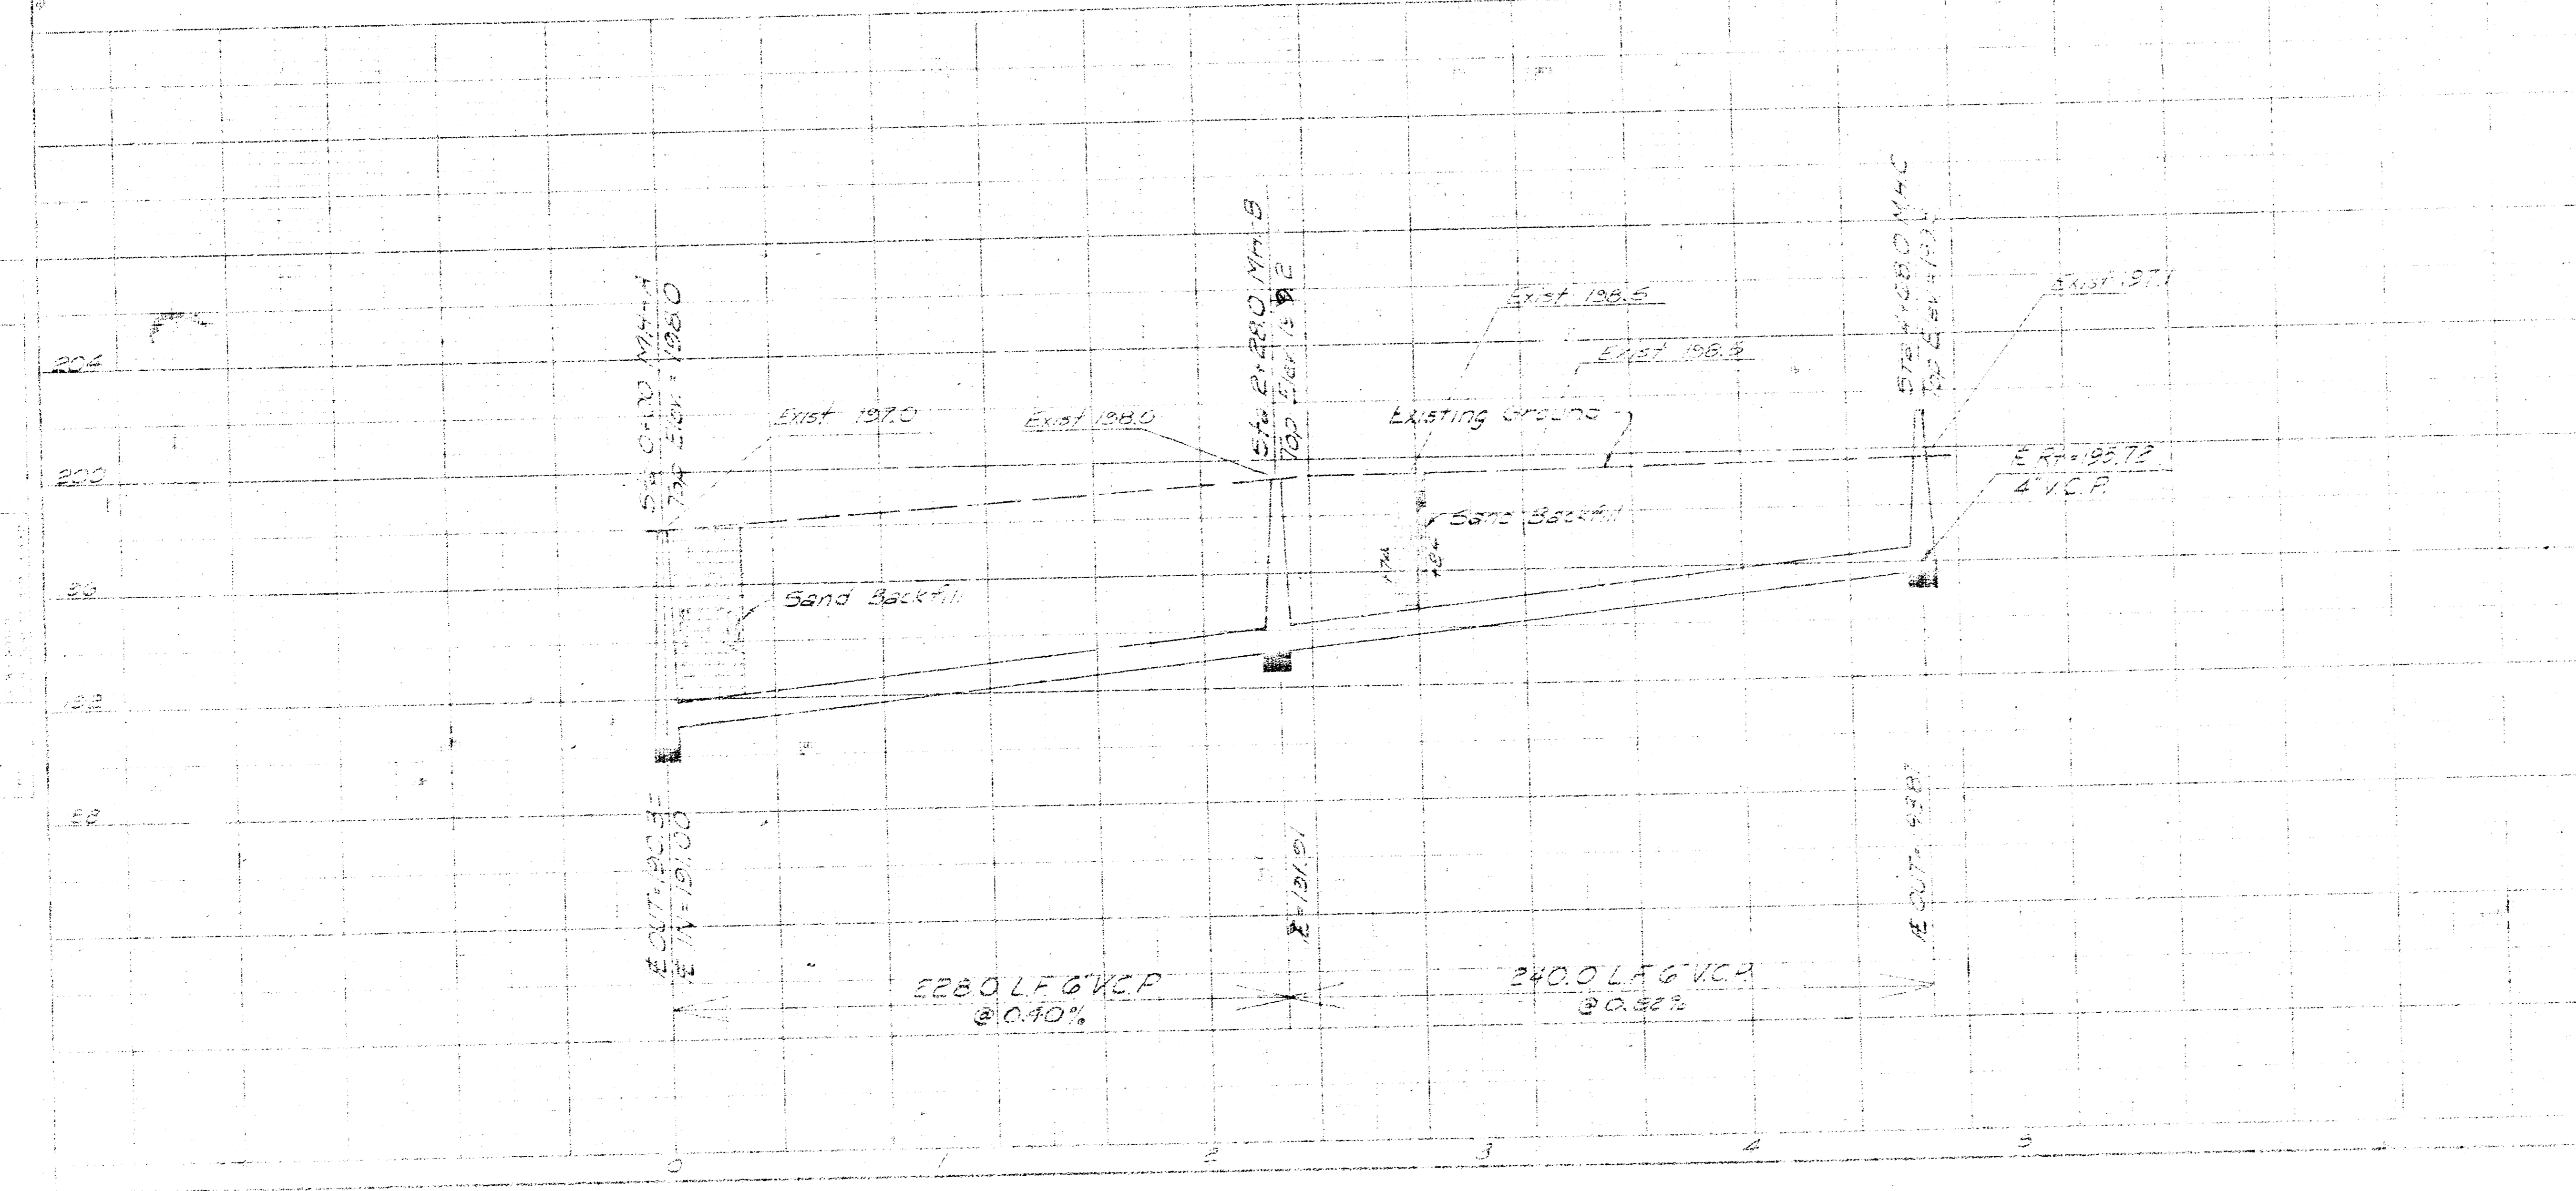

"As Built" Booked on J-148

WICHITA STATE UNIVERSITY
 LANSLOWNE HOUSE
 SEWER REPLACEMENT

6-22-79

City No. No.
 BHK 503040