



PLAN
 SURVEYED
 APPROVED
 BY
 DATE
 NO. OF SAY CHANGES
 NO. OF SAY CHANGES
 NO. OF SAY CHANGES

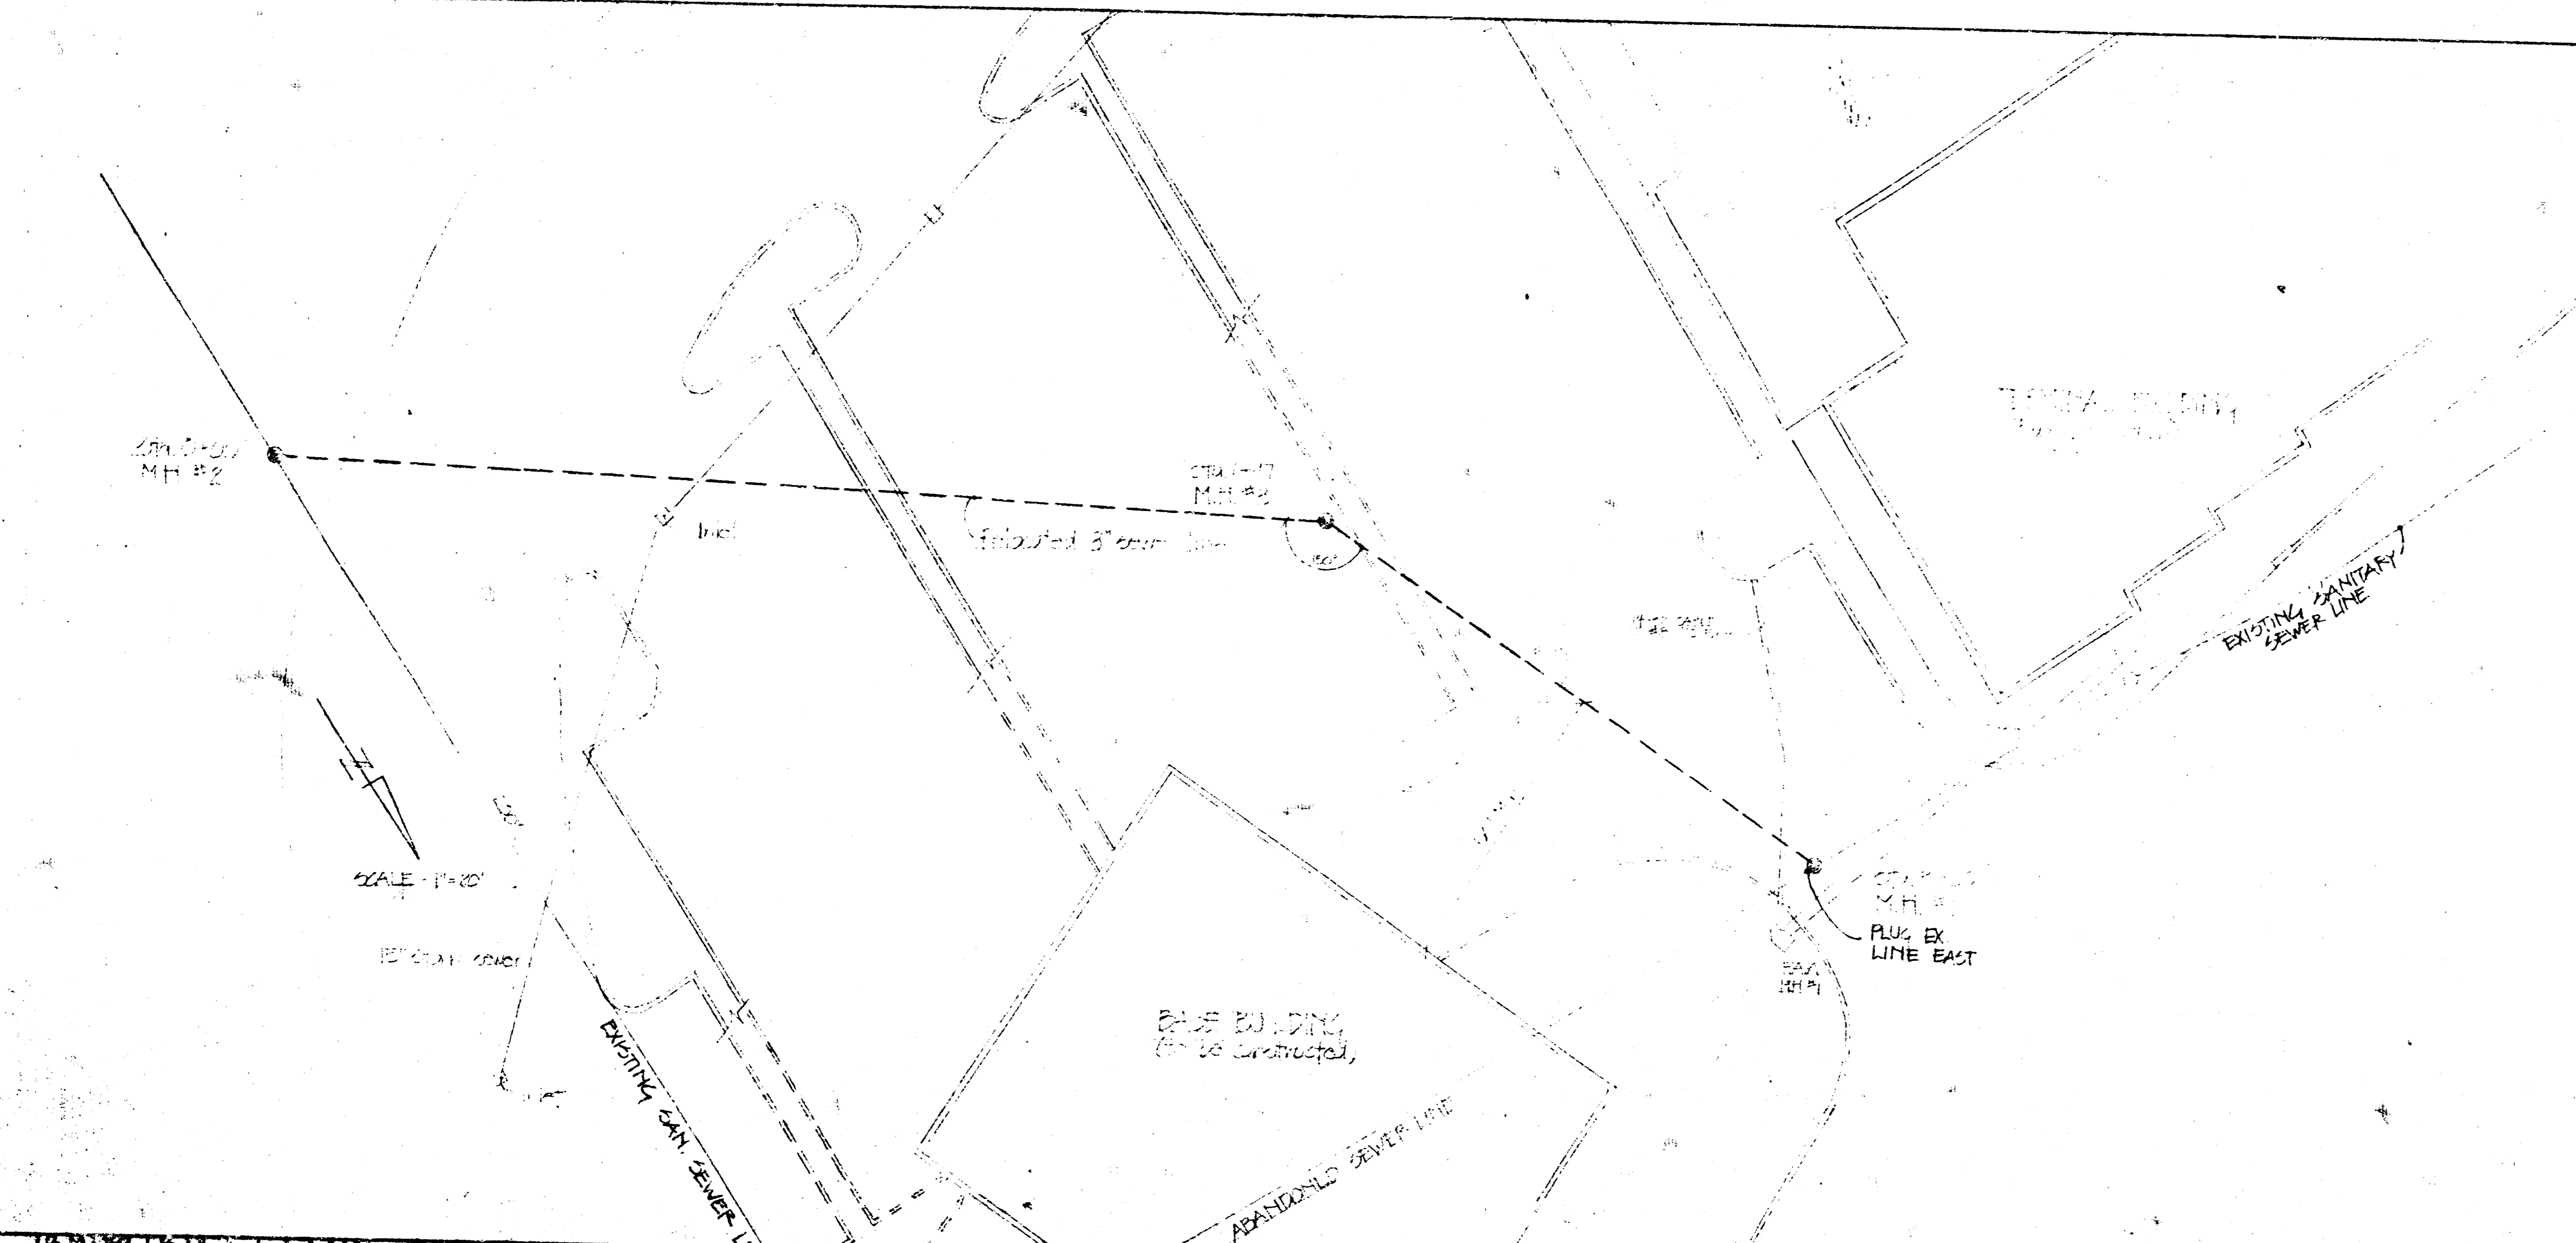


8-1-80
 APPROVED AS NOTED
 BY CITY ENGINEER OF WICHITA
 Sanitary Sewers *PLD*
 Storm Sewers _____
 Driveway Approaches _____

NOTE TO CONTRACTOR
 This project will be constructed under the supervision of the CITY ENGINEER and conforming to the SPECIFICATIONS of the CITY OF WICHITA. The CONTRACTOR will reimburse the City of Wichita for all cost of _____ and Inspection.

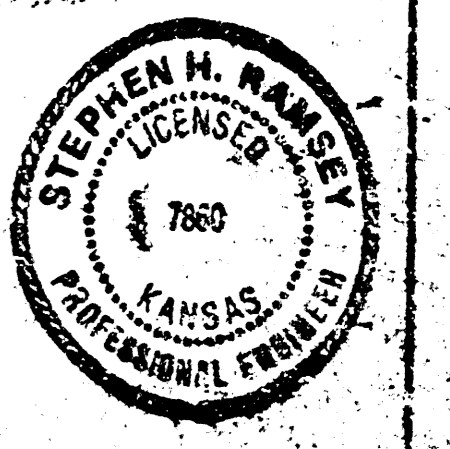

PROFILE
 SURVEYED
 APPROVED
 BY
 DATE
 NO. OF SAY CHANGES
 NO. OF SAY CHANGES
 NO. OF SAY CHANGES

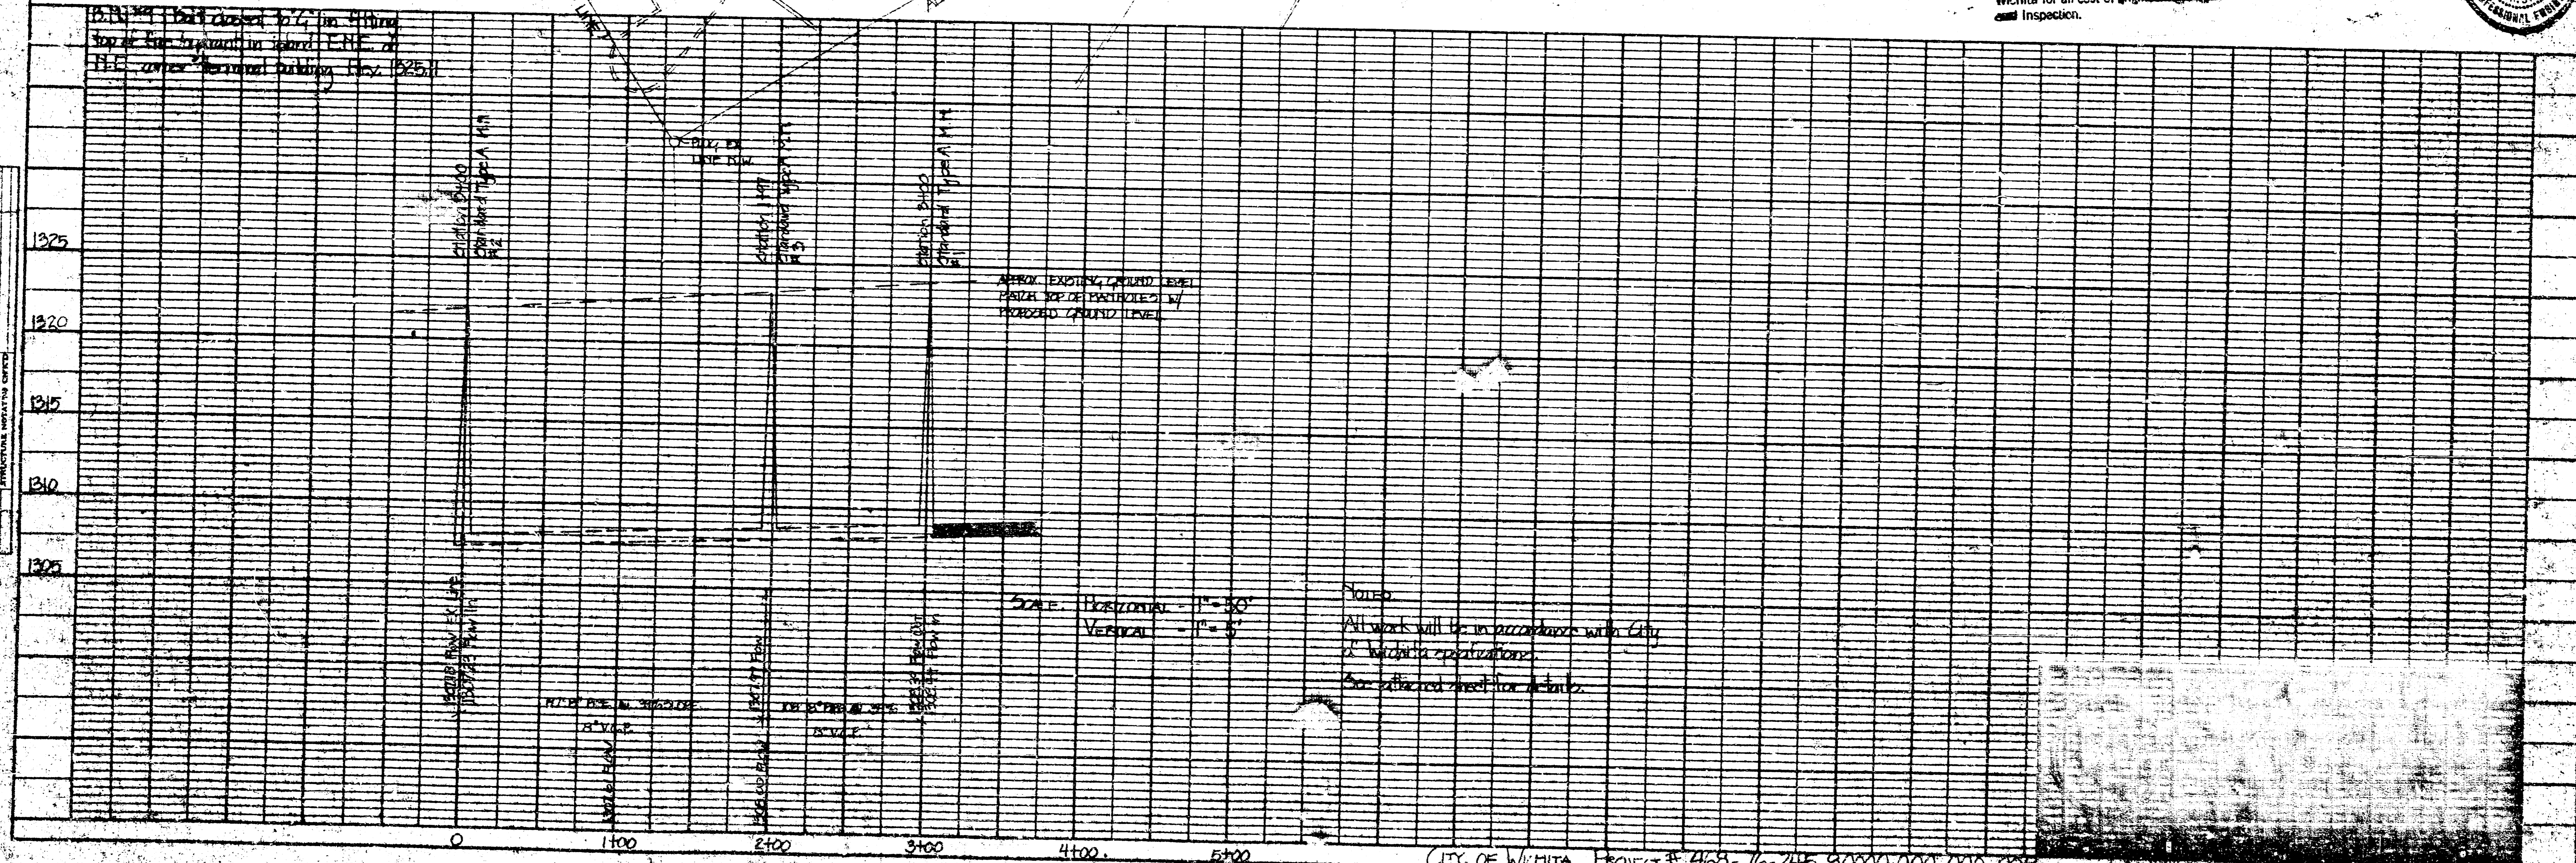

Notes
 All work will be in accordance with City of Wichita specifications.
 See attached specification details.

PLATE I - PLAN, PROFILE - F.A.S.
 CLEARPRINT PAPER CO., S.F. CAL.
 NO. 10011

CITY OF WICHITA PROJECT # 468-16-745-80000-000-000-008

17 5 1 150

FILED FROM THE BEST
 AVAILABLE COPY