

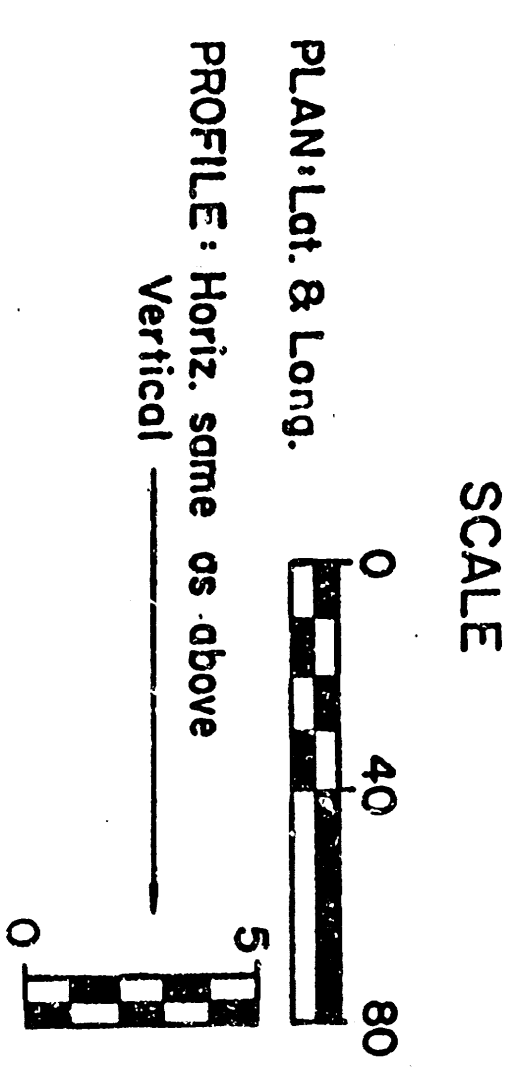
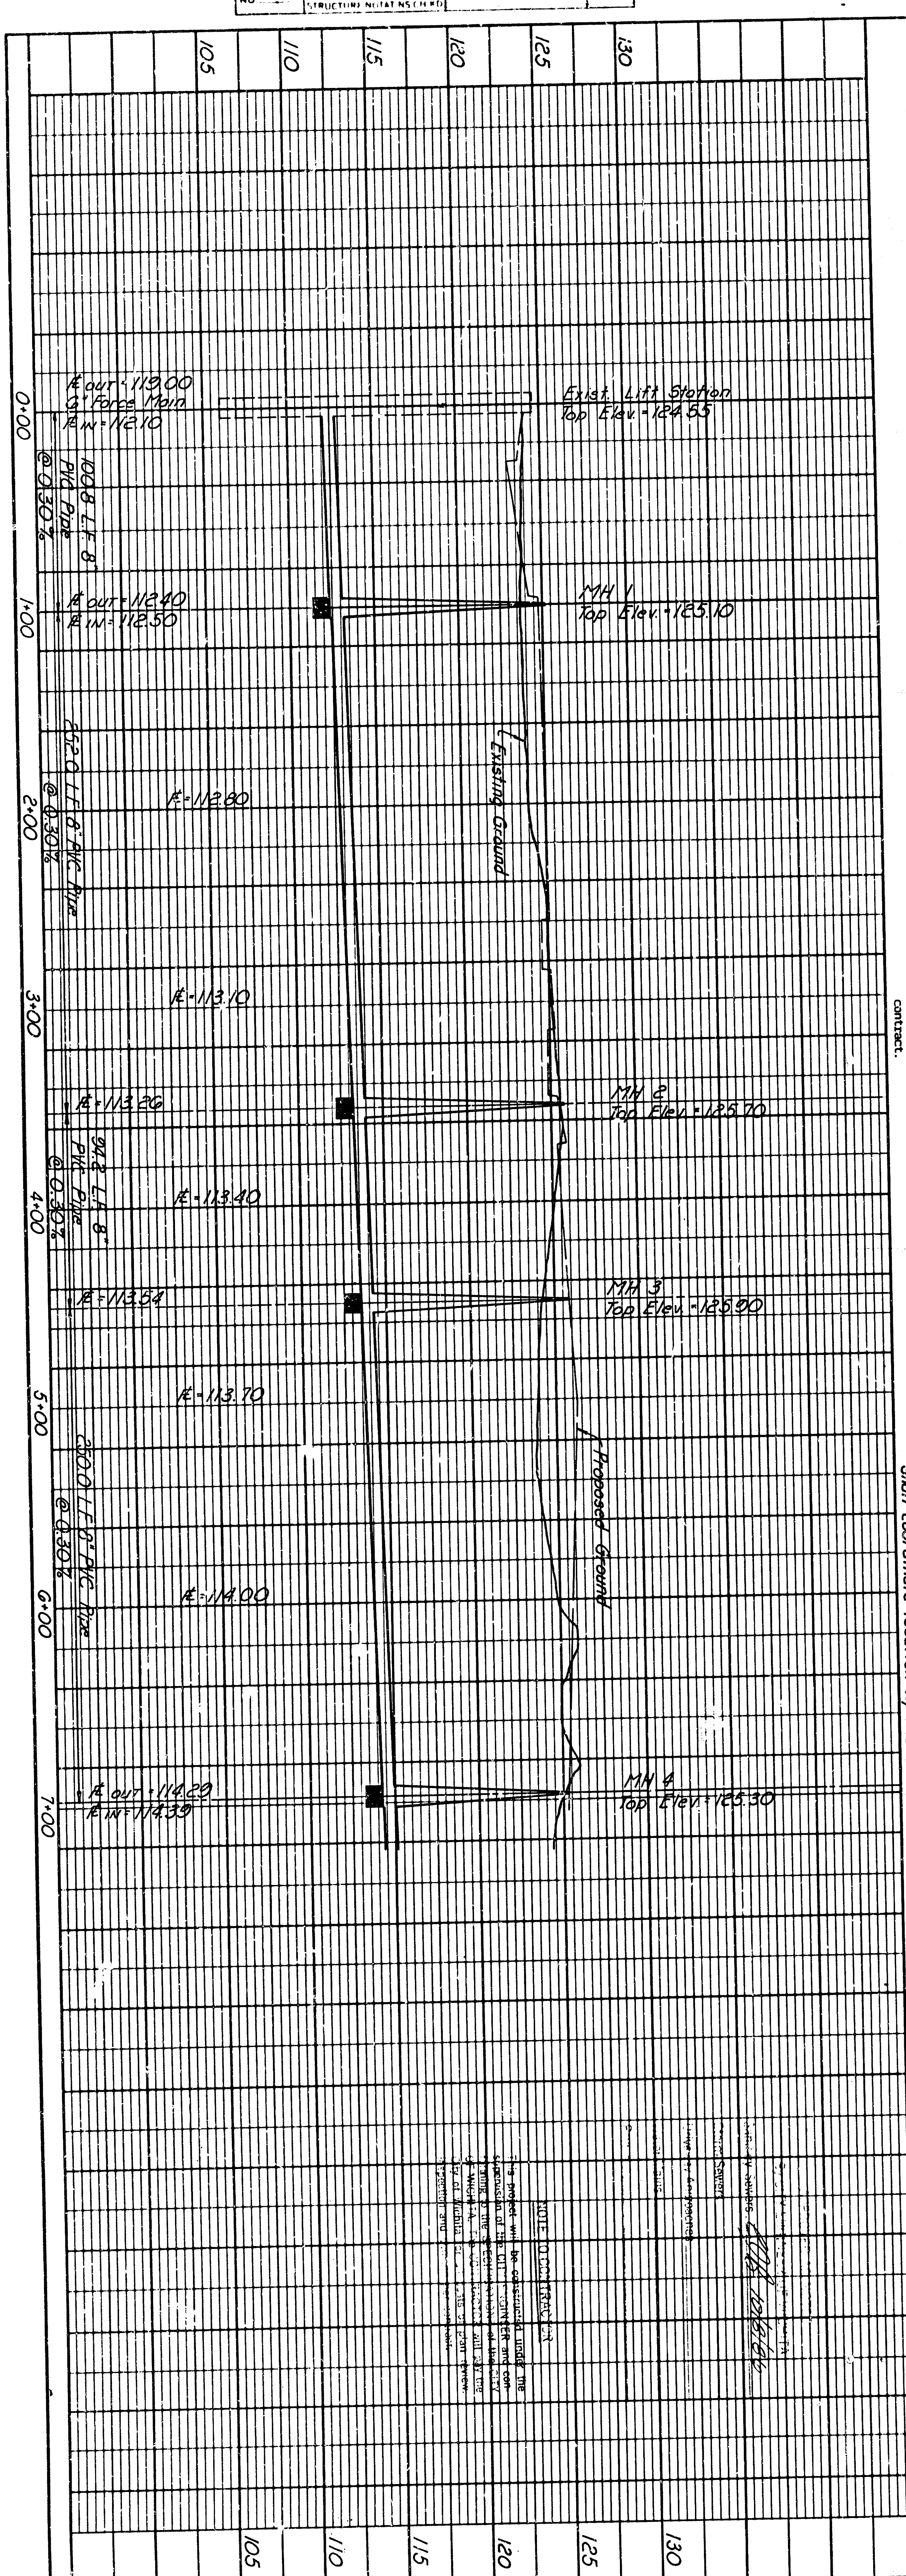


PLAN	SURVEYED	BY	DATE
NO. 1004	NOTED		
	ALIGNMENT CHECKED		
	RT. OF WAY CHECKED		

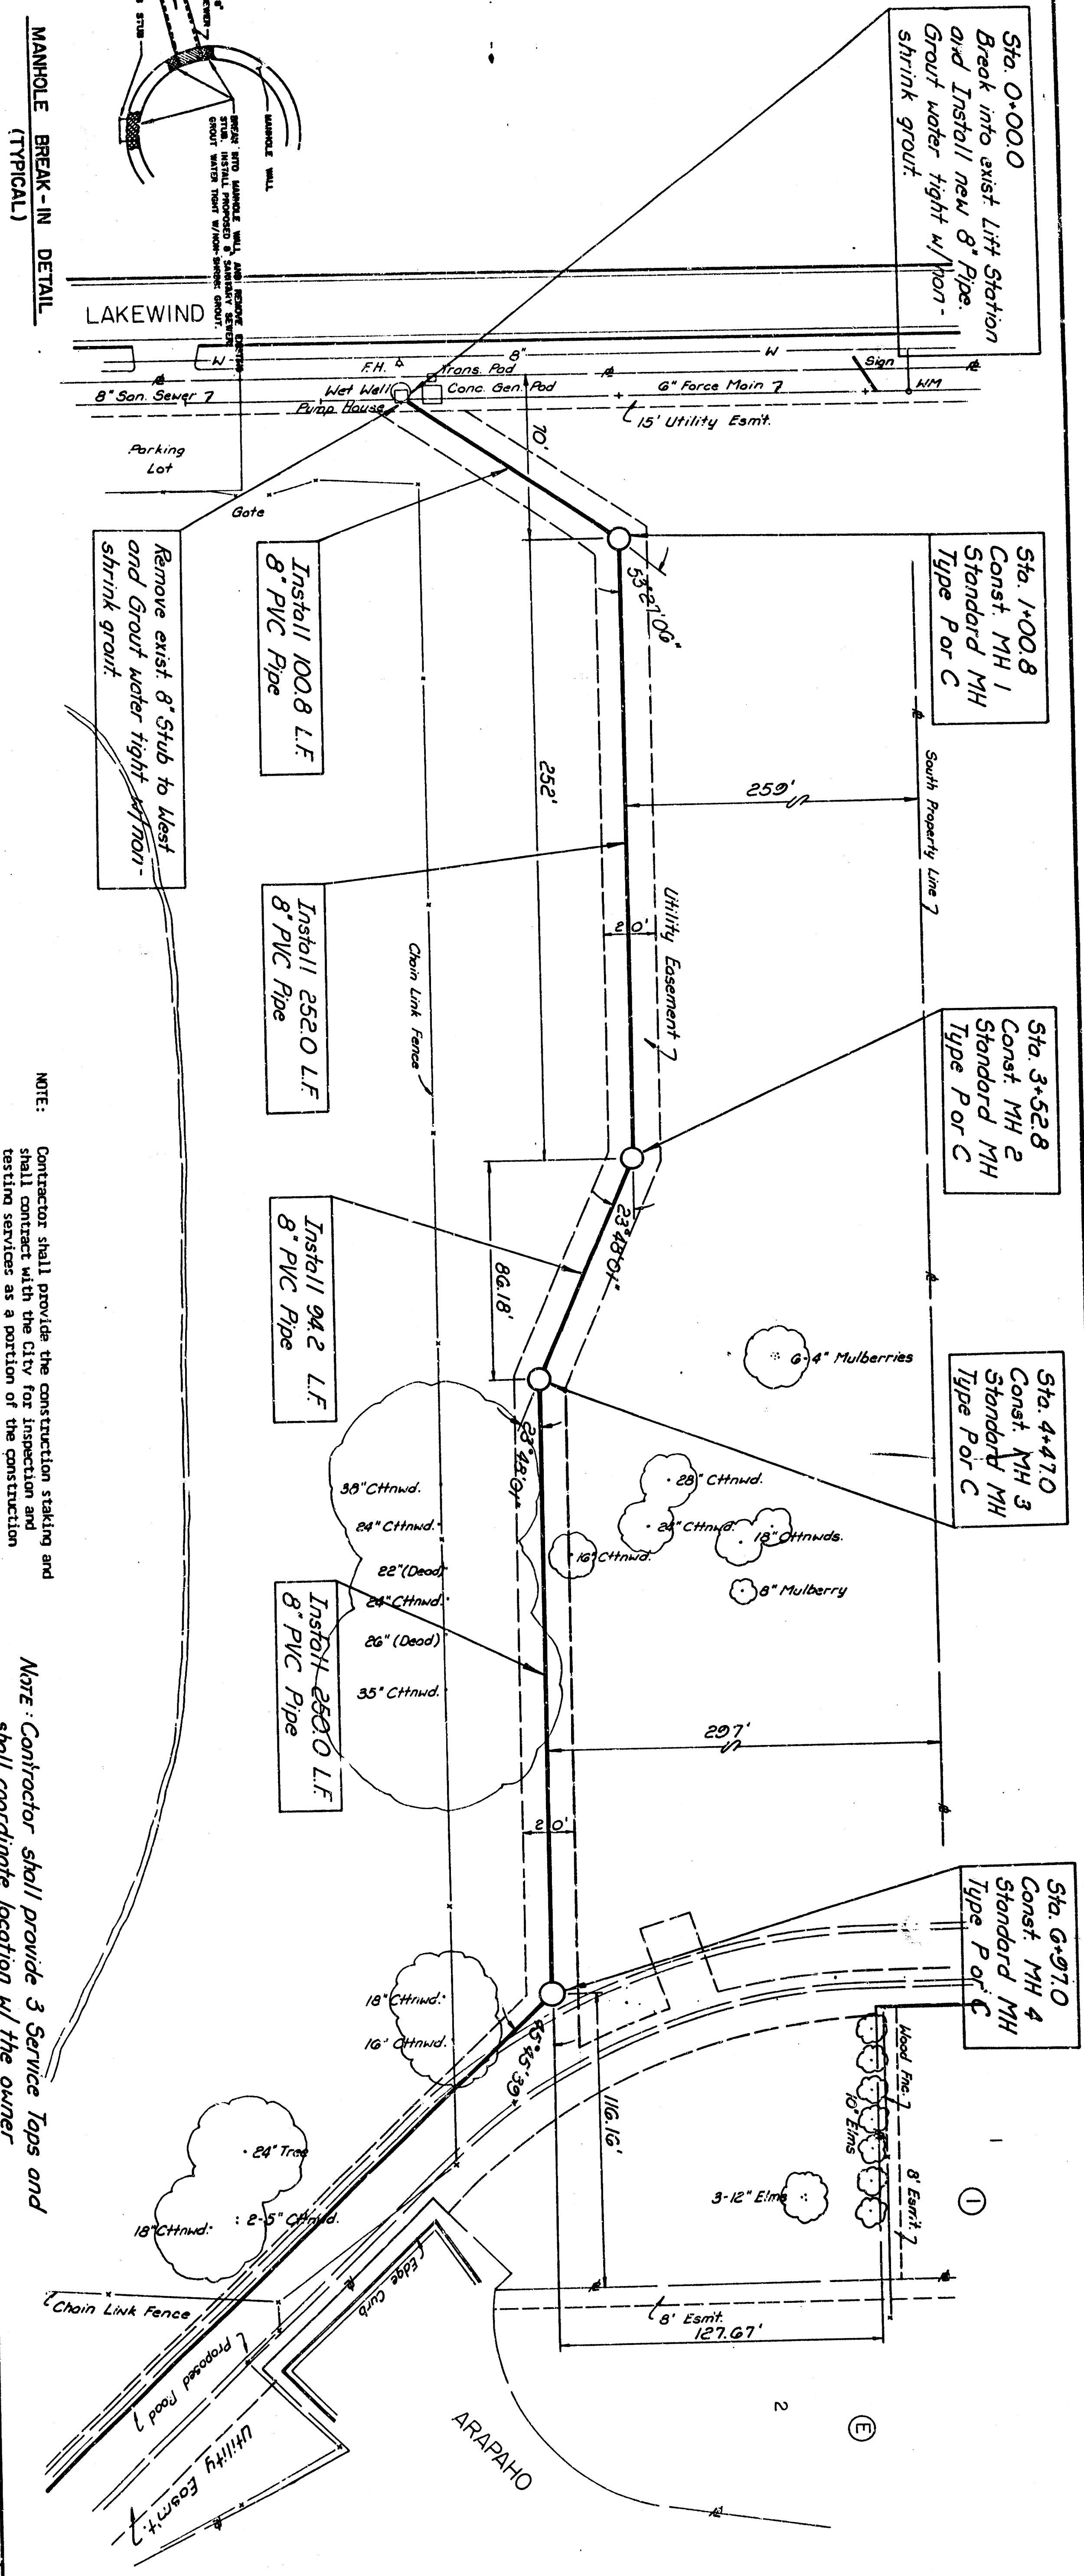



PROFESSIONAL ENGINEERING CONSULTANTS, P.A.
 ENGINEERS
 WICHITA, KANSAS
 CITY OF WICHITA, KANSAS
 MICHAEL E. LINDEBAK P.E., CITY ENGINEER
 SANITARY SEWER IMPROVEMENTS
LINE NO. 1
 MILES LAKEWOOD LIVING NURSING CENTER
 C.O.W. No. 468-76-245-80001-000-000-075

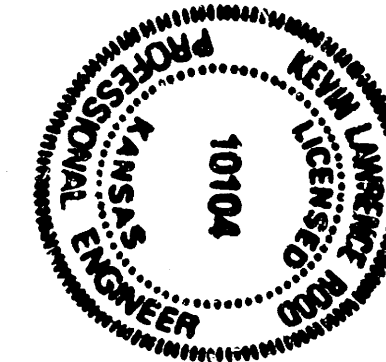

PLAN	SURVEYED	DATE
	NOTED	BY
NOTE BOOK	ALIGNED CHECKED	
	RT OF WAY CHECKED	
NO.		

PROFILE	SURVEYED	DATE
	NOTED	BY
NOTE BOOK	ALIGNED CHECKED	
	STRUCTURE NOTING CHECKED	
NO.		




Bench Mark: Northwest corner of concrete porch at 906 Arapaho. Elev. = 125.94

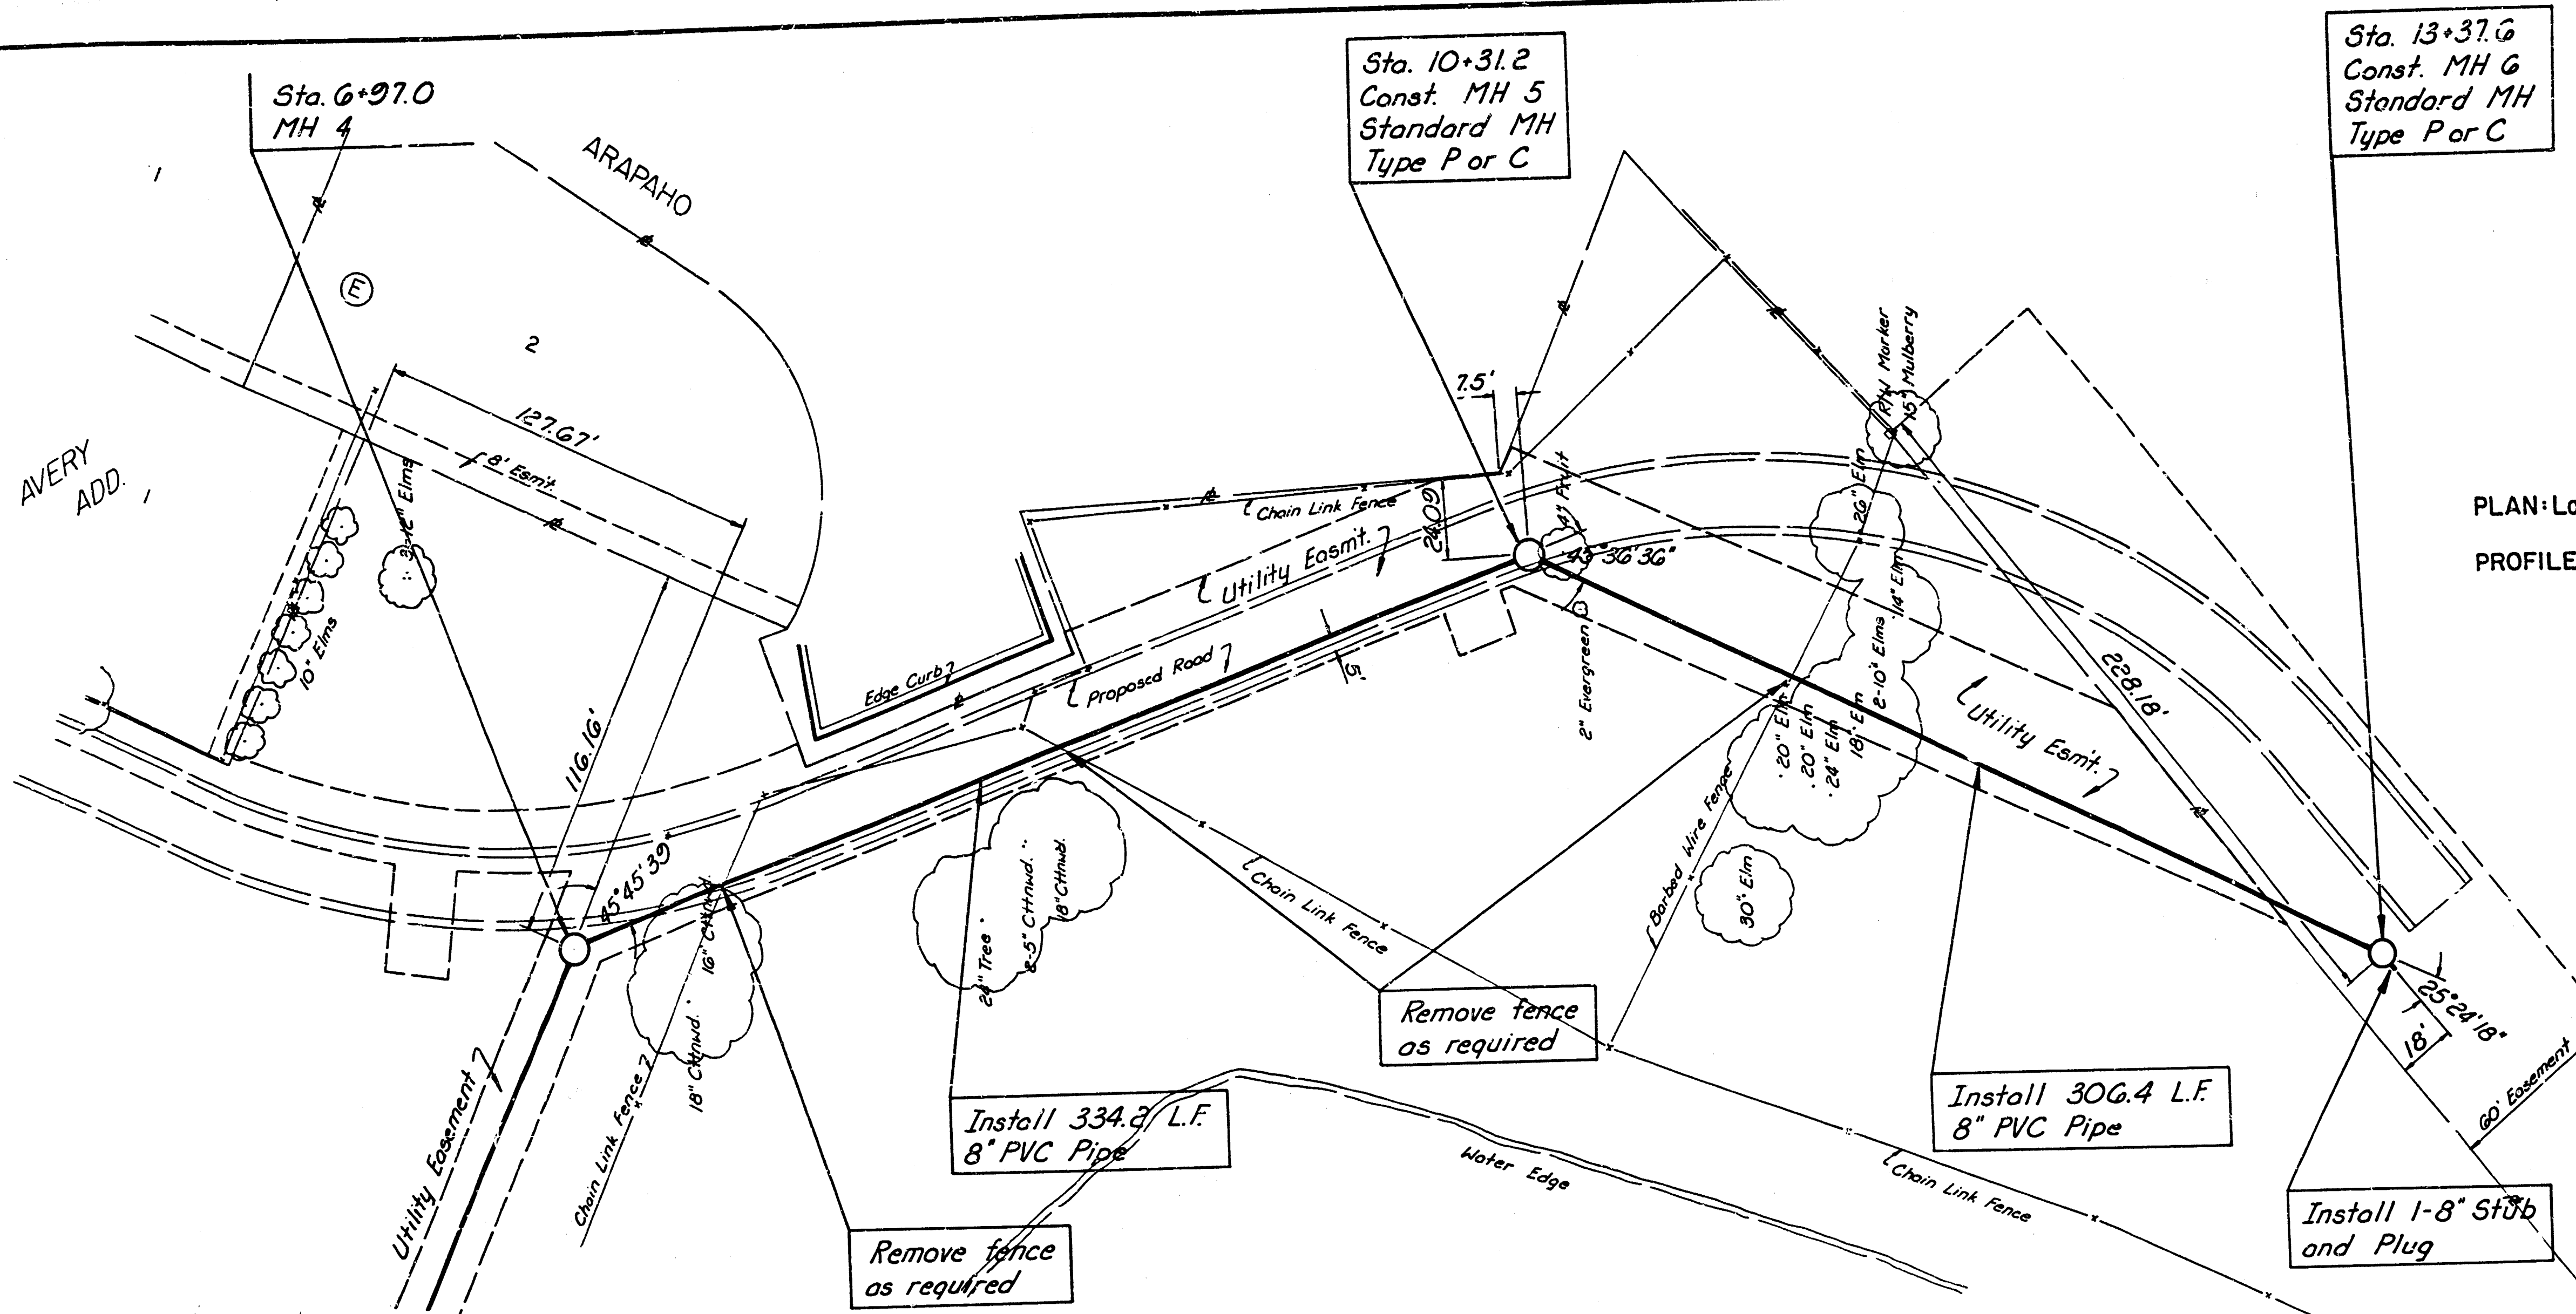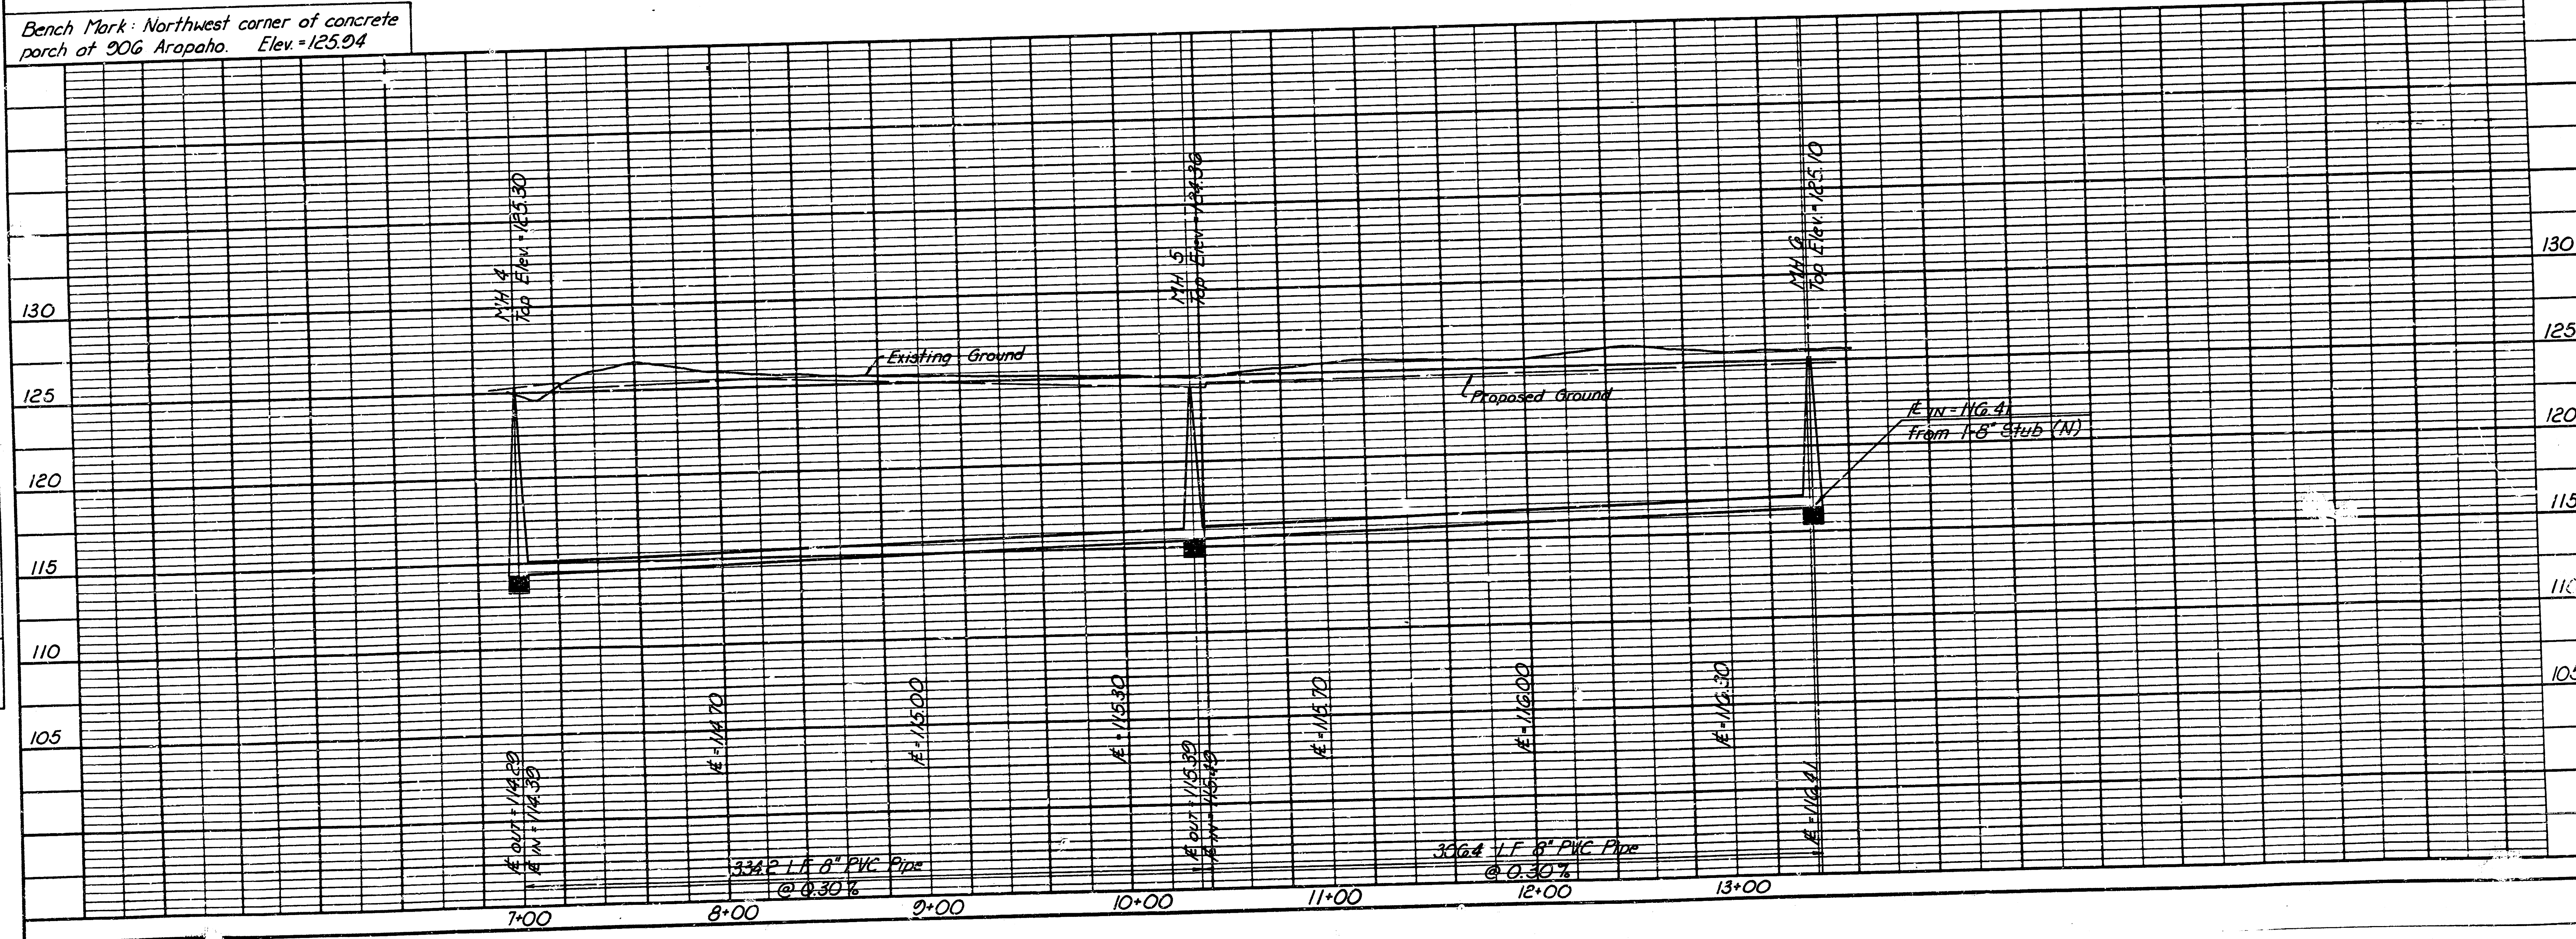

PLAN: Lot. & Long.

PROFILE: Horiz. same as above
Vertical

SCALE

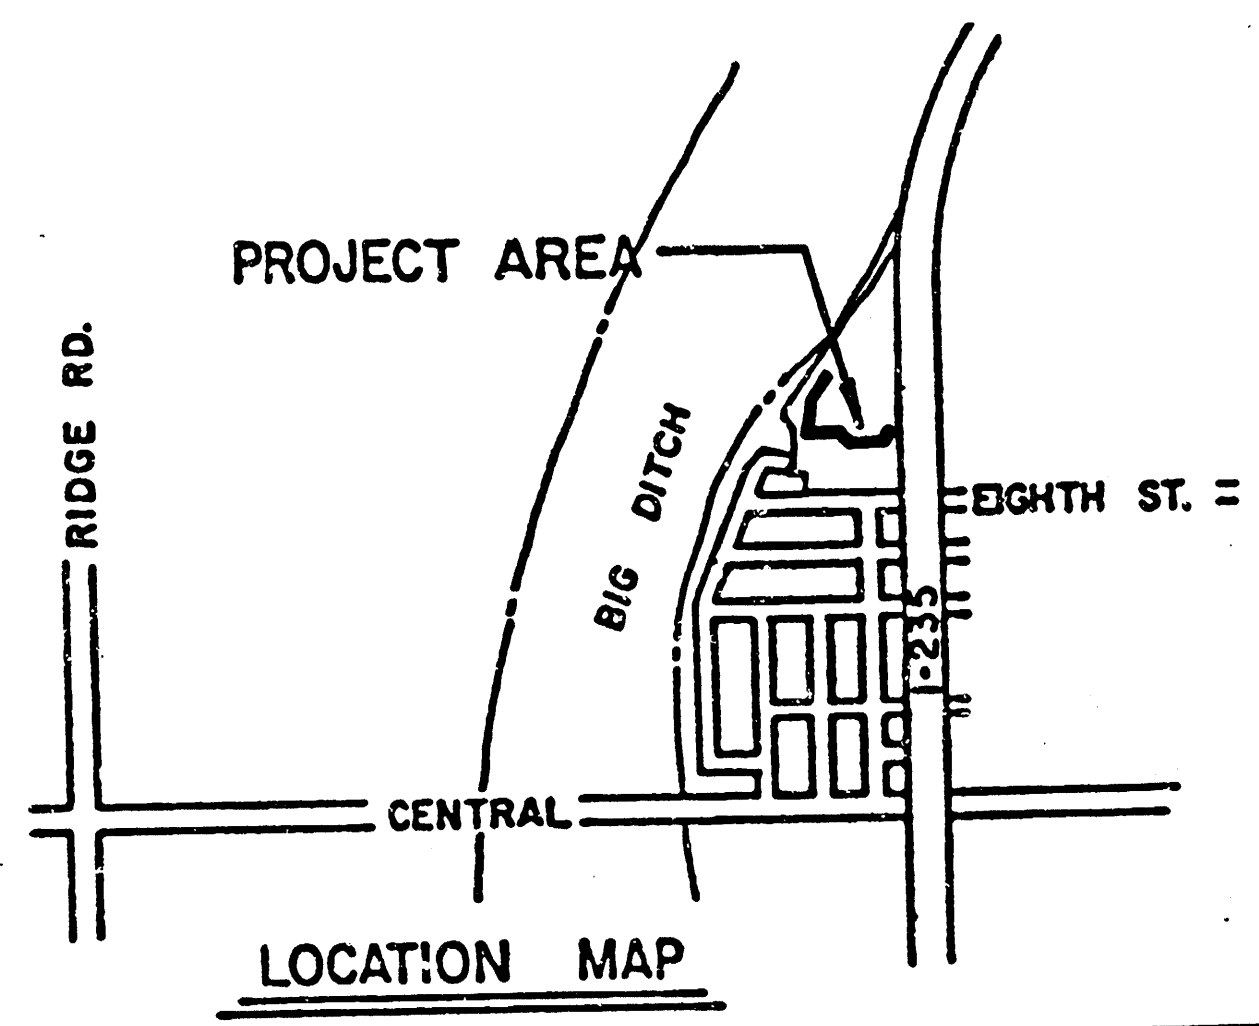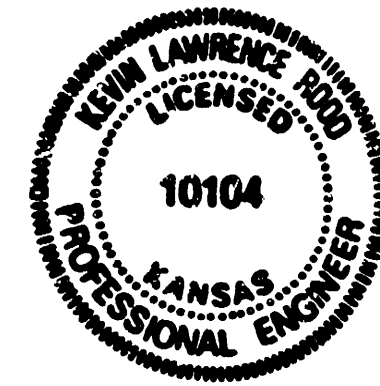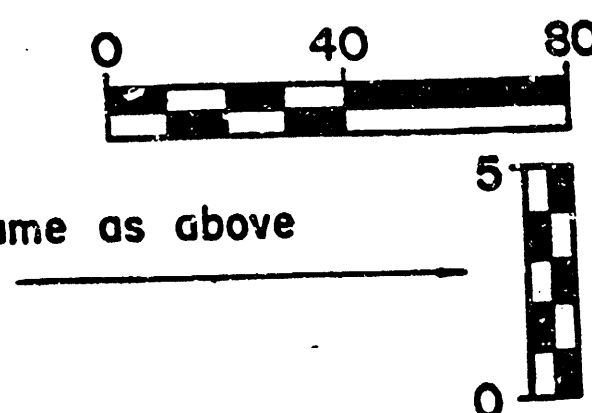

- GENERAL NOTES
1. ALL CONSTRUCTION AND MATERIALS TO COMPLY WITH CITY OF WICHITA SPECIFICATIONS AND STANDARDS.
 2. ALL ELEVATIONS SHOWN ARE CITY OF WICHITA DATUM (UGS-1187.4 - CITY DATUM).
 3. THE CONTRACTOR SHALL MAINTAIN THE EXTENT OF TRENCH TO REMAIN OPEN OVERNIGHT AND REPAIRS TO LESS THAN 50 FEET.
 4. AT LEAST 48 HOURS PRIOR TO BEGINNING EXCAVATION, IF REQUIRED, (EXCLUDING NEIGHBORS AND HOLDINGS), THE CONTRACTOR SHALL CONTACT THE KANSAS ONE-CALL SYSTEM, A UTILITY LOCATION SERVICE, AT (316) 687-2470 TO REQUEST THE FOLLOWING UTILITY COMPANIES TO LOCATE ANY EXISTING LINES WITHIN THE PROJECT AREA: GAS SERVICE COMPANY, K.G.A.E., THE WICHITA WATER DEPARTMENT, AND AIR CAPITAL CABLEVISION.
 5. THE CONTRACTOR MUST ALSO NOTIFY THE TELEPHONE COMPANY AT (913) 571-2115 48 HOURS PRIOR TO BEGINNING EXCAVATION AND REQUEST THAT ANY LINES WITHIN THE PROJECT AREA BE PLACED.
 6. THE BURIED UTILITIES AS LOCATED ON THE PLANS ARE APPROXIMATE LOCATIONS ONLY. IT SHOULD BE NOTED THAT OTHER BURIED LINES AND CABLES MAY EXIST WHICH ARE NOT SHOWN ON THESE PLANS. THE CONTRACTOR SHALL EXERCISE EXTREME CAUTION DURING TRENCHING OPERATIONS TO AVOID DAMAGING THESE LINES. ANY LINES DAMAGED SHALL BE REPLACED OR REPAIRED IMMEDIATELY AS DIRECTED BY THE ENGINEER AT THE CONTRACTOR'S EXPENSE.
 7. THE CONTRACTOR SHALL RESTORE ALL DITCHES, SHALES, ROAD SHOULDERS, ENTRANCES, AND BANK LINES TO THEIR ORIGINAL SURFACES EXCEPT AS SHOWN OTHERWISE ON THE EASEMENT GRADING PLAN.
 8. THE CONTRACTOR SHALL BE RESPONSIBLE FOR PRESERVING PROPERTY IRONS. THE CONTRACTOR SHALL BE REQUIRED TO RE-ESTABLISH ANY PROPERTY IRONS WHICH ARE DAMAGED OR DESTROYED BY HIS CONSTRUCTION OPERATIONS. SUCH IRONS SHALL BE RE-ESTABLISHED BY A LICENSED LAND SURVEYOR OR A LICENSED PROFESSIONAL ENGINEER IN ACCORDANCE WITH STATE LMS. ALL COSTS FOR THIS WORK SHALL BE SUBSIDIARY TO THE OTHER ITEMS OF WORK.
 9. ALL EXCESS EXCAVATED MATERIAL FROM THIS PROJECT SHALL BE WASTED AS DIRECTED OR APPROVED BY THE ENGINEER. NO EXCESS MATERIAL SHALL BE PLACED WITHIN STREET RIGHTS-OF-WAY. THE CONTRACTOR SHALL CONTACT THE DEVELOPER FOR INFORMATION PERTAINING TO ACCEPTABLE LOCATIONS FOR THE DISPOSITION OF WASTE MATERIAL ON SITE. WASTE MATERIAL SHALL BE BLADED SMOOTH AND SLOPED TO DRAIN. THIS WORK SHALL BE SUBSIDIARY TO OTHER BID ITEMS.
 10. CONTRACTOR SHALL PROVIDE POSITIVE DRAINAGE AWAY FROM ALL MANHOLE COVERS.

LINE NO. 1
CITY OF WICHITA, KANSAS
MICHAEL P. CITY ENGINEER
SANITARY SEWER IMPROVEMENTS



PROFESSIONAL ENGINEERING CONSULTANTS, P.A.
ENGINEERS
WICHITA, KANSAS

Job No. 34-86439-1
Designed by KLR, BT
Drawn by BT
Date Sept. 1996


MILES LAKEWOOD LIVING NURSING CENTER
C.O.W. No. 488-75-245-80001-000-000-079

PLAN	DATE	
	BY	
	SURVEYED	
	NOTED	

PROFILE	DATE	
	BY	
	SURVEYED	
	NOTED	

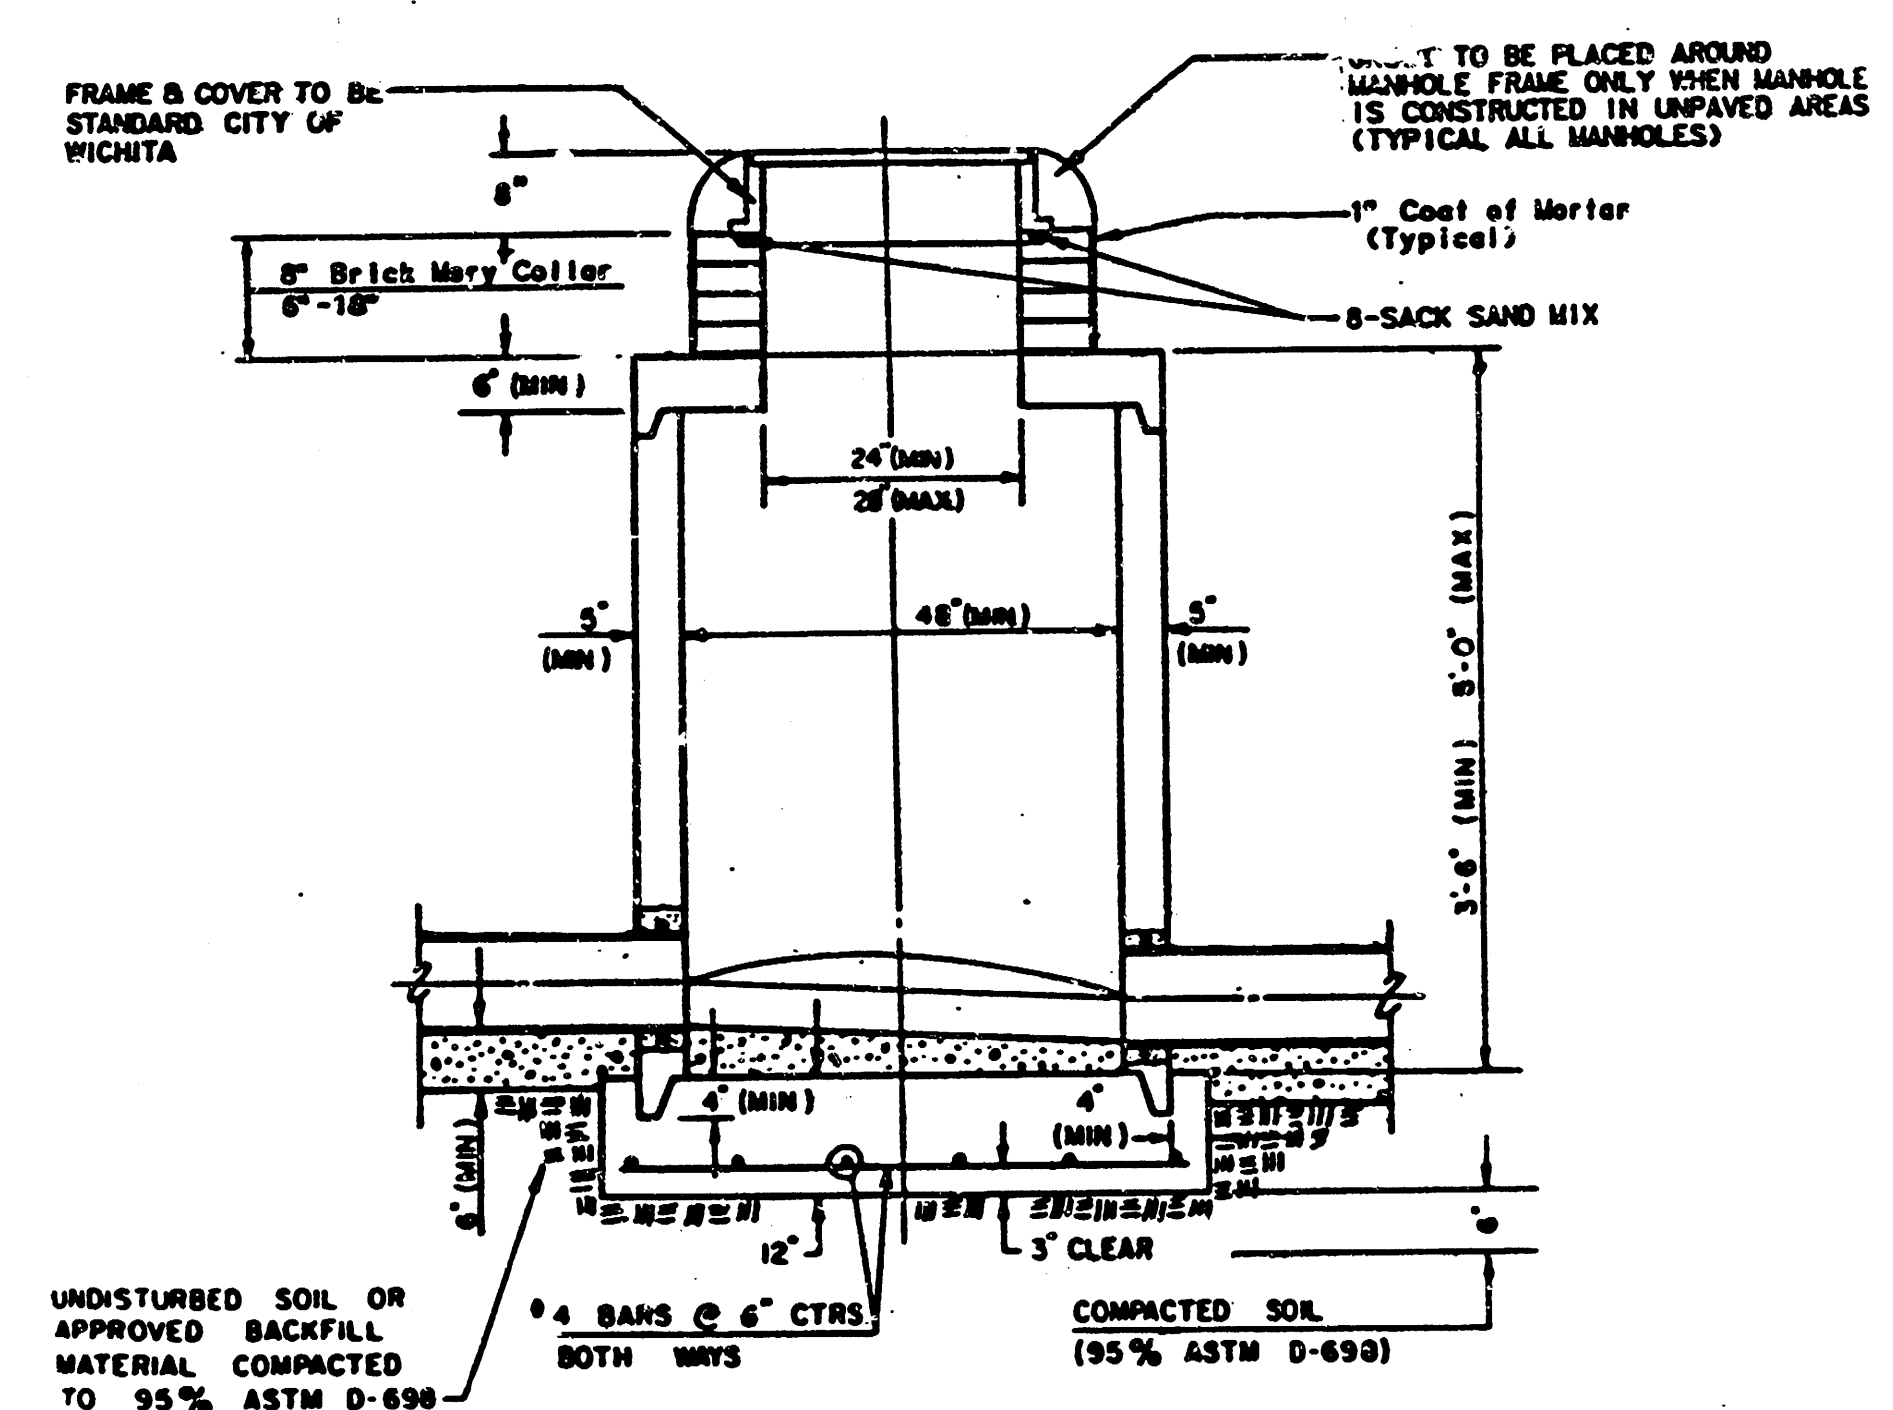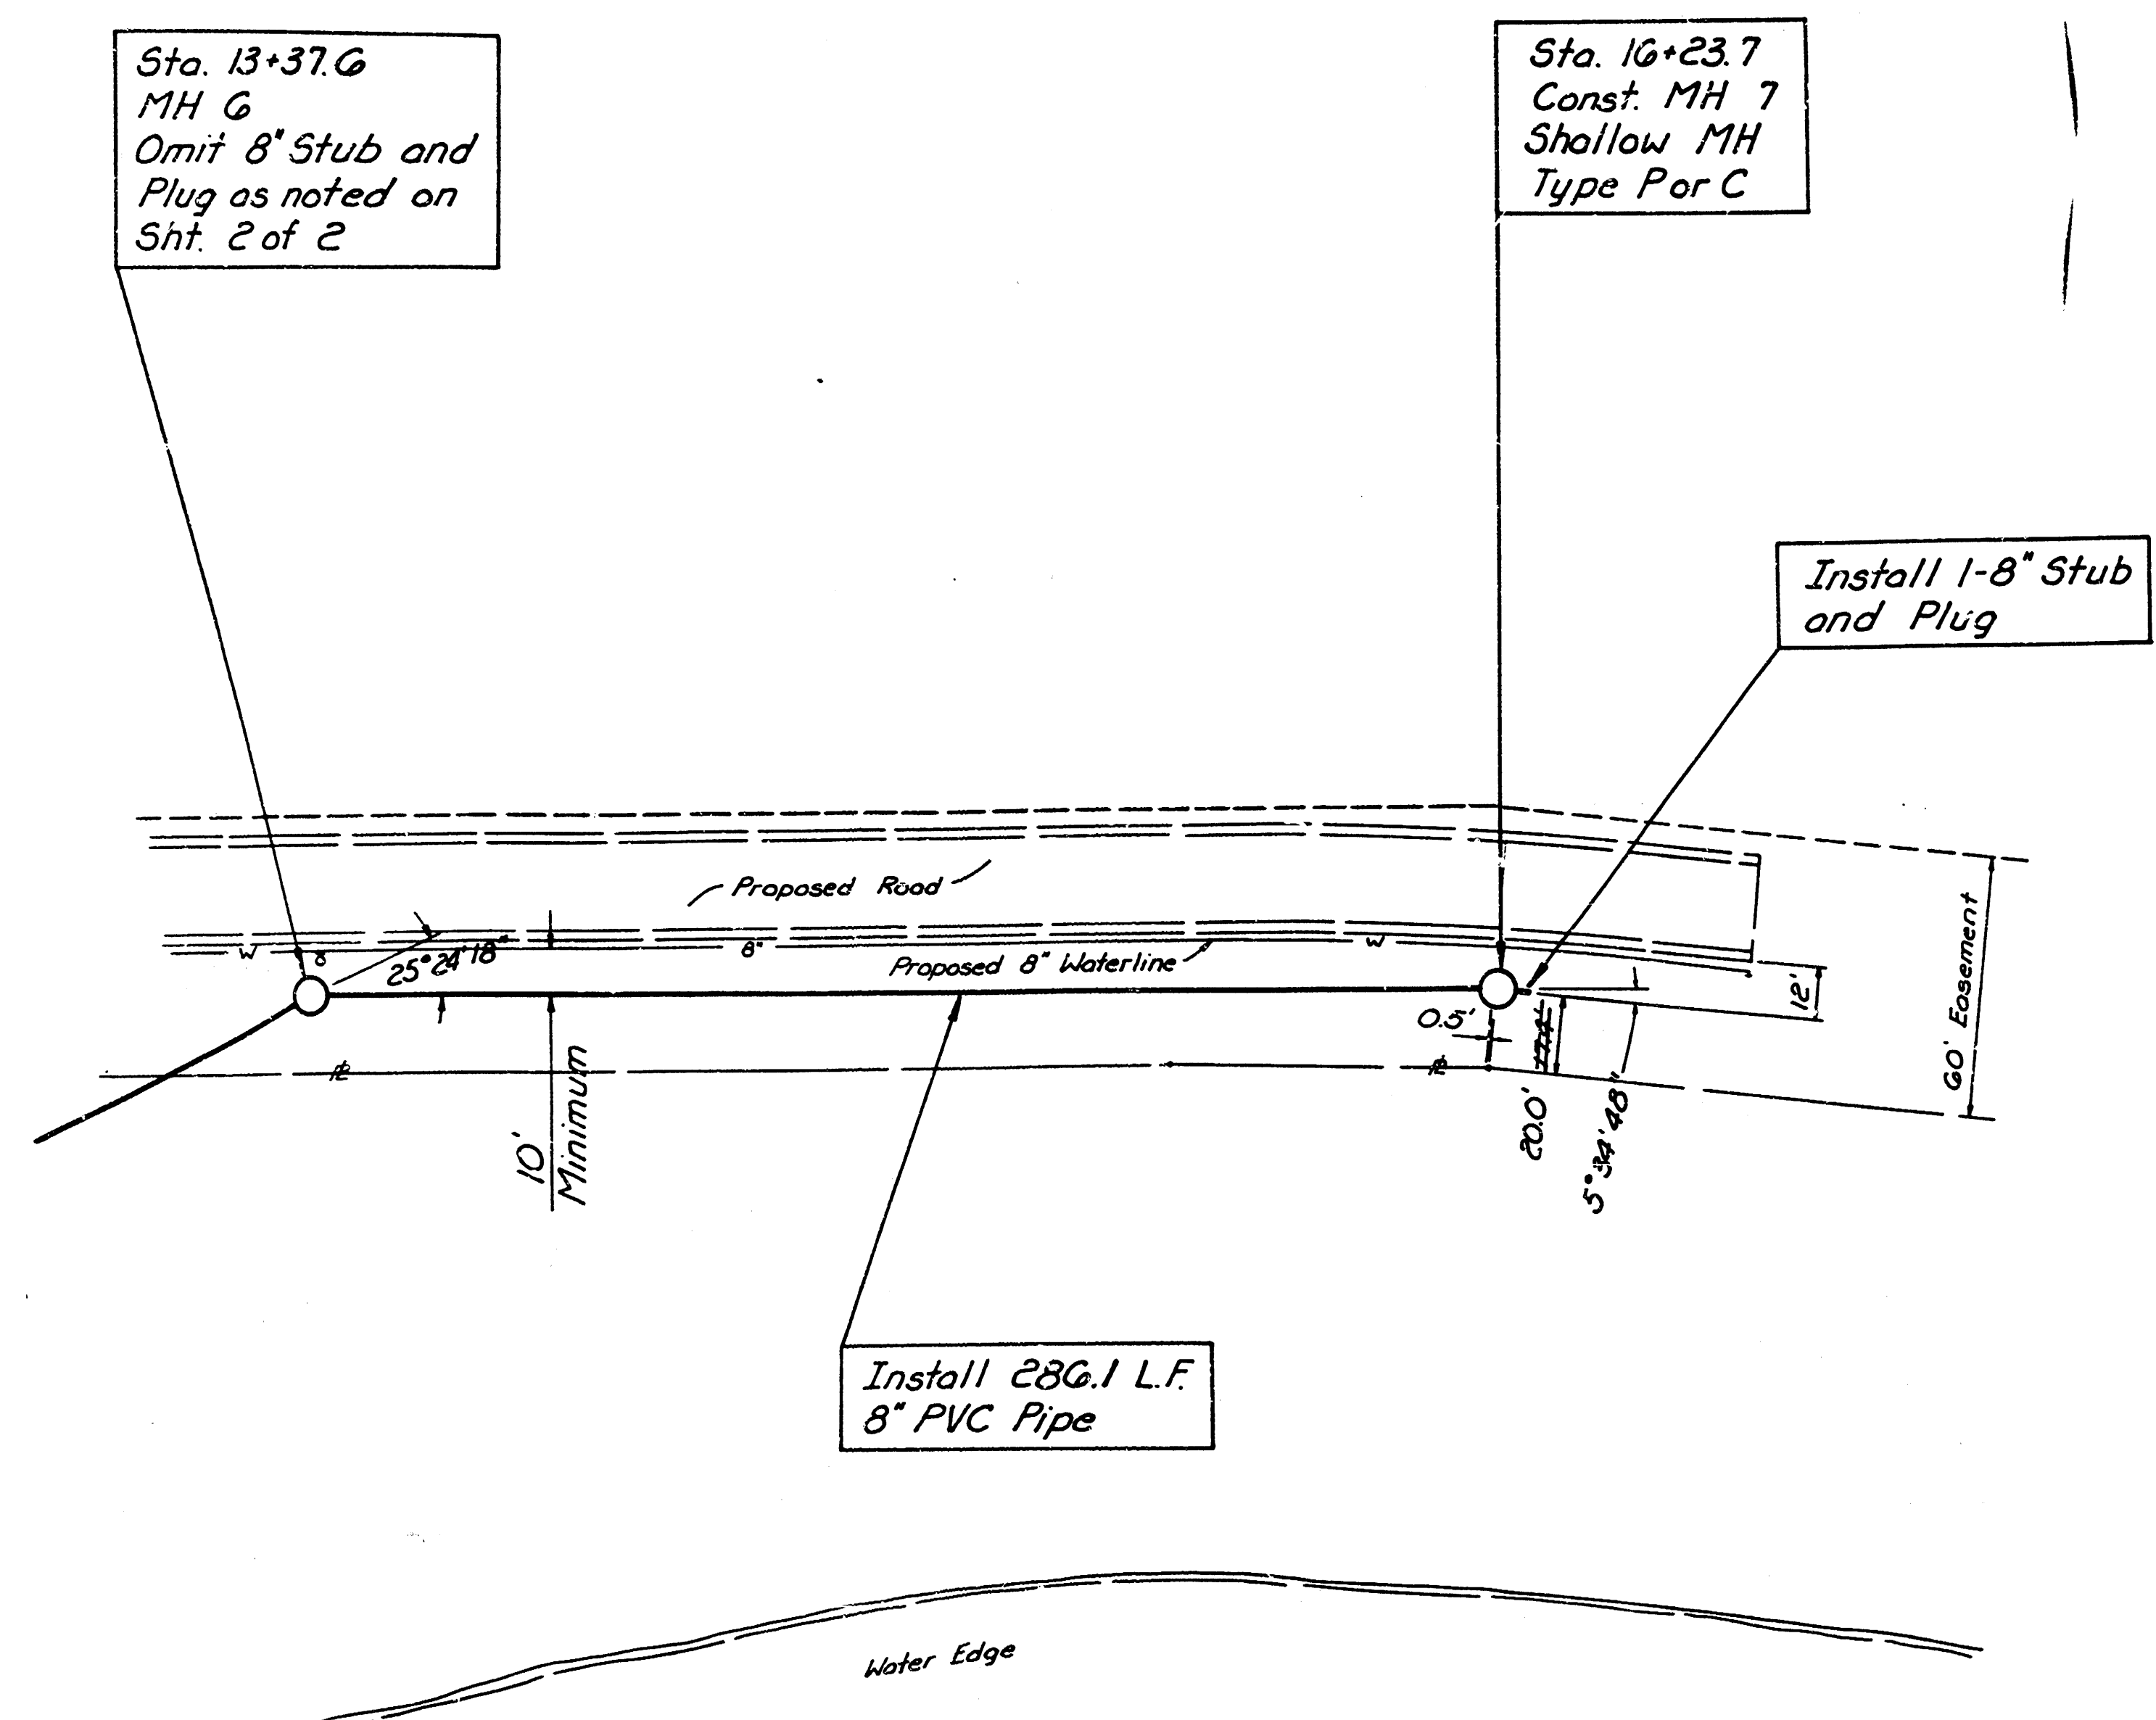

PRECAST
SHALLOW MANHOLE
TYPE "P"

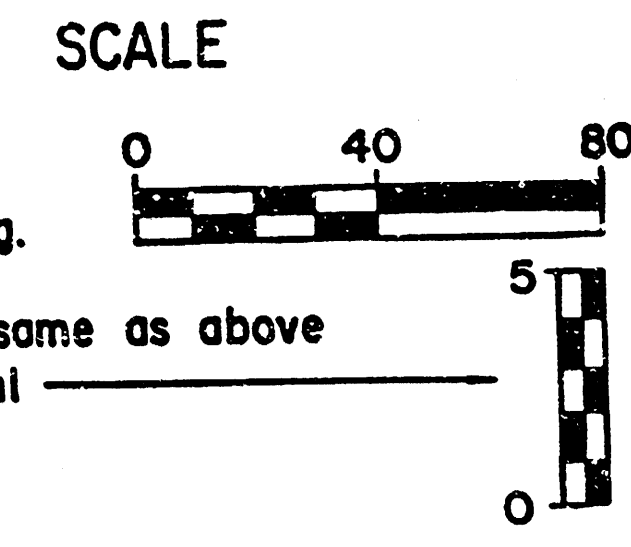


PLAN: Lat. & Long.
PROFILE: Horiz. same as above
Vertical

AS CONSTRUCTED
PROJ. ENG. _____ DATE 3/6/87
RES. ENG. _____ DATE _____

APPROVED AS NOTED
By CITY ENGINEER OF WICHITA
Sanitary Sewers MB 10/6/86
Storm Sewers _____
Driveway Approaches _____
Water Mains _____
Paving _____

NOTE TO CONTRACTOR
This project will be constructed under the supervision of the CITY ENGINEER and conforming to the SPECIFICATIONS of the CITY OF WICHITA. The CONTRACTOR will pay the City of Wichita for all costs of plan review, inspection and booking per contract.

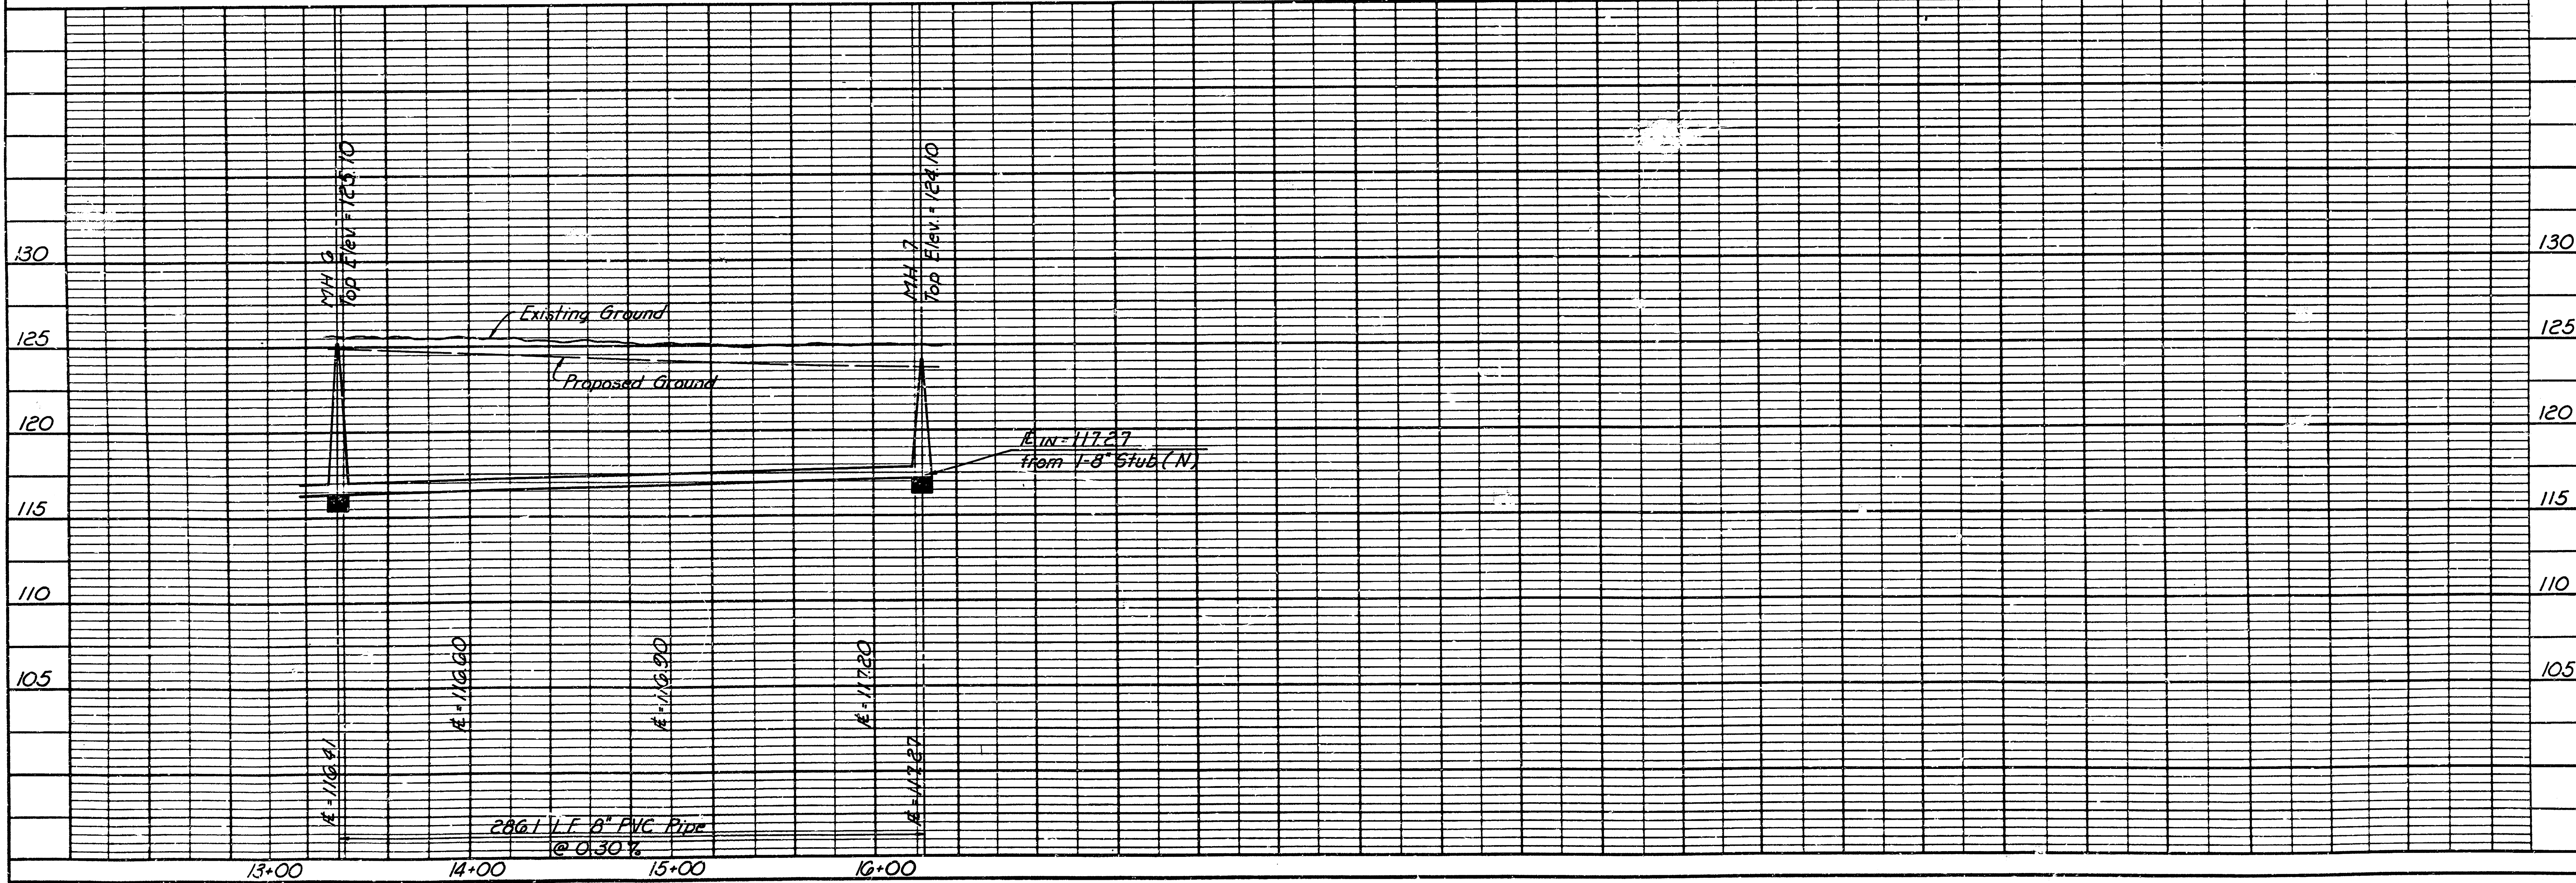

CITY OF WICHITA, KANSAS
 MICHAEL E. LIVING CENTER
 SANITARY SEWER IMPROVEMENTS
 LINE NO. 1
 MILES LAKEWOOD LIVING NURSING CENTER
 C.O.W. No. 469-76-245-80001-000-000-079
 PROFESSIONAL ENGINEERING CONSULTANTS, P.A.
 ENGINEERS
 WICHITA, KANSAS
 Job No. 34-80450-1
 Date Sept 1986
 Designed by KLR/GM
 Drawn by GM
 Sht 2A of 2