


PLAN	DATE
PROJECT: _____	BY: _____
DESIGNED BY: _____	CHECKED BY: _____
DATE: _____	BY: _____

PROFILE	DATE
PROJECT: _____	BY: _____
DESIGNED BY: _____	CHECKED BY: _____
DATE: _____	BY: _____

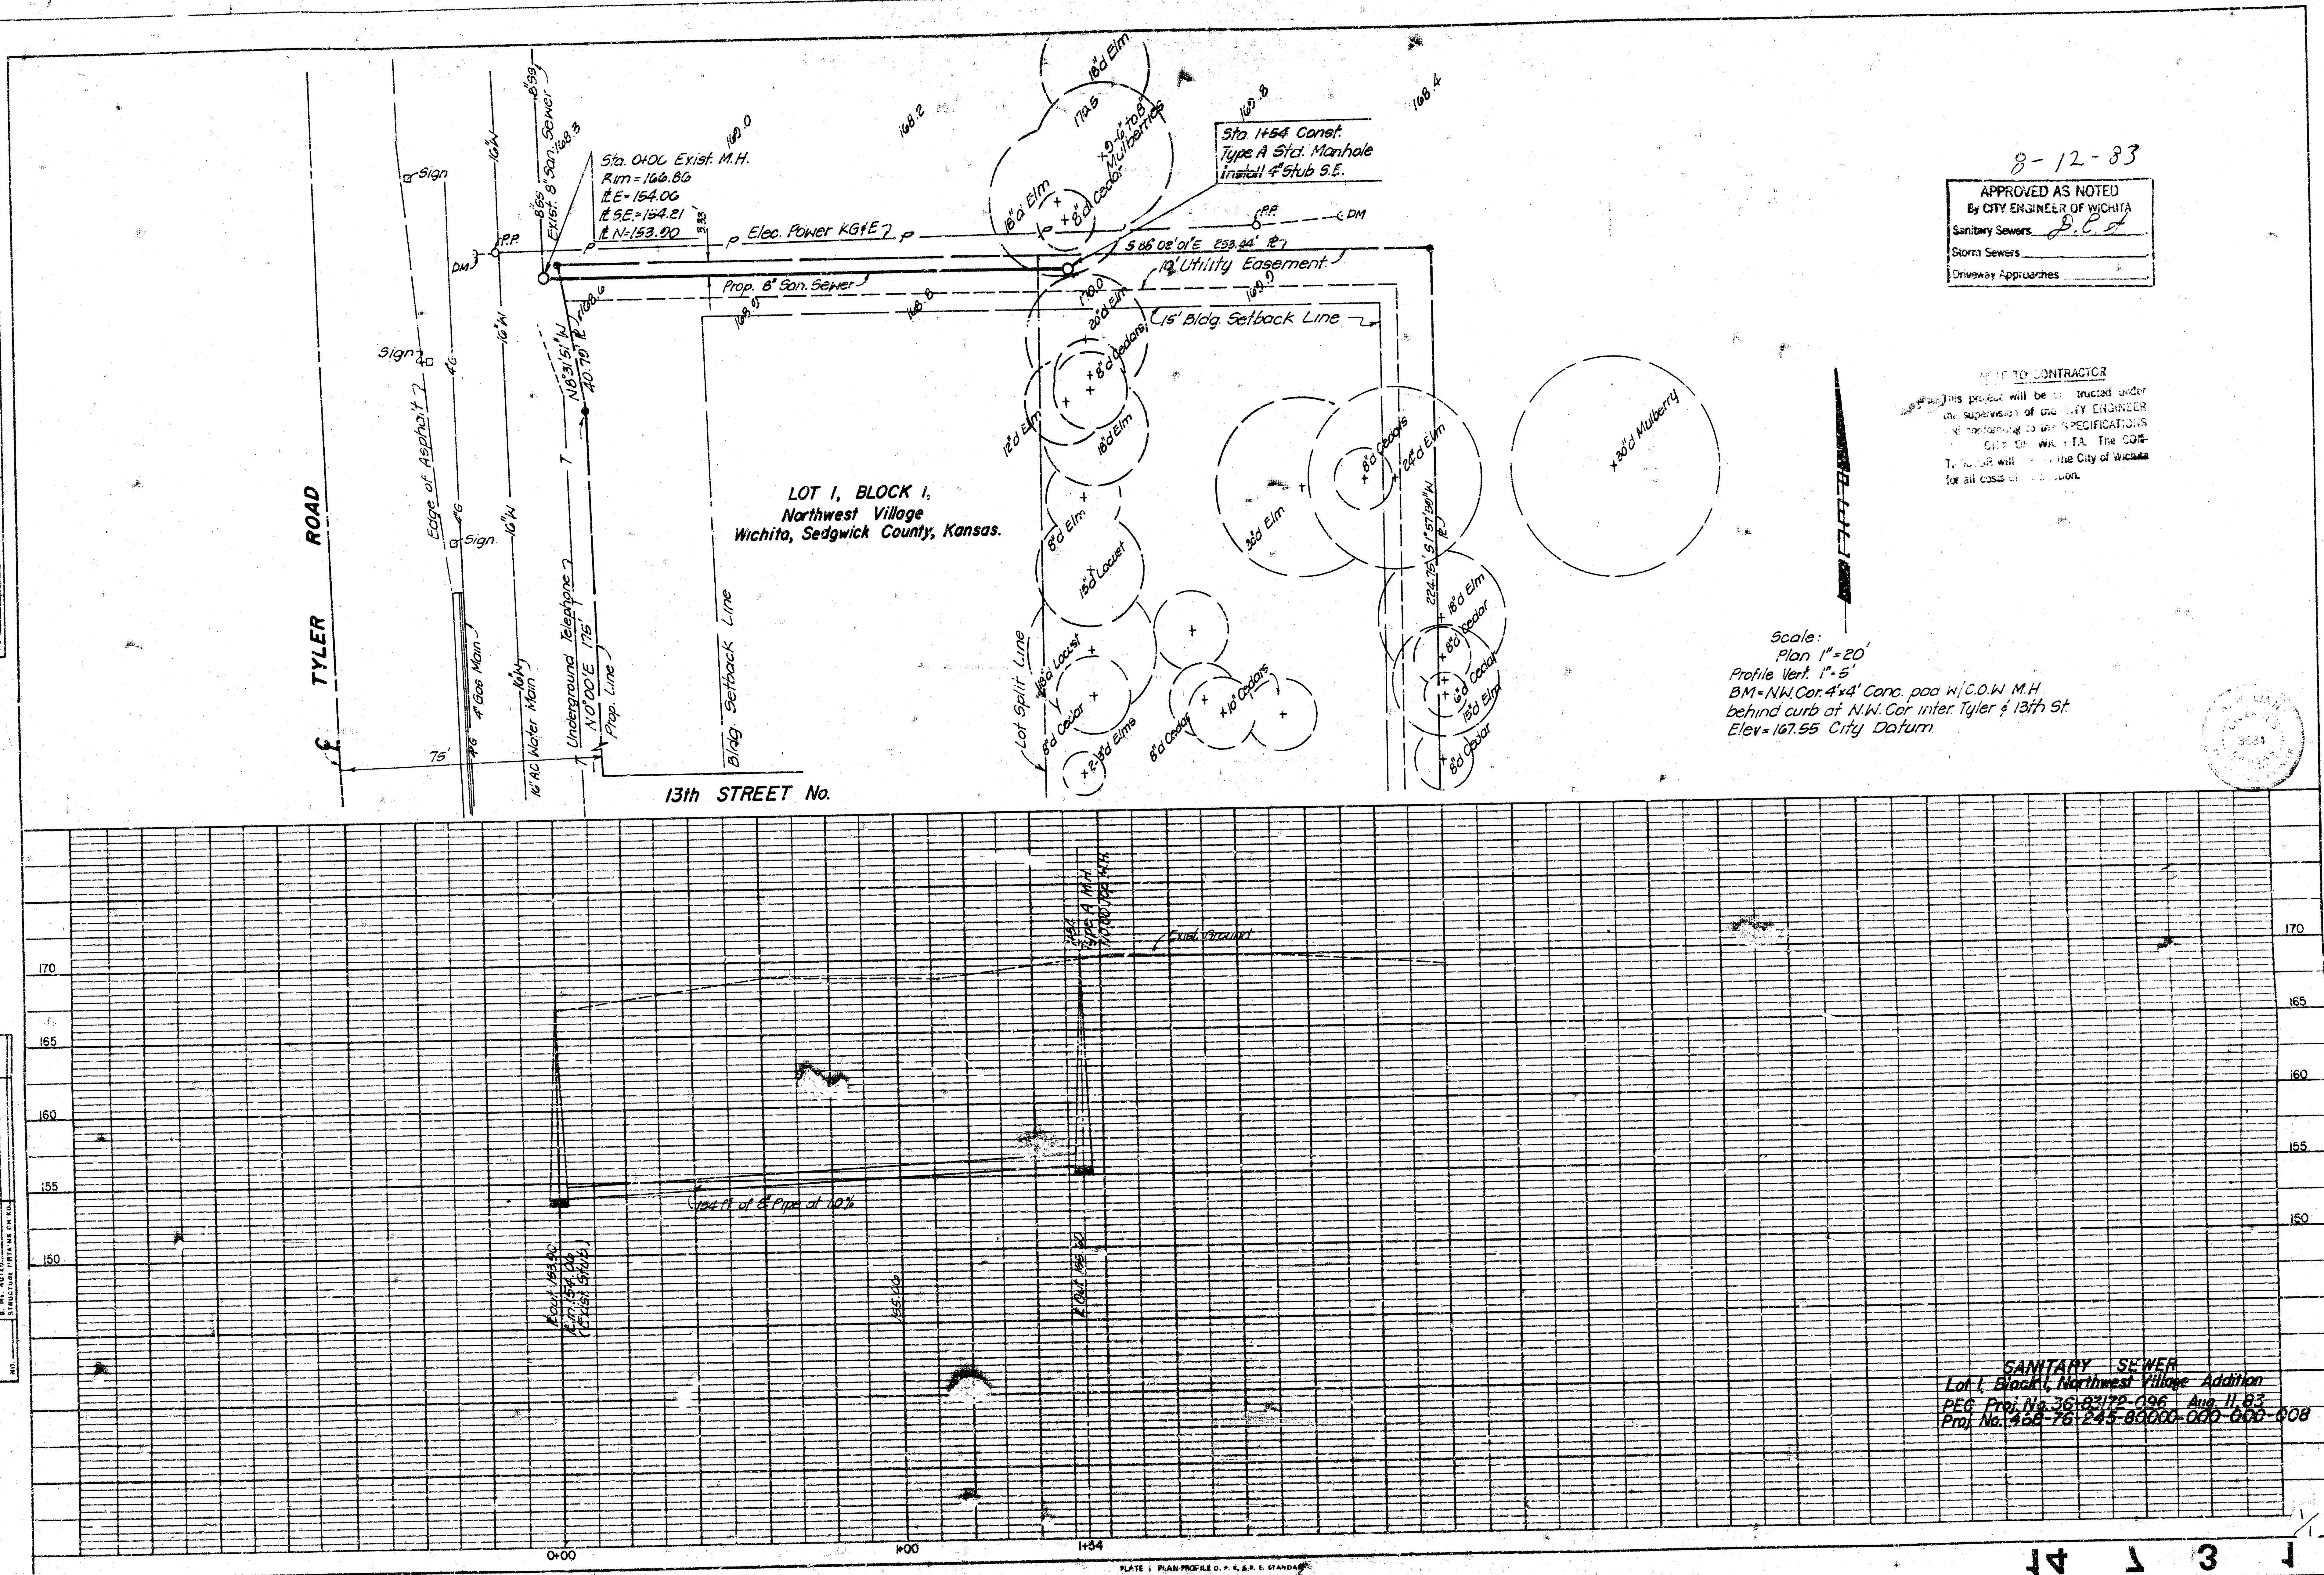

8-12-83
 APPROVED AS NOTED
 By CITY ENGINEER OF WICHITA
 Sanitary Sewers *B.C.*
 Storm Sewers
 Driveway Approaches

NOTE TO CONTRACTOR
 This project will be constructed under
 the supervision of the CITY ENGINEER
 and conforming to the SPECIFICATIONS
 CITY OF WICHITA. The CON-
 TRACTOR will be responsible for the City of Wichita
 for all costs of construction.

Scale:
 Plan 1"=20'
 Profile Vert. 1"=5'
 BM= NW Cor. 4x4' Conc. pad w/ C.O.W. M.H.
 behind curb of N.W. Cor. inter Tyler & 13th St.
 Elev= 167.55 City Datum

SANITARY SEWER
Lot 1, Block 1, Northwest Village Addition
PEC Proj. No. 36-83175-096 Aug. 11, 83
Proj. No. 400-78-245-80000-000-000-008