

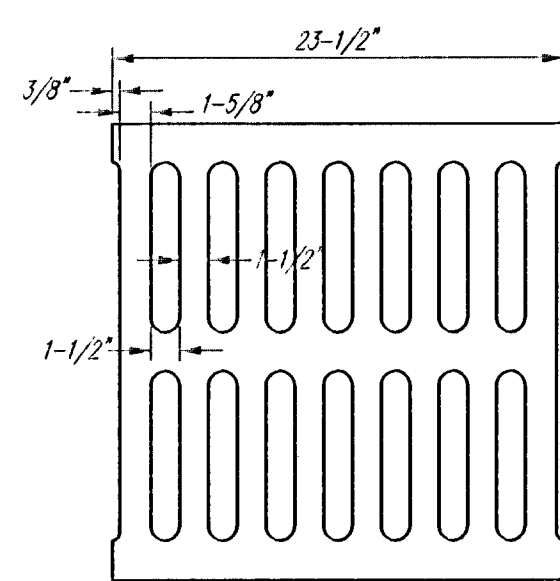


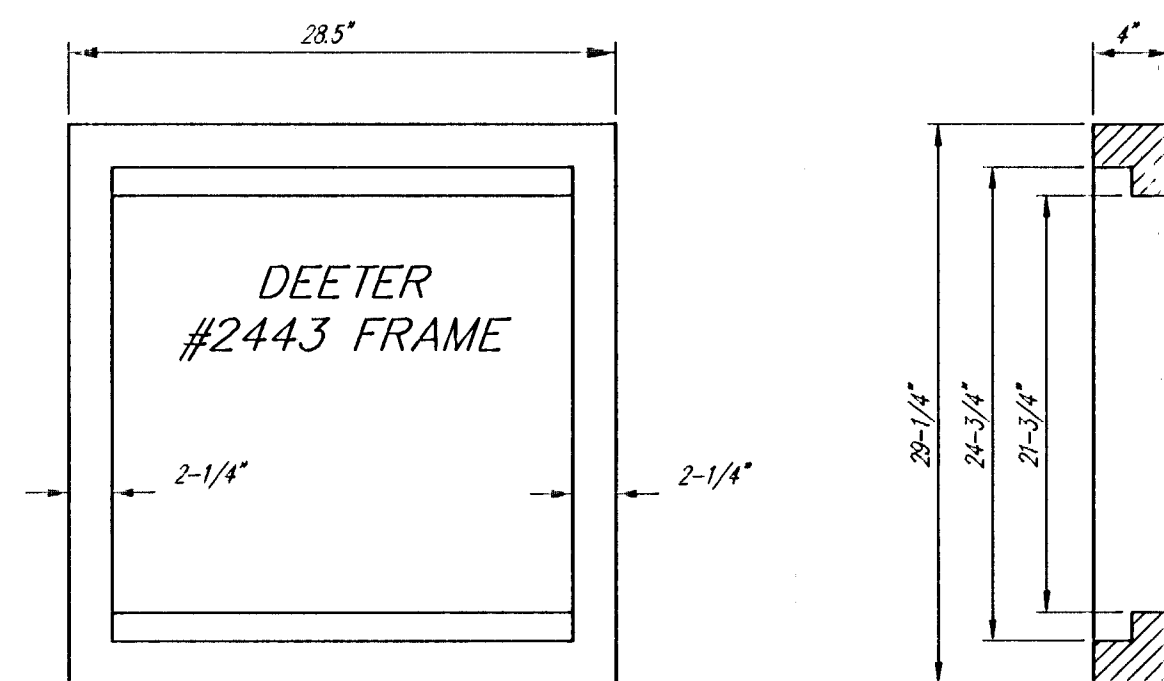






DEETER #2433 GRATE

24" x 24" Frame and Grate Detail

NOTE: Grates shall be imprinted on the top surface with "CITY OF WICHITA" using letters at least 1" in height. Other marking methods may be approved by the engineer.

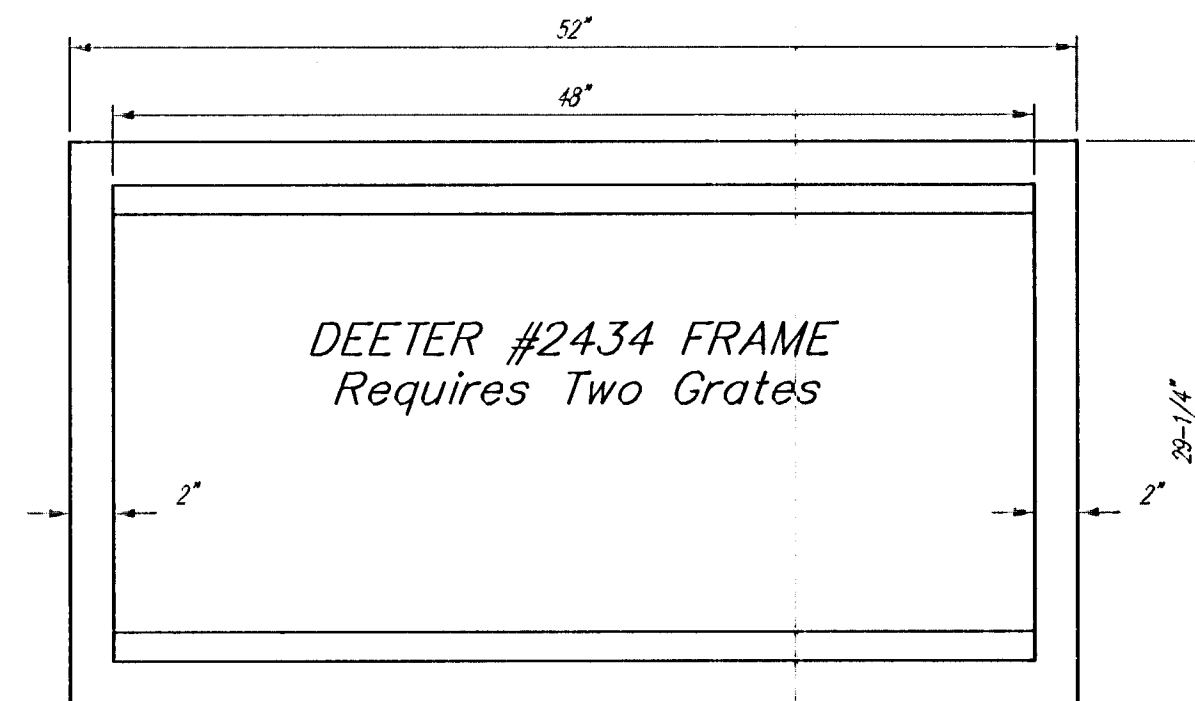

Double 24" x 24" Frame Detail

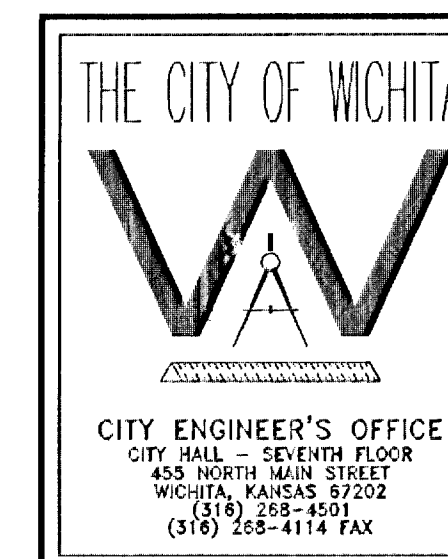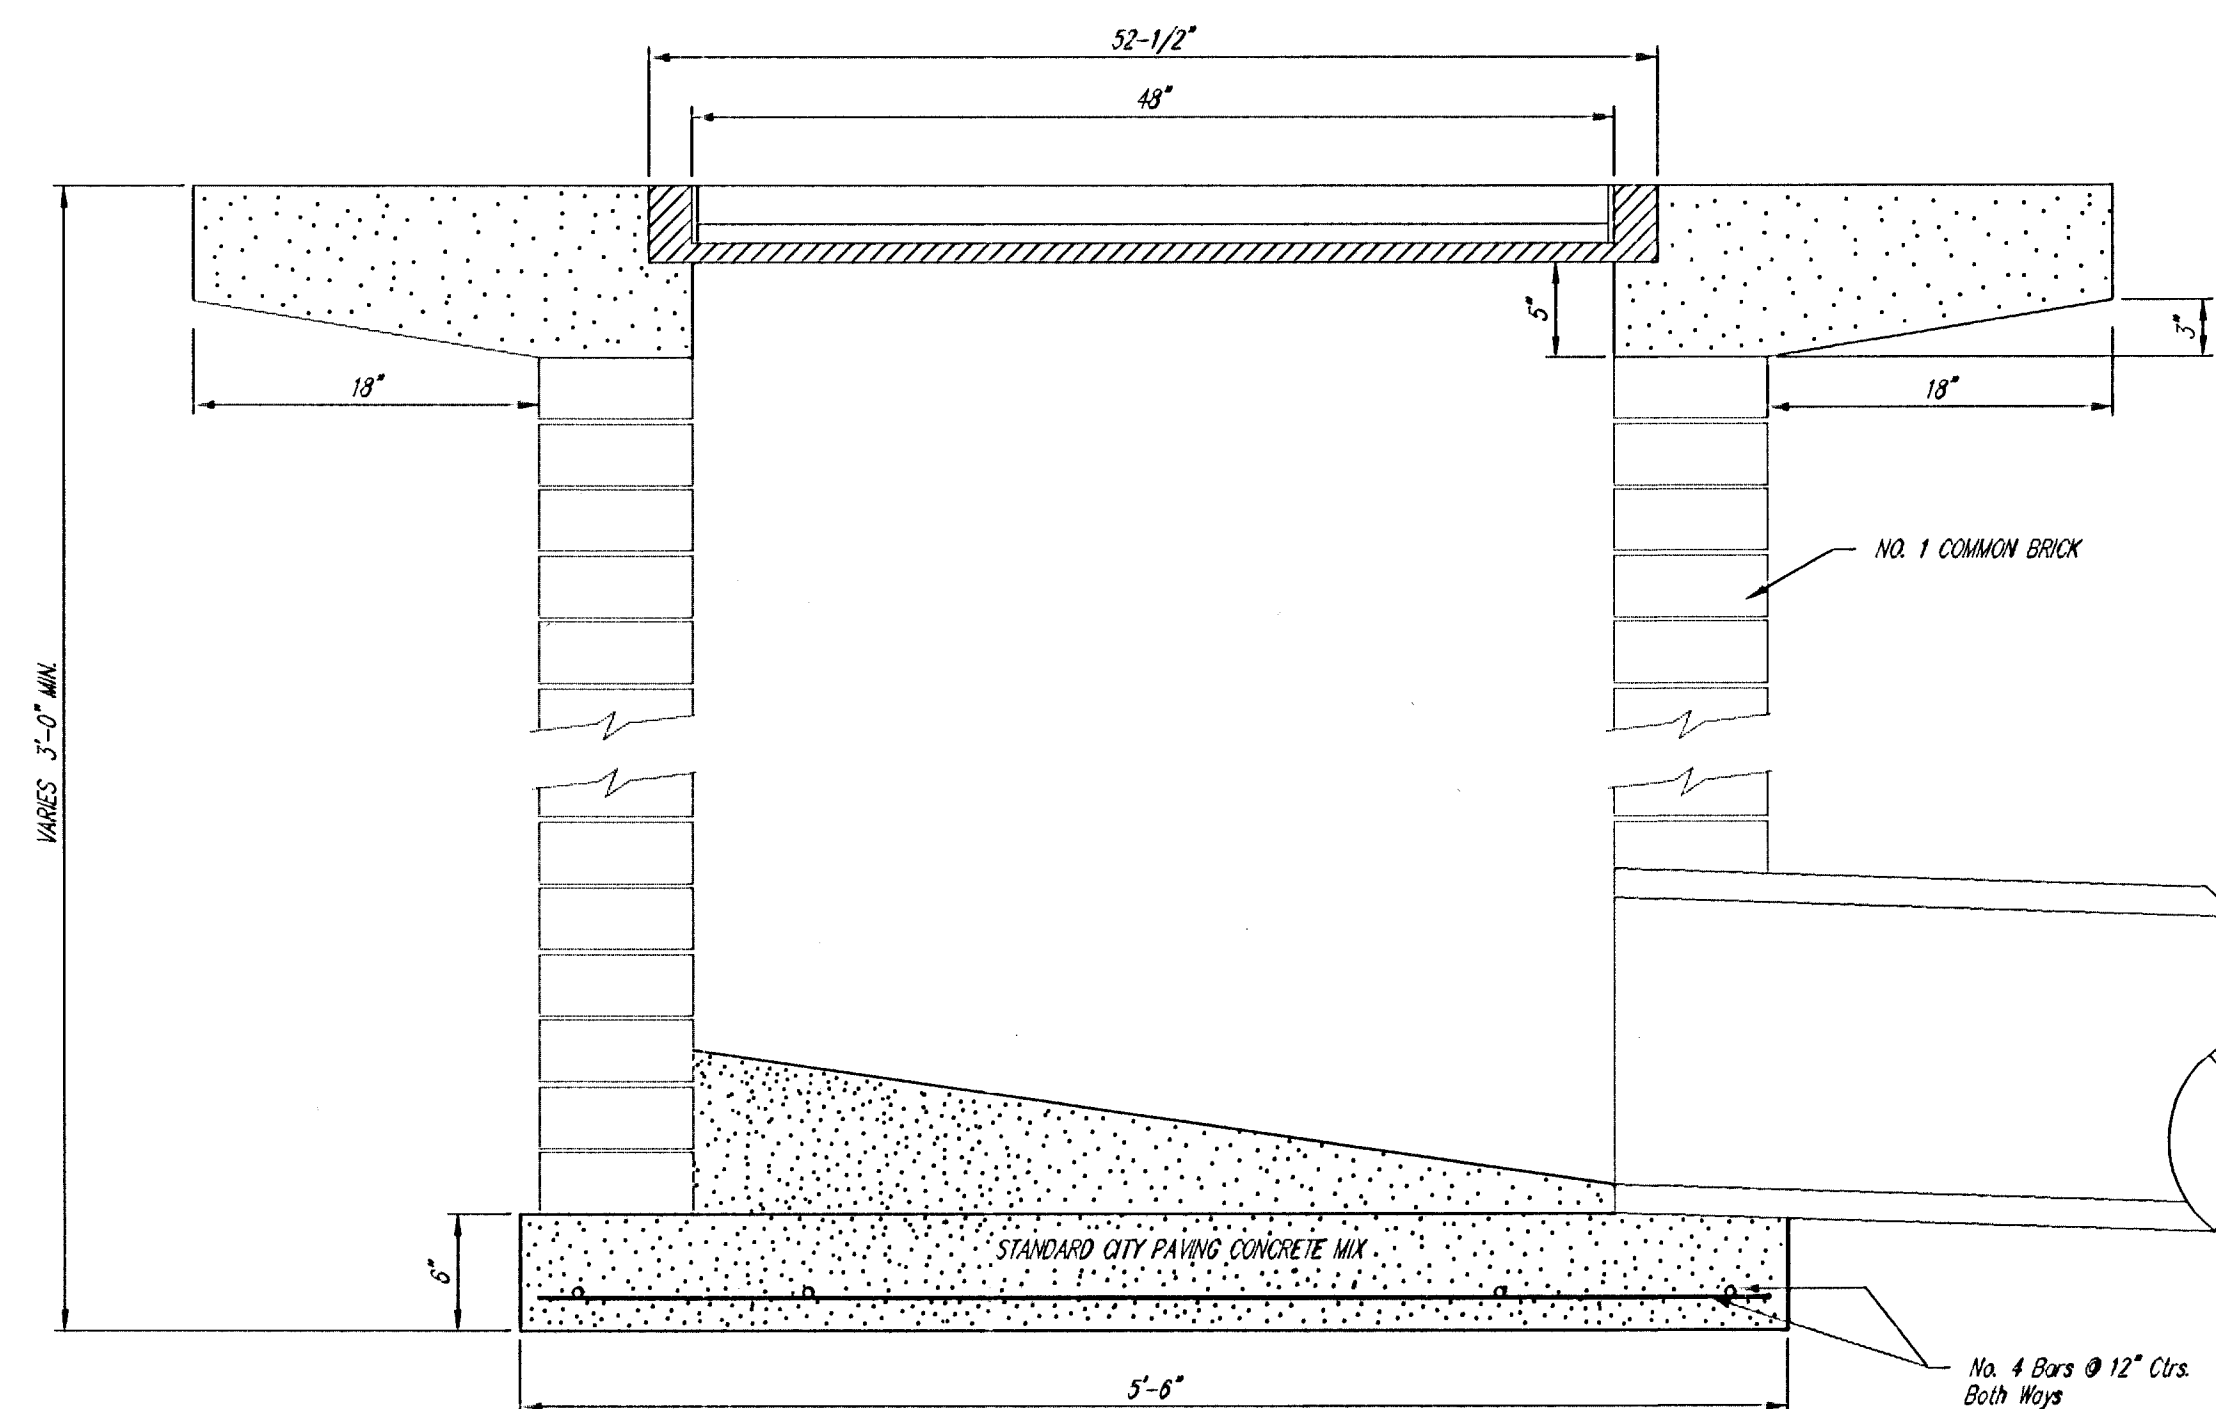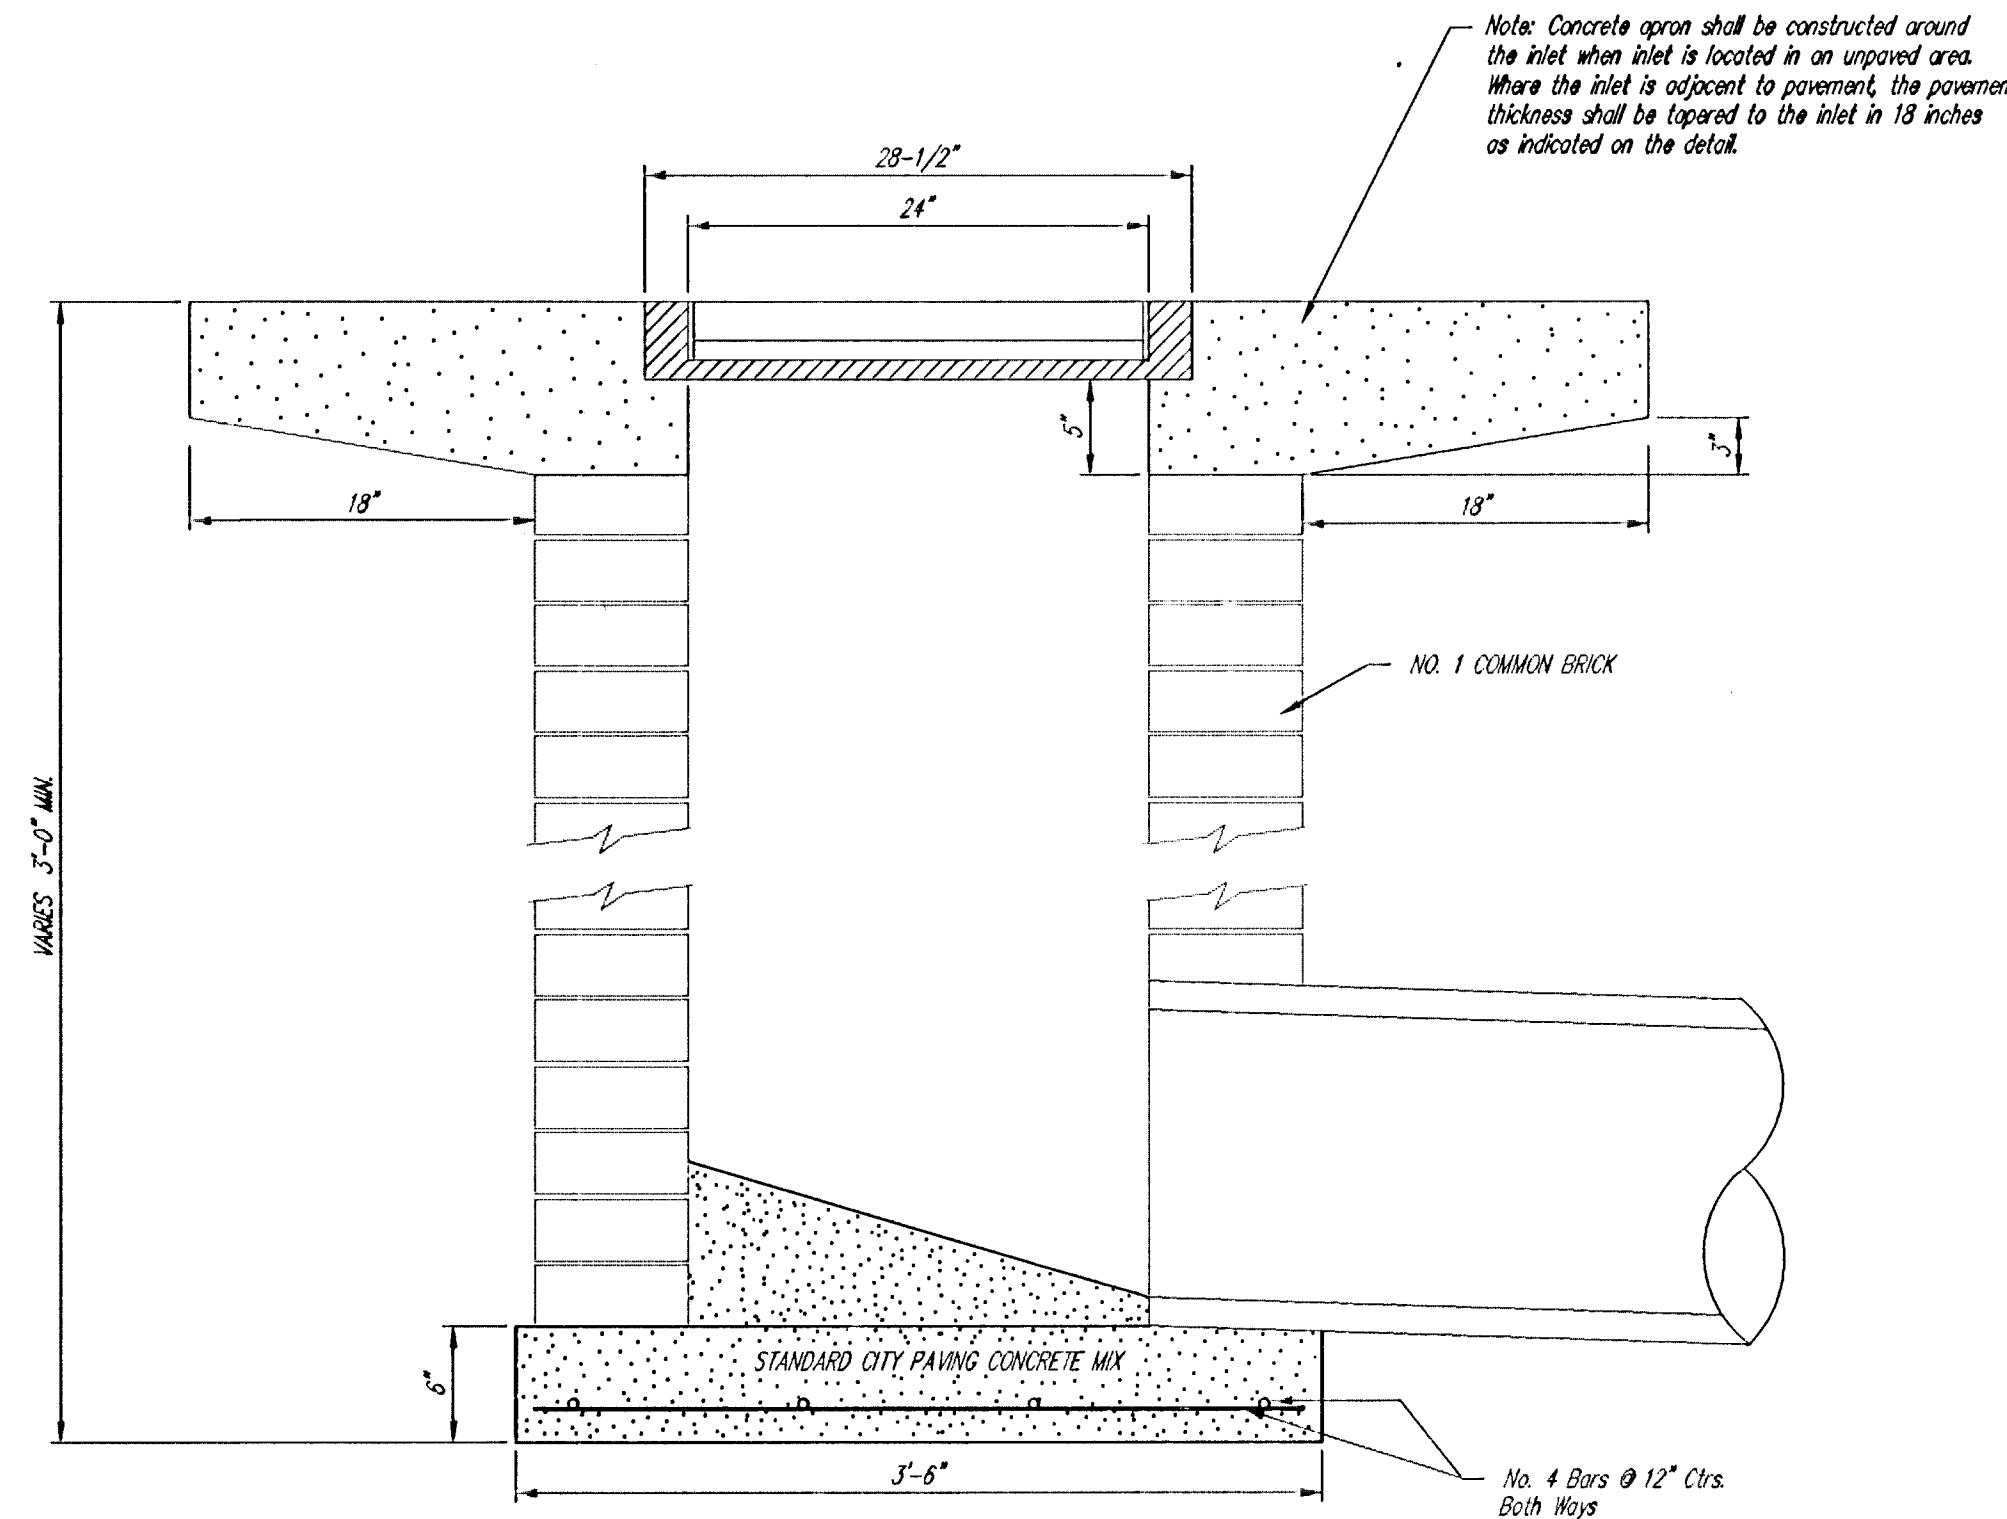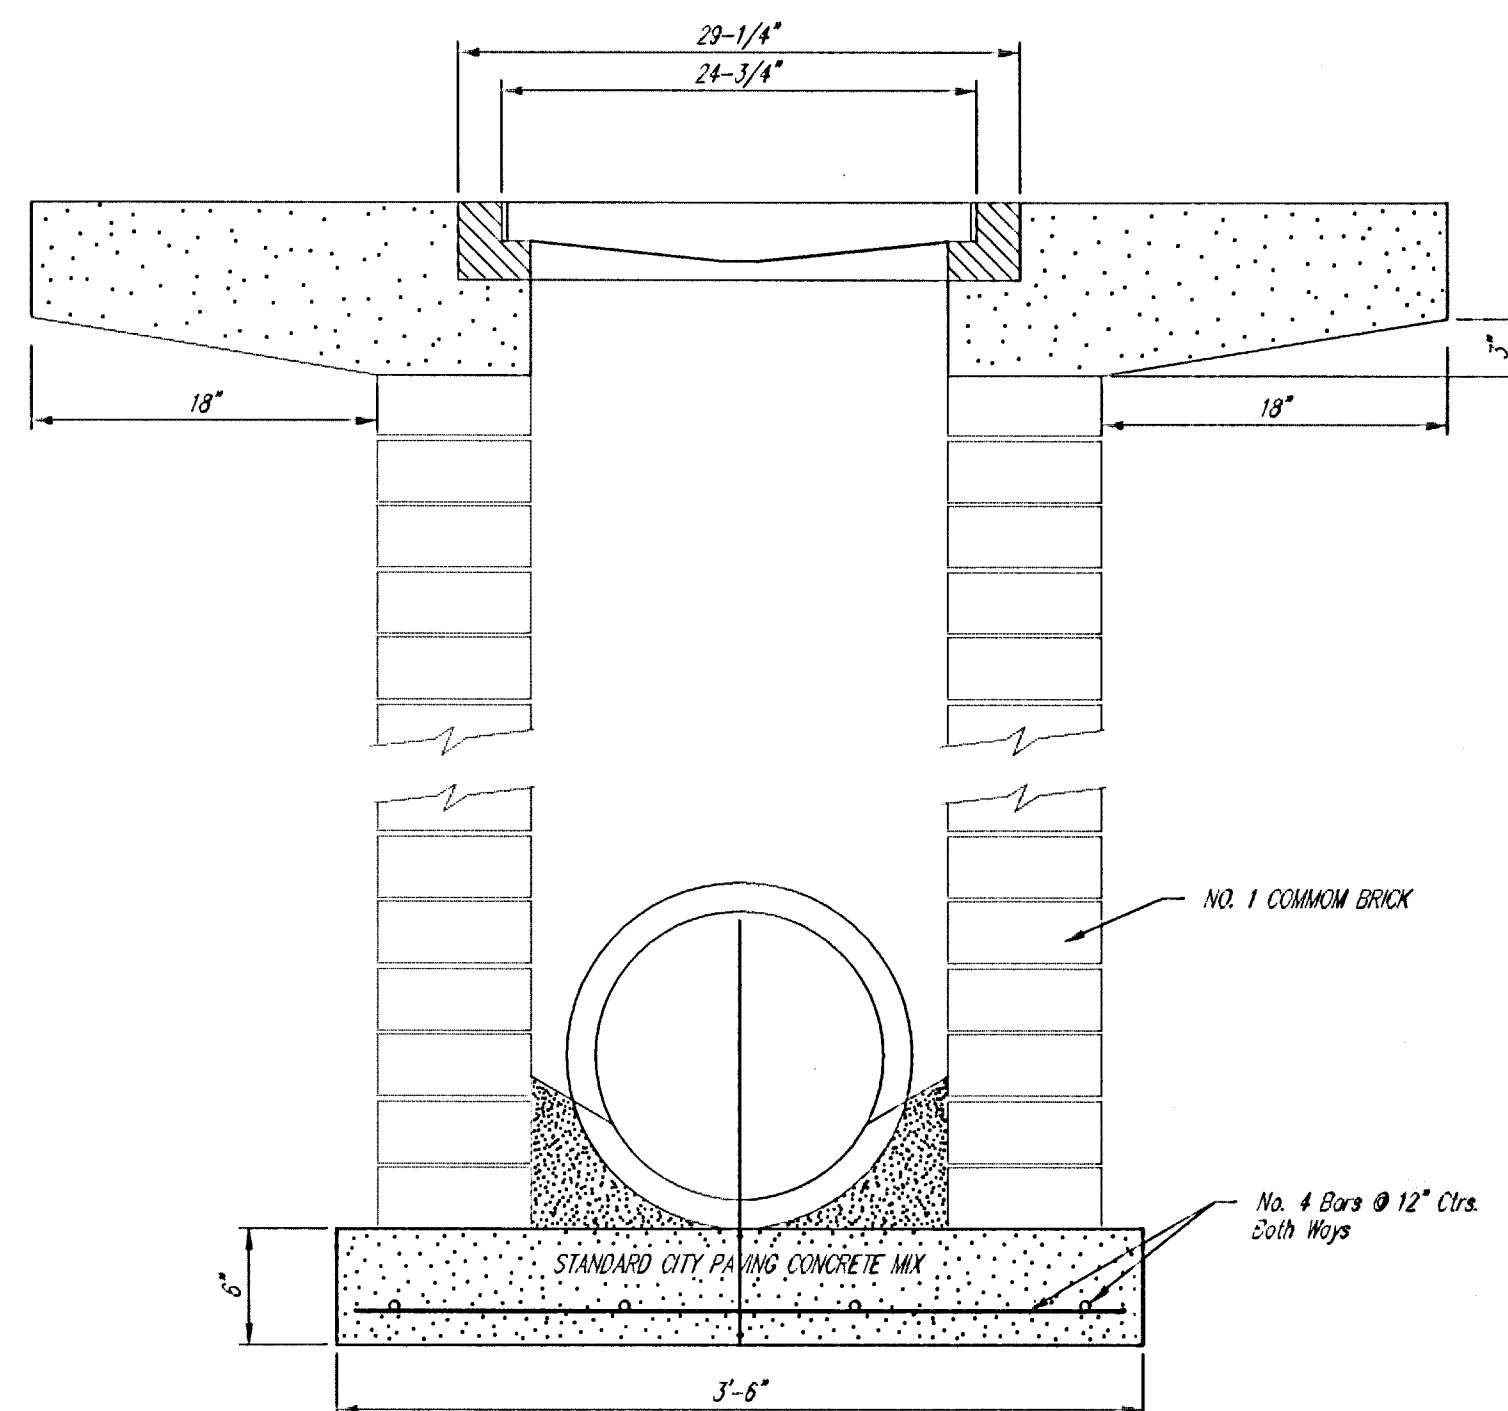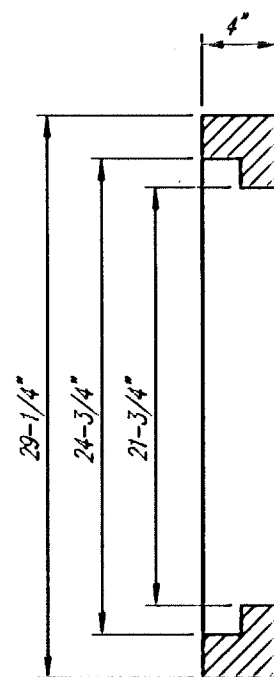

DROP INLET 2' X 2' / 2' X 4'	
M. E. LINDEBAK P.E. - CITY ENGINEER	
PROJECT NUMBER 1744 PPS	INDEX CODE 607861
DATE MAR 96	SHEET 4 OF 10

AS-BUILT 9-14-07
T.N.-C&D