


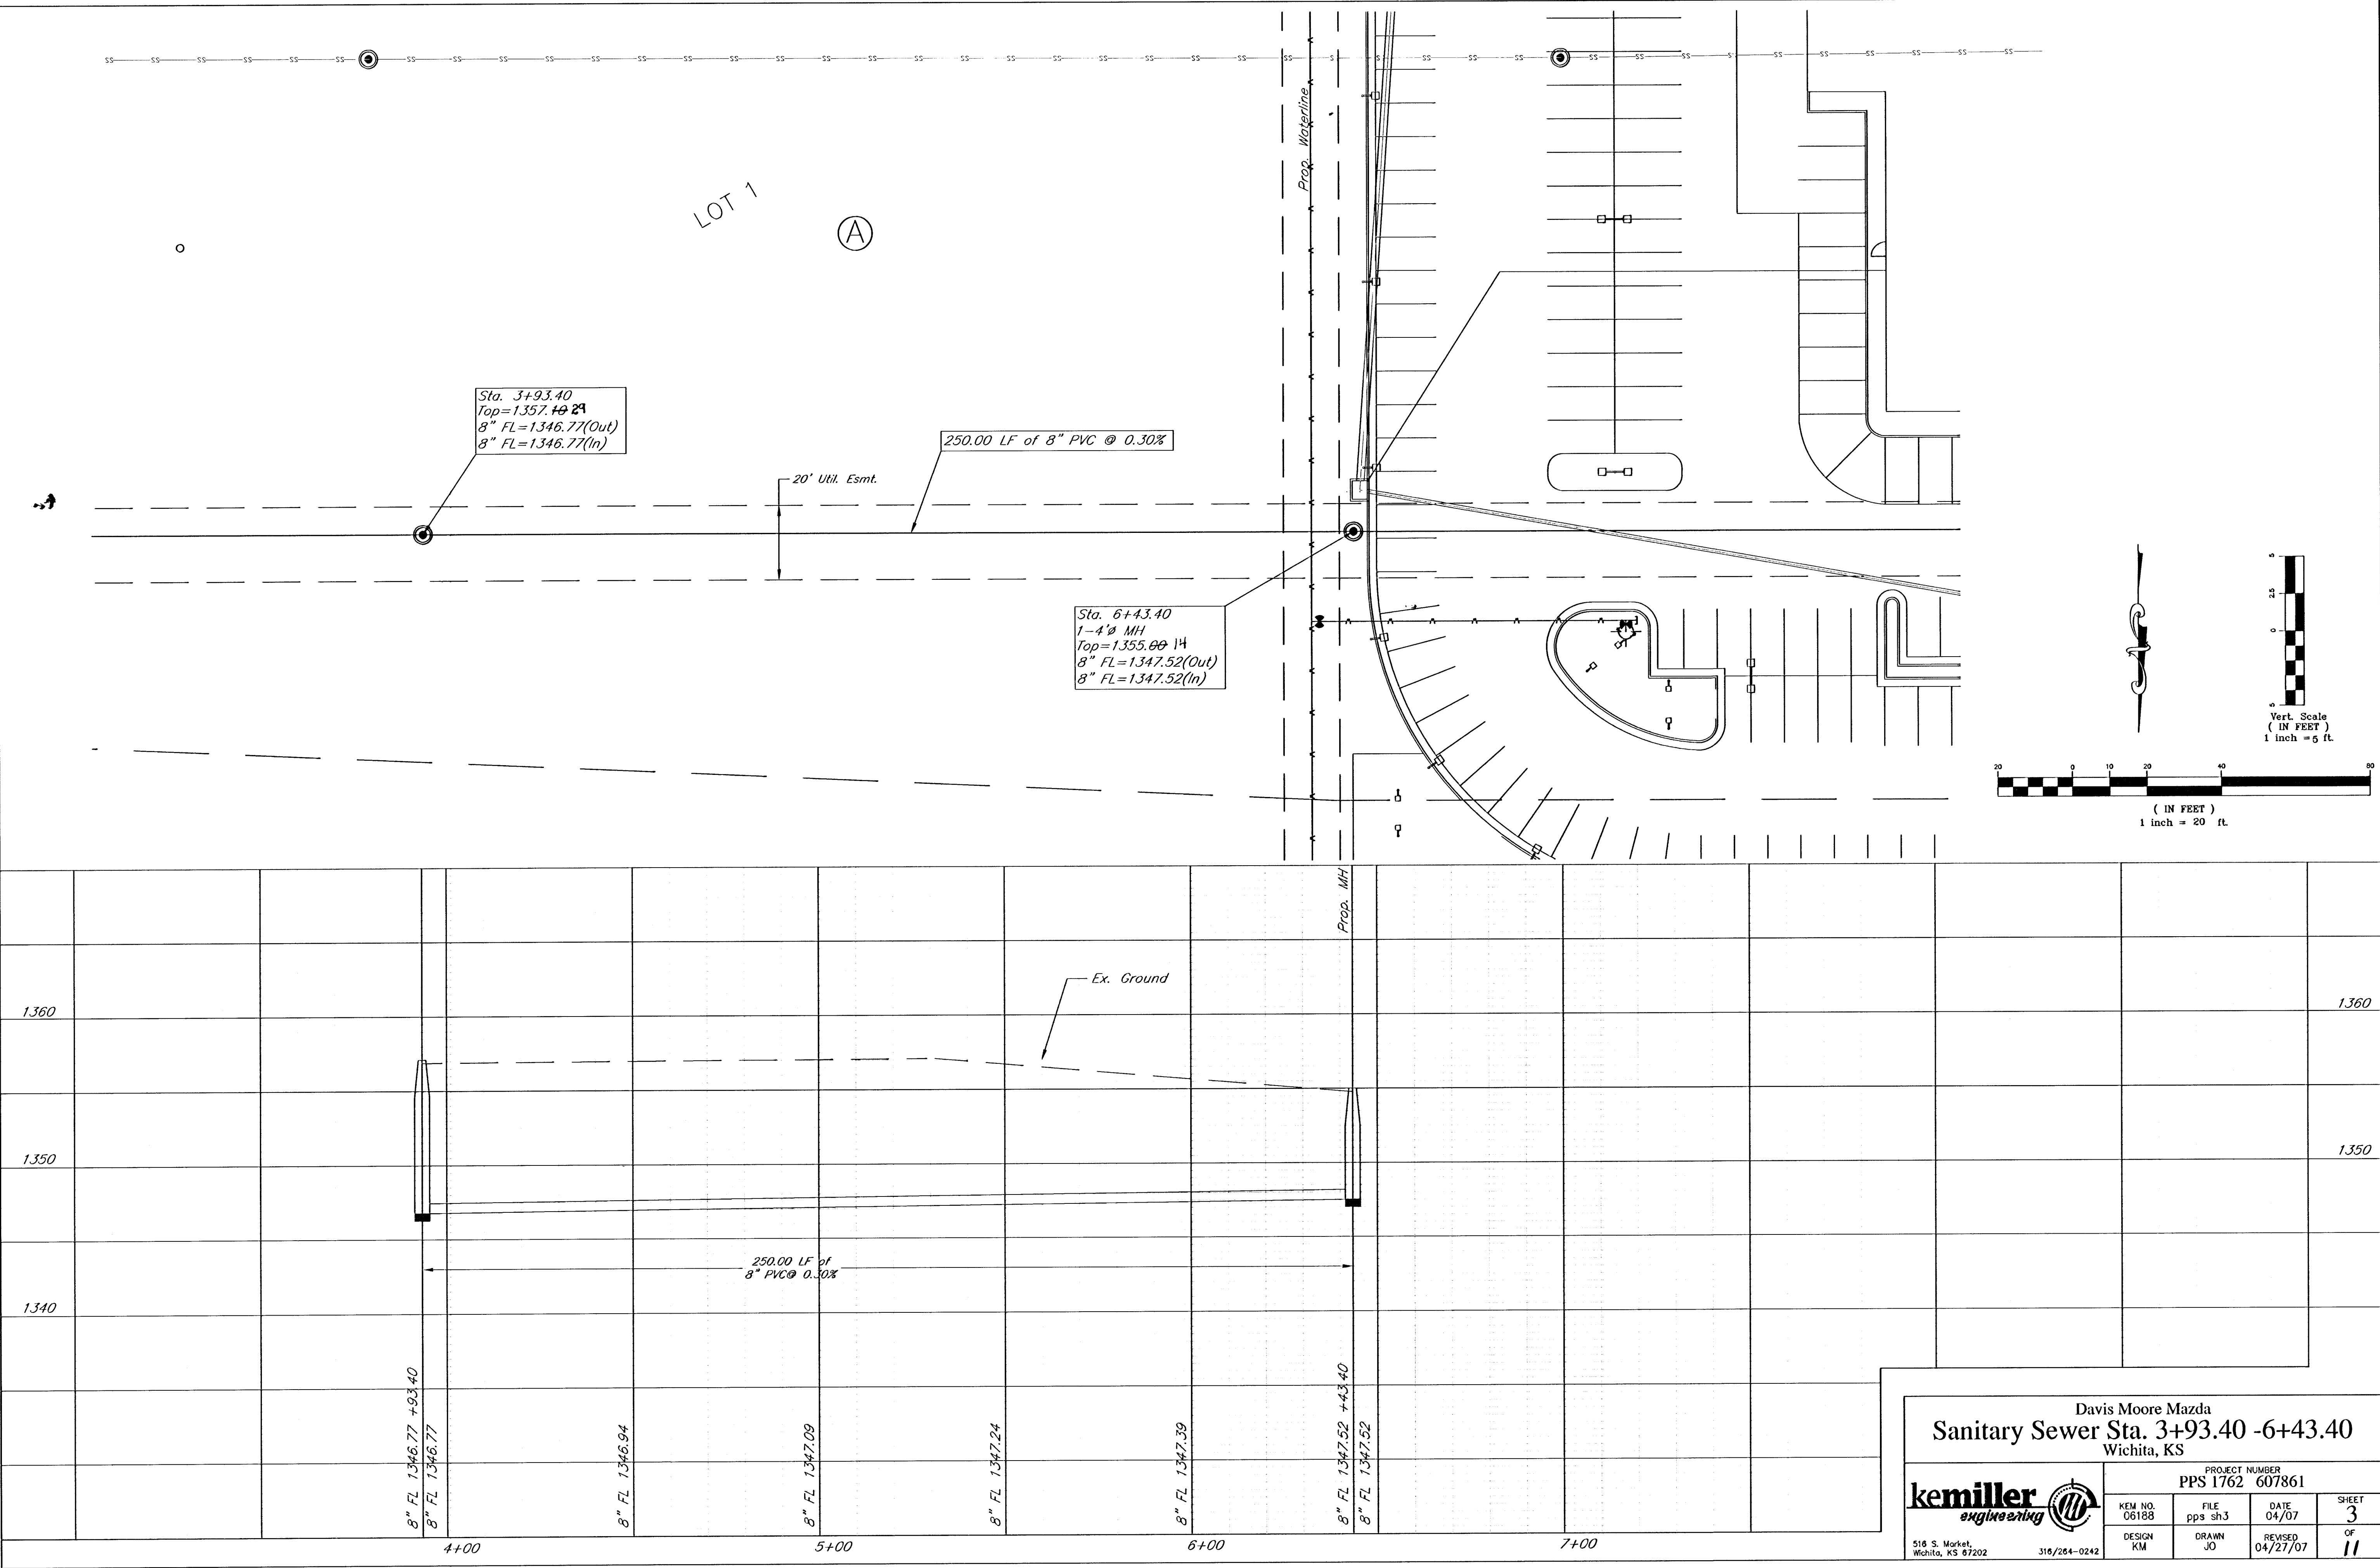

Davis Moore Mazda
Sanitary Sewer Sta. 3+93.40 -6+43.40
Wichita, KS

kemiller
engineering

PROJECT NUMBER
PPS 1762 607861

KEM NO. 06188	FILE pps sh3	DATE 04/07	SHEET 3
DESIGN KM	DRAWN JO	REVISED 04/27/07	OF 11

518 S. Market,
Wichita, KS 67202

316/264-0242