


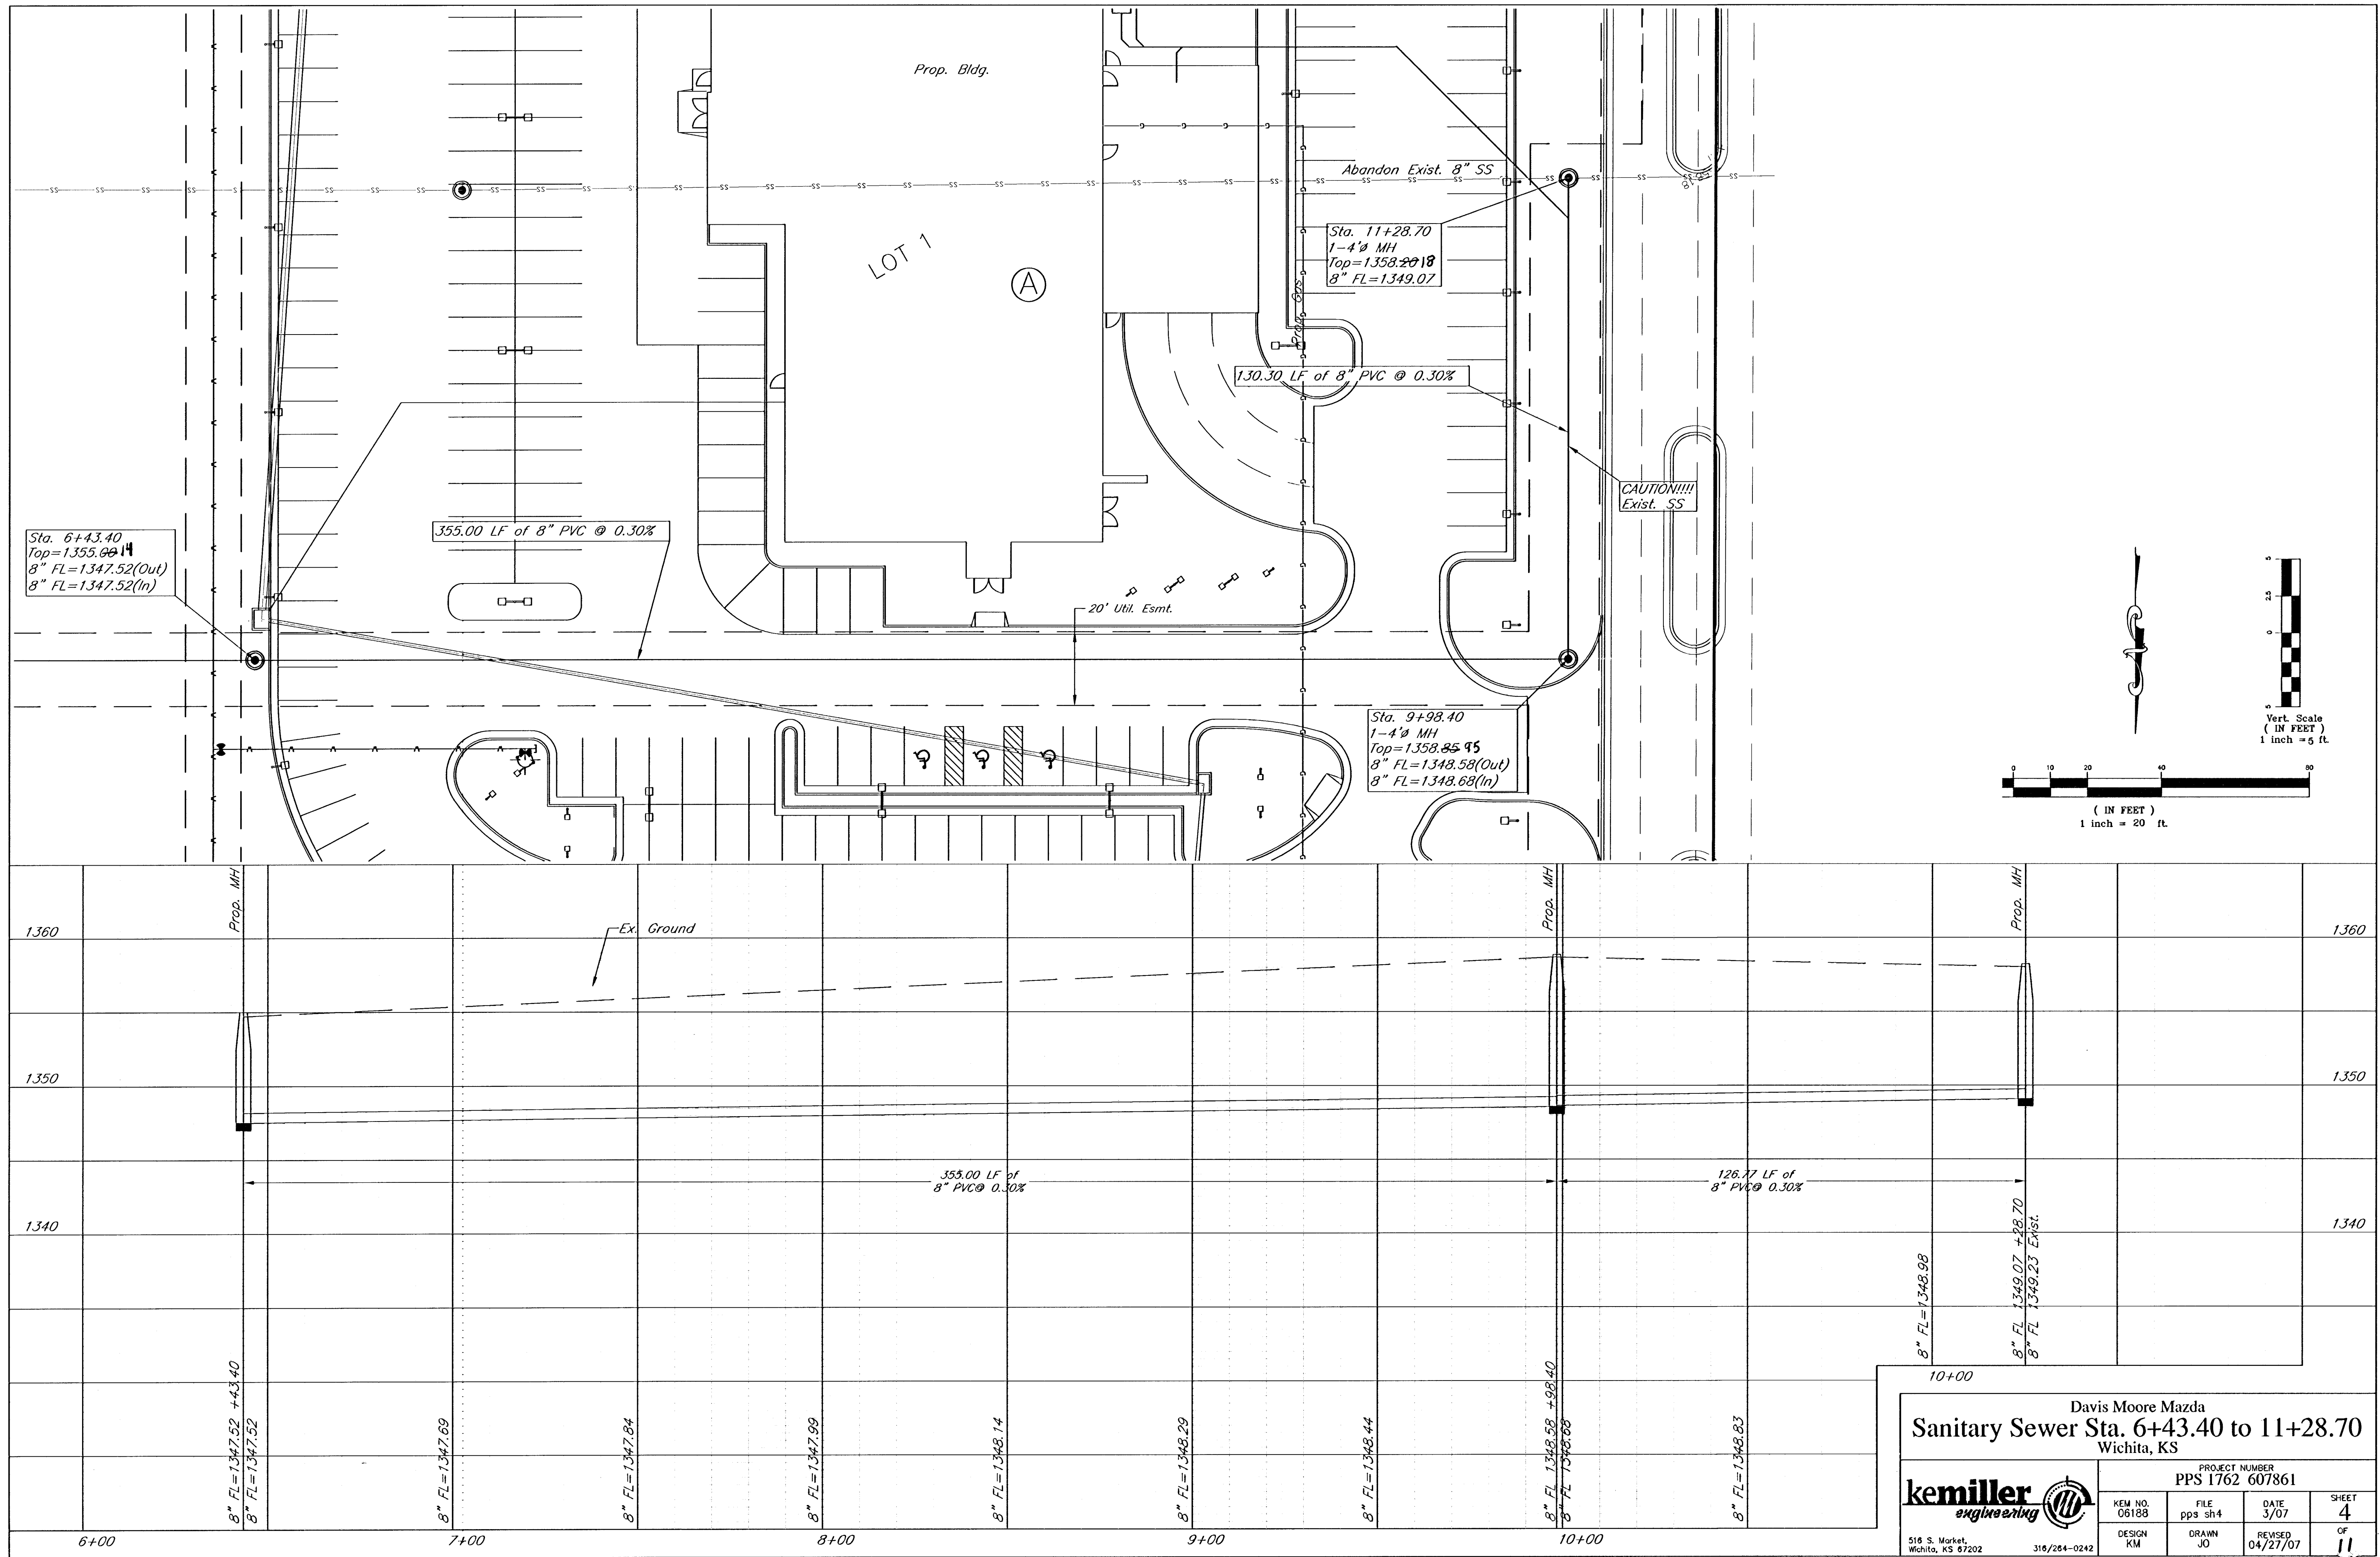

Davis Moore Mazda
Sanitary Sewer Sta. 6+43.40 to 11+28.70
Wichita, KS

PROJECT NUMBER
PPS 1762 607861

KEM NO. 06188	FILE pps sh4	DATE 3/07	SHEET 4
DESIGN KM	DRAWN JO	REVISED 04/27/07	OF 11

516 S. Market,
Wichita, KS 67202

318/264-0242