
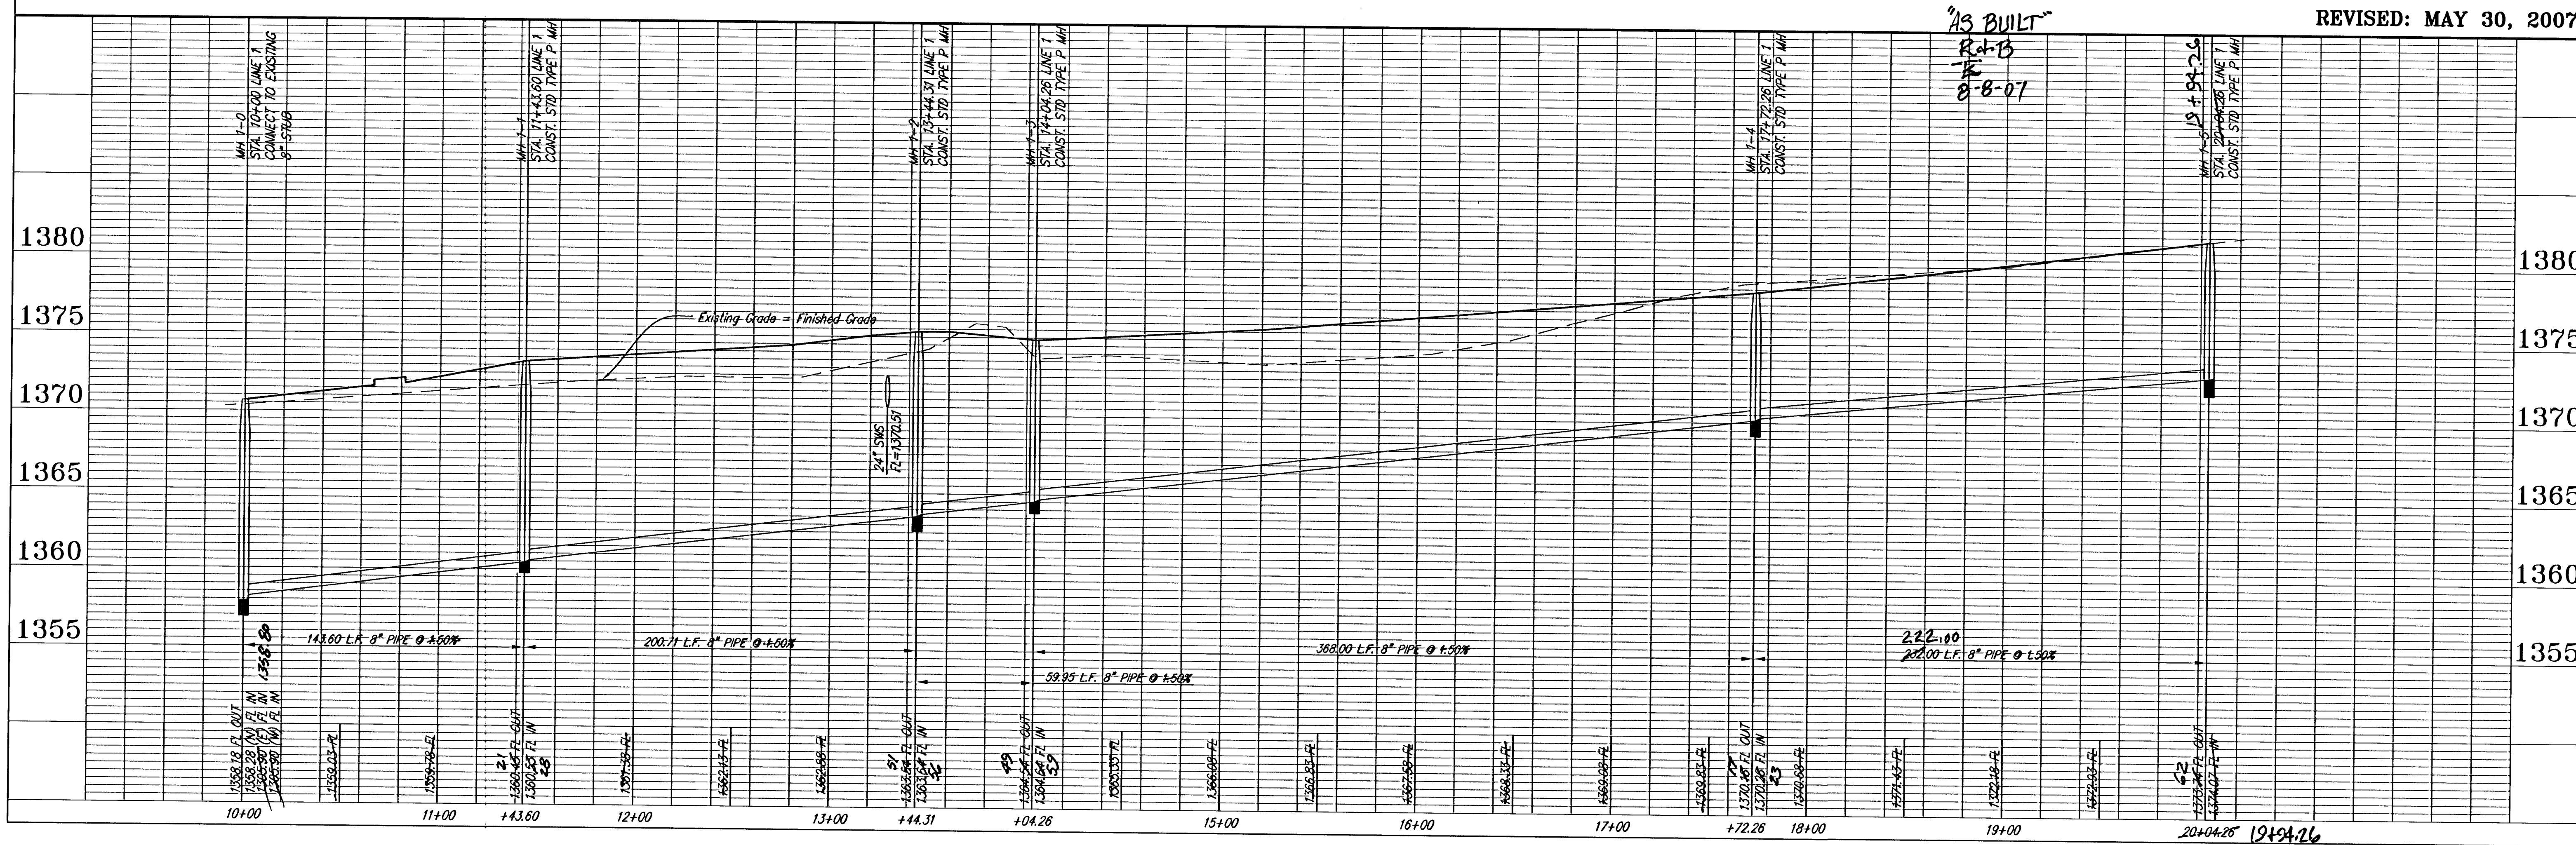
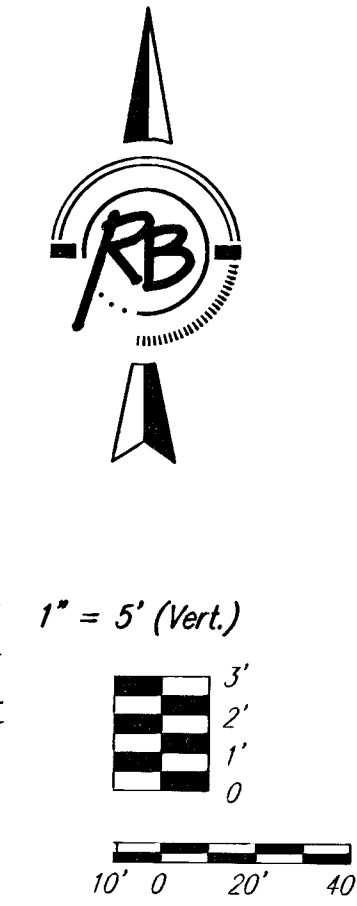


ALL PAVEMENT REMOVED SHALL HAVE SAWED EDGES. THE CONTRACTOR SHALL REPLACE PAVEMENT AS PER CITY OF WICHITA SPECIFICATIONS.

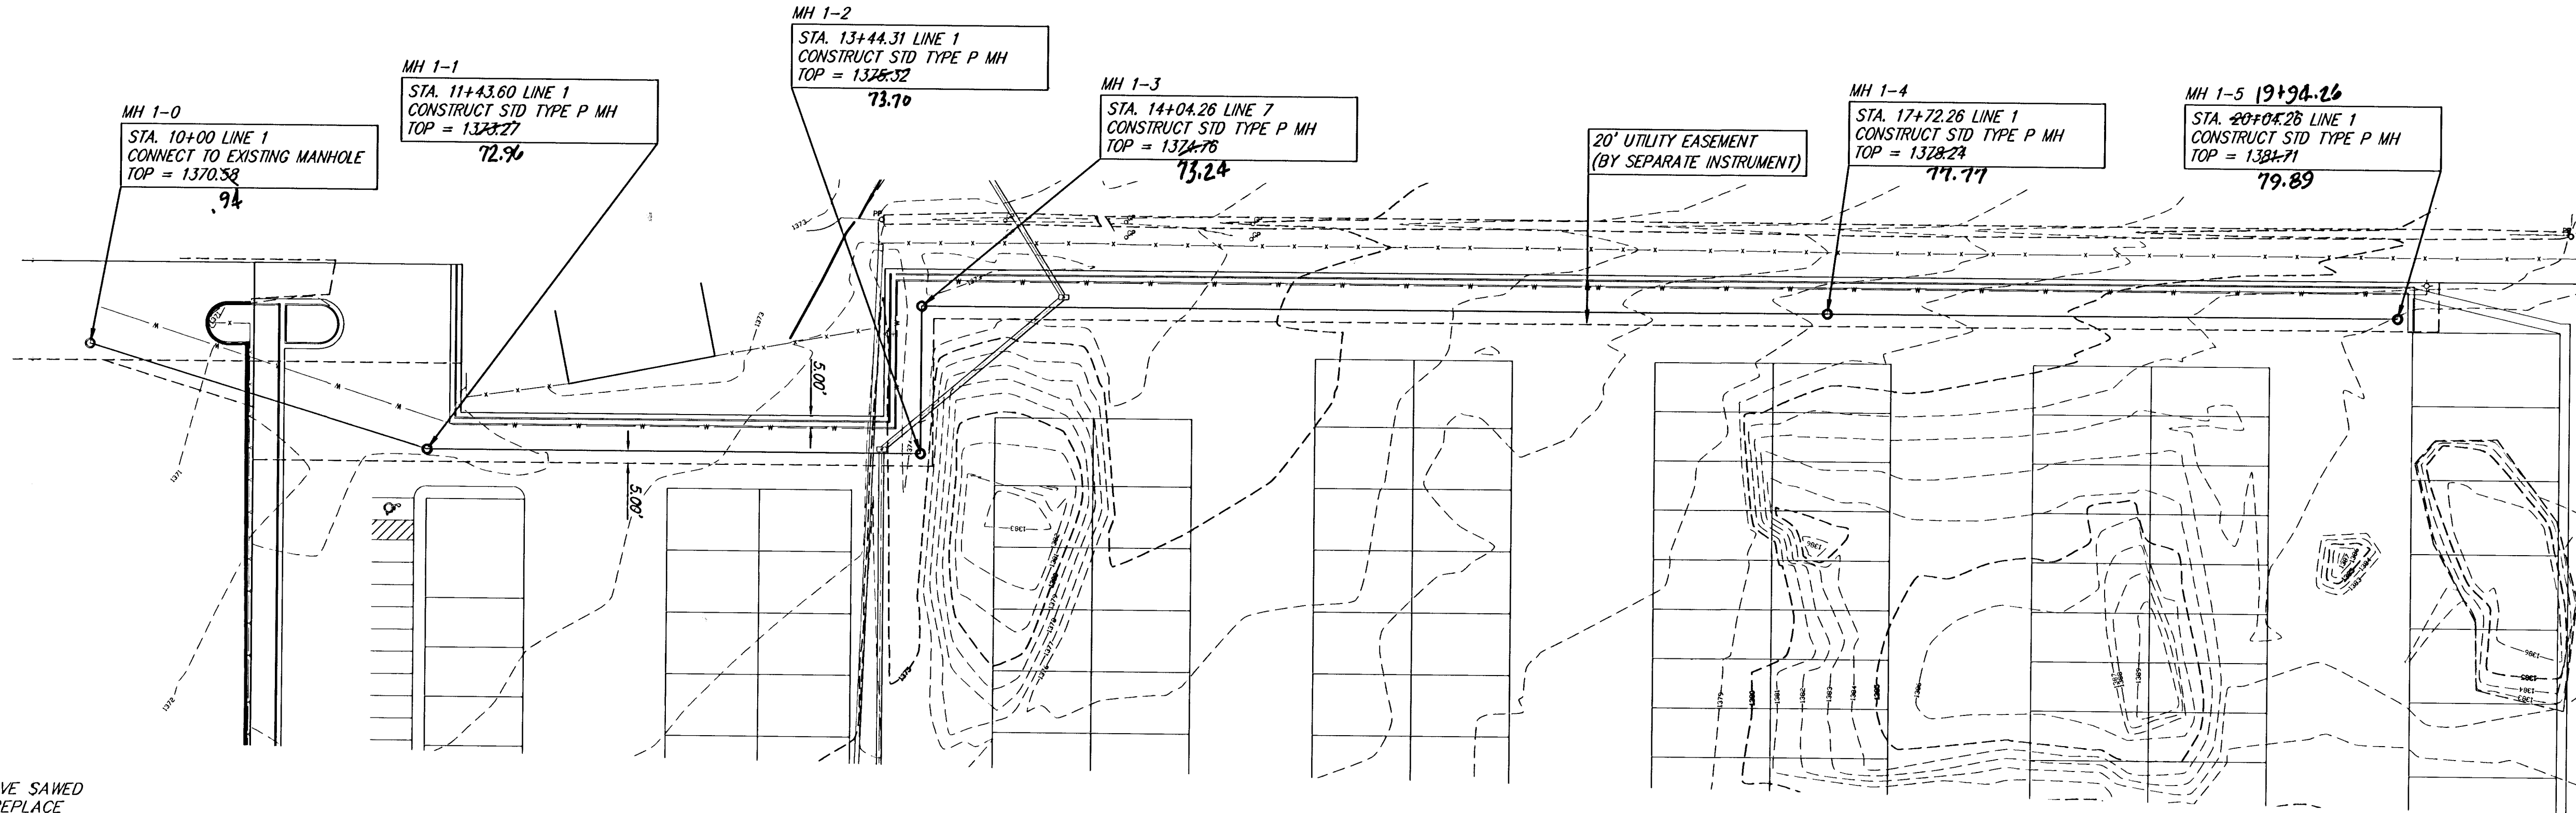

REVISED: MAY 30, 2007

AS BUILT
R+B
8-8-07

SANTARY SEWER LATERALS Exec-U-Stor Wichita, KS	PROJECT NUMBER 1771	DESIGN PDC	DRAWN PDC	REVIEW PDC
		UTILITY	DATE 4/16/07	REVIEW
	DRAWING FILE EN99 Base			
	RB-XB 29906			