

MAIN 10 NWI SANITARY SEWER PROJECT

135th STREET WEST


21st to 29th Street North

SANITARY SEWER PROJECT NO. 468-83971


OCA NO. 622096

LEGEND

— W —	Existing Water Line
— E —	Electric Line
— G —	Gas Line
— T —	Telephone Line
— CATV —	Cable TV Line
—	Center Line
---	Existing Right-of-Way
■	Power Pole
• E.M.	Electric Meter
⊙	Luminaire
⊙	Yard Light
⊙	Pull Box
⊙	Signal Control Box
• M.A.	Mast Arm
• P.M.S.	Pedestal Mounted Signal
• T.M.H.	Telephone Manhole
□	Telephone Pedestal
□ PHONE	Telephone
□	Cable Television Box
◀ W.V.	Water Valve
• W.M.	Water Meter
⊙	Fire Hydrant
• S.H.	Sprinkler Head
▶ I.C.V.	Irrigation Control Valve
• A.R.	Air Release
• G.M.S.	Gas Monitoring Station
• G.M.	Gas Meter
• G.T.S.	Gas Testing Station
• G.F.C.	Gas Filler Cap
• S.S.M.H.	Sanitary Sewer Manhole

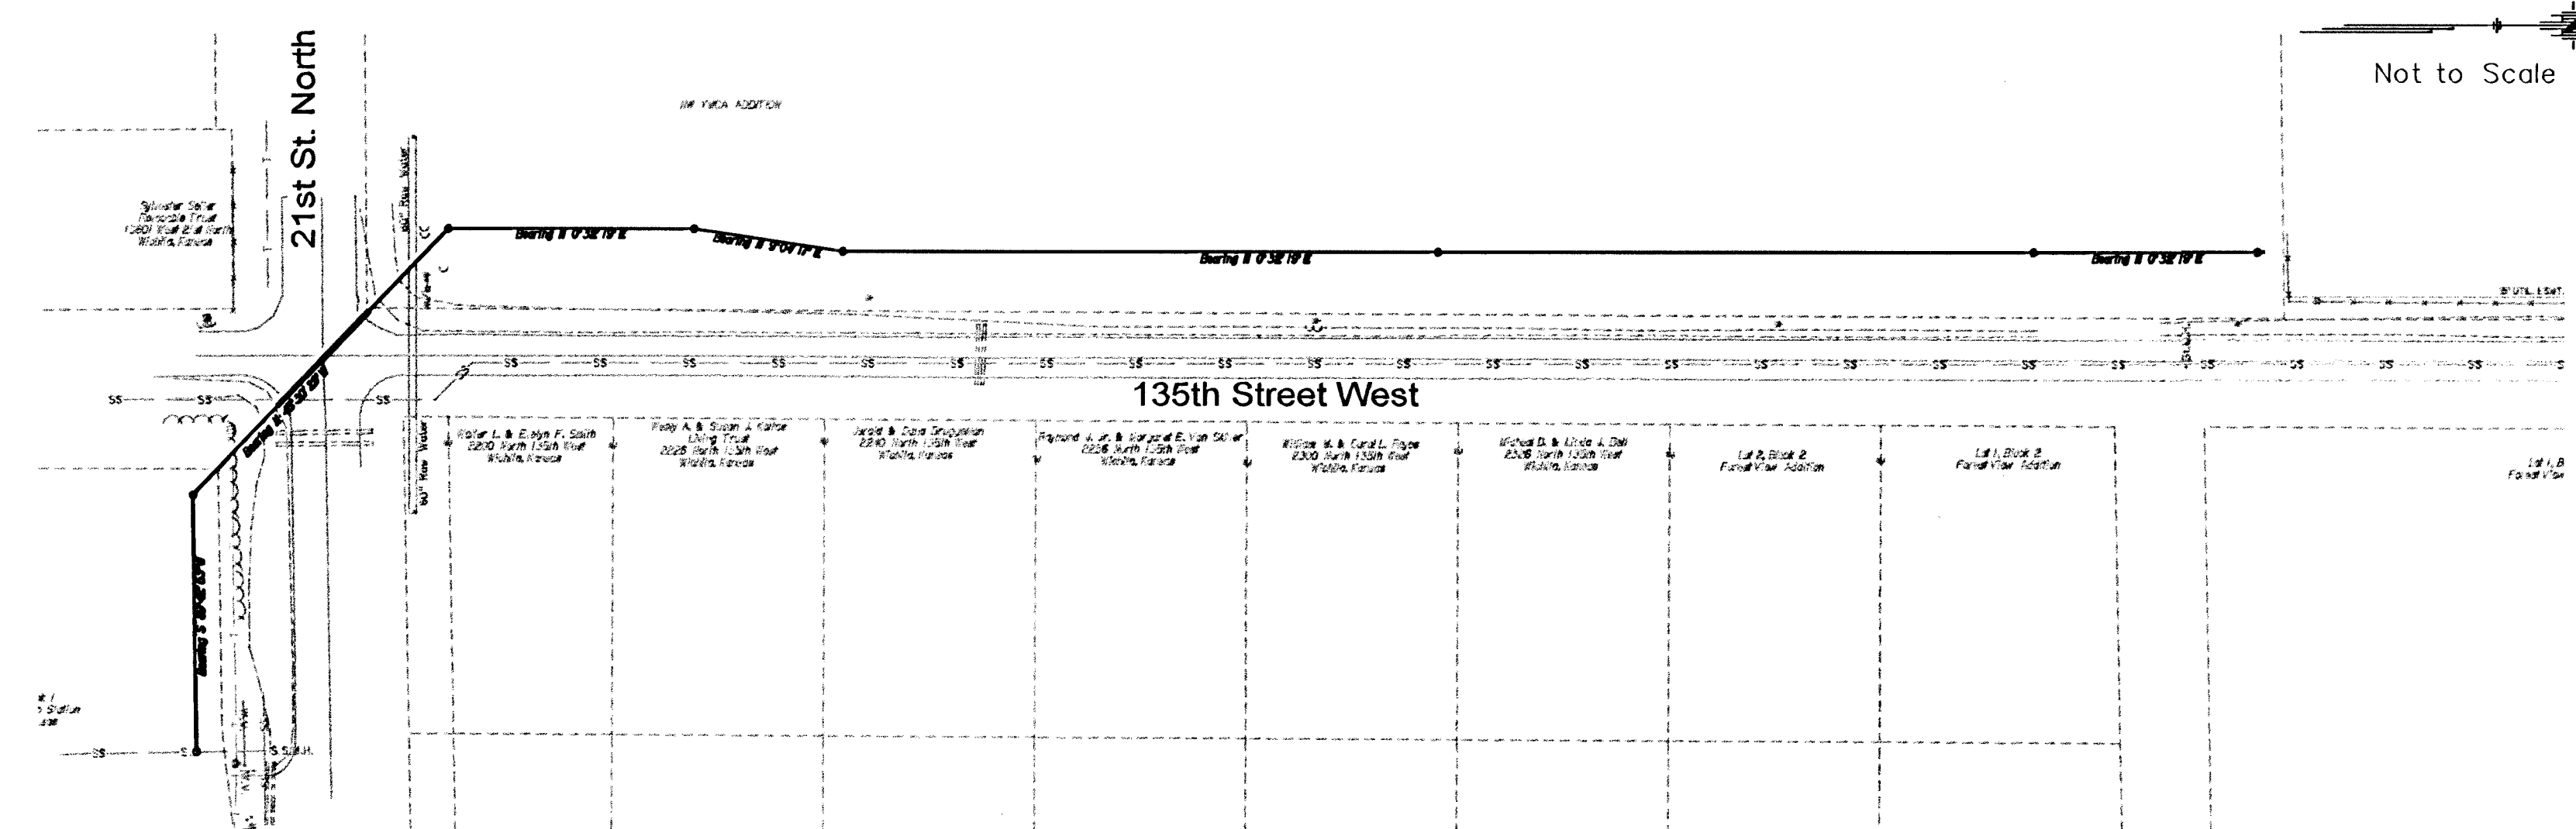

Vicinity Map

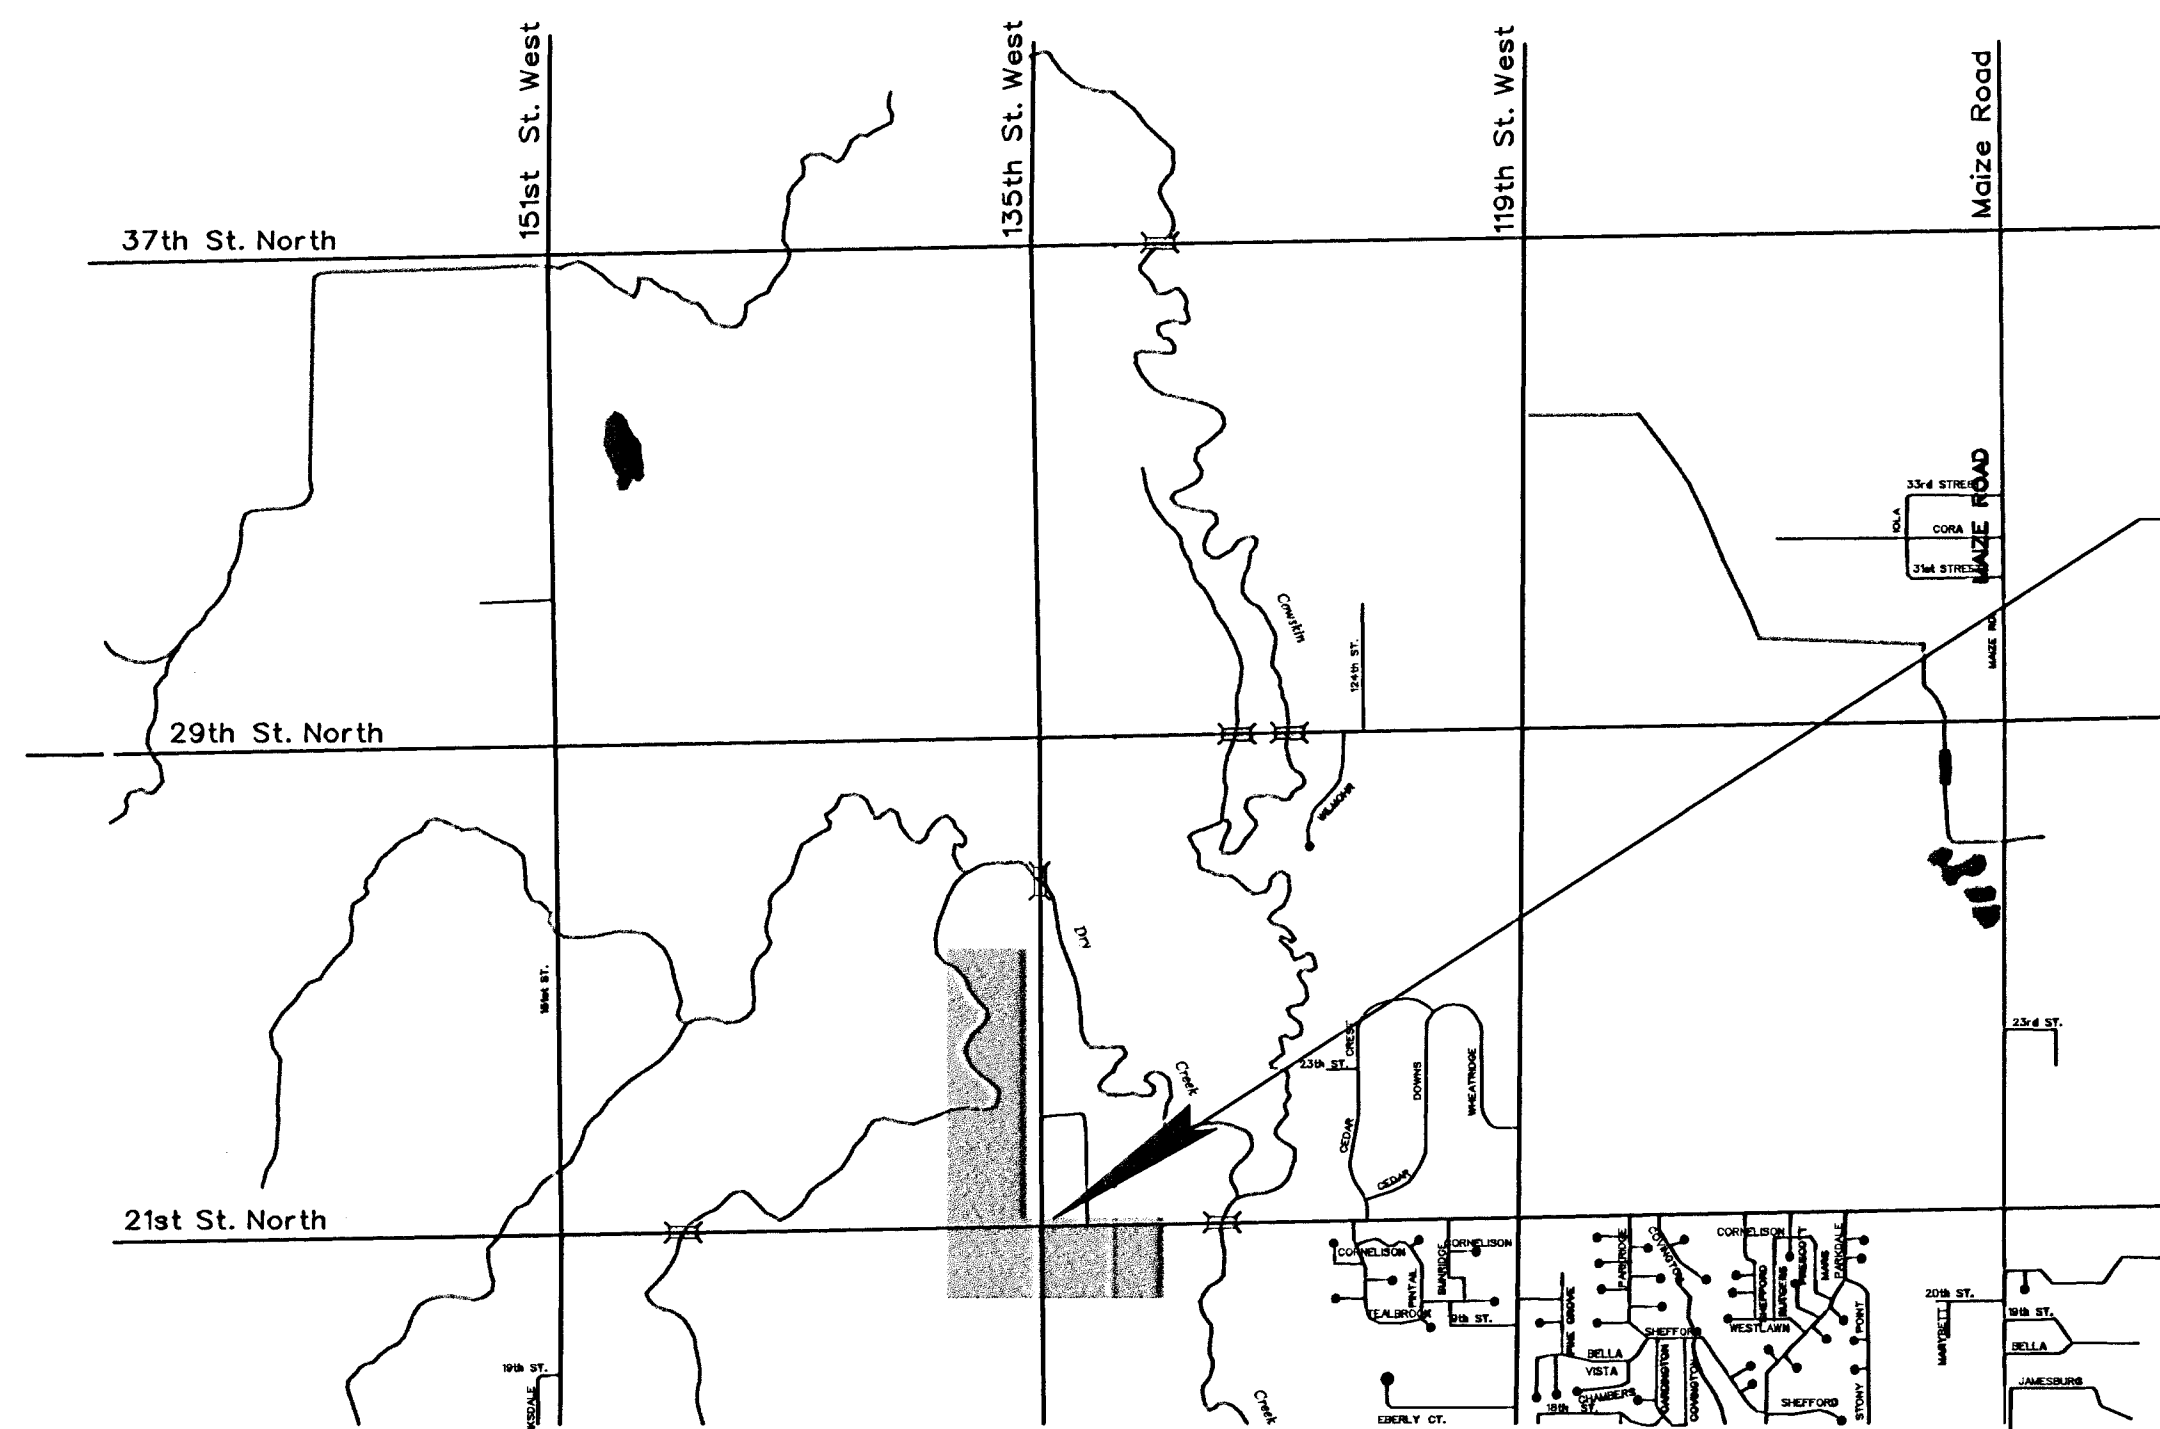


Project Map

INDEX TO DRAWINGS

TITLE SHEET	1
GENERAL NOTES	2
CITY OF WICHITA STANDARDS	3 - 4
PLAN SHEETS	5 - 6

Dondlinger & Sons Construction Co., Inc. - Contractor
 Smith/Peterson, City - Inspectors
 Released 1/15/06
 As-Built
 .pdf by JDL 4/27/06

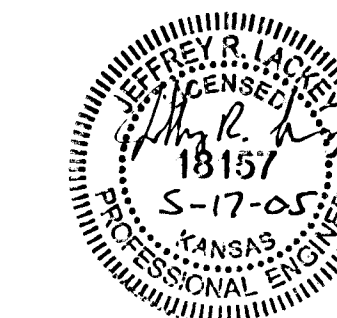

CITY OF WICHITA, KANSAS
 James L. Armour, P.E. City Engineer
MAY, 2005

PREPARED BY
TRANSYSTEMS
 CORPORATION
 245 North Waco Suite 420
 Wichita, Kansas

