



STORM WATER SEWER PLANS
THE GROVE AT WICHITA
LOT 1, BLOCK 1 CAMPUS CREST

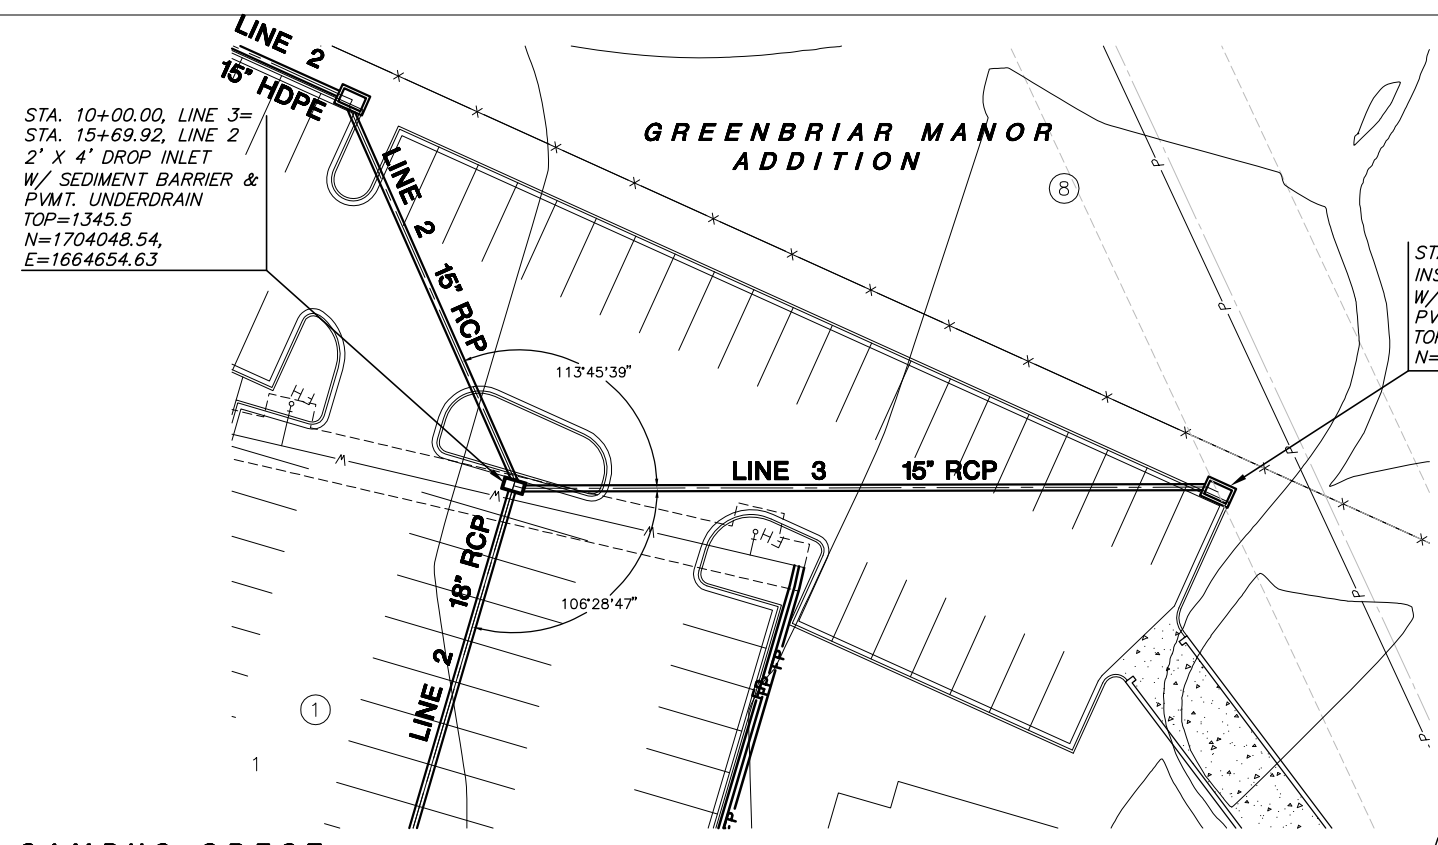


CAMPUS CREST
ADDITION

PLAN LINE 3

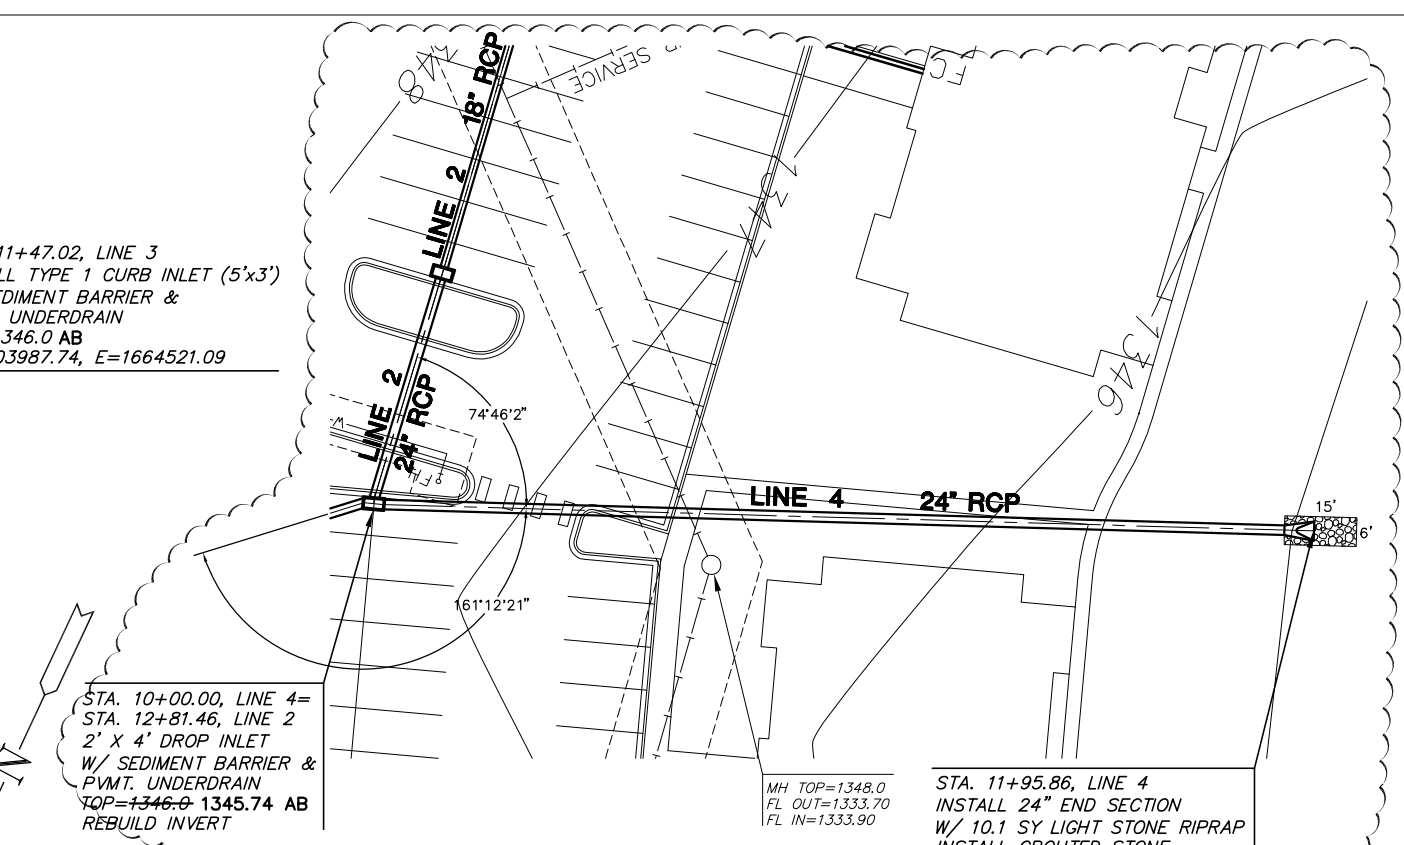


PLAN LINE 4

AS-BUILT 4-1-09
REVISED: 3-7-08

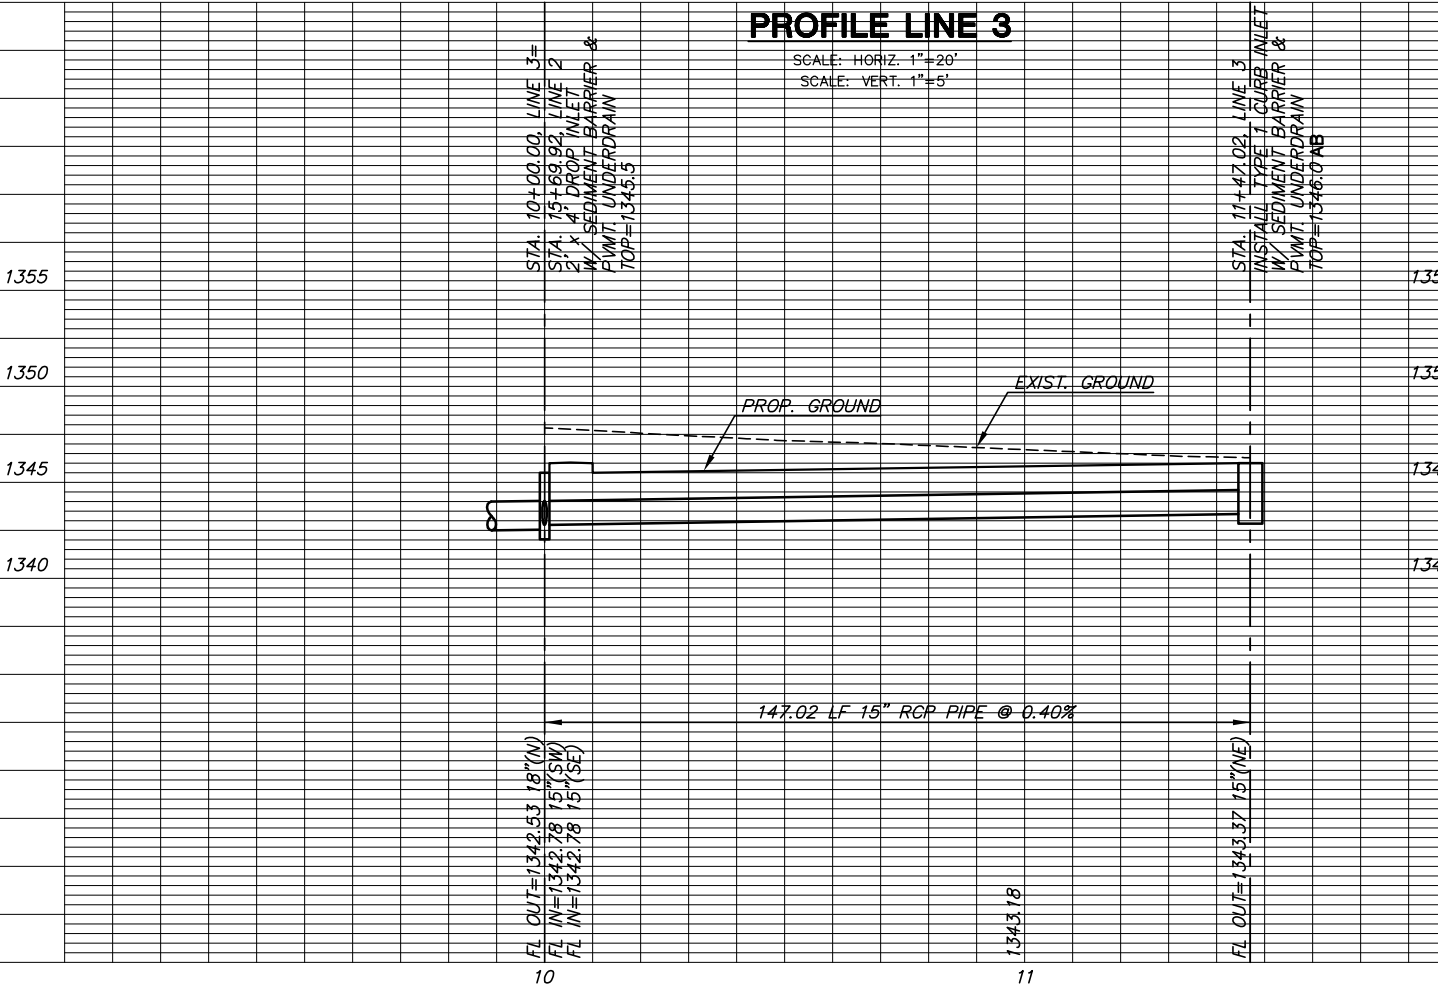

PROFILE LINE 3

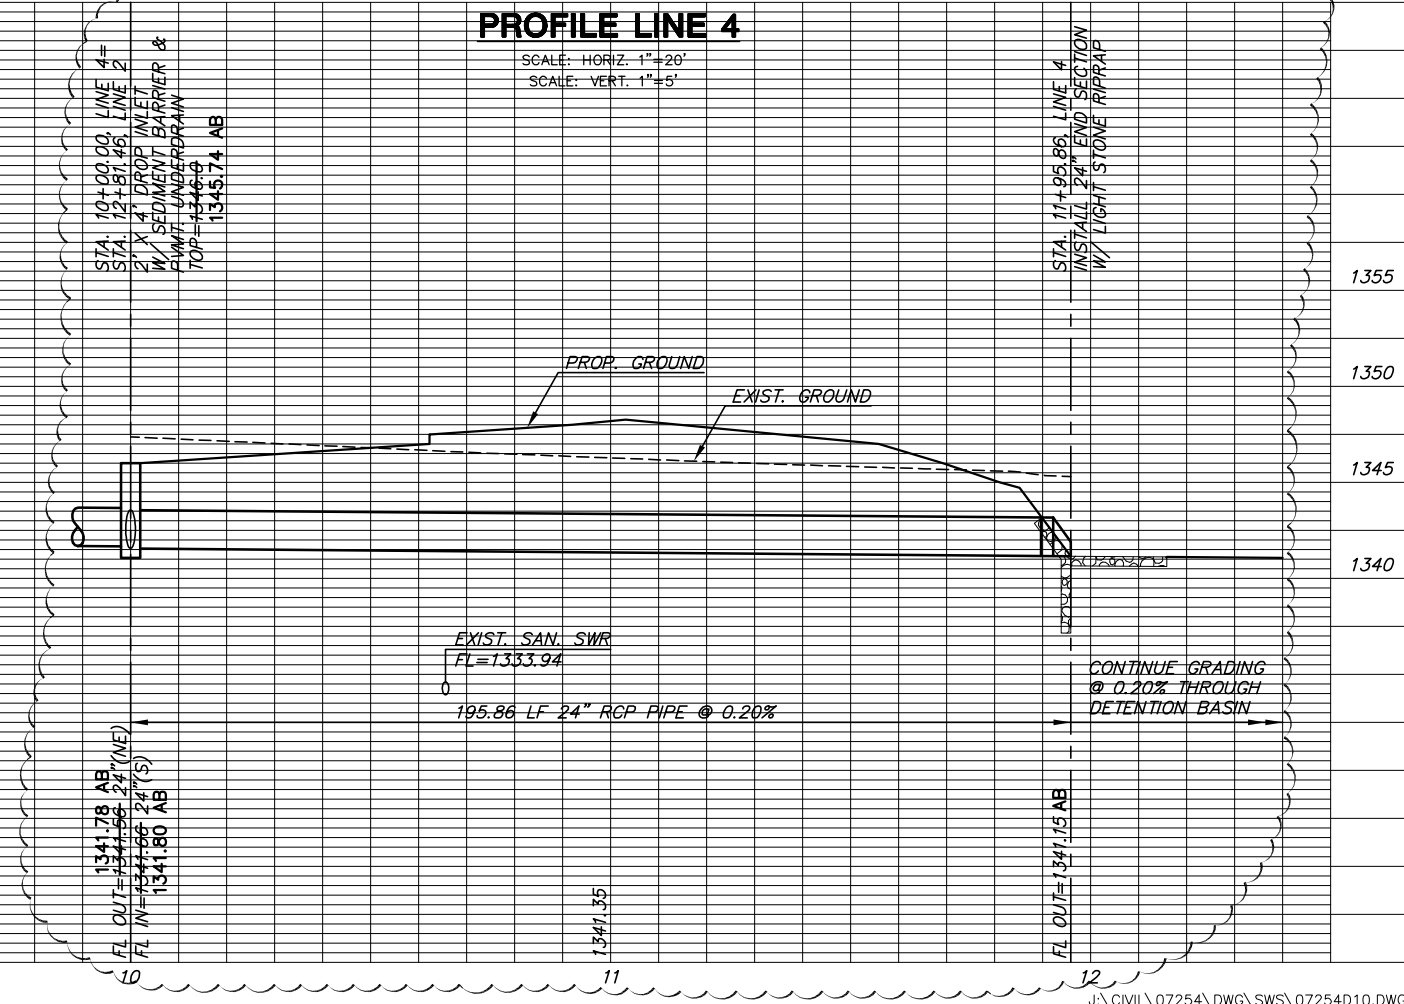

PROFILE LINE 4

PLOTED: Thursday, April 02, 2009 @ 02:52PM

LINES 3 & 4
SHEET TITLE
07008 (CC)
07254 (MKEC)
PROJECT NUMBER

DESIGN BY: SRS
DRAWN BY: JWC
CHECKED BY: GJA

ISSUED: DECEMBER 2007
REVISED: MARCH 2008